

WW-7
8-30-06



West Virginia Department of Environmental Protection
Office of Oil and Gas
WELL LOCATION FORM: GPS

API: 47-095-01647 WELL NO.: 10
 FARM NAME: Enoch McIntyre
 RESPONSIBLE PARTY NAME: Tribune Resources
 COUNTY: Tyler DISTRICT: McElroy
 QUADRANGLE: Centerpoint
 SURFACE OWNER: Fred Glover
 ROYALTY OWNER: _____
 UTM GPS NORTHING: 4364797.84
 UTM GPS EASTING: 526470.13 GPS ELEVATION: 961'

The Responsible Party named above has chosen to submit GPS coordinates in lieu of preparing a new well location plat for a plugging permit or assigned API number on the above well. The Office of Oil and Gas will not accept GPS coordinates that do not meet the following requirements:

1. Datum: NAD 1983, Zone: 17 North, Coordinate Units: meters, Altitude: height above mean sea level (MSL) – meters.
2. Accuracy to Datum – 3.05 meters
3. Data Collection Method:

Survey grade GPS ____: Post Processed Differential ____


Real-Time Differential ____

Mapping Grade GPS ____: Post Processed Differential

Real-Time Differential ____

4. Letter size copy of the topography map showing the well location.

I the undersigned, hereby certify this data is correct to the best of my knowledge and belief and shows all the information required by law and the regulations issued and prescribed by the Office of Oil and Gas.

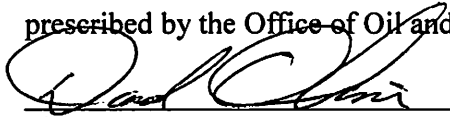
Signature

Facilities/Pipeline Engineer
Title

2/11/21
Date


RECEIVED
Office of Oil and Gas

MAR 15 2021

WV Department of
Environmental Protection

08/13/2021

47-095-01647P

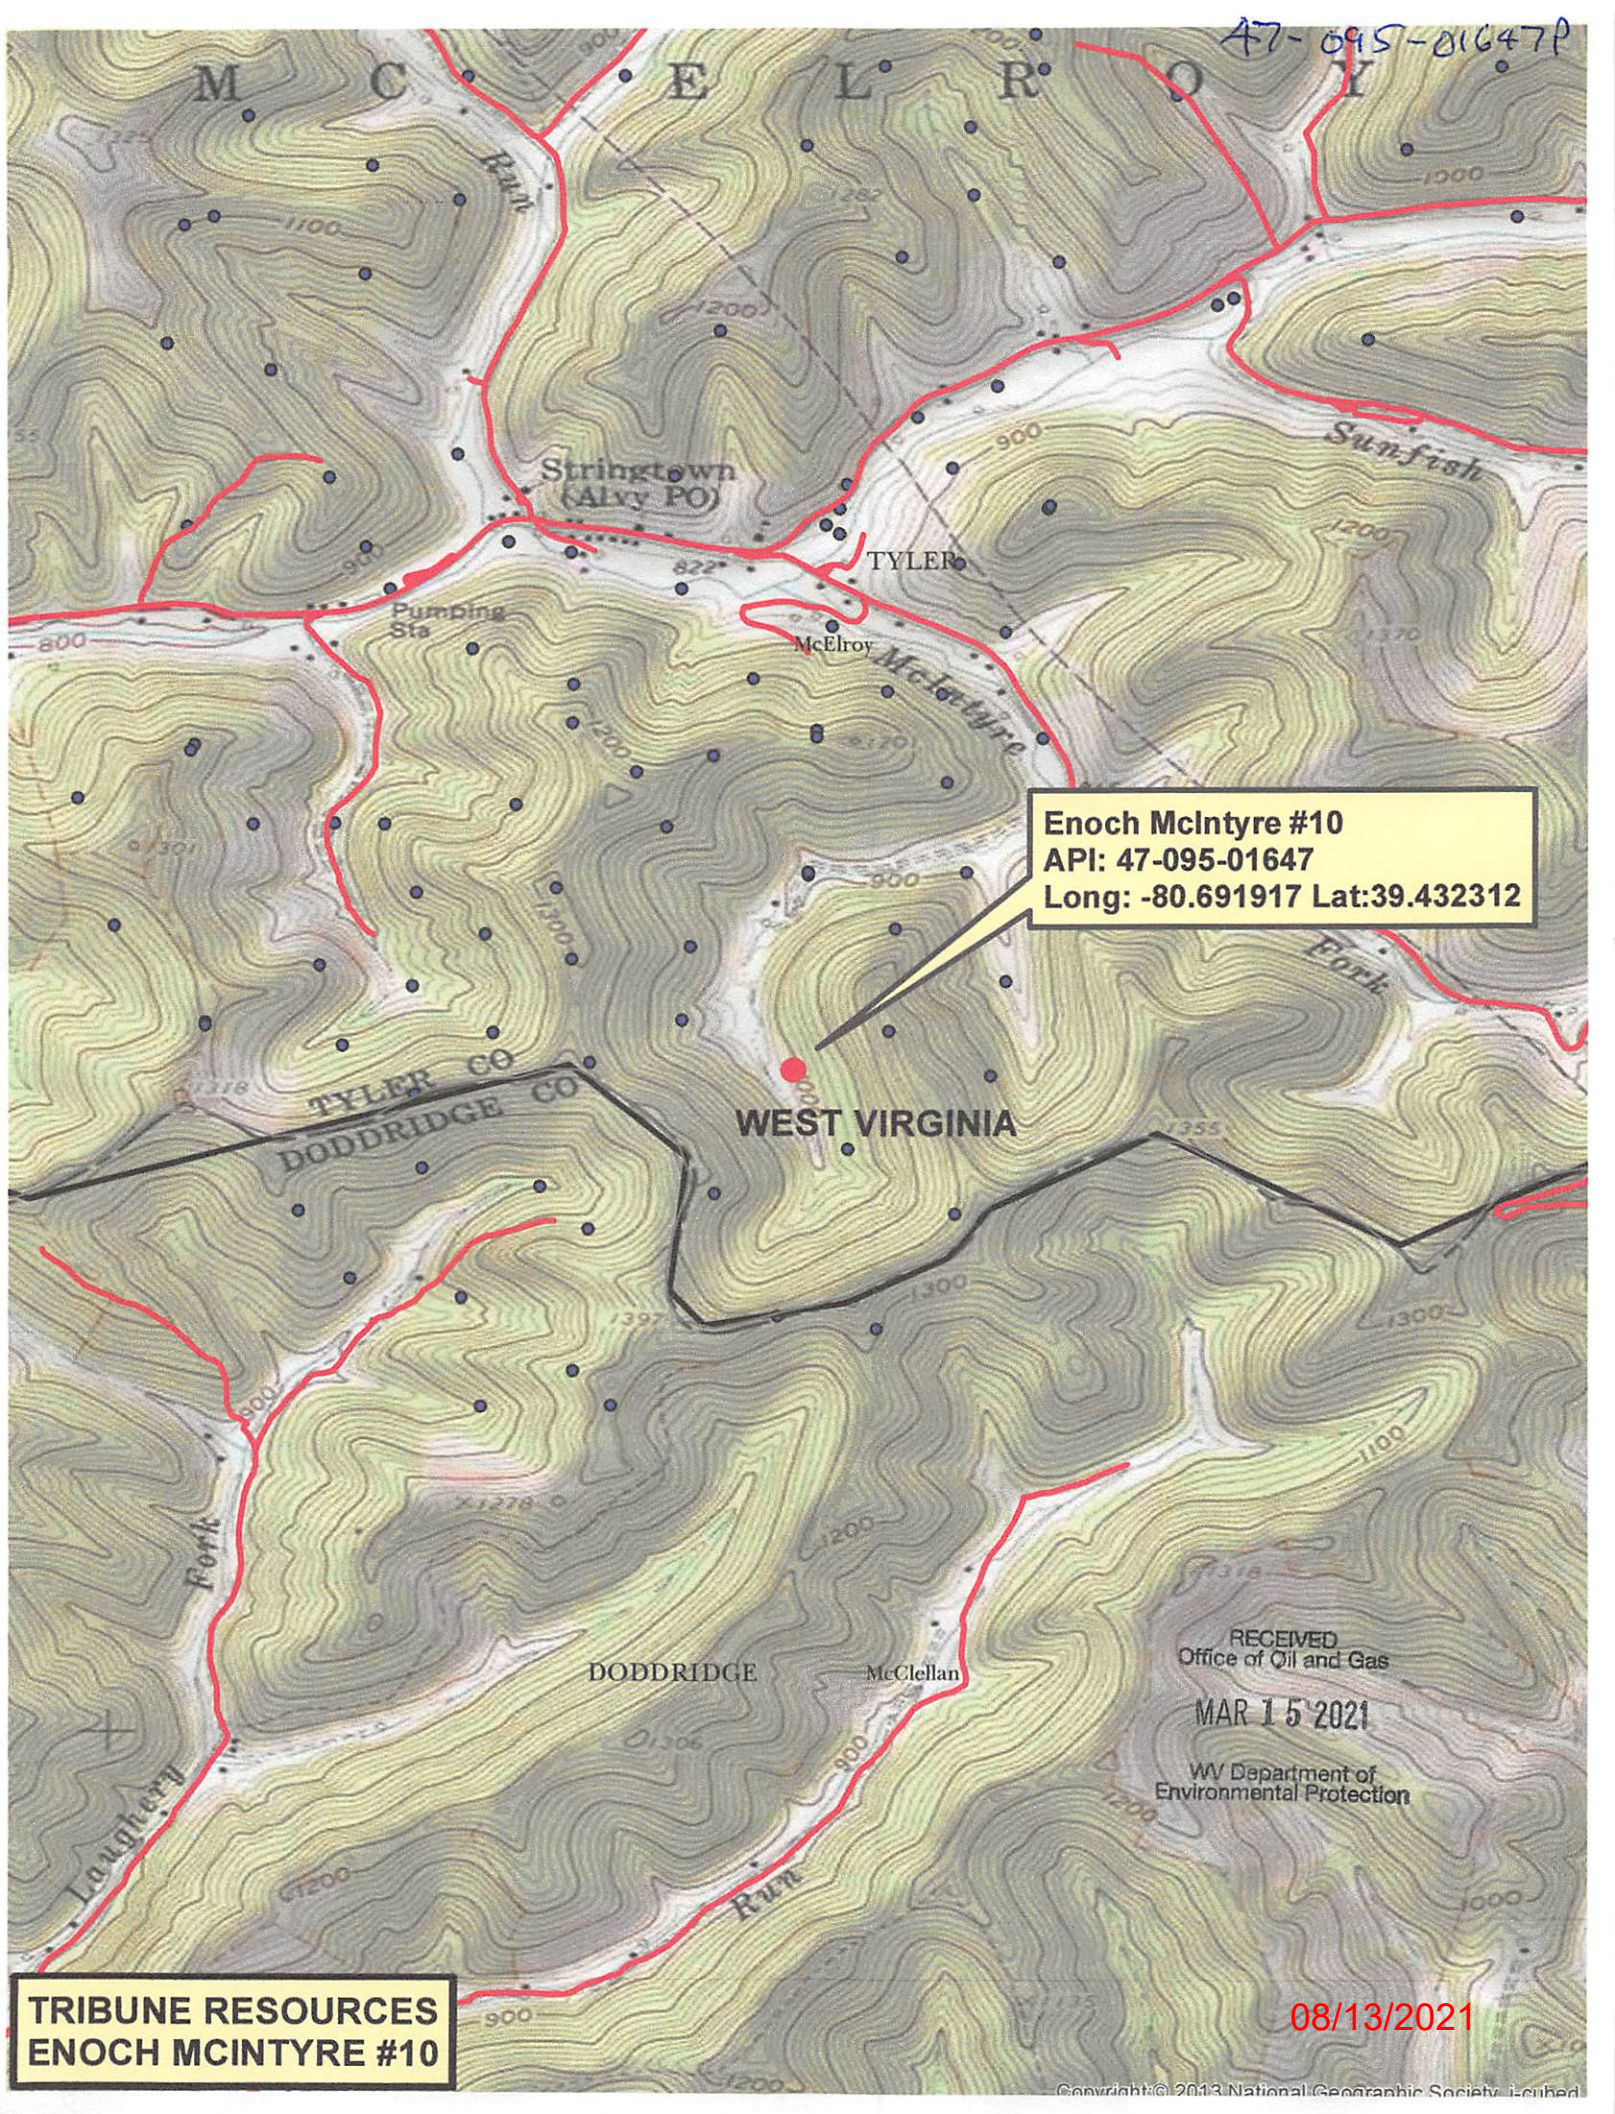

Enoch McIntyre #10
API: 47-095-01647
Long: -80.691917 Lat:39.432312

RECEIVED
Office of Oil and Gas
MAR 15 2021
WV Department of
Environmental Protection

TRIBUNE RESOURCES
ENOCH MCINTYRE #10

08/13/2021