

WW-7  
8-30-06



West Virginia Department of Environmental Protection  
Office of Oil and Gas

**WELL LOCATION FORM: GPS**

API: 47-095-01649 WELL NO.: D-3

FARM NAME: P.G. Wright

RESPONSIBLE PARTY NAME: Ascent Resources - Marcellus LLC

COUNTY: Tyler DISTRICT: McElroy

QUADRANGLE: Center Point

SURFACE OWNER: Betty Baker

ROYALTY OWNER: Ascent Resources - Marcellus LLC

UTM GPS NORTHING: 4366226.2

UTM GPS EASTING: 525292.3 GPS ELEVATION: 932'

The Responsible Party named above has chosen to submit GPS coordinates in lieu of preparing a new well location plat for a plugging permit or assigned API number on the above well. The Office of Oil and Gas will not accept GPS coordinates that do not meet the following requirements:

1. Datum: NAD 1983, Zone: 17 North, Coordinate Units: meters, Altitude: height above mean sea level (MSL) – meters.
2. Accuracy to Datum – 3.05 meters
3. Data Collection Method:

Survey grade GPS  : Post Processed Differential


Real-Time Differential

Mapping Grade GPS  : Post Processed Differential

Real-Time Differential

4. Letter size copy of the topography map showing the well location.

I the undersigned, hereby certify this data is correct to the best of my knowledge and belief and shows all the information required by law and the regulations issued and prescribed by the Office of Oil and Gas.

  
Signature

Sr. Regulatory Analyst  
Title

9/12/2017  
Date

RECEIVED  
Office of Oil and Gas  
SEP 15 2017  
WV Department of  
Environmental Protection

SEP 15 2017

WV Department of  
Environmental Protection

Ascent Resources—  
Marcellus LLC.  
Proposed Plugging of  
P.G. Wright No.D-3 (095-01649)  
McElroy District  
Tyler County, WV

TOP HOLE (NAD 83)  
N) 346561.41  
E) 1627915.93  
LAT.) 39°26'42.8"  
LONG.) 80°42'21.8"  
DEC. LAT.) 39.445220  
DEC. LONG.) 80.706063

TOP HOLE (NAD 27)  
N) 346525.43  
E) 1659356.92  
LAT.) 39°26'42.5"  
LONG.) 80°42'22.5"  
DEC. LAT.) 39.445138  
DEC. LONG.) 80.706239

TOP HOLE (UTM NAD 83)  
N) 4366226.2  
E) 525292.3




BETTY BAKER  
TAX MAP & PARCEL  
05-13-41.1  
32.00 TOTAL ACRES

P. G. Wright No. D-3

Pumping  
Sta

PRELIMINARY

BOORD, BENCHEK and ASSOC., INC.  
Engineering, Surveying, Construction,  
and Mining Services  
Southpointe, PA 15317 Phone: 724-746-1055

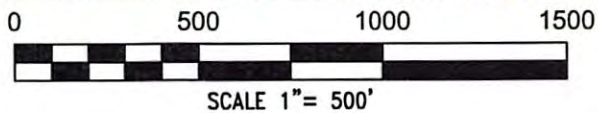

JULY 27, 2017