

WW-7
8-30-06



West Virginia Department of Environmental Protection
Office of Oil and Gas
WELL LOCATION FORM: GPS

API: 47-095-01781 WELL NO.: 12

FARM NAME: Enoch McIntyre

RESPONSIBLE PARTY NAME: Harman Brown

COUNTY: Tyler DISTRICT: McElroy

QUADRANGLE: Centerpoint

SURFACE OWNER: Fred & Dottie Glover

ROYALTY OWNER: _____

UTM GPS NORTHING: 4364472.72

UTM GPS EASTING: 526354.11 GPS ELEVATION: 1267'

The Responsible Party named above has chosen to submit GPS coordinates in lieu of preparing a new well location plat for a plugging permit or assigned API number on the above well. The Office of Oil and Gas will not accept GPS coordinates that do not meet the following requirements:

1. Datum: NAD 1983, Zone: 17 North, Coordinate Units: meters, Altitude: height above mean sea level (MSL) – meters.
2. Accuracy to Datum – 3.05 meters
3. Data Collection Method:

Survey grade GPS _____: Post Processed Differential _____
Real-Time Differential _____

Mapping Grade GPS _____: Post Processed Differential _____
Real-Time Differential _____

4. **Letter size copy of the topography map showing the well location.**

I the undersigned, hereby certify this data is correct to the best of my knowledge and belief and shows all the information required by law and the regulations issued and prescribed by the Office of Oil and Gas.

[Signature] Facilities/Pipeline Engineer 2/11/21
Signature Title Date

RECEIVED
Office of Oil and Gas


MAR 15 2021

WV Department of Environmental Protection

[Signature]
12/23/2021

08/13/2021

47-095-01781 P

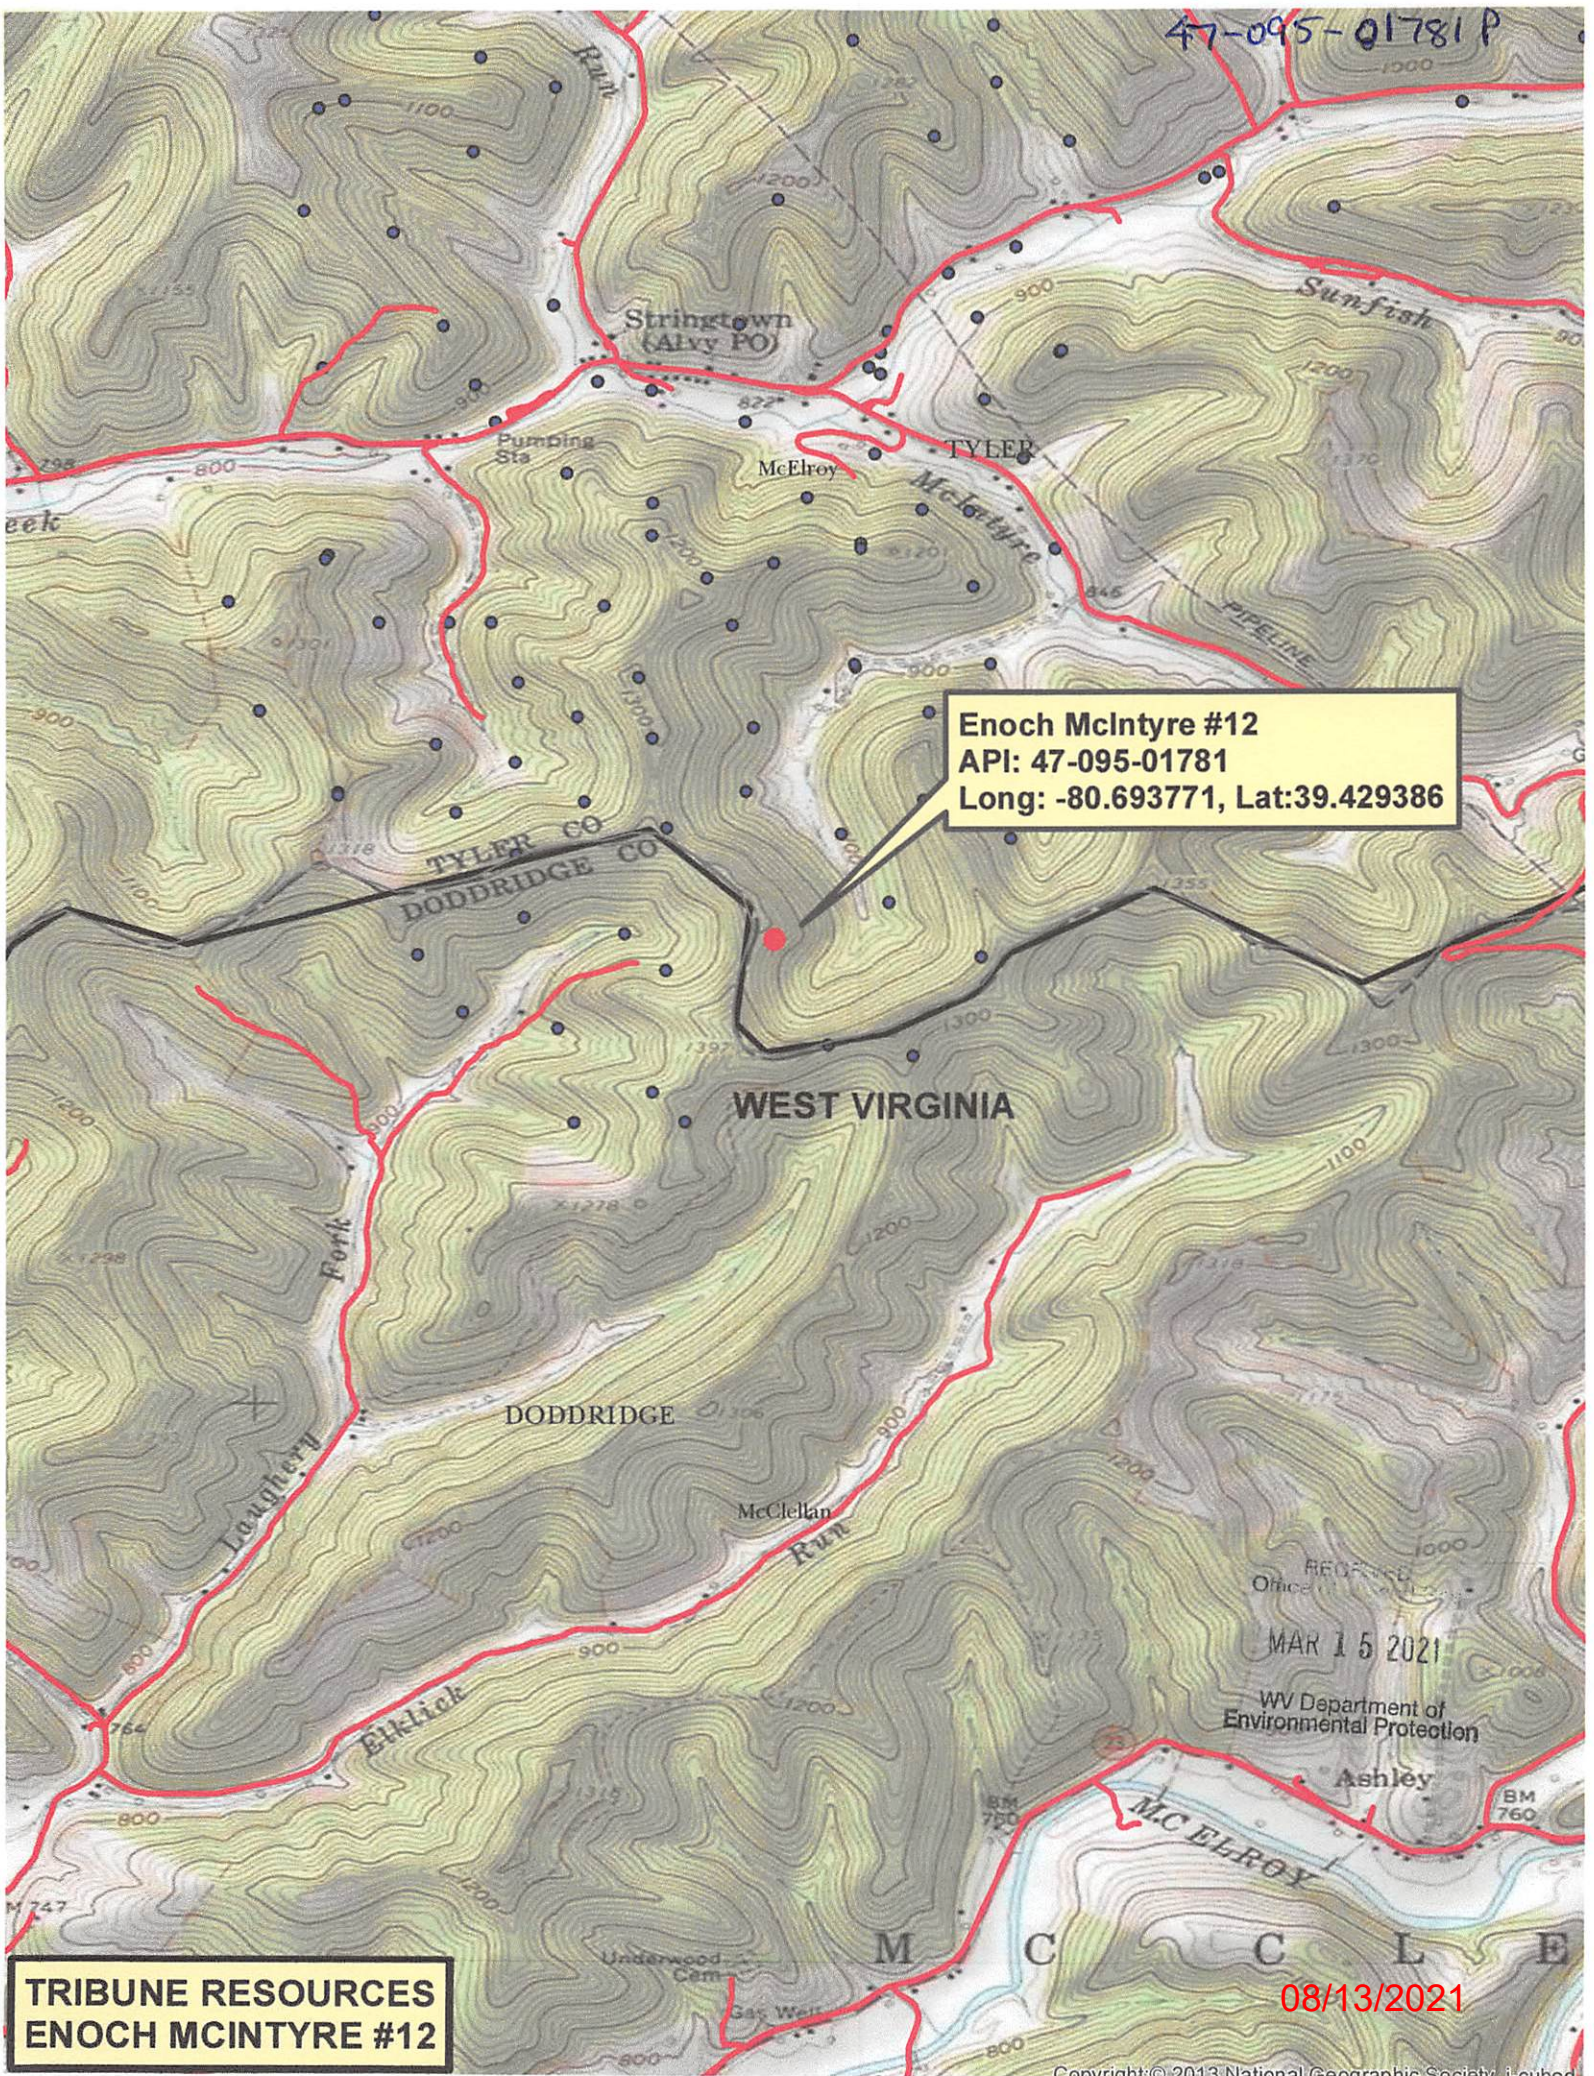

Enoch McIntyre #12
API: 47-095-01781
Long: -80.693771, Lat:39.429386

TRIBUNE RESOURCES
ENOCH MCINTYRE #12

08/13/2021

RECEIVED
 Office
 MAR 15 2021
 WV Department of
 Environmental Protection