
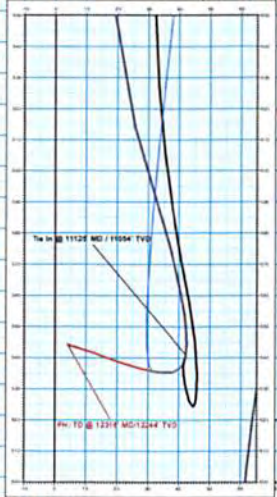


WELL DETAILS: RPT 8-4U			

Company Name: Jay-Bee Oil & Gas
 RPT 8-4U
 Tyler County
 Rig: Nomas #81
 Created By: WS Jircik
 Date: 3/27/2017

RPT 8-4U
 Tyler County
 Q170149 & AM-170119
 Design #5

PROJECT DETAILS: Tyler County			
Geoidic System	US State Plane 1983	Datum	North American Datum 1983
Ellipsoid	GRS 1980	Zone	West Virginia Northern Zone
System Datum	Mean Sea Level		

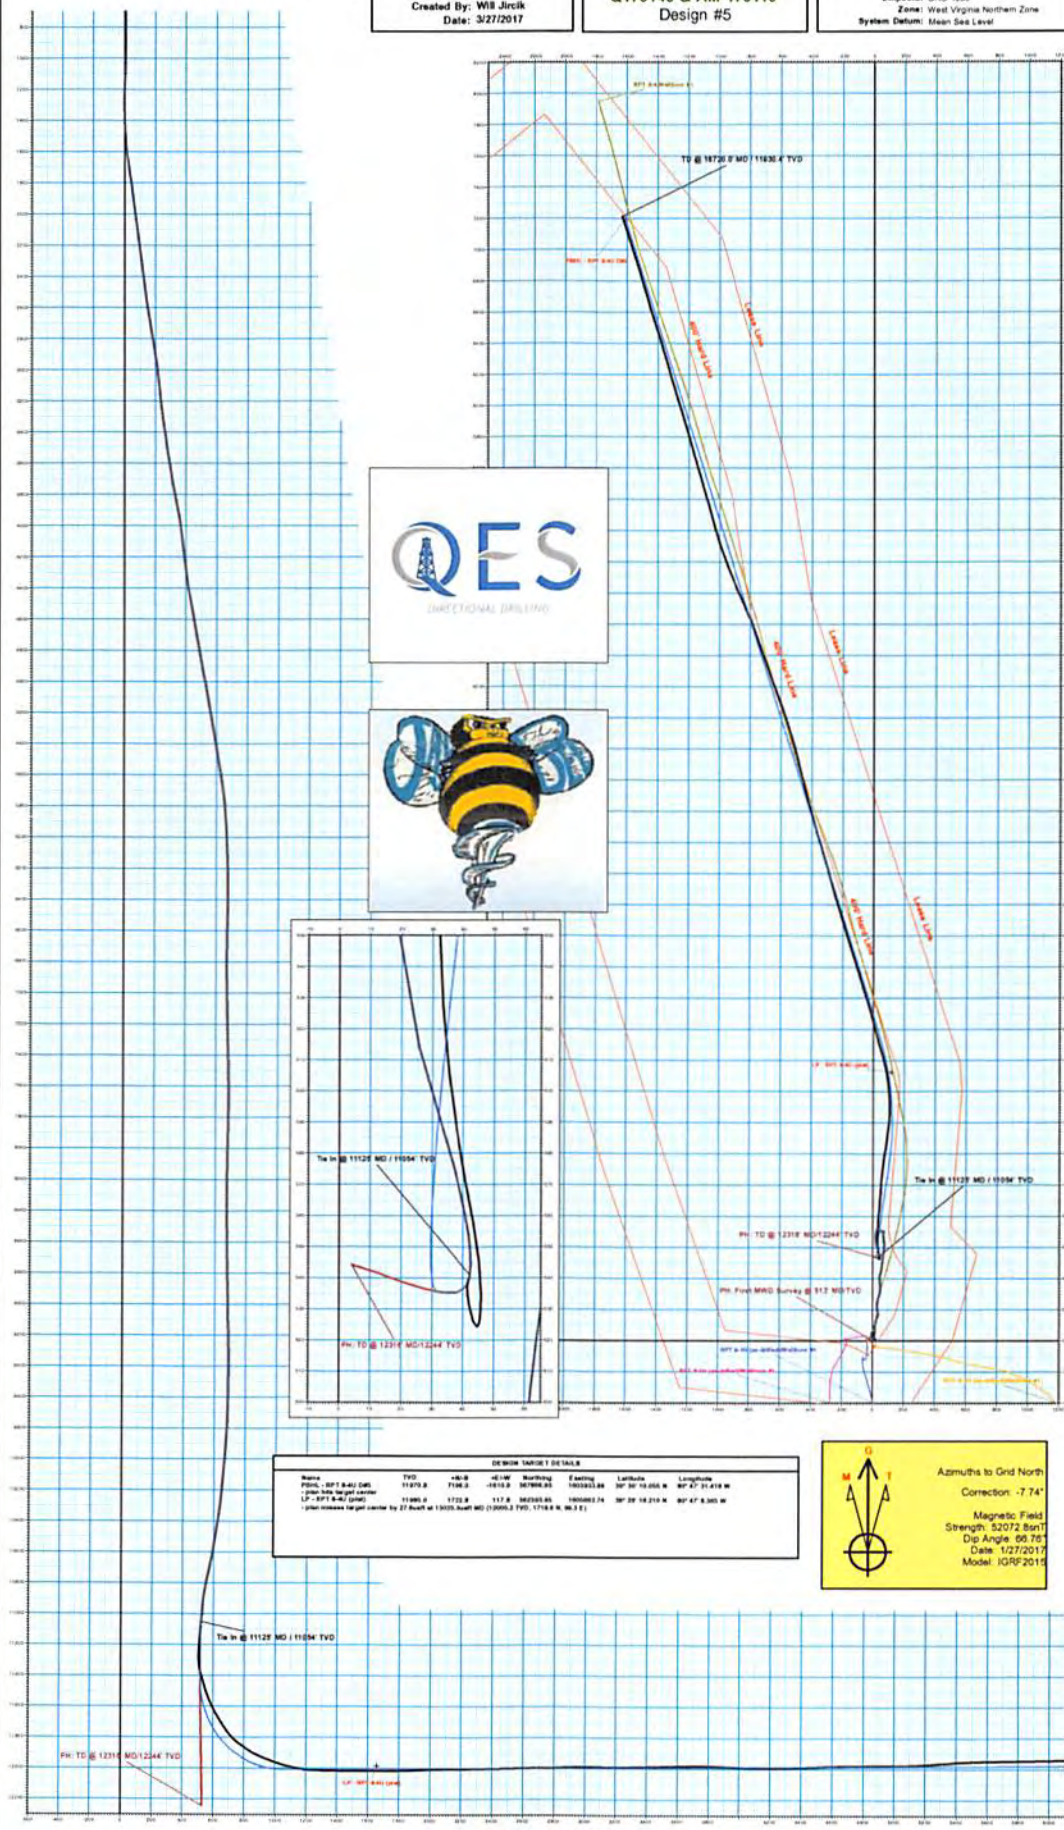




Jay-Bee Oil & Gas

Tyler County
Jack Hair et al
RPT 8-4U

Pilot

Survey: MWD

QES Survey Report

27 March, 2017



Survey Report

05/03/2019



Company:	Jay-Bee Oil & Gas	Local Co-ordinate Reference:	Well RPT 8-4U
Project:	Tyler County	TVD Reference:	well @ 1267.1usft (Nomac #81)
Site:	Jack Hair et al	MD Reference:	well @ 1267.1usft (Nomac #81)
Well:	RPT 8-4U	North Reference:	Grid
Wellbore:	Pilot	Survey Calculation Method:	Minimum Curvature
Design:	Pilot	Database:	EDM5002

Project	Tyler County		
Map System:	US State Plane 1983	System Datum:	Mean Sea Level
Geo Datum:	North American Datum 1983		
Map Zone:	West Virginia Northern Zone		

Site	Jack Hair et al				
Site Position:		Northing:	360,680.39 usft	Latitude:	39° 28' 59.261 N
From:	Lat/Long	Easting:	1,605,541.96 usft	Longitude:	80° 47' 9.593 W
Position Uncertainty:	0.0 usft	Slot Radius:	13-3/16 "	Grid Convergence:	-0.82 °

Well	RPT 8-4U					
Well Position	+N/-S	0.0 usft	Northing:	360,670.87 usft	Latitude:	39° 28' 59.167 N
	+E/-W	0.0 usft	Easting:	1,605,544.93 usft	Longitude:	80° 47' 9.553 W
Position Uncertainty		0.0 usft	Wellhead Elevation:	0.0 usft	Ground Level:	1,246.5 usft

Wellbore	Pilot				
Magnetics	Model Name	Sample Date	Declination (°)	Dip Angle (°)	Field Strength (nT)
	IGRF2015	2/17/2017	-8.56	66.76	52,066

Design	Pilot				
Audit Notes:					
Version:	1.0	Phase:	ACTUAL	Tie On Depth:	0.0
Vertical Section:	Depth From (TVD) (usft)	+N/-S (usft)	+E/-W (usft)	Direction (°)	
	0.0	0.0	0.0	0.44	

Survey Program	Date 3/16/2017				
From (usft)	To (usft)	Survey (Wellbore)	Tool Name	Description	
513.0	12,316.0	MWD (Pilot)	MWD default	MWD - Standard	

Measured Depth (usft)	Inclination (°)	Azimuth (°)	Vertical Depth (usft)	+N/-S (usft)	+E/-W (usft)	Vertical Section (usft)	Dogleg Rate (°/100usft)	Build Rate (°/100usft)	Turn Rate (°/100usft)	
0.0	0.00	0.00	0.0	0.0	0.0	0.0	0.00	0.00	0.00	
PH: First MWD Survey @ 513' MD/TVD										
513.0	0.82	0.00	513.0	3.7	0.0	3.7	0.16	0.16	0.00	
608.0	2.84	68.30	607.9	5.2	2.2	5.2	2.79	2.13	71.89	
703.0	2.65	58.17	702.8	7.2	6.2	7.3	0.55	-0.20	-10.66	
798.0	2.26	68.34	797.7	9.1	9.8	9.2	0.61	-0.41	10.71	
892.0	0.53	108.56	891.7	9.6	12.0	9.7	2.01	-1.84	42.79	
987.0	1.67	201.13	986.7	8.2	11.9	8.3	1.87	1.20	97.44	
1,081.0	2.32	187.53	1,080.6	5.0	11.2	5.1	0.85	0.69	-14.47	
1,176.0	2.19	176.73	1,175.6	1.3	11.0	1.4	0.47	-0.14	-11.37	
1,223.0	1.23	263.20	1,222.6	0.4	10.6	0.5	5.20	-2.04	183.98	



Survey Report

Company:	Jay-Bee Oil & Gas	Local Co-ordinate Reference:	Well RPT 8-4U
Project:	Tyler County	TVD Reference:	well @ 1267.1usft (Nomac #81)
Site:	Jack Hair et al	MD Reference:	well @ 1267.1usft (Nomac #81)
Well:	RPT 8-4U	North Reference:	Grid
Wellbore:	Pilot	Survey Calculation Method:	Minimum Curvature
Design:	Pilot	Database:	EDM5002

Survey

Measured Depth (usft)	Inclination (°)	Azimuth (°)	Vertical Depth (usft)	+N/-S (usft)	+E/-W (usft)	Vertical Section (usft)	Dogleg Rate (°/100usft)	Build Rate (°/100usft)	Turn Rate (°/100usft)
1,271.0	0.79	242.98	1,270.5	0.2	9.8	0.2	1.17	-0.92	-42.13
1,318.0	0.27	324.80	1,317.5	0.1	9.4	0.2	1.70	-1.11	174.09
1,366.0	1.06	349.18	1,365.5	0.6	9.3	0.7	1.71	1.65	50.79
1,413.0	2.12	15.09	1,412.5	1.9	9.4	2.0	2.67	2.26	55.13
1,461.0	3.69	24.61	1,460.5	4.2	10.3	4.2	3.41	3.27	19.83
1,508.0	4.89	15.61	1,507.3	7.5	11.4	7.6	2.92	2.55	-19.15
1,556.0	6.17	17.57	1,555.1	11.9	12.8	12.0	2.70	2.67	4.08
1,603.0	7.49	13.55	1,601.8	17.3	14.2	17.4	2.99	2.81	-8.55
1,650.0	8.65	7.43	1,648.3	23.8	15.4	23.9	3.07	2.47	-13.02
1,697.0	8.64	7.07	1,694.8	30.8	16.3	30.9	0.12	-0.02	-0.77
1,745.0	8.13	1.18	1,742.3	37.7	16.8	37.9	2.08	-1.06	-12.27
1,792.0	8.19	358.93	1,788.8	44.4	16.8	44.5	0.69	0.13	-4.79
1,840.0	8.11	359.89	1,836.3	51.2	16.8	51.3	0.33	-0.17	2.00
1,887.0	8.22	356.94	1,882.8	57.9	16.6	58.0	0.92	0.23	-6.28
1,935.0	8.13	357.20	1,930.3	64.7	16.2	64.8	0.20	-0.19	0.54
1,982.0	7.77	356.62	1,976.9	71.2	15.9	71.3	0.78	-0.77	-1.23
2,030.0	7.45	3.05	2,024.5	77.5	15.9	77.7	1.89	-0.67	13.40
2,077.0	7.46	6.49	2,071.1	83.6	16.4	83.7	0.95	0.02	7.32
2,125.0	7.79	7.45	2,118.6	89.9	17.1	90.1	0.74	0.69	2.00
2,219.0	8.46	13.64	2,211.7	103.0	19.6	103.1	1.17	0.71	6.59
2,508.0	7.86	11.95	2,497.8	143.0	28.7	143.2	0.22	-0.21	-0.58
2,603.0	9.23	7.05	2,591.7	156.9	31.0	157.1	1.63	1.44	-5.16
2,698.0	9.84	6.60	2,685.4	172.5	32.8	172.8	0.65	0.64	-0.47
2,792.0	10.33	359.56	2,777.9	188.9	33.7	189.2	1.41	0.52	-7.49
2,887.0	9.28	354.07	2,871.6	205.1	32.8	205.3	1.48	-1.11	-5.78
2,982.0	7.51	349.70	2,965.5	218.8	30.9	219.0	1.98	-1.86	-4.60
3,077.0	6.00	356.02	3,059.9	229.8	29.5	230.1	1.77	-1.59	6.65
3,172.0	6.76	7.65	3,154.3	240.3	29.9	240.6	1.57	0.80	12.24
3,266.0	7.91	12.70	3,247.5	252.1	32.0	252.4	1.40	1.22	5.37
3,361.0	8.79	16.58	3,341.5	265.5	35.6	265.7	1.10	0.93	4.08
3,456.0	9.43	16.22	3,435.3	279.9	39.8	280.2	0.68	0.67	-0.38
3,551.0	10.14	16.17	3,528.9	295.4	44.3	295.7	0.75	0.75	-0.05
3,649.0	9.98	13.32	3,625.4	312.0	48.7	312.3	0.53	-0.16	-2.91
3,743.0	9.91	3.17	3,718.0	328.0	51.0	328.3	1.66	-0.07	-10.80
3,838.0	11.53	353.28	3,811.4	345.6	50.3	345.9	2.57	1.71	-10.41
3,933.0	11.35	355.51	3,904.5	364.3	48.5	364.7	0.50	-0.19	2.35
4,027.0	9.38	356.97	3,996.9	381.2	47.4	381.5	2.11	-2.10	1.55
4,122.0	7.79	0.89	4,090.9	395.3	47.0	395.7	1.78	-1.67	4.13
4,217.0	7.38	3.69	4,185.0	407.9	47.5	408.2	0.58	-0.43	2.95
4,311.0	8.49	9.14	4,278.1	420.7	49.0	421.1	1.43	1.18	5.80
4,406.0	10.09	13.01	4,371.9	435.8	52.0	436.2	1.81	1.68	4.07
4,501.0	10.14	10.97	4,465.4	452.1	55.5	452.5	0.38	0.05	-2.15
4,596.0	10.85	6.54	4,558.8	469.2	58.1	469.6	1.13	0.75	-4.66



Survey Report

Company:	Jay-Bee Oil & Gas	Local Co-ordinate Reference:	Well RPT 8-4U
Project:	Tyler County	TVD Reference:	well @ 1267.1usft (Nomac #81)
Site:	Jack Hair et al	MD Reference:	well @ 1267.1usft (Nomac #81)
Well:	RPT 8-4U	North Reference:	Grid
Wellbore:	Pilot	Survey Calculation Method:	Minimum Curvature
Design:	Pilot	Database:	EDM5002

Survey										
Measured Depth (usft)	Inclination (°)	Azimuth (°)	Vertical Depth (usft)	+N/-S (usft)	+E/-W (usft)	Vertical Section (usft)	Dogleg Rate (°/100usft)	Build Rate (°/100usft)	Turn Rate (°/100usft)	
4,693.0	10.52	6.10	4,654.2	487.1	60.1	487.5	0.35	-0.34	-0.45	
4,788.0	10.57	5.87	4,747.5	504.4	61.9	504.8	0.07	0.05	-0.24	
4,883.0	10.02	7.04	4,841.0	521.2	63.8	521.7	0.62	-0.58	1.23	
4,978.0	11.33	7.90	4,934.4	538.7	66.1	539.2	1.39	1.38	0.91	
5,073.0	11.38	6.92	5,027.5	557.2	68.5	557.7	0.21	0.05	-1.03	
5,168.0	10.67	7.75	5,120.8	575.2	70.8	575.8	0.77	-0.75	0.87	
5,263.0	10.31	7.06	5,214.2	592.4	73.0	592.9	0.40	-0.38	-0.73	
5,358.0	10.49	3.07	5,307.6	609.5	74.6	610.0	0.78	0.19	-4.20	
5,453.0	9.40	357.62	5,401.2	625.8	74.7	626.4	1.51	-1.15	-5.74	
5,548.0	9.86	353.73	5,494.8	641.7	73.5	642.2	0.84	0.48	-4.09	
5,643.0	9.38	349.56	5,588.5	657.4	71.2	657.9	0.89	-0.51	-4.39	
5,737.0	7.33	353.94	5,681.5	670.9	69.2	671.4	2.28	-2.18	4.66	
5,832.0	6.79	355.65	5,775.8	682.5	68.1	683.0	0.61	-0.57	1.80	
5,927.0	4.90	355.35	5,870.3	692.2	67.3	692.6	1.99	-1.99	-0.32	
6,022.0	3.02	353.47	5,965.1	698.7	66.7	699.2	1.98	-1.98	-1.98	
6,117.0	1.50	358.90	6,060.0	702.4	66.4	702.9	1.61	-1.60	5.72	
6,211.0	0.48	20.02	6,154.0	704.0	66.5	704.5	1.13	-1.09	22.47	
6,306.0	0.60	324.20	6,249.0	704.8	66.4	705.3	0.54	0.13	-58.76	
6,401.0	0.49	123.07	6,344.0	705.0	66.4	705.5	1.13	-0.12	167.23	
6,496.0	0.98	108.98	6,439.0	704.5	67.5	705.0	0.55	0.52	-14.83	
6,686.0	2.27	118.81	6,628.9	702.1	72.4	702.7	0.69	0.68	5.17	
6,875.0	1.24	49.88	6,817.8	701.7	77.2	702.2	1.14	-0.54	-36.47	
7,065.0	0.82	297.12	7,007.8	703.6	77.6	704.2	0.91	-0.22	-59.35	
7,349.0	3.48	293.18	7,291.6	707.9	67.8	708.4	0.94	0.94	-1.39	
7,533.0	2.62	276.26	7,475.3	710.6	58.5	711.0	0.67	-0.47	-9.20	
7,722.0	2.56	256.59	7,664.1	710.1	50.1	710.4	0.47	-0.03	-10.41	
7,912.0	2.00	207.50	7,854.0	706.1	44.5	706.5	1.03	-0.29	-25.84	
8,102.0	1.25	182.60	8,043.9	701.1	42.8	701.4	0.53	-0.39	-13.11	
8,291.0	0.27	339.65	8,232.9	699.5	42.6	699.8	0.79	-0.52	83.10	
8,483.0	0.36	21.75	8,424.9	700.5	42.7	700.8	0.13	0.05	21.93	
8,672.0	0.68	20.84	8,613.9	702.1	43.3	702.4	0.17	0.17	-0.48	
8,862.0	1.15	359.44	8,803.9	705.0	43.7	705.3	0.30	0.25	-11.26	
9,051.0	1.05	297.82	8,992.8	707.7	42.1	708.0	0.60	-0.05	-32.60	
9,241.0	2.59	293.79	9,182.7	710.3	36.7	710.5	0.81	0.81	-2.12	
9,432.0	1.81	261.40	9,373.6	711.6	29.7	711.8	0.75	-0.41	-16.96	
9,609.0	1.32	219.65	9,550.5	709.6	25.7	709.8	0.68	-0.28	-23.59	
9,798.0	2.50	201.36	9,739.4	704.1	22.8	704.2	0.70	0.62	-9.68	
9,988.0	5.06	188.23	9,929.0	691.9	20.1	692.1	1.41	1.35	-6.91	
10,180.0	4.49	184.82	10,120.3	676.1	18.2	676.2	0.33	-0.30	-1.78	
10,369.0	7.12	177.45	10,308.3	657.0	18.1	657.1	1.44	1.39	-3.90	
10,653.0	10.48	165.09	10,589.0	614.4	25.5	614.6	1.35	1.18	-4.35	
10,792.0	13.10	162.70	10,725.0	587.2	33.5	587.4	1.92	1.88	-1.72	
10,840.0	13.00	163.70	10,771.8	576.8	36.6	577.0	0.51	-0.21	2.08	



Survey Report

05/03/2019



Company:	Jay-Bee Oil & Gas	Local Co-ordinate Reference:	Well RPT 8-4U
Project:	Tyler County	TVD Reference:	well @ 1267.1usft (Nomac #81)
Site:	Jack Hair et al	MD Reference:	well @ 1267.1usft (Nomac #81)
Well:	RPT 8-4U	North Reference:	Grid
Wellbore:	Pilot	Survey Calculation Method:	Minimum Curvature
Design:	Pilot	Database:	EDM5002

Measured Depth (usft)	Inclination (°)	Azimuth (°)	Vertical Depth (usft)	+N/-S (usft)	+E/-W (usft)	Vertical Section (usft)	Dogleg Rate (°/100usft)	Build Rate (°/100usft)	Turn Rate (°/100usft)
10,887.0	10.20	167.30	10,817.8	567.6	39.0	567.9	6.15	-5.96	7.66
10,935.0	8.30	168.40	10,865.2	560.1	40.6	560.4	3.98	-3.96	2.29
10,982.0	6.90	172.30	10,911.8	554.0	41.7	554.3	3.17	-2.98	8.30
11,030.0	5.60	175.20	10,959.5	548.8	42.3	549.1	2.79	-2.71	6.04
11,077.0	4.70	180.20	11,006.3	544.6	42.5	544.9	2.14	-1.91	10.64
11,125.0	3.80	189.50	11,054.2	541.0	42.2	541.4	2.36	-1.88	19.38
11,172.0	2.80	204.40	11,101.1	538.5	41.5	538.8	2.79	-2.13	31.70
11,220.0	2.00	221.50	11,149.1	536.8	40.4	537.1	2.22	-1.67	35.63
11,315.0	1.80	265.50	11,244.0	535.4	37.8	535.7	1.51	-0.21	46.32
11,409.0	2.00	273.10	11,338.0	535.4	34.7	535.6	0.34	0.21	8.09
11,504.0	1.90	278.70	11,432.9	535.7	31.5	535.9	0.23	-0.11	5.89
11,599.0	2.00	285.70	11,527.9	536.4	28.4	536.6	0.27	0.11	7.37
11,694.0	1.80	284.70	11,622.8	537.2	25.3	537.4	0.21	-0.21	-1.05
11,788.0	2.00	289.20	11,716.8	538.1	22.4	538.3	0.27	0.21	4.79
11,883.0	2.10	288.00	11,811.7	539.2	19.1	539.4	0.11	0.11	-1.26
11,978.0	2.20	292.60	11,906.6	540.5	15.8	540.6	0.21	0.11	4.84
12,073.0	2.00	288.60	12,001.6	541.7	12.5	541.8	0.26	-0.21	-4.21
12,167.0	2.20	286.30	12,095.5	542.7	9.3	542.8	0.23	0.21	-2.45
12,262.0	2.00	287.90	12,190.4	543.7	5.9	543.8	0.22	-0.21	1.68
PH: TD @ 12316' MD/12244' TVD									
12,316.0	2.00	287.90	12,244.4	544.3	4.1	544.3	0.00	0.00	0.00

Measured Depth (usft)	Vertical Depth (usft)	+N/-S (usft)	+E/-W (usft)	Comment
513.0	513.0	3.7	0.0	PH: First MWD Survey @ 513' MD/TVD
12,316.0	12,244.4	544.3	4.1	PH: TD @ 12316' MD/12244' TVD

Checked By: _____ Approved By: _____ Date: _____



Jay-Bee Oil & Gas

Tyler County
Jack Hair et al
RPT 8-4U

Wellbore #1

Design: Wellbore #1

QES Survey Report

01 March, 2017



Survey Report



Company:	Jay-Bee Oil & Gas	Local Co-ordinate Reference:	Well RPT 8-4U
Project:	Tyler County	TVD Reference:	well @ 1267.1usft (Nomac #81)
Site:	Jack Hair et al	MD Reference:	well @ 1267.1usft (Nomac #81)
Well:	RPT 8-4U	North Reference:	Grid
Wellbore:	Wellbore #1	Survey Calculation Method:	Minimum Curvature
Design:	Wellbore #1	Database:	EDM5002

Project	Tyler County	System Datum:	Mean Sea Level
Map System:	US State Plane 1983		
Geo Datum:	North American Datum 1983		
Map Zone:	West Virginia Northern Zone		

Site	Jack Hair et al				
Site Position:		Northing:	360,680.39 usft	Latitude:	39° 28' 59.261 N
From:	Lat/Long	Easting:	1,605,541.96 usft	Longitude:	80° 47' 9.593 W
Position Uncertainty:	0.0 usft	Slot Radius:	13-3/16 "	Grid Convergence:	-0.82 °

Well	RPT 8-4U					
Well Position	+N/-S	0.0 usft	Northing:	360,670.87 usft	Latitude:	39° 28' 59.167 N
	+E/-W	0.0 usft	Easting:	1,605,544.93 usft	Longitude:	80° 47' 9.553 W
Position Uncertainty		0.0 usft	Wellhead Elevation:	0.0 usft	Ground Level:	1,246.5 usft

Wellbore	Wellbore #1				
Magnetics	Model Name	Sample Date	Declination (°)	Dip Angle (°)	Field Strength (nT)
	IGRF2015	1/27/2017	-8.56	66.76	52,073

Design	Wellbore #1				
Audit Notes:					
Version:	1.0	Phase:	ACTUAL	Tie On Depth:	11,125.0
Vertical Section:	Depth From (TVD) (usft)	+N/-S (usft)	+E/-W (usft)	Direction (°)	
	0.0	0.0	0.0	347.38	

Survey Program	Date	3/1/2017		
From (usft)	To (usft)	Survey (Wellbore)	Tool Name	Description
513.0	11,125.0	MWD (Pilot)	MWD default	MWD - Standard
11,151.0	18,720.0	MWD Surveys (Wellbore #1)	MWD default	MWD - Standard

Survey									
Measured Depth (usft)	Inclination (°)	Azimuth (°)	Vertical Depth (usft)	+N/-S (usft)	+E/-W (usft)	Vertical Section (usft)	Dogleg Rate (°/100usft)	Build Rate (°/100usft)	Turn Rate (°/100usft)
0.0	0.00	0.00	0.0	0.0	0.0	0.0	0.00	0.00	0.00
513.0	0.82	0.00	513.0	3.7	0.0	3.6	0.16	0.16	0.00
608.0	2.84	68.30	607.9	5.2	2.2	4.6	2.79	2.13	71.89
703.0	2.65	58.17	702.8	7.2	6.2	5.7	0.55	-0.20	-10.66
798.0	2.26	68.34	797.7	9.1	9.8	6.7	0.61	-0.41	10.71
892.0	0.53	108.56	891.7	9.6	12.0	6.8	2.01	-1.84	42.79
987.0	1.67	201.13	986.7	8.2	11.9	5.4	1.87	1.20	97.44
1,081.0	2.32	187.53	1,080.6	5.0	11.2	2.5	0.85	0.69	-14.47
1,176.0	2.19	176.73	1,175.6	1.3	11.0	-1.1	0.47	-0.14	-11.37
1,223.0	1.23	263.20	1,222.6	0.4	10.6	-1.9	5.20	-2.04	183.98



Survey Report



Company:	Jay-Bee Oil & Gas	Local Co-ordinate Reference:	Well RPT 8-4U
Project:	Tyler County	TVD Reference:	well @ 1267.1usft (Nomac #81)
Site:	Jack Hair et al	MD Reference:	well @ 1267.1usft (Nomac #81)
Well:	RPT 8-4U	North Reference:	Grid
Wellbore:	Wellbore #1	Survey Calculation Method:	Minimum Curvature
Design:	Wellbore #1	Database:	EDM5002

Survey									
Measured Depth (usft)	Inclination (°)	Azimuth (°)	Vertical Depth (usft)	+N/-S (usft)	+E/-W (usft)	Vertical Section (usft)	Dogleg Rate (°/100usft)	Build Rate (°/100usft)	Turn Rate (°/100usft)
1,271.0	0.79	242.98	1,270.5	0.2	9.8	-2.0	1.17	-0.92	-42.13
1,318.0	0.27	324.80	1,317.5	0.1	9.4	-1.9	1.70	-1.11	174.09
1,366.0	1.06	349.18	1,365.5	0.6	9.3	-1.4	1.71	1.65	50.79
1,413.0	2.12	15.09	1,412.5	1.9	9.4	-0.2	2.67	2.26	55.13
1,461.0	3.69	24.61	1,460.5	4.2	10.3	1.8	3.41	3.27	19.83
1,508.0	4.89	15.61	1,507.3	7.5	11.4	4.8	2.92	2.55	-19.15
1,556.0	6.17	17.57	1,555.1	11.9	12.8	8.8	2.70	2.67	4.08
1,603.0	7.49	13.55	1,601.8	17.3	14.2	13.8	2.99	2.81	-8.55
1,650.0	8.65	7.43	1,648.3	23.8	15.4	19.8	3.07	2.47	-13.02
1,697.0	8.64	7.07	1,694.8	30.8	16.3	26.5	0.12	-0.02	-0.77
1,745.0	8.13	1.18	1,742.3	37.7	16.8	33.2	2.08	-1.06	-12.27
1,792.0	8.19	358.93	1,788.8	44.4	16.8	39.7	0.69	0.13	-4.79
1,840.0	8.11	359.89	1,836.3	51.2	16.8	46.3	0.33	-0.17	2.00
1,887.0	8.22	356.94	1,882.8	57.9	16.6	52.9	0.92	0.23	-6.28
1,935.0	8.13	357.20	1,930.3	64.7	16.2	59.6	0.20	-0.19	0.54
1,982.0	7.77	356.62	1,976.9	71.2	15.9	66.0	0.78	-0.77	-1.23
2,030.0	7.45	3.05	2,024.5	77.5	15.9	72.2	1.89	-0.67	13.40
2,077.0	7.46	6.49	2,071.1	83.6	16.4	78.0	0.95	0.02	7.32
2,125.0	7.79	7.45	2,118.6	89.9	17.1	84.0	0.74	0.69	2.00
2,219.0	8.46	13.64	2,211.7	103.0	19.6	96.2	1.17	0.71	6.59
2,508.0	7.86	11.95	2,497.8	143.0	28.7	133.2	0.22	-0.21	-0.58
2,603.0	9.23	7.05	2,591.7	156.9	31.0	146.3	1.63	1.44	-5.16
2,698.0	9.84	6.60	2,685.4	172.5	32.8	161.2	0.65	0.64	-0.47
2,792.0	10.33	359.56	2,777.9	188.9	33.7	177.0	1.41	0.52	-7.49
2,887.0	9.28	354.07	2,871.6	205.1	32.8	192.9	1.48	-1.11	-5.78
2,982.0	7.51	349.70	2,965.5	218.8	30.9	206.7	1.98	-1.86	-4.60
3,077.0	6.00	356.02	3,059.9	229.8	29.5	217.9	1.77	-1.59	6.65
3,172.0	6.76	7.65	3,154.3	240.3	29.9	228.0	1.57	0.80	12.24
3,266.0	7.91	12.70	3,247.5	252.1	32.0	239.0	1.40	1.22	5.37
3,361.0	8.79	16.58	3,341.5	265.5	35.6	251.3	1.10	0.93	4.08
3,456.0	9.43	16.22	3,435.3	279.9	39.8	264.4	0.68	0.67	-0.38
3,551.0	10.14	16.17	3,528.9	295.4	44.3	278.6	0.75	0.75	-0.05
3,649.0	9.98	13.32	3,625.4	312.0	48.7	293.8	0.53	-0.16	-2.91
3,743.0	9.91	3.17	3,718.0	328.0	51.0	308.9	1.86	-0.07	-10.80
3,838.0	11.53	353.28	3,811.4	345.6	50.3	326.2	2.57	1.71	-10.41
3,933.0	11.35	355.51	3,904.5	364.3	48.5	344.9	0.50	-0.19	2.35
4,027.0	9.38	356.97	3,996.9	381.2	47.4	361.6	2.11	-2.10	1.55
4,122.0	7.79	0.89	4,090.9	395.3	47.0	375.5	1.78	-1.67	4.13
4,217.0	7.38	3.69	4,185.0	407.9	47.5	387.6	0.58	-0.43	2.95
4,311.0	8.49	9.14	4,278.1	420.7	49.0	399.9	1.43	1.18	5.80
4,406.0	10.09	13.01	4,371.9	435.8	52.0	413.9	1.81	1.68	4.07
4,501.0	10.14	10.97	4,465.4	452.1	55.5	429.1	0.38	0.05	-2.15
4,596.0	10.85	6.54	4,558.8	469.2	58.1	445.2	1.13	0.75	-4.66



Survey Report

Company:	Jay-Bee Oil & Gas	Local Co-ordinate Reference:	Well RPT 8-4U
Project:	Tyler County	TVD Reference:	well @ 1267.1usft (Nomac #81)
Site:	Jack Hair et al	MD Reference:	well @ 1267.1usft (Nomac #81)
Well:	RPT 8-4U	North Reference:	Grid
Wellbore:	Wellbore #1	Survey Calculation Method:	Minimum Curvature
Design:	Wellbore #1	Database:	EDM5002

Measured Depth (usft)	Inclination (°)	Azimuth (°)	Vertical Depth (usft)	+N/-S (usft)	+E/-W (usft)	Vertical Section (usft)	Dogleg Rate (°/100usft)	Build Rate (°/100usft)	Turn Rate (°/100usft)
4,693.0	10.52	6.10	4,654.2	487.1	60.1	462.2	0.35	-0.34	-0.45
4,788.0	10.57	5.87	4,747.5	504.4	61.9	478.6	0.07	0.05	-0.24
4,883.0	10.02	7.04	4,841.0	521.2	63.8	494.7	0.62	-0.58	1.23
4,978.0	11.33	7.90	4,934.4	538.7	66.1	511.2	1.39	1.38	0.91
5,073.0	11.38	6.92	5,027.5	557.2	68.5	528.8	0.21	0.05	-1.03
5,168.0	10.67	7.75	5,120.8	575.2	70.8	545.9	0.77	-0.75	0.87
5,263.0	10.31	7.06	5,214.2	592.4	73.0	562.1	0.40	-0.38	-0.73
5,358.0	10.49	3.07	5,307.6	609.5	74.6	578.4	0.78	0.19	-4.20
5,453.0	9.40	357.62	5,401.2	625.8	74.7	594.4	1.51	-1.15	-5.74
5,548.0	9.86	353.73	5,494.8	641.7	73.5	610.1	0.84	0.48	-4.09
5,643.0	9.38	349.56	5,588.5	657.4	71.2	625.9	0.89	-0.51	-4.39
5,737.0	7.33	353.94	5,681.5	670.9	69.2	639.6	2.28	-2.18	4.66
5,832.0	6.79	355.65	5,775.8	682.5	68.1	651.1	0.61	-0.57	1.80
5,927.0	4.90	355.35	5,870.3	692.2	67.3	660.7	1.99	-1.99	-0.32
6,022.0	3.02	353.47	5,965.1	698.7	66.7	667.2	1.98	-1.98	-1.98
6,117.0	1.50	358.90	6,060.0	702.4	66.4	670.9	1.61	-1.60	5.72
6,211.0	0.48	20.02	6,154.0	704.0	66.5	672.5	1.13	-1.09	22.47
6,306.0	0.60	324.20	6,249.0	704.8	66.4	673.3	0.54	0.13	-58.76
6,401.0	0.49	123.07	6,344.0	705.0	66.4	673.4	1.13	-0.12	167.23
6,496.0	0.98	108.98	6,439.0	704.5	67.5	672.7	0.55	0.52	-14.83
6,686.0	2.27	118.81	6,628.9	702.1	72.4	669.4	0.69	0.68	5.17
6,875.0	1.24	49.88	6,817.8	701.7	77.2	667.8	1.14	-0.54	-36.47
7,065.0	0.82	297.12	7,007.8	703.6	77.6	669.7	0.91	-0.22	-59.35
7,349.0	3.48	293.18	7,291.6	707.9	67.8	676.0	0.94	0.94	-1.39
7,533.0	2.62	276.26	7,475.3	710.6	58.5	680.6	0.67	-0.47	-9.20
7,722.0	2.56	256.59	7,664.1	710.1	50.1	682.0	0.47	-0.03	-10.41
7,912.0	2.00	207.50	7,854.0	706.1	44.5	679.4	1.03	-0.29	-25.84
8,102.0	1.25	182.60	8,043.9	701.1	42.8	674.8	0.53	-0.39	-13.11
8,291.0	0.27	339.65	8,232.9	699.5	42.6	673.3	0.79	-0.52	83.10
8,483.0	0.36	21.75	8,424.9	700.5	42.7	674.2	0.13	0.05	21.93
8,672.0	0.68	20.84	8,613.9	702.1	43.3	675.7	0.17	0.17	-0.48
8,862.0	1.15	359.44	8,803.9	705.0	43.7	678.5	0.30	0.25	-11.26
9,051.0	1.05	297.82	8,992.8	707.7	42.1	681.4	0.60	-0.05	-32.60
9,241.0	2.59	293.79	9,182.7	710.3	36.7	685.1	0.81	0.81	-2.12
9,432.0	1.81	261.40	9,373.6	711.6	29.7	687.9	0.75	-0.41	-16.96
9,609.0	1.32	219.65	9,550.5	709.6	25.7	686.8	0.68	-0.28	-23.59
9,798.0	2.50	201.36	9,739.4	704.1	22.8	682.1	0.70	0.62	-9.68
9,988.0	5.06	188.23	9,929.0	691.9	20.1	670.8	1.41	1.35	-6.91
10,180.0	4.49	184.82	10,120.3	676.1	18.2	655.7	0.33	-0.30	-1.78
10,369.0	7.12	177.45	10,308.3	657.0	18.1	637.1	1.44	1.39	-3.90
10,653.0	10.48	165.09	10,589.0	614.4	25.5	594.0	1.35	1.18	-4.35
10,792.0	13.10	162.70	10,725.0	587.2	33.5	565.7	1.92	1.88	-1.72
10,840.0	13.00	163.70	10,771.8	576.8	36.6	554.8	0.51	-0.21	2.08



Survey Report

Company:	Jay-Bee Oil & Gas	Local Co-ordinate Reference:	Well RPT 8-4U
Project:	Tyler County	TVD Reference:	well @ 1267.1usft (Nomac #81)
Site:	Jack Hair et al	MD Reference:	well @ 1267.1usft (Nomac #81)
Well:	RPT 8-4U	North Reference:	Grid
Wellbore:	Wellbore #1	Survey Calculation Method:	Minimum Curvature
Design:	Wellbore #1	Database:	EDM5002

Survey										
Measured Depth (usft)	Inclination (°)	Azimuth (°)	Vertical Depth (usft)	+N/-S (usft)	+E/-W (usft)	Vertical Section (usft)	Dogleg Rate (°/100usft)	Build Rate (°/100usft)	Turn Rate (°/100usft)	
10,887.0	10.20	167.30	10,817.8	567.6	39.0	545.4	6.15	-5.96	7.66	
10,935.0	8.30	168.40	10,865.2	560.1	40.6	537.7	3.98	-3.96	2.29	
10,982.0	6.90	172.30	10,911.8	554.0	41.7	531.5	3.17	-2.98	8.30	
11,030.0	5.60	175.20	10,959.5	548.8	42.3	526.3	2.79	-2.71	6.04	
11,077.0	4.70	180.20	11,006.3	544.6	42.5	522.1	2.14	-1.91	10.64	
Tie In @ 11125' MD / 11054' TVD										
11,125.0	3.80	189.50	11,054.2	541.0	42.2	518.8	2.36	-1.88	19.38	
11,151.0	3.30	197.10	11,080.1	539.5	41.8	517.3	2.64	-1.92	29.23	
11,183.0	4.00	186.90	11,112.1	537.5	41.4	515.5	2.98	2.19	-31.88	
11,214.0	6.20	172.80	11,143.0	534.8	41.5	512.8	8.12	7.10	-45.48	
11,246.0	6.80	169.30	11,174.7	531.2	42.1	509.2	2.25	1.88	-10.94	
11,293.0	5.50	162.70	11,221.5	526.3	43.3	504.1	3.14	-2.77	-14.04	
11,341.0	1.60	72.20	11,269.4	524.3	44.6	501.9	11.96	-8.13	-188.54	
11,388.0	7.10	6.30	11,316.3	527.4	45.5	504.7	14.06	11.70	-140.21	
11,435.0	11.50	359.60	11,362.6	535.0	45.8	512.0	9.63	9.36	-14.26	
11,482.0	14.10	354.00	11,408.5	545.4	45.2	522.3	6.12	5.53	-11.91	
11,530.0	16.20	349.00	11,454.8	557.7	43.3	534.8	5.15	4.38	-10.42	
11,577.0	18.40	349.20	11,499.7	571.5	40.7	548.8	4.68	4.68	0.43	
11,625.0	21.80	350.70	11,544.7	587.7	37.8	565.2	7.16	7.08	3.13	
11,672.0	25.10	353.50	11,587.8	606.2	35.3	583.9	7.41	7.02	5.96	
11,720.0	27.90	355.90	11,630.8	627.6	33.3	605.1	6.24	5.83	5.00	
11,767.0	30.90	358.80	11,671.7	650.6	32.3	627.8	7.06	6.38	6.17	
11,814.0	33.50	2.00	11,711.5	675.6	32.5	652.2	6.61	5.53	6.81	
11,909.0	42.10	3.30	11,786.5	733.7	35.2	708.3	9.09	9.05	1.37	
12,004.0	53.50	4.00	11,850.2	803.8	39.7	775.7	12.01	12.00	0.74	
12,098.0	61.80	5.30	11,900.5	882.9	46.2	851.5	8.91	8.83	1.38	
12,193.0	70.00	3.00	11,939.2	969.3	52.4	934.5	8.91	8.63	-2.42	
12,240.0	71.40	4.80	11,954.8	1,013.6	55.4	977.0	4.68	2.98	3.83	
12,288.0	72.40	5.80	11,969.7	1,059.0	59.7	1,020.4	2.87	2.08	2.08	
12,335.0	73.90	5.90	11,983.3	1,103.8	64.2	1,063.1	3.20	3.19	0.21	
12,383.0	77.00	7.00	11,995.4	1,149.9	69.5	1,107.0	6.83	6.46	2.29	
12,430.0	81.80	9.20	12,004.0	1,195.6	76.0	1,150.2	11.20	10.21	4.68	
12,478.0	85.30	10.20	12,009.4	1,242.6	84.0	1,194.3	7.58	7.29	2.08	
12,572.0	87.30	6.60	12,015.5	1,335.4	97.7	1,281.8	4.37	2.13	-3.83	
12,667.0	89.60	3.10	12,018.0	1,430.0	105.7	1,372.4	4.41	2.42	-3.68	
12,762.0	89.30	358.40	12,019.0	1,525.0	107.0	1,464.8	4.96	-0.32	-4.95	
12,857.0	91.10	354.40	12,018.6	1,619.8	101.0	1,558.6	4.62	1.89	-4.21	
12,951.0	89.70	350.10	12,018.0	1,712.9	88.3	1,652.2	4.81	-1.49	-4.57	
13,046.0	89.60	344.50	12,018.5	1,805.5	67.5	1,747.2	5.90	-0.11	-5.89	
13,140.0	92.00	344.40	12,017.2	1,896.1	42.3	1,841.0	2.56	2.55	-0.11	
13,235.0	92.70	344.40	12,013.3	1,987.5	16.7	1,935.8	0.74	0.74	0.00	
13,330.0	92.70	342.60	12,008.9	2,078.5	-10.2	2,030.5	1.89	0.00	-1.89	
13,425.0	90.10	343.40	12,006.5	2,169.3	-38.0	2,125.2	2.86	-2.74	0.84	
13,519.0	90.90	343.20	12,005.7	2,259.3	-65.0	2,218.9	0.88	0.85	-0.21	



Survey Report

Company:	Jay-Bee Oil & Gas	Local Co-ordinate Reference:	Well RPT 8-4U
Project:	Tyler County	TVD Reference:	well @ 1267.1usft (Nomac #81)
Site:	Jack Hair et al	MD Reference:	well @ 1267.1usft (Nomac #81)
Well:	RPT 8-4U	North Reference:	Grid
Wellbore:	Wellbore #1	Survey Calculation Method:	Minimum Curvature
Design:	Wellbore #1	Database:	EDM5002

Survey										
Measured Depth (usft)	Inclination (°)	Azimuth (°)	Vertical Depth (usft)	+N/-S (usft)	+E/-W (usft)	Vertical Section (usft)	Dogleg Rate (°/100usft)	Build Rate (°/100usft)	Turn Rate (°/100usft)	
13,614.0	91.00	342.90	12,004.1	2,350.2	-92.7	2,313.7	0.33	0.11	-0.32	
13,709.0	91.10	342.00	12,002.4	2,440.7	-121.3	2,408.3	0.95	0.11	-0.95	
13,804.0	91.80	342.10	12,000.0	2,531.1	-150.6	2,502.8	0.74	0.74	0.11	
13,899.0	91.30	343.10	11,997.4	2,621.7	-179.0	2,597.5	1.18	-0.53	1.05	
13,993.0	90.50	343.80	11,996.0	2,711.8	-205.8	2,691.2	1.13	-0.85	0.74	
14,088.0	90.80	343.10	11,994.9	2,802.9	-232.8	2,786.0	0.80	0.32	-0.74	
14,183.0	92.10	344.50	11,992.5	2,894.1	-259.3	2,880.8	2.01	1.37	1.47	
14,277.0	90.60	344.60	11,990.3	2,984.6	-284.3	2,974.6	1.60	-1.60	0.11	
14,372.0	89.60	343.40	11,990.1	3,075.9	-310.5	3,069.5	1.64	-1.05	-1.26	
14,467.0	89.30	342.60	11,991.0	3,166.8	-338.3	3,164.2	0.90	-0.32	-0.84	
14,561.0	89.70	342.90	11,991.8	3,256.6	-366.2	3,257.9	0.53	0.43	0.32	
14,656.0	92.80	345.10	11,989.8	3,347.8	-392.3	3,352.7	4.00	3.26	2.32	
14,751.0	90.40	344.00	11,987.1	3,439.4	-417.6	3,447.5	2.78	-2.53	-1.16	
14,846.0	91.40	345.30	11,985.6	3,531.0	-442.8	3,542.4	1.73	1.05	1.37	
14,941.0	91.30	346.60	11,983.4	3,623.1	-465.8	3,637.3	1.37	-0.11	1.37	
15,036.0	90.20	347.00	11,982.1	3,715.6	-487.5	3,732.3	1.23	-1.16	0.42	
15,131.0	88.00	343.10	11,983.6	3,807.3	-512.0	3,827.2	4.71	-2.32	-4.11	
15,225.0	87.40	343.90	11,987.4	3,897.4	-538.7	3,920.9	1.06	-0.64	0.85	
15,320.0	88.30	341.60	11,991.0	3,988.0	-566.9	4,015.5	2.60	0.95	-2.42	
15,414.0	88.60	340.20	11,993.5	4,076.8	-597.6	4,108.9	1.52	0.32	-1.49	
15,509.0	89.50	338.80	11,995.1	4,165.8	-630.9	4,203.0	1.75	0.95	-1.47	
15,604.0	91.70	340.40	11,994.1	4,254.8	-664.0	4,297.1	2.86	2.32	1.68	
15,699.0	92.60	340.20	11,990.5	4,344.2	-696.0	4,391.3	0.97	0.95	-0.21	
15,794.0	91.50	340.90	11,987.1	4,433.7	-727.6	4,485.6	1.37	-1.16	0.74	
15,888.0	92.40	340.60	11,983.9	4,522.4	-758.6	4,578.9	1.01	0.96	-0.32	
15,983.0	90.50	338.00	11,981.5	4,611.2	-792.1	4,672.9	3.39	-2.00	-2.74	
16,078.0	90.60	337.10	11,980.6	4,699.0	-828.4	4,766.5	0.95	0.11	-0.95	
16,172.0	89.80	334.30	11,980.3	4,784.7	-867.1	4,858.5	3.10	-0.85	-2.98	
16,267.0	91.20	336.40	11,979.4	4,871.0	-906.7	4,951.4	2.66	1.47	2.21	
16,361.0	89.30	338.50	11,979.0	4,957.8	-942.7	5,044.0	3.01	-2.02	2.23	
16,456.0	92.70	340.70	11,977.4	5,046.8	-975.9	5,138.1	4.26	3.58	2.32	
16,550.0	94.20	342.10	11,971.7	5,135.8	-1,005.8	5,231.4	2.18	1.60	1.49	
16,645.0	94.50	344.30	11,964.5	5,226.4	-1,033.2	5,325.9	2.33	0.32	2.32	
16,740.0	94.10	345.30	11,957.4	5,317.9	-1,058.0	5,420.5	1.13	-0.42	1.05	
16,835.0	92.00	342.50	11,952.3	5,409.0	-1,084.3	5,515.2	3.68	-2.21	-2.95	
16,930.0	90.60	344.80	11,950.2	5,500.1	-1,111.0	5,610.0	2.83	-1.47	2.42	
17,025.0	90.20	342.70	11,949.5	5,591.3	-1,137.6	5,704.8	2.25	-0.42	-2.21	
17,120.0	91.10	344.00	11,948.4	5,682.3	-1,164.8	5,799.5	1.66	0.95	1.37	
17,214.0	91.10	343.90	11,946.6	5,772.6	-1,190.8	5,893.3	0.11	0.00	-0.11	
17,309.0	91.60	343.80	11,944.4	5,863.9	-1,217.2	5,988.1	0.54	0.53	-0.11	
17,404.0	90.70	343.40	11,942.5	5,955.0	-1,244.0	6,082.9	1.04	-0.95	-0.42	
17,499.0	91.00	343.00	11,941.1	6,045.9	-1,271.5	6,177.7	0.53	0.32	-0.42	
17,593.0	91.60	342.40	11,938.9	6,135.6	-1,299.4	6,271.3	0.90	0.64	-0.64	



Survey Report

Company:	Jay-Bee Oil & Gas	Local Co-ordinate Reference:	Well RPT 8-4U
Project:	Tyler County	TVD Reference:	well @ 1267.1usft (Nomac #81)
Site:	Jack Hair et al	MD Reference:	well @ 1267.1usft (Nomac #81)
Well:	RPT 8-4U	North Reference:	Grid
Wellbore:	Wellbore #1	Survey Calculation Method:	Minimum Curvature
Design:	Wellbore #1	Database:	EDM5002

Survey										
Measured Depth (usft)	Inclination (°)	Azimuth (°)	Vertical Depth (usft)	+N/-S (usft)	+E/-W (usft)	Vertical Section (usft)	Dogleg Rate (°/100usft)	Build Rate (°/100usft)	Turn Rate (°/100usft)	
17,688.0	89.50	344.20	11,938.0	6,226.6	-1,326.7	6,366.1	2.91	-2.21	1.89	
17,783.0	89.80	343.90	11,938.6	6,318.0	-1,352.8	6,460.9	0.45	0.32	-0.32	
17,878.0	90.00	342.70	11,938.8	6,408.9	-1,380.1	6,555.7	1.28	0.21	-1.26	
17,972.0	90.60	342.50	11,938.3	6,498.6	-1,408.3	6,649.3	0.67	0.64	-0.21	
18,067.0	89.70	342.00	11,938.0	6,589.1	-1,437.2	6,743.9	1.08	-0.95	-0.53	
18,162.0	90.50	344.20	11,937.9	6,680.0	-1,464.8	6,838.7	2.46	0.84	2.32	
18,256.0	90.70	343.60	11,936.9	6,770.3	-1,490.9	6,932.5	0.67	0.21	-0.64	
18,351.0	90.50	342.70	11,935.9	6,861.2	-1,518.4	7,027.2	0.97	-0.21	-0.95	
18,446.0	90.90	342.60	11,934.7	6,951.9	-1,546.8	7,121.9	0.43	0.42	-0.11	
18,540.0	90.70	341.40	11,933.4	7,041.3	-1,575.8	7,215.5	1.29	-0.21	-1.28	
18,635.0	91.00	342.50	11,932.0	7,131.6	-1,605.2	7,310.0	1.20	0.32	1.16	
18,669.0	91.10	342.70	11,931.4	7,164.0	-1,615.4	7,343.9	0.66	0.29	0.59	
TD @ 18720.0' MD / 11930.4' TVD										
18,720.0	91.10	342.70	11,930.4	7,212.7	-1,630.6	7,394.7	0.00	0.00	0.00	

Design Annotations					
Measured Depth (usft)	Vertical Depth (usft)	Local Coordinates		Comment	
		+N/-S (usft)	+E/-W (usft)		
11,125.0	11,054.2	541.0	42.2	Tie In @ 11125' MD / 11054' TVD	
18,720.0	11,930.4	7,212.7	-1,630.6	TD @ 18720.0' MD / 11930.4' TVD	

Checked By: _____ Approved By: _____ Date: _____