



ANTERO RESOURCES CORPORATION

Location: Tyler County, WV
 Field: Tyler
 Facility: Vera Pad

Slot: Slot #02
 Well: Mysis Unit 2H
 Wellbore: Mysis Unit 2H PWB




Plot reference wellpath is Mysis Unit 2H PWB Rev-A.0	Grid System: NAD27 / UTM Zone 17 North US feet
True vertical depths are referenced to Frontier 22 (RKB)	North Reference: Grid north
Measured depths are referenced to Frontier 22 (RKB)	Scale: True distance
Frontier 22 (RKB) to Mean Sea Level: 1169.5 feet	Depths are in feet
Mean Sea Level to Mud line (At Slot: Slot #02): -1145 feet	Created by: delaset on 2017-11-01
Coordinates are in feet referenced to Slot	Database: WA_MPL_EasternUS_Defn


Location Information					
Facility Name	Grid East (US ft)	Grid North (US ft)	Latitude	Longitude	
Vera Pad	1667510.600	14316799.487	39°25'31.060"N	80°54'14.800"W	
Slot	Local N (ft)	Local E (ft)	Grid East (US ft)	Grid North (US ft)	Longitude
Slot #02	48.53	-15.74	1667494.862	14316845.994	80°54'14.800"W
Comment: Mysis Unit 2H					
Frontier 22 (RKB) to Mud line (At Slot: Slot #02)			24.5ft		
Mean Sea Level to Mud line (At Slot: Slot #02)			-1145ft		
Frontier 22 (RKB) to Mean Sea Level			1169.5ft		

Well Data			
Slot	Well	Wellbore	Wellpath
Slot #02	Mysis Unit 2H	Mysis Unit 2H AWB	Mysis Unit 2H AWP Proj. 14183
Slot #02	Mysis Unit 2H	Mysis Unit 2H PWB	Mysis Unit 2H PWB Rev-A.0

Well Profile Data								
Design Comment	MD (ft)	Inc (")	Az (°)	TVD (ft)	Local N (ft)	Local E (ft)	DLS ("/100ft)	VS (ft)
Tie On	5915.50	10.660	224.470	5857.48	-428.13	-442.70	0.25	-252.57
Proj. To Bottom	5885.50	11.350	240.000	5926.18	-436.28	-453.28	4.32	-256.65
End of 3D Arc	6617.39	53.824	338.401	6486.56	-211.93	-614.15	8.90	8.97
POE	6809.07	71.005	340.168	6555.00	-53.56	-673.82	9.00	178.20
Landing Pt.	6867.36	90.000	340.168	6581.00	92.64	-726.55	12.00	333.61
BH4	14202.37	90.000	340.168	6581.00	6898.52	-3181.17	0.00	7568.61

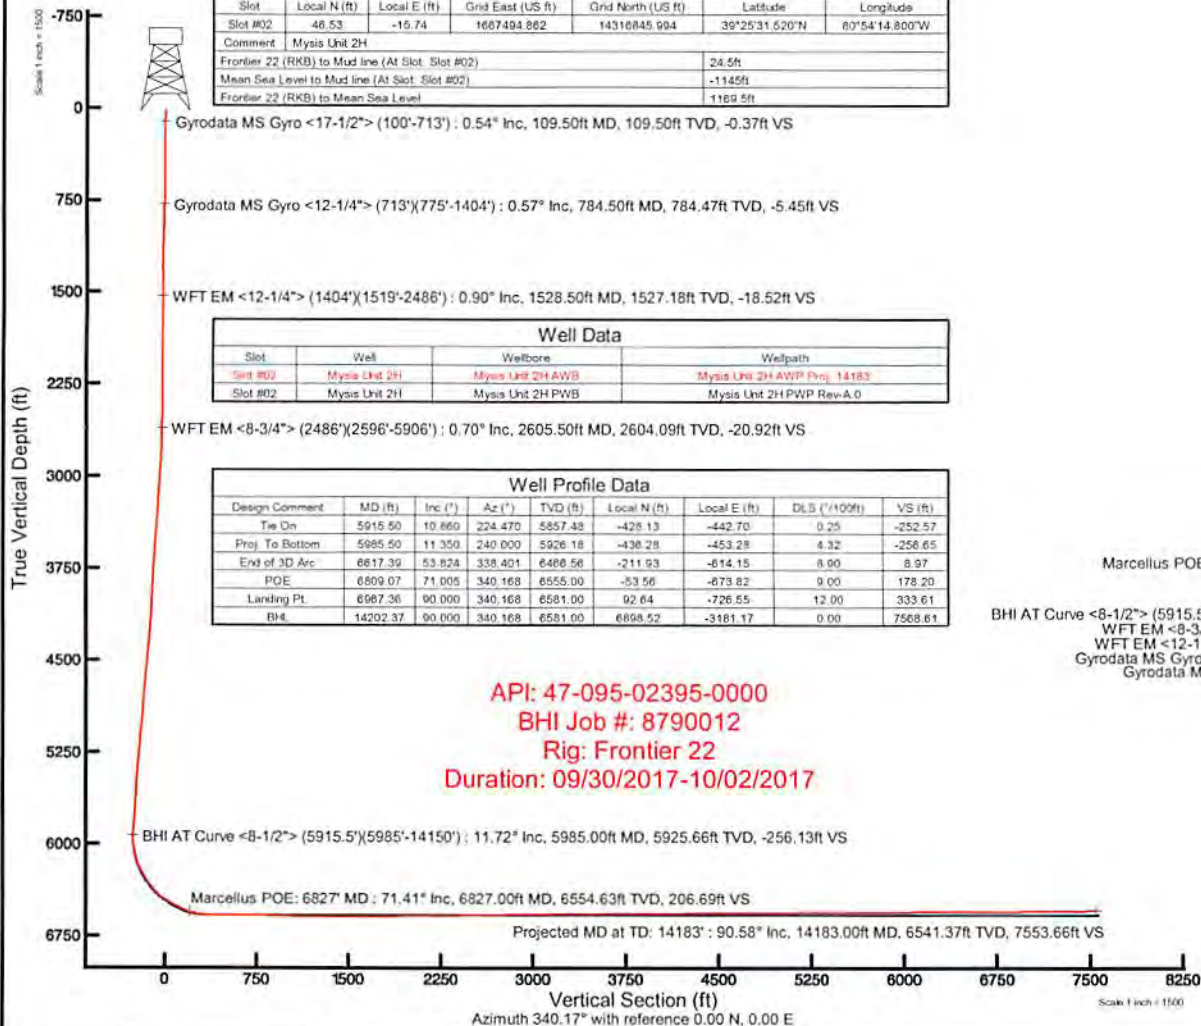

API: 47-095-02395-0000
 BHI Job #: 8790012
 Rig: Frontier 22
 Duration: 09/30/2017-10/02/2017

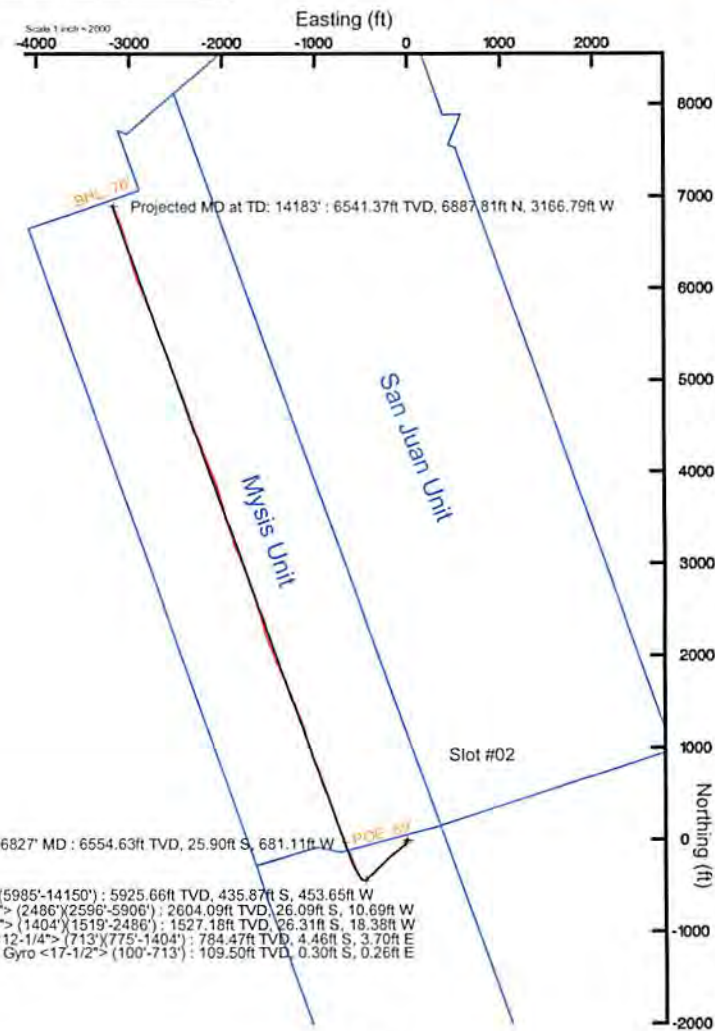

BHI AT Curve <8-1/2"> (5915.5)(5985-14150) : 5925.66ft TVD, 435.87ft S, 453.65ft W
 WFT EM <8-3/4"> (2486)(2596-5906) : 2604.09ft TVD, 26.09ft S, 10.69ft W
 WFT EM <12-1/4"> (1404)(1519-2486) : 1527.18ft TVD, 26.31ft S, 18.38ft W
 Gyrodata MS Gyro <12-1/4"> (713)(775-1404) : 784.47ft TVD, 4.46ft S, 3.70ft E
 Gyrodata MS Gyro <17-1/2"> (100-713) : 109.50ft TVD, 0.30ft S, 0.26ft E



User specified Dip: 66.68° Field: 51991 nT
 Magnetic North is 7.62 degrees West of True North (at 28/Sep/2017)
 Grid North is 0.06 degrees East of True North
 To correct azimuth from True to Grid subtract 0.06 degrees
 To correct azimuth from Magnetic to Grid subtract 7.68 degrees



Actual Wellpath Report

Mysis Unit 2H AWP Proj: 14183'

Page 1 of 10



REFERENCE WELLPATH IDENTIFICATION			
Operator	ANTERO RESOURCES CORPORATION	Slot	Slot #02
Area	Tyler County, WV	Well	Mysis Unit 2H
Field	Tyler	Wellbore	Mysis Unit 2H AWB
Facility	Vera Pad		

REPORT SETUP INFORMATION			
Projection System	NAD27 / UTM Zone 17 North, US feet	Software System	WellArchitect® 5.1
North Reference	Grid	User	Delaset
Scale	0.999601	Report Generated	01/Nov/2017 at 16:07
Convergence at slot	0.06° East	Database/Source file	WA_MPL_EasternUS_Defn/Mysis_Unit_2H_AWP_Proj_14183_.xml

WELLPATH LOCATION						
	Local coordinates		Grid coordinates		Geographic coordinates	
	North[ft]	East[ft]	Easting[US ft]	Northing[US ft]	Latitude	Longitude
Slot Location	46.53	-15.74	1667494.86	14316845.99	39°25'31.520"N	80°54'14.800"W
Facility Reference Pt			1667510.60	14316799.49	39°25'31.060"N	80°54'14.600"W
Field Reference Pt			0.00	0.00	0°00'00.000"	85°29'19.301"W

WELLPATH DATUM			
Calculation method	Minimum curvature	Frontier 22 (RKB) to Facility Vertical Datum	24.50ft
Horizontal Reference Pt	Slot	Frontier 22 (RKB) to Mean Sea Level	1169.50ft
Vertical Reference Pt	Frontier 22 (RKB)	Frontier 22 (RKB) to Mud Line at Slot (Slot #02)	24.50ft
MD Reference Pt	Frontier 22 (RKB)	Section Origin	N 0.00, E 0.00 ft
Field Vertical Reference	Mean Sea Level	Section Azimuth	340.17°

RECEIVED
 Office of Oil and Gas
 FEB 13 2019
 WV Department of
 Environmental Protection



Actual Wellpath Report

Mysis Unit 2H AWP Proj: 14183'

Page 2 of 10



REFERENCE WELLPATH IDENTIFICATION			
Operator	ANTERO RESOURCES CORPORATION		Slot #02
Area	Tyler County, WV		Well
Field	Tyler		Wellbore
Facility	Vera Pad		Mysis Unit 2H AWB

WELLPATH DATA (175 stations) † = interpolated/extrapolated station																
MD	Inclination	Azimuth	TVD	Vert Sect	North	East	Grid East	Grid North	Latitude	Longitude	Closure Dist	Closure Dir	DLS	Build Rate	Turn Rate	Comments
(ft)	(°)	(°)	(ft)	(ft)	(ft)	(ft)	(US ft)	(US ft)			(ft)	(°)	(°/100ft)	(°/100ft)	(°/100ft)	
0.00	0.00	139.000	0.00	0.00	0.00	0.00	1667494.86	14316845.99	39°25'31.520"N	80°54'14.800"W	0.00	0.000	0.00	0.00	0.00	
24.50	0.00	139.000	24.50	0.00	0.00	0.00	1667494.86	14316845.99	39°25'31.520"N	80°54'14.800"W	0.00	0.000	0.00	0.00	0.00	
109.50	0.540	139.000	109.50	-0.37	-0.30	0.26	1667495.12	14316845.69	39°25'31.517"N	80°54'14.797"W	0.40	139.000	0.64	0.64	163.53	Gyrodata MS Gyro <17-1/2"> (100'-713')
209.50	0.140	152.700	209.50	-0.93	-0.77	0.63	1667495.49	14316845.23	39°25'31.512"N	80°54'14.792"W	0.99	140.673	0.41	-0.40	13.70	
309.50	0.260	99.440	309.50	-1.17	-0.91	0.91	1667495.77	14316845.08	39°25'31.511"N	80°54'14.788"W	1.29	135.140	0.21	0.12	-53.26	
409.50	0.450	144.370	409.49	-1.65	-1.27	1.36	1667496.22	14316844.73	39°25'31.507"N	80°54'14.783"W	1.86	133.002	0.32	0.19	44.93	
509.50	0.800	139.690	509.49	-2.69	-2.12	2.04	1667496.90	14316843.87	39°25'31.499"N	80°54'14.774"W	2.94	136.093	0.35	0.35	-4.68	
609.50	0.670	139.150	609.48	-3.89	-3.09	2.87	1667497.74	14316842.90	39°25'31.489"N	80°54'14.763"W	4.22	137.110	0.13	-0.13	-0.54	
709.50	0.480	140.990	709.48	-4.83	-3.86	3.52	1667498.38	14316842.13	39°25'31.482"N	80°54'14.755"W	5.23	137.649	0.19	-0.19	1.84	
722.50	0.530	139.270	722.47	-4.94	-3.95	3.59	1667498.45	14316842.04	39°25'31.481"N	80°54'14.754"W	5.34	137.701	0.40	0.38	-13.23	
784.50	0.570	195.790	784.47	-5.45	-4.46	3.70	1667498.56	14316841.53	39°25'31.476"N	80°54'14.753"W	5.80	140.367	0.84	0.06	91.16	Gyrodata MS Gyro <12-1/4"> (713')(775'-1404')
814.50	0.980	194.300	814.47	-5.79	-4.86	3.59	1667498.45	14316841.14	39°25'31.472"N	80°54'14.754"W	6.04	143.501	1.37	1.37	-4.97	
844.50	1.360	193.180	844.46	-6.30	-5.45	3.45	1667498.31	14316840.54	39°25'31.466"N	80°54'14.756"W	6.45	147.681	1.27	1.27	-3.73	
877.50	1.880	200.700	877.45	-7.04	-6.34	3.17	1667498.03	14316839.66	39°25'31.457"N	80°54'14.760"W	7.09	153.444	1.70	1.58	22.79	
909.50	2.510	209.790	909.43	-7.89	-7.44	2.63	1667497.50	14316838.56	39°25'31.446"N	80°54'14.767"W	7.89	160.496	2.24	1.97	28.41	
941.50	3.210	212.090	941.39	-8.90	-8.81	1.81	1667496.67	14316837.19	39°25'31.433"N	80°54'14.777"W	8.99	168.381	2.22	2.19	7.19	
1003.50	4.240	219.580	1003.25	-11.14	-12.04	-0.57	1667494.29	14316833.95	39°25'31.401"N	80°54'14.807"W	12.06	182.716	1.83	1.66	12.05	
1066.50	5.810	226.160	1066.01	-13.62	-16.05	-4.35	1667490.51	14316829.95	39°25'31.361"N	80°54'14.856"W	16.63	195.182	2.65	2.49	10.48	
1161.50	6.010	226.060	1160.51	-17.61	-22.83	-11.40	1667483.46	14316823.17	39°25'31.294"N	80°54'14.946"W	25.52	206.543	0.21	0.21	-0.11	
1256.50	2.470	237.070	1255.23	-20.10	-27.40	-16.71	1667478.16	14316818.61	39°25'31.249"N	80°54'15.013"W	32.09	211.374	3.81	-3.73	11.59	
1287.50	1.680	246.600	1286.21	-20.28	-27.94	-17.68	1667477.19	14316818.07	39°25'31.244"N	80°54'15.026"W	33.06	212.331	2.77	-2.55	30.74	
1317.50	1.190	254.730	1316.20	-20.29	-28.20	-18.39	1667476.48	14316817.81	39°25'31.242"N	80°54'15.035"W	33.66	213.110	1.76	-1.63	27.10	
1413.50	0.790	26.410	1412.20	-19.75	-27.87	-19.05	1667475.81	14316818.14	39°25'31.245"N	80°54'15.043"W	33.76	214.365	1.89	-0.42	137.17	
1528.50	0.900	21.000	1527.18	-18.52	-26.31	-18.38	1667476.49	14316819.69	39°25'31.260"N	80°54'15.035"W	32.09	214.933	0.12	0.10	-4.70	WFT EM <12-1/4"> (1404')(1519'-2486')
1624.50	0.590	344.620	1623.18	-17.45	-25.13	-18.24	1667476.63	14316820.87	39°25'31.272"N	80°54'15.033"W	31.05	215.970	0.57	-0.32	-37.90	
1719.50	0.540	301.950	1718.17	-16.61	-24.42	-18.75	1667476.12	14316821.58	39°25'31.279"N	80°54'15.039"W	30.79	217.512	0.44	-0.05	-44.92	
1814.50	0.440	279.270	1813.17	-16.09	-24.13	-19.49	1667475.38	14316821.88	39°25'31.282"N	80°54'15.049"W	31.01	218.929	0.23	-0.11	-23.87	
1908.50	0.190	227.410	1907.17	-15.97	-24.17	-19.96	1667474.91	14316821.83	39°25'31.281"N	80°54'15.055"W	31.35	219.544	0.38	-0.27	-55.17	
2003.50	0.450	120.560	2002.17	-16.32	-24.47	-19.75	1667475.12	14316821.53	39°25'31.278"N	80°54'15.052"W	31.45	218.912	0.57	0.27	-112.47	
2097.50	0.720	107.980	2096.16	-16.97	-24.84	-18.67	1667475.99	14316821.16	39°25'31.275"N	80°54'15.041"W	31.20	217.228	0.32	0.29	-13.38	

RECEIVED
Office of Oil and Gas
FEB 13 2019
WV Department of
Environmental Protection



Actual Wellpath Report

Mysis Unit 2H AWP Proj: 14183'

Page 3 of 10



REFERENCE WELLPATH IDENTIFICATION			
Operator	ANTERO RESOURCES CORPORATION	Slot	Slot #02
Area	Tyler County, WV	Well	Mysis Unit 2H
Field	Tyler	Wellbore	Mysis Unit 2H AWB
Facility	Vera Pad		

WELLPATH DATA (175 stations)																
MD (ft)	Inclination (°)	Azimuth (°)	TVD (ft)	Vert Sect (ft)	North (ft)	East (ft)	Grid East (US ft)	Grid North (US ft)	Latitude	Longitude	Closure Dist (ft)	Closure Dir (°)	DLS (°/100ft)	Build Rate (°/100ft)	Turn Rate (°/100ft)	Comments
2191.50	0.930	98.840	2190.15	-17.69	-25.14	-17.56	1667477.31	14316820.86	39°25'31.272"N	80°54'15.024"W	30.67	214.932	0.26	0.22	-9.72	
2286.50	1.200	85.750	2285.13	-18.33	-25.19	-15.81	1667479.06	14316820.82	39°25'31.271"N	80°54'15.002"W	29.73	212.111	0.38	0.28	-13.78	
2381.50	1.360	86.680	2380.11	-18.92	-25.05	-13.69	1667481.18	14316820.96	39°25'31.273"N	80°54'14.975"W	28.54	208.656	0.17	0.17	0.98	
2476.50	0.760	119.260	2475.09	-19.71	-25.29	-12.01	1667482.85	14316820.71	39°25'31.270"N	80°54'14.953"W	28.00	205.408	0.87	-0.63	34.29	
2495.50	0.670	116.700	2494.09	-19.89	-25.40	-11.80	1667483.06	14316820.60	39°25'31.269"N	80°54'14.951"W	28.01	204.924	0.50	-0.47	-13.47	
2605.50	0.700	127.020	2604.09	-20.92	-26.09	-10.69	1667484.17	14316819.91	39°25'31.262"N	80°54'14.937"W	28.20	202.282	0.12	0.03	9.38	WFT EM <8-3/4"> (2486')(2596'-5906')
2700.50	2.010	209.540	2699.06	-22.49	-27.89	-11.05	1667483.82	14316818.11	39°25'31.244"N	80°54'14.941"W	30.00	201.612	2.15	1.38	86.86	
2794.50	4.390	218.240	2792.91	-25.47	-32.15	-14.09	1667480.78	14316813.85	39°25'31.202"N	80°54'14.980"W	35.11	203.664	2.58	2.53	9.26	
2889.50	6.740	217.400	2887.46	-30.41	-39.44	-19.73	1667475.14	14316806.57	39°25'31.130"N	80°54'15.052"W	44.10	206.574	2.48	2.47	-0.88	
2983.50	8.760	219.190	2980.59	-37.08	-49.37	-27.60	1667467.27	14316796.64	39°25'31.032"N	80°54'15.152"W	56.56	209.209	2.18	2.15	1.90	
3078.50	9.970	223.780	3074.33	-44.46	-60.91	-37.86	1667457.01	14316785.10	39°25'30.918"N	80°54'15.283"W	71.72	211.864	1.50	1.27	4.83	
3173.50	9.890	233.580	3167.91	-50.44	-71.70	-50.12	1667444.76	14316774.33	39°25'30.812"N	80°54'15.440"W	87.48	214.955	1.78	-0.08	10.32	
3268.50	9.450	232.010	3261.56	-55.20	-81.34	-82.83	1667432.06	14316764.69	39°25'30.717"N	80°54'15.602"W	102.78	217.684	0.54	-0.46	-1.65	
3362.50	9.710	229.520	3354.25	-60.40	-91.24	-74.94	1667419.95	14316754.79	39°25'30.619"N	80°54'15.756"W	118.07	219.400	0.52	0.28	-2.65	
3457.50	12.830	225.470	3447.41	-67.64	-103.84	-88.56	1667406.34	14316742.20	39°25'30.495"N	80°54'15.930"W	136.47	220.459	3.39	3.28	-4.26	
3552.50	12.620	235.490	3540.08	-74.68	-117.12	-104.63	1667390.27	14316728.92	39°25'30.364"N	80°54'16.135"W	157.05	221.778	2.33	-0.22	10.55	
3646.50	11.520	232.950	3632.01	-80.06	-128.59	-120.59	1667374.32	14316717.46	39°25'30.250"N	80°54'16.338"W	176.28	223.160	1.30	-1.17	-2.70	
3740.50	10.650	230.130	3724.25	-85.81	-139.81	-134.74	1667360.17	14316706.24	39°25'30.140"N	80°54'16.519"W	194.17	223.942	1.09	-0.93	-3.00	
3834.50	9.730	228.850	3816.77	-91.68	-150.61	-147.39	1667347.53	14316695.44	39°25'30.033"N	80°54'16.680"W	210.73	224.381	1.01	-0.98	-1.36	
3929.50	10.450	233.130	3910.30	-97.12	-161.06	-160.33	1667334.60	14316685.00	39°25'29.930"N	80°54'16.845"W	227.26	224.870	1.09	0.76	4.51	
4024.50	9.520	232.120	4003.86	-102.08	-171.05	-173.42	1667321.51	14316675.01	39°25'29.831"N	80°54'17.012"W	243.59	225.394	1.00	-0.98	-1.06	
4118.50	10.120	232.180	4096.48	-107.04	-180.89	-186.08	1667308.85	14316665.17	39°25'29.734"N	80°54'17.174"W	259.52	225.810	0.64	0.64	0.06	
4213.50	11.140	228.780	4189.85	-112.97	-192.06	-199.58	1667295.36	14316654.01	39°25'29.624"N	80°54'17.346"W	276.98	226.100	1.26	1.07	-3.58	
4308.50	12.720	224.490	4282.80	-120.85	-205.57	-213.81	1667281.14	14316640.51	39°25'29.491"N	80°54'17.527"W	296.60	226.126	1.91	1.66	-4.52	
4402.50	12.010	222.100	4374.62	-129.93	-220.21	-227.62	1667267.33	14316625.88	39°25'29.346"N	80°54'17.704"W	316.71	226.949	0.93	-0.76	-2.54	
4497.50	12.790	224.490	4467.40	-139.14	-235.04	-241.62	1667253.34	14316611.05	39°25'29.199"N	80°54'17.882"W	337.08	225.790	0.98	0.82	2.52	
4591.50	12.540	229.730	4559.12	-147.21	-249.06	-256.70	1667238.27	14316597.03	39°25'29.061"N	80°54'18.074"W	357.66	225.865	1.25	-0.27	5.57	
4686.50	12.000	225.960	4651.95	-154.86	-262.59	-271.66	1667223.31	14316583.51	39°25'28.928"N	80°54'18.265"W	377.83	225.973	1.02	-0.57	-3.97	
4780.50	11.510	223.980	4743.98	-163.01	-276.13	-285.20	1667209.77	14316569.97	39°25'28.794"N	80°54'18.438"W	396.98	225.925	0.68	-0.52	-2.11	
4875.50	11.390	227.030	4837.09	-170.88	-289.35	-298.65	1667196.33	14316556.76	39°25'28.663"N	80°54'18.610"W	415.83	225.906	0.65	-0.13	3.21	

RECEIVED
 Office of Oil and Gas
 FEB 13 2019
 WV Department of
 Environmental Protection



Actual Wellpath Report

Mysis Unit 2H AWP Proj: 14183'

Page 4 of 10



REFERENCE WELLPATH IDENTIFICATION			
Operator	ANTERO RESOURCES CORPORATION		Slot #02
Area	Tyler County, WV		Well
Field	Tyler		Wellbore
Facility	Vera Pad		Mysis Unit 2H AWB

WELLPATH DATA (175 stations) † = interpolated/extrapolated station																
MD (ft)	Inclination (°)	Azimuth (°)	TVD (ft)	Vert Sect (ft)	North (ft)	East (ft)	Grid East (US ft)	Grid North (US ft)	Latitude	Longitude	Closure Dist (ft)	Closure Dir (°)	DLS (°/100ft)	Build Rate (°/100ft)	Turn Rate (°/100ft)	Comments
4969.50	10.910	225.210	4929.31	-178.28	-301.94	-311.75	1667183.23	14316544.17	39°25'28.539"N	80°54'18.777"W	434.00	225.916	0.63	-0.51	-1.94	
5064.50	10.500	222.290	5022.66	-186.12	-314.68	-323.96	1667171.03	14316531.44	39°25'28.413"N	80°54'18.932"W	451.63	225.832	0.72	-0.43	-3.07	
5159.50	11.790	222.730	5115.87	-194.64	-328.21	-336.37	1667158.63	14316517.91	39°25'28.280"N	80°54'19.091"W	469.96	225.703	1.36	1.36	0.46	
5254.50	12.510	229.460	5208.74	-202.76	-342.03	-350.77	1667144.23	14316504.10	39°25'28.143"N	80°54'19.275"W	489.93	225.723	1.67	0.76	7.08	
5348.50	13.080	228.400	5300.41	-210.30	-355.71	-366.46	1667128.54	14316490.43	39°25'28.008"N	80°54'19.475"W	510.71	225.853	0.66	0.61	-1.13	
5443.50	11.970	224.530	5393.15	-218.55	-369.87	-381.41	1667113.60	14316476.27	39°25'27.868"N	80°54'19.665"W	531.30	225.880	1.46	-1.17	-4.07	
5537.50	10.010	224.230	5485.42	-226.34	-382.67	-393.95	1667101.07	14316463.47	39°25'27.742"N	80°54'19.825"W	549.21	225.832	2.09	-2.09	-0.32	
5632.50	9.920	231.170	5578.99	-232.62	-393.72	-406.08	1667088.94	14316452.43	39°25'27.633"N	80°54'19.980"W	565.61	225.885	1.27	-0.09	7.31	
5726.50	9.690	228.070	5671.62	-238.23	-404.09	-418.28	1667076.75	14316442.07	39°25'27.531"N	80°54'20.136"W	581.58	225.989	0.61	-0.24	-3.30	
5821.50	10.630	224.730	5765.13	-245.00	-415.65	-430.39	1667064.64	14316430.51	39°25'27.416"N	80°54'20.290"W	598.33	225.998	1.17	0.99	-3.52	
5915.50	10.860	224.470	5857.48	-252.57	-428.13	-442.70	1667052.34	14316418.03	39°25'27.293"N	80°54'20.447"W	615.85	225.958	0.25	0.24	-0.28	
5985.00	11.720	244.290	5925.66	-256.13	-435.87	-453.65	1667041.40	14316410.30	39°25'27.217"N	80°54'20.587"W	629.11	226.145	5.69	1.24	28.52	BHI AT Curve <8-1/2"> (5915.5')(5985'-14150')
6003.00	12.050	248.570	5943.27	-256.37	-437.35	-457.04	1667038.00	14316408.82	39°25'27.202"N	80°54'20.630"W	632.58	226.261	5.23	1.83	23.78	
6050.00	12.630	267.520	5989.21	-254.98	-439.36	-466.75	1667028.30	14316406.81	39°25'27.182"N	80°54'20.754"W	641.01	226.731	8.67	1.23	40.32	
6098.00	14.560	289.730	6035.89	-249.56	-437.55	-477.68	1667017.38	14316408.62	39°25'27.200"N	80°54'20.893"W	647.79	227.510	11.61	4.02	46.27	
6145.00	17.500	305.880	6081.08	-239.96	-431.41	-488.97	1667006.09	14316414.75	39°25'27.261"N	80°54'21.037"W	652.08	228.579	11.31	6.26	34.36	
6192.00	20.240	316.200	6125.56	-226.68	-421.40	-500.33	1666994.73	14316424.76	39°25'27.360"N	80°54'21.181"W	654.15	229.895	9.17	5.83	21.96	
6239.00	23.520	322.250	6169.18	-210.33	-408.11	-511.70	1666983.36	14316438.05	39°25'27.492"N	80°54'21.326"W	654.52	231.426	8.46	6.98	12.87	
6286.00	25.870	329.190	6211.89	-191.33	-391.88	-522.70	1666972.37	14316454.27	39°25'27.652"N	80°54'21.466"W	653.29	233.140	7.93	5.00	14.77	
6333.00	29.500	334.040	6253.50	-169.75	-372.66	-533.02	1666962.05	14316473.48	39°25'27.842"N	80°54'21.597"W	650.38	235.041	9.08	7.72	10.32	
6381.00	33.770	338.140	6294.37	-144.65	-349.64	-543.17	1666951.91	14316496.49	39°25'28.070"N	80°54'21.726"W	645.97	237.230	9.96	8.90	8.54	
6428.00	37.620	339.870	6332.53	-117.24	-324.04	-552.97	1666942.11	14316522.08	39°25'28.323"N	80°54'21.851"W	640.92	239.630	8.47	8.19	3.68	
6477.00	41.980	339.480	6370.17	-85.88	-294.64	-563.87	1666931.22	14316551.48	39°25'28.614"N	80°54'21.989"W	636.21	242.412	8.91	8.90	-0.80	
6524.00	46.840	337.910	6403.73	-53.02	-264.01	-575.83	1666919.26	14316582.09	39°25'28.917"N	80°54'22.141"W	633.47	245.369	10.60	10.34	-3.34	
6530.00†	47.501	337.777	6407.81	-48.62	-259.94	-577.49	1666917.60	14316586.16	39°25'28.957"N	80°54'22.163"W	633.30	245.767	11.13	11.01	-2.21	Middlesex: 6530' MD
6571.00	52.020	336.940	6434.29	-17.37	-231.06	-589.55	1666905.55	14316615.02	39°25'29.242"N	80°54'22.316"W	633.21	248.598	11.13	11.02	-2.04	
6618.00	55.780	336.700	6461.98	20.53	-196.16	-604.49	1666890.61	14316649.91	39°25'29.588"N	80°54'22.506"W	635.52	252.022	8.01	8.00	-0.51	
6666.00	59.900	335.820	6487.52	61.07	-158.97	-620.85	1666874.26	14316687.08	39°25'29.955"N	80°54'22.714"W	640.88	255.638	8.72	8.58	-1.83	
6691.00†	61.681	335.431	6499.72	82.82	-139.10	-629.86	1666865.25	14316706.95	39°25'30.152"N	80°54'22.828"W	645.04	257.547	7.25	7.13	-1.55	Burkett: 6691' MD
6713.00	63.250	335.100	6509.89	102.25	-121.38	-638.02	1666857.09	14316724.86	39°25'30.327"N	80°54'22.932"W	649.47	259.228	7.25	7.13	-1.51	

RECEIVED
 Office of Oil and Gas
 FEB 13 2019
 WV Department of
 Environmental Protection



Actual Wellpath Report

Mysis Unit 2H AWP Proj: 14183
Page 5 of 10



REFERENCE WELLPATH IDENTIFICATION	
Operator	ANTERO RESOURCES CORPORATION
Area	Tyler County, WV
Field	Tyler
Facility	Vera Pad
Slot #02	Mysis Unit 2H
Well	Mysis Unit 2H AWB
Wellbore	

WELLPATH DATA (175 stations)		r = interpolated/extrapolated station														
MD (ft)	Inclination (°)	Azimuth (°)	TVD (ft)	Vent Sect (ft)	North (ft)	East (ft)	Grid East (ft)	Grid North (ft)	Latitude	Longitude	Closure Dist (ft)	Closure Dir (°)	DLS (F/100ft)	Build Rate (F/100ft)	Turn Rate (F/100ft)	Comments
6751.00	65.555	335.025	6526.31	136.38	-90.31	-652.47	1666842.65	14316755.72	39°25'30.634"N	80°54'23.116"W	658.69	262.120	6.07	6.07	-0.20	Tully: 6751 MD
6759.00	66.040	335.010	6529.59	143.65	-83.69	-655.55	1666839.57	14316782.33	39°25'30.700"N	80°54'23.155"W	660.87	262.724	6.07	6.07	-0.19	
6806.00	69.070	336.480	6547.53	186.96	-44.09	-673.39	1666821.74	14316801.92	39°25'31.091"N	80°54'23.382"W	674.83	266.254	7.07	6.45	3.13	
6827.00	71.407	337.490	6554.63	206.69	-25.90	-681.11	1666814.02	14316820.10	39°25'31.271"N	80°54'23.480"W	681.61	267.822	12.02	11.13	4.81	Marcellus POE: 6827 MD
6854.00	74.420	338.750	6562.56	232.48	-1.96	-690.73	1666804.41	14316844.04	39°25'31.508"N	80°54'23.602"W	680.73	268.838	12.02	11.16	4.66	
6901.00	80.100	340.380	6572.92	278.30	40.98	-706.72	1666788.42	14316868.96	39°25'31.932"N	80°54'23.805"W	707.91	273.319	12.55	12.09	3.47	
6949.00	85.870	341.190	6578.78	325.91	85.95	-722.39	1666772.76	14316893.91	39°25'32.377"N	80°54'24.004"W	727.49	276.785	12.14	12.02	1.69	
6987.00	89.910	341.500	6580.18	363.87	121.92	-734.54	1666760.62	14316917.93	39°25'32.733"N	80°54'24.159"W	744.59	279.424	10.66	10.93	0.82	
7044.00	89.940	341.750	6580.26	420.85	176.02	-752.50	1666742.66	14317021.94	39°25'33.267"N	80°54'24.387"W	772.82	283.165	0.44	0.05	0.44	
7140.00	90.000	341.010	6580.31	516.83	266.99	-783.16	1666712.02	14317112.88	39°25'34.167"N	80°54'24.776"W	827.42	288.825	0.77	0.06	-0.77	
7235.00	90.310	340.190	6580.05	611.83	356.60	-814.71	1666680.48	14317202.45	39°25'35.053"N	80°54'25.177"W	889.33	293.639	0.92	0.33	-0.86	
7330.00	88.920	340.640	6580.69	706.82	446.10	-846.55	1666648.65	14317291.91	39°25'35.938"N	80°54'25.582"W	956.90	297.787	1.54	-1.46	0.47	
7424.00	89.630	340.320	6581.88	800.81	534.69	-877.96	1666617.25	14317380.47	39°25'36.814"N	80°54'25.981"W	1027.96	301.342	0.83	0.76	-0.34	
7519.00	88.310	339.480	6583.59	895.79	623.88	-910.60	1666584.63	14317469.63	39°25'37.695"N	80°54'26.386"W	1103.82	304.416	1.65	-1.39	-0.88	
7614.00	88.460	339.960	6586.26	990.75	712.96	-943.51	1666551.73	14317558.67	39°25'38.576"N	80°54'26.814"W	1192.59	307.076	0.53	0.16	0.51	
7709.00	88.460	340.050	6588.82	1085.72	802.20	-975.99	1666519.27	14317647.87	39°25'39.459"N	80°54'27.227"W	1263.36	309.418	0.09	0.00	0.09	
7804.00	89.450	340.390	6590.55	1180.70	891.58	-1008.13	1666487.14	14317737.21	39°25'40.342"N	80°54'27.635"W	1345.82	311.489	1.10	1.04	0.36	
7899.00	89.670	339.730	6591.36	1275.70	980.88	-1040.53	1666454.75	14317826.48	39°25'41.225"N	80°54'28.047"W	1429.97	313.310	0.71	0.13	-0.69	
7994.00	90.150	340.240	6591.99	1370.69	1070.14	-1073.04	1666422.25	14317915.71	39°25'42.108"N	80°54'28.460"W	1515.46	314.922	0.81	0.61	0.54	
8088.00	90.680	344.610	6590.93	1462.60	1157.82	-1100.81	1666394.49	14318003.35	39°25'42.975"N	80°54'28.813"W	1597.61	316.446	4.78	0.58	4.75	
8182.00	90.520	342.820	6589.92	1558.40	1249.96	-1127.73	1666367.58	14318095.45	39°25'43.886"N	80°54'29.155"W	1683.50	317.943	1.87	-0.17	-1.86	
8276.00	90.550	335.870	6589.04	1652.33	1337.86	-1160.87	1666334.46	14318183.32	39°25'44.755"N	80°54'29.576"W	1771.30	319.052	7.39	0.03	-7.39	
8371.00	90.400	337.460	6588.26	1747.15	1425.09	-1198.50	1666296.85	14318270.51	39°25'45.617"N	80°54'30.054"W	1862.06	319.936	1.68	-0.16	1.67	
8466.00	90.310	339.520	6587.67	1842.10	1513.46	-1233.33	1666262.03	14318358.85	39°25'46.491"N	80°54'30.497"W	1952.35	320.823	2.17	-0.09	2.17	
8562.00	90.060	340.230	6587.36	1938.10	1603.60	-1266.36	1666229.01	14318448.95	39°25'47.382"N	80°54'30.917"W	2043.33	321.702	0.78	-0.26	0.74	
8657.00	90.830	338.630	6586.62	2033.08	1692.54	-1299.73	1666195.65	14318537.85	39°25'48.261"N	80°54'31.341"W	2134.01	322.479	1.87	0.81	-1.68	
8751.00	90.650	334.170	6585.40	2126.85	1778.65	-1337.35	1666158.05	14318623.93	39°25'49.113"N	80°54'31.819"W	2225.33	323.061	4.75	-0.19	-4.74	
8846.00	90.550	334.220	6584.41	2221.33	1864.17	-1378.70	1666116.71	14318709.41	39°25'49.959"N	80°54'32.345"W	2318.61	323.514	0.12	-0.11	0.05	
8941.00	90.580	340.550	6583.47	2316.16	1951.81	-1415.22	1666080.21	14318797.03	39°25'50.825"N	80°54'32.809"W	2410.90	324.055	6.66	0.03	6.66	
9035.00	90.710	338.340	6582.41	2410.14	2039.82	-1448.21	1666047.23	14318884.89	39°25'51.695"N	80°54'33.229"W	2501.64	324.626	2.35	0.14	-2.35	

RECEIVED
Office of Oil and Gas
FEB 13 2019
WV Department of
Environmental Protection



Actual Wellpath Report

Mysis Unit 2H AWP Proj: 14183



Operator	Area	Field	Facility
ANTERO RESOURCES CORPORATION	Tyler County, WV	Tyler	Vera Pad
Slot	Well	Wellbore	
Slot #02	Mysis Unit 2H	Mysis Unit 2H AWB	

WELLPATH DATA (175 stations)																
MD	Inclination	Azimuth	TVD	Vert Sect	North	East	Grid East	Grid North	Grid North	Latitude	Longitude	Closure Dist	Closure Dir	DLS	Turn Rate	Comments
ft	ft	ft	ft	ft	ft	ft	ft	ft	ft	ft	ft	ft	ft	ft/100ft	ft/100ft	

RECEIVED
Office of Oil and Gas
FEB 13 2019
WV Department of
Environmental Protection



Actual Wellpath Report

Mysis Unit 2H AWP Proj: 14183

Page 7 of 10



REFERENCE WELLPATH IDENTIFICATION

Operator	ANTERO RESOURCES CORPORATION
Area	Tyler County, WV
Field	Tyler
Facility	Vera Pad
Well	Mysis Unit 2H
Wellbore	Mysis Unit 2H AWB
Slot	Slot #02

WELLPATH DATA (175 stations)

MD	Inclination	Azimuth	TVD	Vert Sect	North	East	Grid East	Grid North	Latitude	Longitude	Closure Dist	Closure Dir	DLS	Build Rate	Turn Rate	Comments
11973.00	90.370	340.320	6556.15	5345.41	4809.13	-2421.48	1665074.35	14321653.20	39°26'19.075"N	80°54'45.598"W	5384.36	333.274	0.00	0.00	-0.16	
12068.00	90.310	340.090	6555.58	5440.41	4898.52	-2453.65	1665042.20	14321742.55	39°26'19.959"N	80°54'46.007"W	5478.68	333.394	0.25	-0.06	-0.24	
12163.00	90.310	338.930	6555.07	5535.40	4987.51	-2486.90	1665008.96	14321831.50	39°26'20.839"N	80°54'46.430"W	5573.14	333.498	0.00	0.00	-1.22	
12257.00	90.250	338.230	6554.61	5629.36	5075.01	-2521.23	1664974.64	14321918.97	39°26'21.704"N	80°54'46.866"W	5666.78	333.582	0.75	-0.06	-0.74	
12352.00	90.220	340.300	6554.22	5724.34	5163.85	-2554.86	1664941.02	14322007.77	39°26'22.582"N	80°54'47.294"W	5761.31	333.676	2.18	-0.03	2.18	
12446.00	90.310	341.320	6553.79	5818.33	5252.63	-2585.76	1664910.14	14322096.51	39°26'23.460"N	80°54'47.686"W	5854.59	333.790	1.09	0.10	1.09	
12541.00	90.400	340.210	6553.20	5913.32	5342.32	-2617.06	1664878.86	14322186.17	39°26'24.347"N	80°54'48.084"W	5948.90	333.901	1.17	0.09	-1.17	
12635.00	90.280	339.310	6552.64	6007.32	5430.59	-2649.38	1664846.55	14322274.40	39°26'25.220"N	80°54'48.495"W	6042.39	333.994	0.69	-0.13	-0.68	
12730.00	90.340	339.310	6552.13	6102.31	5519.54	-2682.74	1664813.20	14322363.31	39°26'26.099"N	80°54'48.919"W	6136.97	334.078	0.28	0.06	-0.27	
12825.00	90.280	339.720	6551.61	6197.30	5608.53	-2716.98	1664779.97	14322452.27	39°26'26.979"N	80°54'49.342"W	6231.54	334.161	0.44	-0.06	0.43	
12920.00	90.310	339.080	6551.12	6292.29	5697.45	-2749.41	1664746.56	14322541.16	39°26'27.858"N	80°54'49.767"W	6326.15	334.240	0.67	0.03	-0.67	
13014.00	90.340	338.830	6550.59	6388.27	5785.18	-2783.16	1664712.81	14322628.85	39°26'28.725"N	80°54'50.196"W	6419.84	334.308	0.27	0.00	-0.27	
13109.00	90.340	337.600	6550.03	6481.21	5873.39	-2818.42	1664677.57	14322717.03	39°26'29.598"N	80°54'50.644"W	6514.61	334.365	1.29	0.00	-1.29	
13204.00	90.280	337.640	6549.51	6576.12	5961.23	-2854.59	1664641.42	14322804.84	39°26'30.466"N	80°54'51.104"W	6609.46	334.412	0.08	-0.06	0.04	
13299.00	90.160	337.970	6549.16	6671.03	6049.19	-2890.48	1664605.54	14322892.76	39°26'31.336"N	80°54'51.561"W	6704.30	334.460	0.37	-0.14	0.35	
13394.00	90.310	340.190	6548.77	6766.01	6137.93	-2924.39	1664571.64	14322981.46	39°26'32.213"N	80°54'51.992"W	6798.99	334.525	2.34	0.17	2.34	
13489.00	90.370	343.070	6548.21	6860.97	6228.07	-2954.33	1664541.72	14323071.57	39°26'33.104"N	80°54'52.372"W	6893.26	334.622	3.03	0.06	3.03	
13583.00	90.950	344.310	6547.13	6954.78	6318.28	-2980.73	1664515.33	14323161.74	39°26'33.996"N	80°54'52.708"W	6986.09	334.744	1.46	0.62	1.32	
13678.00	90.430	345.610	6545.98	7049.44	6410.02	-3005.38	1664490.69	14323253.44	39°26'34.903"N	80°54'53.021"W	7079.59	334.880	1.47	-0.55	1.37	
13773.00	90.430	343.650	6544.52	7144.15	6501.61	-3030.55	1664465.52	14323345.00	39°26'35.809"N	80°54'53.341"W	7173.23	335.009	2.06	0.00	-2.06	
13867.00	90.490	343.290	6544.52	7237.99	6591.73	-3057.30	1664438.79	14323435.08	39°26'36.699"N	80°54'53.680"W	7266.22	335.118	0.39	0.06	-0.38	
13961.00	90.620	342.190	6543.61	7331.89	6681.49	-3085.19	1664410.91	14323524.80	39°26'37.587"N	80°54'54.035"W	7359.39	335.215	1.18	0.14	-1.17	
14056.00	90.550	338.430	6542.65	7425.86	6769.97	-3116.85	1664379.26	14323613.25	39°26'38.462"N	80°54'54.437"W	7453.00	335.279	4.00	-0.07	-4.00	
14150.00	90.580	336.210	6541.71	7520.74	6857.62	-3153.48	1664342.65	14323700.86	39°26'39.328"N	80°54'54.903"W	7547.93	335.305	2.34	0.03	-2.34	
14183.00	90.580	336.210	6541.37	7553.66	6887.91	-3166.79	1664329.34	14323731.04	39°26'39.627"N	80°54'55.072"W	7580.93	335.309	0.00	0.00	0.00	Projected MD at TD: 14183'

RECEIVED
Office of Oil and Gas
FEB 13 2019
WV Department of
Environmental Protection



Actual Wellpath Report

Mysis Unit 2H AWP Proj: 14183'

Page 8 of 10



REFERENCE WELLPATH IDENTIFICATION

Operator	ANTERO RESOURCES CORPORATION	Slot	Slot #02
Area	Tyler County, WV	Well	Mysis Unit 2H
Field	Tyler	Wellbore	Mysis Unit 2H AWB
Facility	Vera Pad		

HOLE & CASING SECTIONS - Ref Wellbore: Mysis Unit 2H AWB Ref Wellpath: Mysis Unit 2H AWP Proj: 14183'

String/Diameter	Start MD [ft]	End MD [ft]	Interval [ft]	Start TVD [ft]	End TVD [ft]	Start N/S [ft]	Start E/W [ft]	End N/S [ft]	End E/W [ft]
20in Conductor	24.50	104.50	80.00	24.50	104.50	0.00	0.00	-0.27	0.23
17.5in Open Hole	104.50	749.70	645.20	104.50	749.67	-0.27	0.23	-4.16	3.71
13.375in Casing Surface	24.50	749.70	725.20	24.50	749.67	0.00	0.00	-4.16	3.71
12.25in Open Hole	749.70	2577.30	1827.60	749.67	2575.89	-4.16	3.71	-25.89	-10.97
9.625in Casing Intermediate	24.50	2577.30	2552.80	24.50	2575.89	0.00	0.00	-25.89	-10.97
8.75in Open Hole	2577.30	5985.50	3408.20	2575.89	5926.15	-25.89	-10.97	-435.91	-453.74
8.5in Open Hole	5985.50	14183.00	8197.50	5926.15	6541.37	-435.91	-453.74	6887.81	-3166.79
5.5in Casing Production	24.50	14183.00	14158.50	24.50	6541.37	0.00	0.00	6887.81	-3166.79

TARGETS

Name	TVD [ft]	North [ft]	East [ft]	Grid East [US ft]	Grid North [US ft]	Latitude	Longitude	Shape
Mysis Unit 2H POE Rev-2	6555.00	-53.56	-673.82	1666821.31	14316792.46	39°25'30.996"N	80°54'23.387"W	point
Mysis Unit 2H BHL Rev-2	6581.00	6898.52	-3181.17	1664314.97	14323741.75	39°26'39.733"N	80°54'55.256"W	point
Mysis Unit 2H LP Rev-1	6581.00	92.64	-726.55	1666768.61	14316938.59	39°25'32.443"N	80°54'24.057"W	point

RECEIVED
 Office of Oil and Gas
 FEB 13 2019
 WV Department of
 Environmental Protection



Actual Wellpath Report

Mysis Unit 2H AWP Proj: 14183'

Page 9 of 10



REFERENCE WELLPATH IDENTIFICATION			
Operator	ANTERO RESOURCES CORPORATION	Slot	Slot #02
Area	Tyler County, WV	Well	Mysis Unit 2H
Field	Tyler	Wellbore	Mysis Unit 2H AWB
Facility	Vera Pad		

WELLPATH COMPOSITION - Ref Wellbore: Mysis Unit 2H AWB Ref Wellpath: Mysis Unit 2H AWP Proj: 14183'				
Start MD [ft]	End MD [ft]	Positional Uncertainty Model	Log Name/Comment	Wellbore
24.50	722.50	Gyrodata standard - Drop gyro or Multi-shot	01 Gyrodata MS Gyro <17-1/2">(100'-713')	Mysis Unit 2H AWB
722.50	1413.50	Gyrodata standard - Drop gyro or Multi-shot	02 Gyrodata MS Gyro <12-1/4">(713')(775'-1404')	Mysis Unit 2H AWB
1413.50	2495.50	ISCWSA MWD, Rev. 4 (Standard)	03 WFT EM <12-1/4">(1404')(1519'-2486')	Mysis Unit 2H AWB
2495.50	5915.50	ISCWSA MWD, Rev. 4 (Standard)	04 WFT EM <8-3/4">(2486')(2596'-5906')	Mysis Unit 2H AWB
5915.50	14150.00	BHI AutoTrak Curve (Short)	05 BHI AT Curve <8-1/2">(5915.5')(5985'-14150')	Mysis Unit 2H AWB
14150.00	14183.00	Blind Drilling (std)	Projection to bit	Mysis Unit 2H AWB

RECEIVED
 Office of Oil and Gas
 FEB 13 2019
 WV Department of
 Environmental Protection



Actual Wellpath Report

Mysis Unit 2H AWP Proj: 14183'

Page 10 of 10



REFERENCE WELLPATH IDENTIFICATION

Operator	ANTERO RESOURCES CORPORATION	Slot	Slot #02
Area	Tyler County, WV	Well	Mysis Unit 2H
Field	Tyler	Wellbore	Mysis Unit 2H AWB
Facility	Vera Pad		

COMMENTS

Wellpath general comments

API: 47-095-02395-0000
BHI Job #: 8790012
Rig: Frontier 22
Duration: 09/30/2017-10/02/2017
Gyrodata MS Gyro <17-1/2"> (100'-713')
Gyrodata MS Gyro <12-1/4"> (713')(775'-1404')
WFT EM <12-1/4"> (1404')(1519'-2486')
WFT EM <8-3/4"> (2486')(2596'-5906')
BHI AT Curve <8-1/2"> (5915.5')(5985'-14150')
Middlesex: 6530' MD
Burkett: 6691' MD
Tully: 6751' MD
Marcellus POE: 6827' MD
Projected MD at TD: 14183'

RECEIVED
Office of Oil and Gas
FEB 13 2019
WV Department of
Environmental Protection