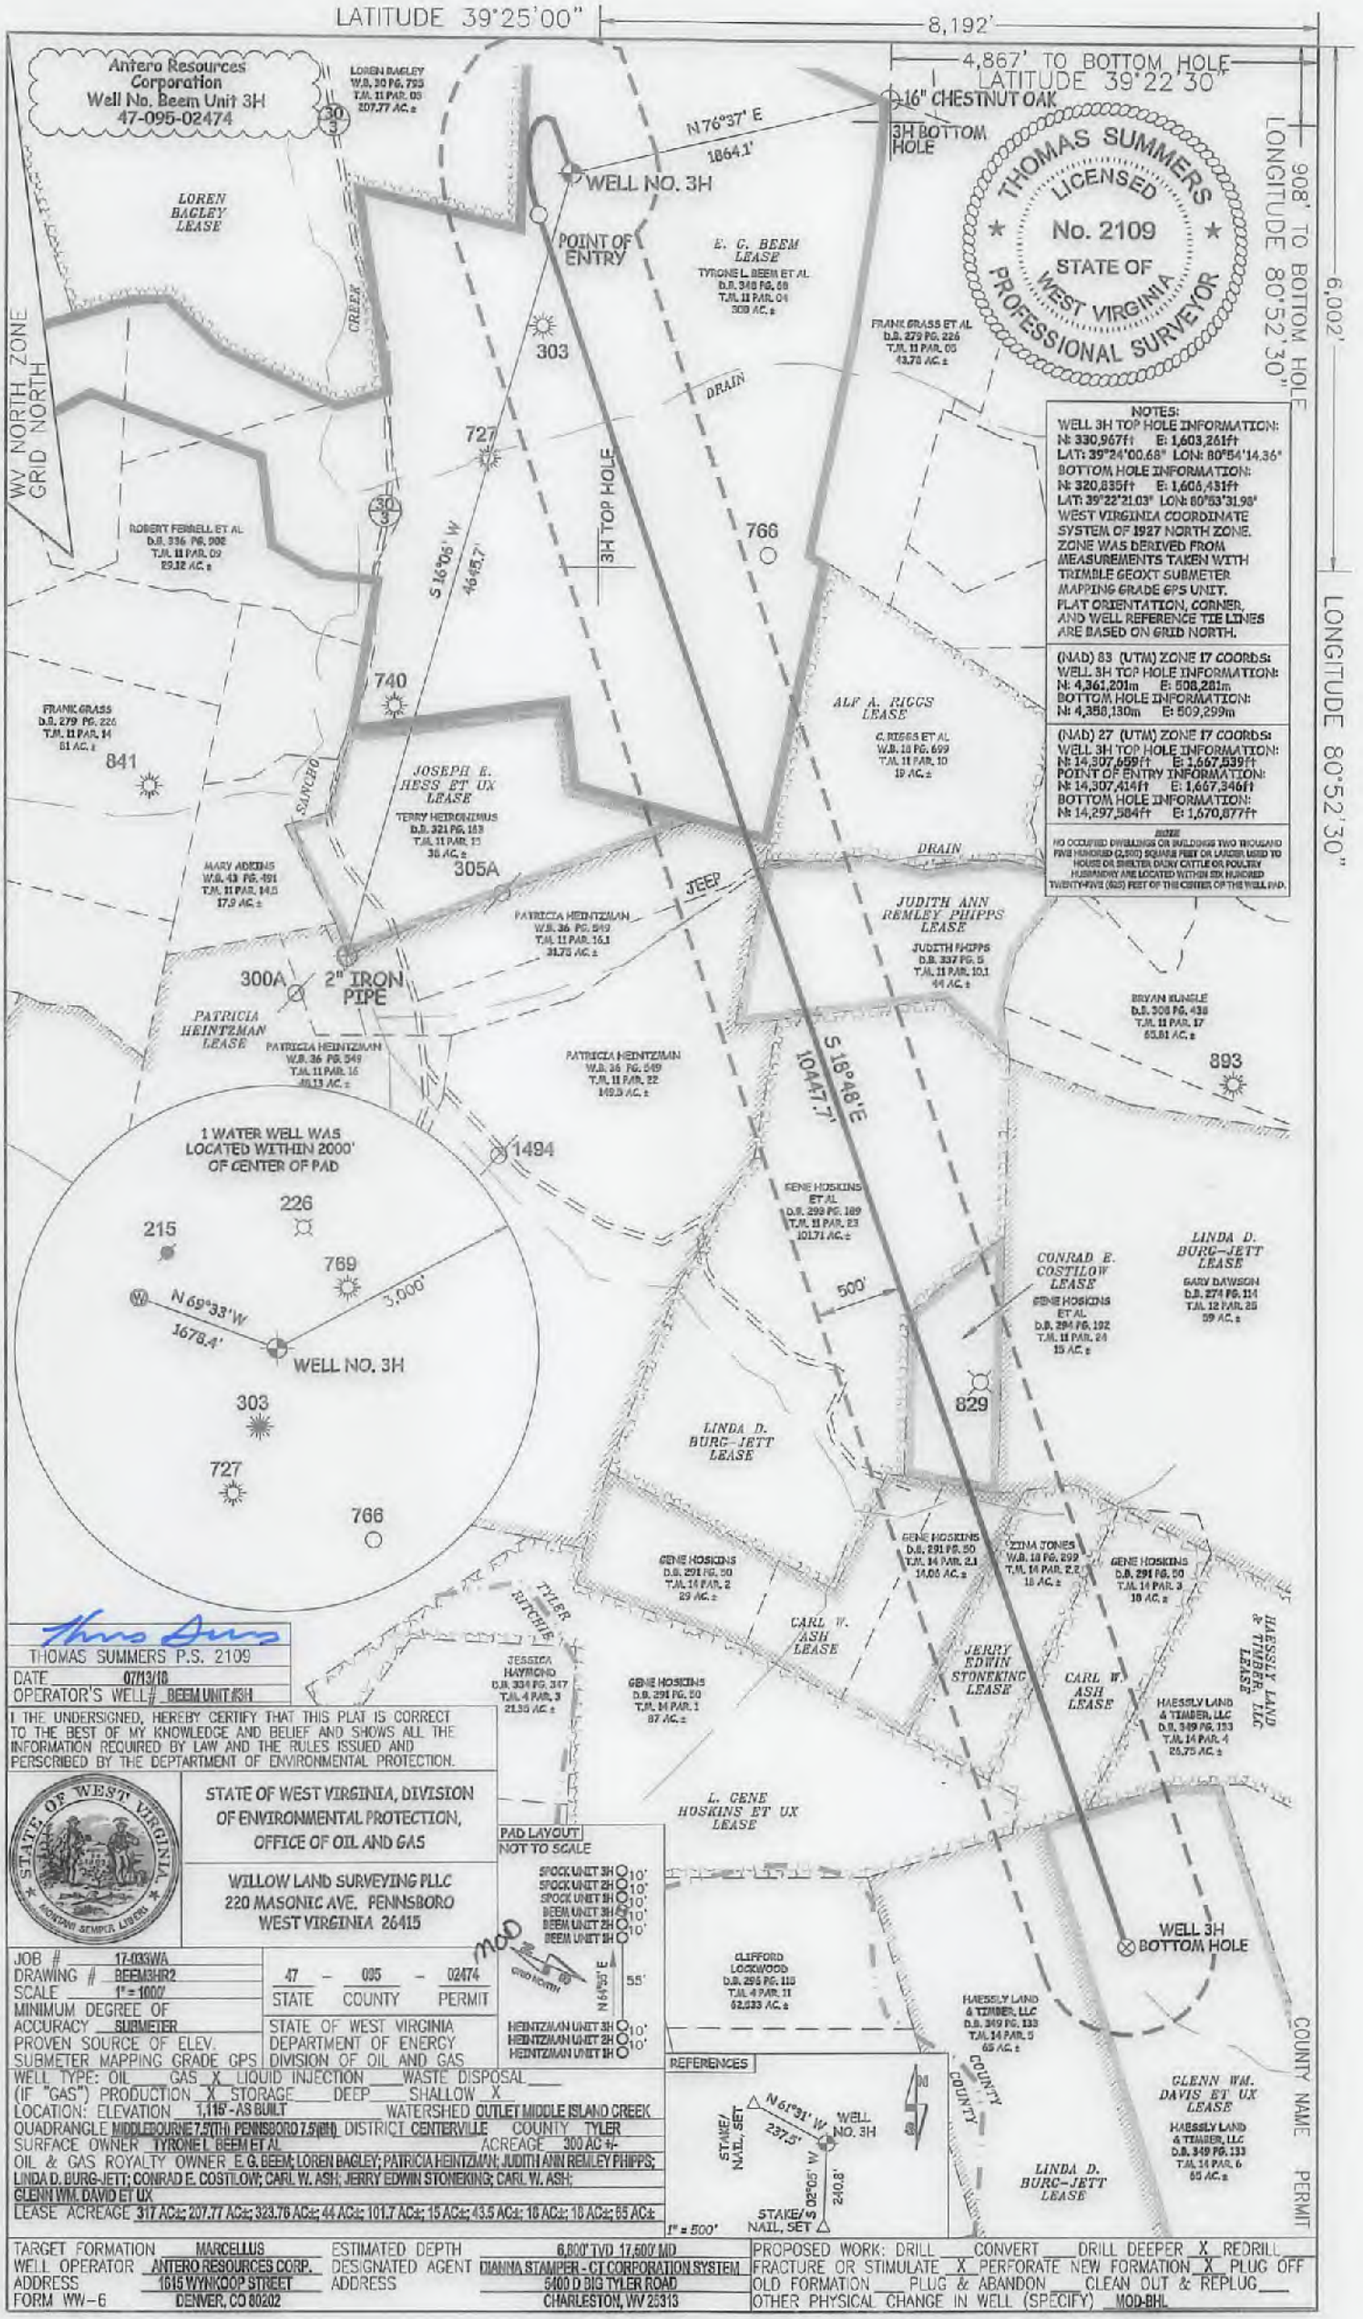

THOMAS SUMMERS P.S. 2109
DATE 07/13/18
OPERATOR'S WELL # BEEM UNIT #3H

I THE UNDERSIGNED, HEREBY CERTIFY THAT THIS PLAT IS CORRECT TO THE BEST OF MY KNOWLEDGE AND BELIEF AND SHOWS ALL THE INFORMATION REQUIRED BY LAW AND THE RULES ISSUED AND PERSCRIBED BY THE DEPTARTMENT OF ENVIRONMENTAL PROTECTION.

STATE OF WEST VIRGINIA, DIVISION OF ENVIRONMENTAL PROTECTION, OFFICE OF OIL AND GAS

WILLOW LAND SURVEYING PLLC
220 MASONIC AVE. PENNSBORO
WEST VIRGINIA 26415

JOB # 17-033WA
DRAWING # BEEM3HR2
SCALE 1" = 1000'
MINIMUM DEGREE OF ACCURACY SUBMETER
PROVEN SOURCE OF ELEV. SUBMETER MAPPING GRADE GPS

47 - 095 - 02474
STATE COUNTY PERMIT

STATE OF WEST VIRGINIA
DEPARTMENT OF ENERGY
DIVISION OF OIL AND GAS

WELL TYPE: OIL ___ GAS X LIQUID INJECTION ___ WASTE DISPOSAL ___
(IF "GAS") PRODUCTION X STORAGE ___ DEEP ___ SHALLOW X
LOCATION: ELEVATION 1,115' - AS BUILT WATERSHED OUTLET MIDDLE ISLAND CREEK
QUADRANGLE MIDDLEBOURNE 7.5(TH) PENNSBORO 7.5(BH) DISTRICT CENTERVILLE COUNTY TYLER
SURFACE OWNER TYRONE L. BEEM ET AL ACREAGE 300 AC +/-
OIL & GAS ROYALTY OWNER E. G. BEEM; LOREN BAGLEY; PATRICIA HEINTZMAN; JUDITH ANN REMLEY PHIPPS; LINDA D. BURG-JETT; CONRAD E. COSTILOW; CARL W. ASH; JERRY EDWIN STONEKING; CARL W. ASH; GLENN WM. DAVID ET UX
LEASE ACREAGE 317 AC±; 207.77 AC±; 323.76 AC±; 44 AC±; 101.7 AC±; 15 AC±; 43.5 AC±; 18 AC±; 18 AC±; 65 AC±

TARGET FORMATION MARCELLUS
WELL OPERATOR ANTERO RESOURCES CORP.
ADDRESS 1615 WYNKOOP STREET
FORM WW-6 DENVER, CO 80202

ESTIMATED DEPTH 6,800' TVD 17,500' MD
ADDRESS 5400 D BIG TYLER ROAD
CHARLESTON, WV 25313

PROPOSED WORK: DRILL ___ CONVERT ___ DRILL DEEPER X REDRILL ___
FRACTURE OR STIMULATE X PERFORATE NEW FORMATION X PLUG OFF OLD FORMATION ___ PLUG & ABANDON ___ CLEAN OUT & REPLUG ___
OTHER PHYSICAL CHANGE IN WELL (SPECIFY) MOD-BHL