

WW-7
8-30-06



West Virginia Department of Environmental Protection
Office of Oil and Gas
WELL LOCATION FORM: GPS

API: Unknown WELL NO.: Unknown
 FARM NAME: Grimm, Dennis
 RESPONSIBLE PARTY NAME: Antero Resources Corporation
 COUNTY: Tyler DISTRICT: McElroy
 QUADRANGLE: Center Point & Shirley
 SURFACE OWNER: Stephen R. & Tamera K. Grimm, Gary & Lori Dennis
 ROYALTY OWNER: Unknown
 UTM GPS NORTHING: 4360790.75 m
 UTM GPS EASTING: 521952.58 m GPS ELEVATION: 793.5 m^{FT.}

The Responsible Party named above has chosen to submit GPS coordinates in lieu of preparing a new well location plat for a plugging permit or assigned API number on the above well. The Office of Oil and Gas will not accept GPS coordinates that do not meet the following requirements:

- Datum: NAD 1983, Zone: 17 North, Coordinate Units: meters, Altitude: height above mean sea level (MSL) – meters.
- Accuracy to Datum: 3.05 meters
- Data Collection Method:

Survey grade GPS : Post Processed Differential _____
 Real-Time Differential

Mapping Grade GPS : Post Processed Differential _____
 Real-Time Differential

RECEIVED
Office of Oil and Gas

JUL 27 2018

WV Department of
Environmental Protection


- Letter size copy of the topography map showing the well location.**

I the undersigned, hereby certify this data is correct to the best of my knowledge and belief and shows all the information required by law and the regulations issued and prescribed by the Office of Oil and Gas.

May Sims
Signature

Permitting Supervisor
Title

6/25/18
Date

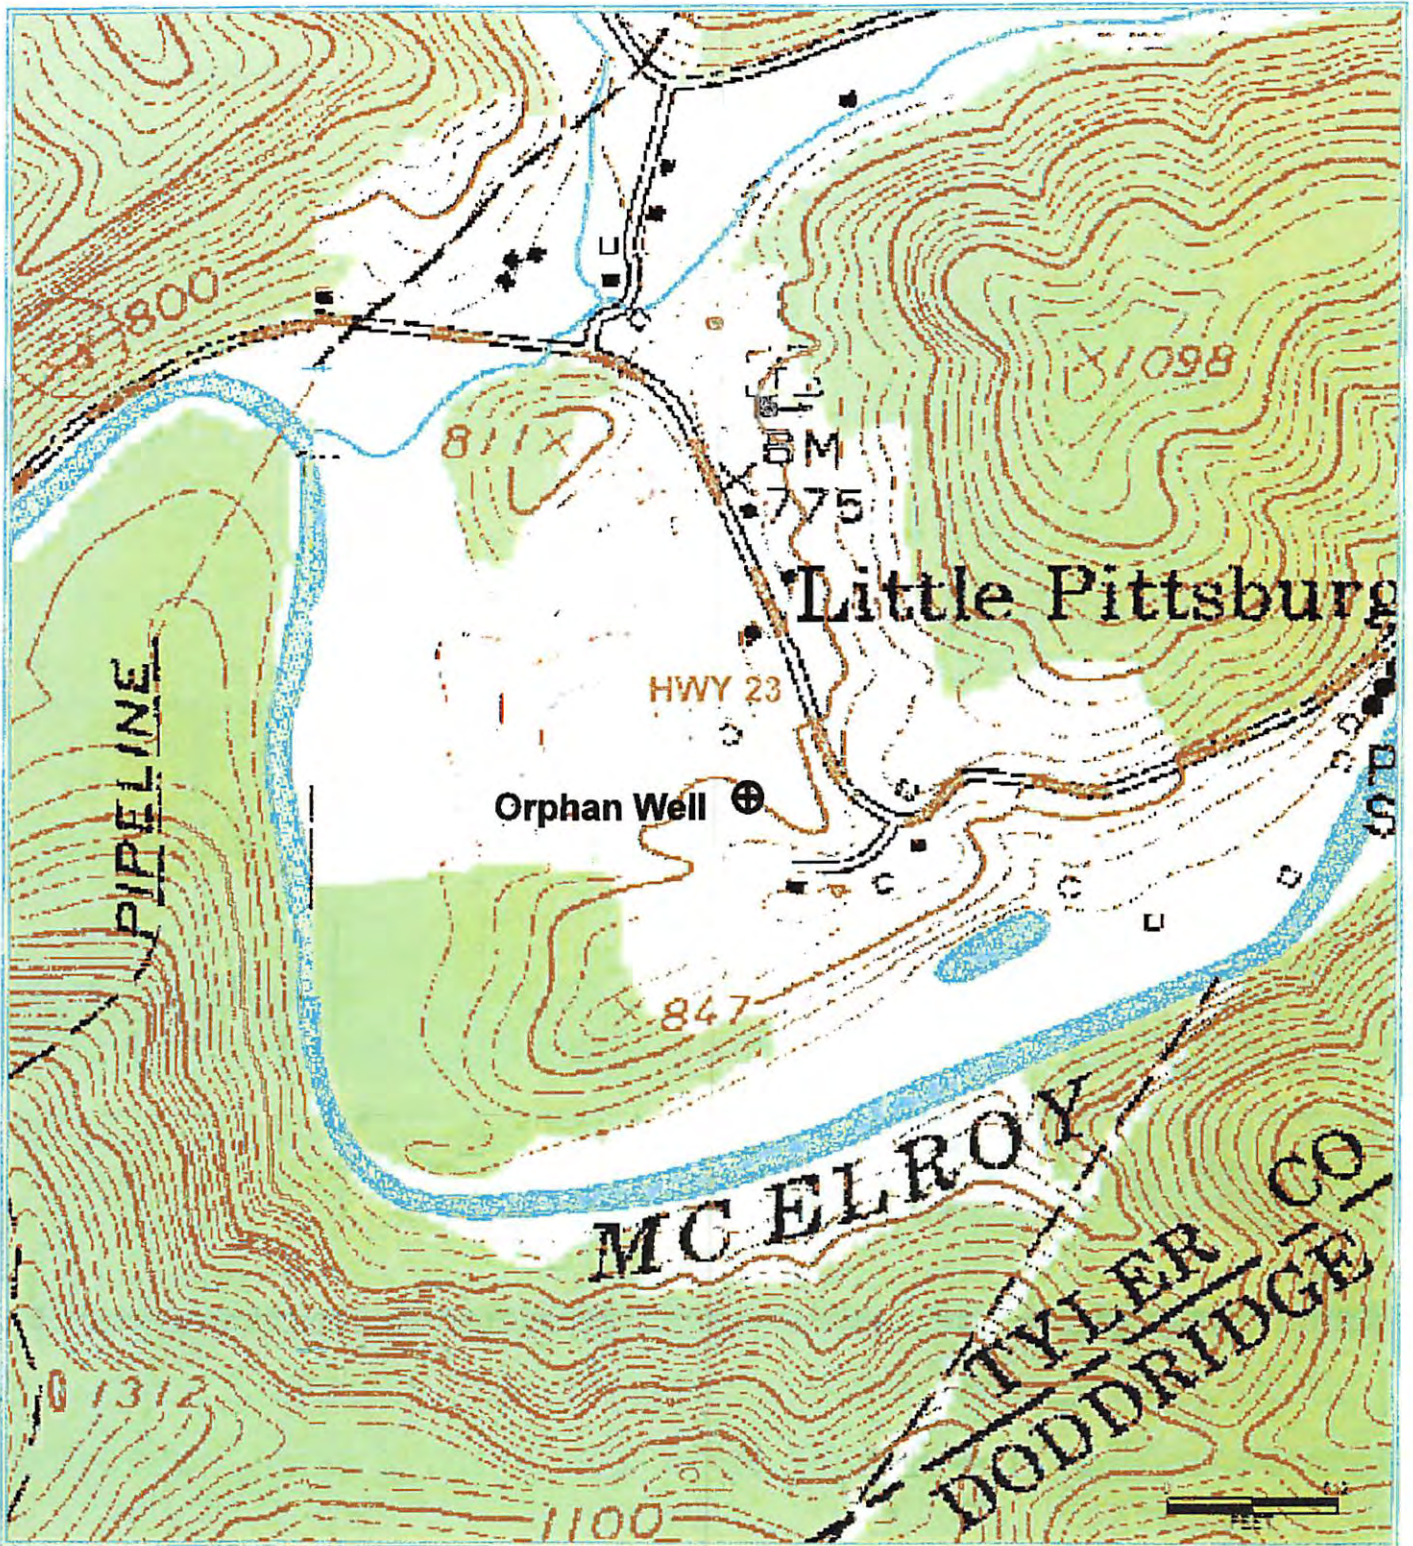

Antero Resources Corporation
Appalachian Basin
Orphan Well
Tyler County

Quadrangle: Center Point
Watershed: McElroy Creek
District: McElroy
Date: 4-30-2018

RECEIVED
Office of Oil and Gas

JUL 27 2018

WV Department of
Environmental Protection