

LATITUDE 39°25'00"

11,258'

6,193' TO BOTTOM HOLE

LATITUDE 39°25'00"

LONGITUDE 80°55'00"

589' LONGITUDE 80°55'00"

9,756' TO BOTTOM HOLE

Antero Resources Corporation Well No. Winchester Unit 2H


MARK A. KARL LEASE

- A - SURFACE - RAYMOND L. MOORE D.B. 285 PG. 310 T.M. 08 PAR. 29.1 1.10 AC. ±

AS DRILLED DATA: WELL 2H TOP HOLE INFORMATION: N: 336,616ft E: 1,588,507ft

(NAD) 83 (UTM) ZONE 17 COORDS: WELL 2H TOP HOLE INFORMATION: N: 4,362,846m E: 503,758m

NOTE: 7 WATER WELLS WERE LOCATED WITHIN 2000' OF CENTER OF PAD

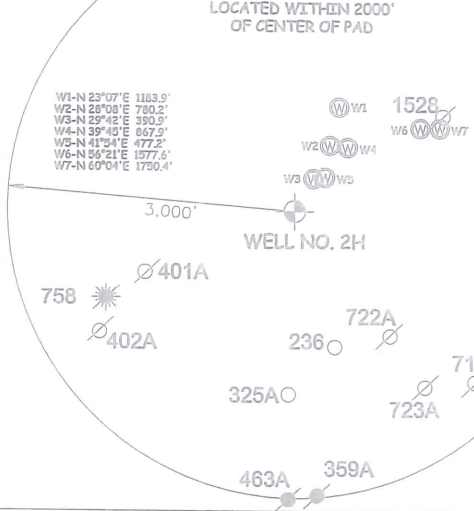

I THE UNDERSIGNED, HEREBY CERTIFY THAT THIS PLAT IS CORRECT TO THE BEST OF MY KNOWLEDGE AND BELIEF AND SHOWS ALL THE INFORMATION REQUIRED BY LAW AND THE RULES ISSUED AND PERSCRIBED BY THE DEPARTMENT OF ENVIRONMENTAL PROTECTION.



STATE OF WEST VIRGINIA, DIVISION OF ENVIRONMENTAL PROTECTION, OFFICE OF OIL AND GAS



JOB # 17-002WA DRAWING # WINCHESTER2HAD SCALE 1" = 1000'

Table with 2 columns: Description and Legend. Legend includes Surface Owner Boundary Lines +/-, Interior Surface Tracts +/-, Proposed Well Path, and As Drilled Well Path.

WELL TYPE: OIL GAS X LIQUID INJECTION WASTE DISPOSAL (IF "GAS") PRODUCTION X STORAGE DEEP SHALLOW X

SURFACE OWNER JAMES SINE ET AL ACREAGE 32.395 ACRES +/- OIL & GAS ROYALTY OWNER JAMES L. SINE ET UX; ROBERT S. CARSE ET UX; JASON GREATHOUSE; LEASE ACREAGE 54.74 ACRES +/-

- 1. NO OCCUPIED DWELLINGS OR BUILDINGS TWO THOUSAND FIVE HUNDRED (2,500) SQUARE FEET OR LARGER USED TO HOUSE OR SHELTER DAIRY CATTLE OR POULTRY HUSBANDRY ARE LOCATED WITHIN SIX HUNDRED TWENTY-FIVE (625) FEET OF THE CENTER OF THE WELL PAD.

47 STATE 095 COUNTY 02534 PERMIT

RICHARD R. BARNARD ET AL D.B. 270 PG. 231 T.M. 11 PAR. 13 91.55 AC. ±

GARY A. BARNARD ET UX LEASE

JOE-DOM INC. LEASE

KEVIN GRIM D.B. 326 PG. 52 T.M. 11 PAR. 14 90.5 AC. ±

WELL 2H BOTTOM HOLE

COUNTY NAME PERMIT