

References:

24" Double Black Oak

NUMBER	DIRECTION	DISTANCE
L1	N5°56'E	2,477.7'
L2	S04°41'E	2,815.8'
L3	N35°22'W	1,431.2'


As Drilled  
Permitted

LEGEND

Lease lines  
500' from well bore path  
Surface tracts within lease  
Adjoiner tracts

16" Double Shagbark Hickory Doc 7

- A- R. Dotson T.M. 11/5.2 1.0 Ac.
- B- Straight T.M. 11/5 0.88 Ac.
- C- Tennant & Tustin T.M. 11/6 46.51 Ac.
- D- T. Dotson T.M. 11/5 62.0 Ac.
- E- Jay Bee Oil & Gas, Inc T.M. 6/35.1 8.0 Ac. T3050C
- F- Coastal Forest Resources Co. Coastal Timberlands Co. T.M. 6/36 70.0 Ac.
- G- Westbrook T.M. 6/34 10.13 Ac. T3138
- H- A. Warner T.M. 6/10.1 0.968 Ac. T3098B
- I- Tallman T.M. 6/33 14.75 Ac. T3136C
- J- Fields & Leasure T.M. 11/52 1.25 Ac.
- K- Hoover T.M. 11/17.4 1.12 Ac. T3048A
- L- Hoover T.M. 11/17.2 0.25 Ac. T3048B3
- M- Lancaster T.M. 11/17.3 0.6 Ac. T3048B2
- N- Mt. Zion Cemetery T.M. 11/16 0.88 Ac.
- O- Headley T.M. 11/8 95.511 Ac.
- P- Headley T.M. 11/33.1 9.227 Ac.
- Q- Wilson & Black T.M. 11/17.1 0.65 Ac.
- R- Dave & Annie Underwood Est. T.M. 11/4 136.0 Ac.
- S- R. Warner T.M. 6/10.2 1.25 Ac.
- T- Tallman T.M. 6/30 25.75 Ac. T3136D, T3136E

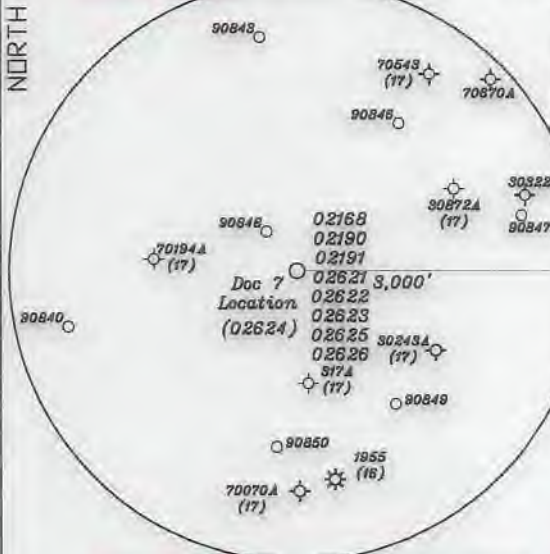

Top Hole - TH  
Geo NAD 83- 39.449133 N, 80.768225 W  
UTM NAD 83(Meters)-4366845.61 N, 519942.02 E  
UTM NAD 83(Feet)-14328236.47 N, 1705843.11 E

Landing Point - LP  
Geo NAD 83- 39.452311 N, 80.771221 W  
UTM NAD 83(Meters)-4366886.83 N, 519883.67 E  
UTM NAD 83(Feet)-14327389.10 N, 1704995.52 E

Bottom Hole - BH  
Geo NAD 83- 39.467383 N, 80.776443 W  
UTM NAD 83(Meters)-4368888.48 N, 519330.16 E  
UTM NAD 83(Feet)-14332873.12 N, 1709507.83 E

Top Hole - TH  
Geo NAD 83- 39.449140 N, 80.768230 W  
UTM NAD 83(Meters)-4366845.68 N, 519941.91 E  
UTM NAD 83(Feet)-14328236.72 N, 1705842.74 E

Landing Point - LP  
Geo NAD 83- 39.451000 N, 80.770868 W  
UTM NAD 83(Meters)-4368851.52 N, 519714.35 E  
UTM NAD 83(Feet)-14328912.03 N, 1705096.17 E


Bottom Hole - BH  
Geo NAD 83- 39.467398 N, 80.776394 W  
UTM NAD 83(Meters)-4368889.94 N, 519334.45 E  
UTM NAD 83(Feet)-14332877.96 N, 1709521.69 E

(+) DENOTES LOCATION OF WELL ON UNITED STATES TOPOGRAPHIC MAPS

FILE NO. \_\_\_\_\_  
DRAWING NO. 1  
SCALE 1" = 2000'  
MINIMUM DEGREE OF ACCURACY 1 in 200  
PROVEN SOURCE OF ELEVATION GPS  
submeter unit

I THE UNDERSIGNED, HEREBY CERTIFY THAT THIS PLAT IS CORRECT TO THE BEST OF MY KNOWLEDGE AND BELIEF AND SHOWS ALL THE INFORMATION REQUIRED BY LAW AND THE RULES ISSUED AND PRESCRIBED BY THE DEPARTMENT OF ENVIRONMENTAL PROTECTION.

(SIGNED) David L Jackson  
R.P.E. \_\_\_\_\_ P.S. 708

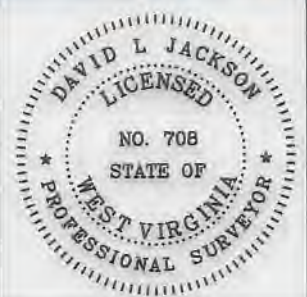

STATE OF WEST VIRGINIA  
Division of Environmental Protection  
OFFICE OF OIL AND GAS

DATE August 05, 2022  
OPERATOR'S WELL NO. Doc 7  
API WELL NO. \_\_\_\_\_

WELL TYPE: OIL GAS LIQUID INJECTION \_\_\_\_\_ WASTE DISPOSAL \_\_\_\_\_  
(IF "GAS") PRODUCTION X STORAGE \_\_\_\_\_ DEEP \_\_\_\_\_ SHALLOW X

LOCATION: ELEVATION 1,039.9' WATER SHED Indian Creek of Outlet Middle Island Creek (HUC-10)  
DISTRICT McElroy COUNTY Tyler  
QUADRANGLE Shirley 7 1/2'

SURFACE OWNER Francis W. Tennant Sr. & Randy W. Tustin ACREAGE 46.51 Ac.  
OIL & GAS ROYALTY OWNER Arnold Schulberg LEASE ACREAGE 46.51 Ac.  
LEASE NO. See Above

PROPOSED WORK: DRILL \_\_\_\_\_ CONVERT \_\_\_\_\_ DRILL DEEPER \_\_\_\_\_ REDRILL \_\_\_\_\_ FRACTURE OR  
STIMULATE \_\_\_\_\_ PLUG OFF OLD FORMATION \_\_\_\_\_ PERFORATE NEW  
FORMATION \_\_\_\_\_ OTHER PHYSICAL CHANGE IN WELL (SPECIFY) As Drilled

PLUG AND ABANDON \_\_\_\_\_ CLEAN OUT AND REPLUG \_\_\_\_\_  
TARGET FORMATION Marcellus ESTIMATED DEPTH TVD = 6,824'; TMD = 13,347'  
WELL OPERATOR Jay-Bee Oil & Gas, Inc. DESIGNATED AGENT Deborah Broda-Morgan  
ADDRESS 16 South Ave. W., Ste 118, Cranford NJ 07016 ADDRESS 429 Simonton Rd., Ellenboro, WV 26346

03/17/2023