

<b>Borehole:</b>	<b>Well:</b>	<b>Field:</b>	<b>Structure:</b>
Original Borehole	SHR-37H-HSM	WV Tyler County (NAD 27)	CNX SHR-37 Pad



<b>Gravity &amp; Magnetic Parameters</b>		<b>Surface Location</b>		<b>NAD27 West Virginia State Plane, Northern Zone, US Feet</b>		<b>Miscellaneous</b>	
Model:	HJGM 2019	Dip:	66.362°	Date:	11-Feb-2020	Lat:	N 39 21 11.39
Mag Dec:	-7.718°	FS:	51738.161Nt	Gravity FS:	999.338mgN (S.80665 Based)	Northing:	313589.03RUS
						Grid Conv:	-6.8582°
						Scale Fact:	0.99995202
						Plan:	CNX SHR-37H-HSM Surveys 01 to 208281 MD
						Slot:	SHR-37H-HSM
						TVD Ref:	RKB(857R above MSL)




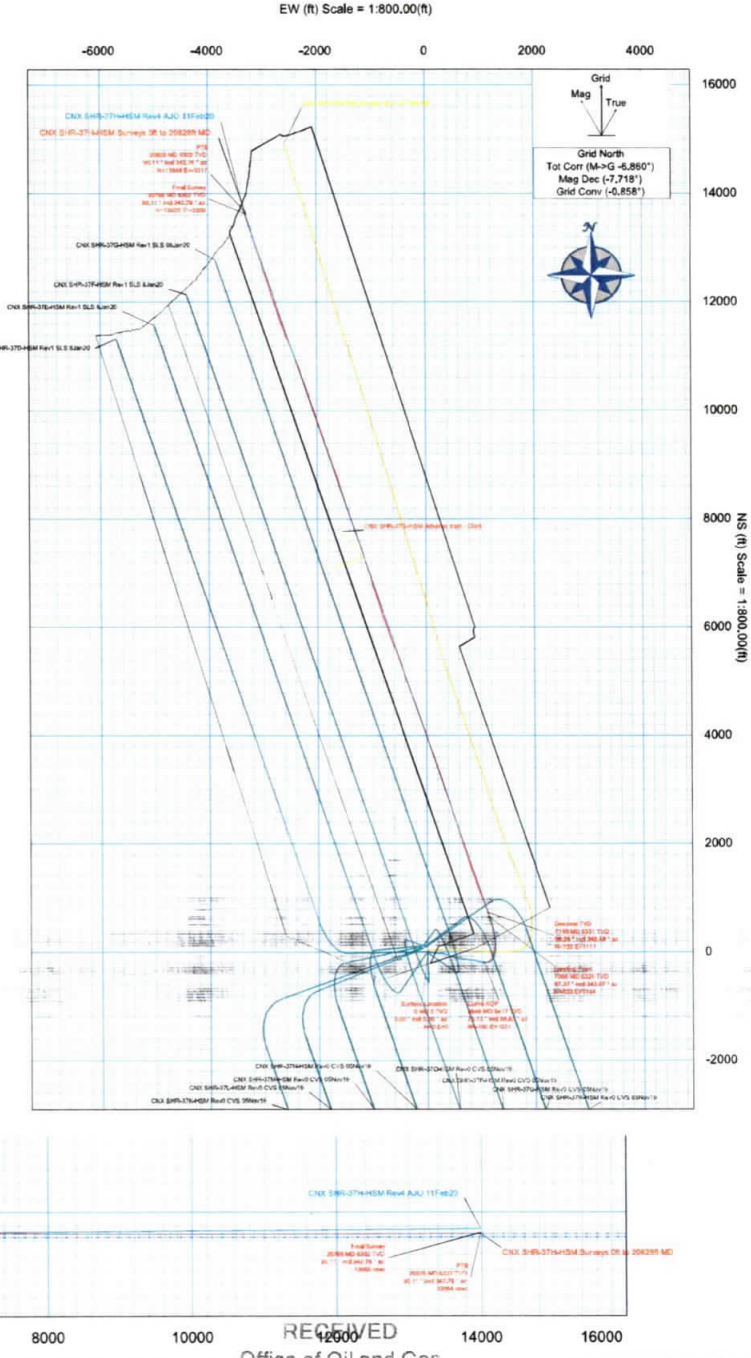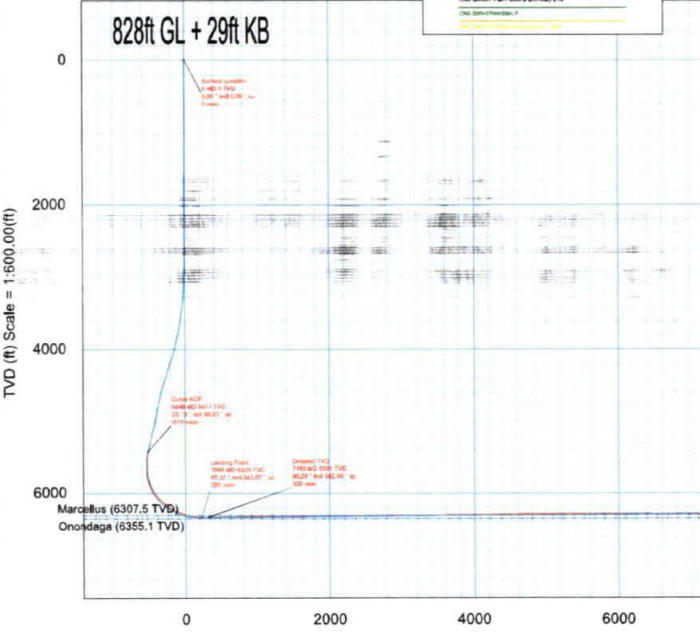

RECEIVED  
Office of Oil and Gas

JUL 12 2021

Environmental Protection











# CNX SHR-37H-HSM Surveys 0ft to 20828ft MD Survey Geodetic Report

(Def Survey)

**Report Date:** March 10, 2020 - 12:35 PM  
**Client:** CNX  
**Field:** WV Tyler County (NAD 27)  
**Structure / Slot:** CNX SHR-37 Pad / SHR-37H-HSM  
**Well:** SHR-37H-HSM  
**Borehole:** Original Borehole  
**UWI / API#:** Unknown / Unknown  
**Survey Name:** CNX SHR-37H-HSM Surveys 0ft to 20828ft MD  
**Survey Date:** February 11, 2020  
**Tort / AHD / DDI / ERD Ratio:** 279.606 ° / 15776.231 ft / 7.162 / 2.492  
**Coordinate Reference System:** NAD27 West Virginia State Plane, Northern Zone, US Feet  
**Location Lat / Long:** N 39° 21' 11.38742", W 80° 50' 44.29520"  
**Location Grid N/E Y/X:** N 313589.030 ftUS, E 1619491.764 ftUS  
**CRS Grid Convergence Angle:** -0.8582 °  
**Grid Scale Factor:** 0.99995202  
**Version / Patch:** 2.10.787.0

**Survey / DLS Computation:** Minimum Curvature / Lubinski  
**Vertical Section Azimuth:** 341.000 ° (Grid North)  
**Vertical Section Origin:** 0.000 ft, 0.000 ft  
**TVD Reference Datum:** RKB  
**TVD Reference Elevation:** 857.000 ft above MSL  
**Seabed / Ground Elevation:** 828.000 ft above MSL  
**Magnetic Declination:** -7.718 °  
**Total Gravity Field Strength:** 999.3376mgn (9.80665 Based)  
**Gravity Model:** GARM  
**Total Magnetic Field Strength:** 51738.161 nT  
**Magnetic Dip Angle:** 66.362 °  
**Declination Date:** February 11, 2020  
**Magnetic Declination Model:** HDGM 2019  
**North Reference:** Grid North  
**Grid Convergence Used:** -0.8582 °  
**Total Corr Mag North->Grid North:** -6.8596 °  
**Local Coord Referenced To:** Well Head

Comments	MD (ft)	Incl (°)	Azim Grid (°)	TVD (ft)	VSEC (ft)	NS (ft)	EW (ft)	DLS (°/100ft)	Northing (ftUS)	Easting (ftUS)	Latitude (N/S ° ' ")	Longitude (E/W ° ' ")
Surface Location	0.00	0.00	0.00	0.00	0.00	0.00	0.00	N/A	313589.03	1619491.76	N 39 21 11.39	W 80 50 44.30
	100.00	0.30	28.40	100.00	0.18	0.23	0.12	0.30	313589.26	1619491.89	N 39 21 11.39	W 80 50 44.29
	125.00	0.37	14.15	125.00	0.29	0.37	0.18	0.43	313589.40	1619491.94	N 39 21 11.39	W 80 50 44.29
	150.00	0.38	354.93	150.00	0.44	0.53	0.19	0.50	313589.56	1619491.95	N 39 21 11.39	W 80 50 44.29
	175.00	0.39	326.26	175.00	0.60	0.68	0.13	0.76	313589.71	1619491.90	N 39 21 11.39	W 80 50 44.29
	200.00	0.44	320.41	200.00	0.77	0.83	0.02	0.26	313589.86	1619491.79	N 39 21 11.40	W 80 50 44.30
	225.00	0.48	328.59	225.00	0.96	0.99	-0.09	0.31	313590.02	1619491.67	N 39 21 11.40	W 80 50 44.30
	250.00	0.35	346.14	250.00	1.14	1.15	-0.16	0.72	313590.18	1619491.60	N 39 21 11.40	W 80 50 44.30
	275.00	0.22	3.42	275.00	1.26	1.27	-0.18	0.62	313590.30	1619491.58	N 39 21 11.40	W 80 50 44.30
	300.00	0.21	0.27	300.00	1.35	1.37	-0.18	0.06	313590.40	1619491.59	N 39 21 11.40	W 80 50 44.30
	325.00	0.21	27.99	325.00	1.43	1.45	-0.15	0.40	313590.48	1619491.61	N 39 21 11.40	W 80 50 44.30
	350.00	0.15	346.54	350.00	1.49	1.53	-0.14	0.56	313590.56	1619491.62	N 39 21 11.40	W 80 50 44.30
	375.00	0.01	266.57	375.00	1.52	1.56	-0.15	0.59	313590.59	1619491.61	N 39 21 11.40	W 80 50 44.30
	399.00	0.08	185.32	399.00	1.51	1.54	-0.15	0.33	313590.57	1619491.61	N 39 21 11.40	W 80 50 44.30
	504.00	0.56	33.14	503.99	1.76	1.90	0.12	0.60	313590.93	1619491.88	N 39 21 11.41	W 80 50 44.29
	599.00	0.40	30.81	598.99	2.25	2.57	0.54	0.17	313591.60	1619492.31	N 39 21 11.41	W 80 50 44.29
	683.00	0.10	326.91	692.99	2.55	2.92	0.67	0.39	313591.95	1619492.43	N 39 21 11.42	W 80 50 44.29
	787.00	0.11	3.88	786.99	2.71	3.08	0.63	0.07	313592.11	1619492.39	N 39 21 11.42	W 80 50 44.29
	882.00	0.35	29.45	881.99	2.98	3.42	0.78	0.27	313592.45	1619492.54	N 39 21 11.42	W 80 50 44.29
	976.00	0.16	133.35	975.99	3.06	3.58	1.01	0.45	313592.61	1619492.78	N 39 21 11.42	W 80 50 44.28
	1071.00	0.75	107.46	1070.98	2.57	3.31	1.70	0.64	313592.34	1619493.47	N 39 21 11.42	W 80 50 44.27
	1166.00	0.82	126.85	1165.98	1.64	2.71	2.84	0.29	313591.74	1619494.60	N 39 21 11.41	W 80 50 44.26
	1260.00	1.02	137.69	1259.96	0.31	1.69	3.94	0.28	313590.72	1619495.71	N 39 21 11.40	W 80 50 44.25
	1354.00	0.92	136.22	1353.95	-1.14	0.53	5.03	0.11	313589.56	1619496.79	N 39 21 11.39	W 80 50 44.23
	1449.00	0.78	122.81	1448.94	-2.34	-0.37	6.10	0.26	313588.66	1619497.86	N 39 21 11.38	W 80 50 44.22
	1543.00	0.92	97.37	1542.93	-3.18	-0.82	7.38	0.42	313588.21	1619499.15	N 39 21 11.38	W 80 50 44.20
	1638.00	0.73	89.76	1637.92	-3.71	-0.91	8.75	0.23	313588.12	1619500.51	N 39 21 11.38	W 80 50 44.18

ENVIRONMENTAL PROTECTION  
 JUL 12 2021  
 WV Tyler County

Comments	MD (ft)	Incl (°)	Azim Grid (°)	TVD (ft)	VSEC (ft)	NS (ft)	EW (ft)	DLS (%/100ft)	Northing (RUS)	Easting (RUS)	Latitude (N/S ° ' ")	Longitude (E/W ° ' ")
	1732.00	0.54	87.13	1731.91	-4.03	-0.89	9.79	0.20	313588.14	1619501.55	N 39 21 11.38 W	80 50 44.17
	1827.00	0.91	110.46	1826.91	-4.63	-1.13	10.94	0.49	313587.90	1619502.70	N 39 21 11.38 W	80 50 44.16
	1921.00	0.57	111.24	1920.90	-5.41	-1.56	12.08	0.36	313587.47	1619503.84	N 39 21 11.37 W	80 50 44.14
	2015.00	0.50	82.34	2014.89	-5.79	-1.67	12.92	0.29	313587.36	1619504.68	N 39 21 11.37 W	80 50 44.13
	2110.00	0.43	125.14	2109.89	-6.16	-1.82	13.62	0.36	313587.21	1619505.38	N 39 21 11.37 W	80 50 44.12
	2204.00	0.42	75.70	2203.89	-6.47	-1.94	14.24	0.38	313587.09	1619506.01	N 39 21 11.37 W	80 50 44.11
	2295.00	0.37	101.23	2294.89	-6.65	-1.92	14.85	0.20	313587.11	1619506.62	N 39 21 11.37 W	80 50 44.11
	2303.00	0.09	40.45	2302.89	-6.66	-1.92	14.88	4.19	313587.11	1619506.65	N 39 21 11.37 W	80 50 44.11
	2401.00	0.05	168.71	2400.89	-6.66	-1.90	14.94	0.13	313587.13	1619506.71	N 39 21 11.37 W	80 50 44.10
	2495.00	0.39	205.56	2494.89	-6.93	-2.23	14.81	0.37	313586.80	1619506.58	N 39 21 11.37 W	80 50 44.11
	2590.00	0.34	255.66	2589.88	-7.14	-2.59	14.40	0.33	313586.44	1619506.16	N 39 21 11.36 W	80 50 44.11
	2684.00	0.37	275.78	2683.88	-6.99	-2.63	13.83	0.14	313586.40	1619505.59	N 39 21 11.36 W	80 50 44.12
	2779.00	0.51	284.26	2778.88	-6.63	-2.49	13.11	0.16	313586.54	1619504.88	N 39 21 11.36 W	80 50 44.13
	2873.00	1.75	98.14	2872.87	-7.05	-2.60	14.13	2.40	313586.44	1619505.89	N 39 21 11.36 W	80 50 44.11
	2967.00	4.59	99.82	2966.72	-9.52	-3.44	19.26	3.02	313585.59	1619511.02	N 39 21 11.36 W	80 50 44.05
	3062.00	6.61	93.55	3061.26	-13.45	-4.43	28.46	2.22	313584.60	1619520.22	N 39 21 11.35 W	80 50 43.93
	3157.00	8.40	93.20	3155.44	-18.17	-5.15	40.85	1.88	313583.88	1619532.61	N 39 21 11.34 W	80 50 43.77
	3251.00	9.92	96.83	3248.24	-24.29	-6.50	55.74	1.73	313582.53	1619547.50	N 39 21 11.33 W	80 50 43.58
	3345.00	11.86	101.74	3340.54	-32.76	-9.43	73.24	2.29	313579.60	1619565.00	N 39 21 11.31 W	80 50 43.36
	3439.00	15.42	102.02	3431.88	-44.14	-14.00	94.93	3.79	313575.03	1619586.69	N 39 21 11.26 W	80 50 43.08
	3534.00	18.89	95.97	3522.65	-57.15	-18.23	122.59	4.10	313570.80	1619614.34	N 39 21 11.23 W	80 50 42.73
	3627.00	21.58	90.84	3609.90	-69.31	-20.05	154.67	3.46	313568.99	1619646.42	N 39 21 11.21 W	80 50 42.32
	3725.00	24.83	89.56	3699.96	-81.98	-20.15	193.27	3.36	313568.88	1619685.03	N 39 21 11.22 W	80 50 41.83
	3819.00	27.28	95.03	3784.42	-97.04	-21.89	234.48	3.65	313567.14	1619726.23	N 39 21 11.21 W	80 50 41.31
	3914.00	26.22	98.82	3869.25	-115.54	-26.84	276.94	1.92	313562.20	1619768.69	N 39 21 11.16 W	80 50 40.77
	4008.00	24.05	103.88	3954.36	-135.47	-34.44	316.09	3.41	313554.59	1619807.84	N 39 21 11.09 W	80 50 40.27
	4103.00	23.08	111.81	4041.46	-158.16	-46.00	352.18	3.49	313543.03	1619843.93	N 39 21 10.98 W	80 50 39.80
	4197.00	25.21	114.93	4127.23	-184.09	-61.29	387.45	2.64	313527.74	1619879.19	N 39 21 10.84 W	80 50 39.35
	4291.00	27.17	113.62	4211.58	-212.51	-78.33	425.27	2.17	313510.71	1619917.01	N 39 21 10.68 W	80 50 38.87
	4386.00	29.46	105.62	4295.24	-240.49	-93.32	467.66	4.66	313495.72	1619959.40	N 39 21 10.53 W	80 50 38.32
	4480.00	30.74	106.36	4376.56	-267.52	-106.31	512.98	1.42	313482.73	1620004.71	N 39 21 10.41 W	80 50 37.75
	4575.00	33.05	99.24	4457.24	-293.84	-117.31	561.86	4.64	313471.73	1620053.60	N 39 21 10.31 W	80 50 37.12
	4669.00	31.81	96.18	4536.59	-316.52	-124.09	611.80	2.19	313464.94	1620103.53	N 39 21 10.25 W	80 50 36.48
	4764.00	29.78	93.96	4618.19	-336.37	-128.42	660.23	2.45	313460.62	1620151.96	N 39 21 10.22 W	80 50 35.87
	4858.00	27.93	94.79	4700.52	-354.36	-131.87	705.46	2.01	313457.17	1620197.19	N 39 21 10.19 W	80 50 35.29
	4952.00	27.96	98.64	4783.56	-373.47	-137.02	749.19	1.92	313452.02	1620240.92	N 39 21 10.14 W	80 50 34.73
	5050.00	25.71	96.82	4871.00	-393.39	-143.00	793.02	2.44	313446.04	1620284.74	N 39 21 10.09 W	80 50 34.17
	5144.00	23.78	95.36	4956.37	-410.09	-147.19	832.13	2.15	313441.85	1620323.86	N 39 21 10.06 W	80 50 33.68
	5240.00	24.15	99.09	5044.10	-427.32	-152.10	870.80	1.62	313436.94	1620362.52	N 39 21 10.01 W	80 50 33.18
	5333.00	23.71	104.80	5129.12	-446.68	-159.88	907.67	2.53	313429.16	1620399.39	N 39 21 9.94 W	80 50 32.71
	5428.00	23.25	105.60	5216.25	-467.95	-169.80	944.19	0.59	313419.24	1620435.91	N 39 21 9.85 W	80 50 32.24
	5522.00	23.97	104.51	5302.38	-489.03	-179.58	980.55	0.90	313409.46	1620472.26	N 39 21 9.76 W	80 50 31.78
	5583.00	24.99	101.10	5357.90	-502.33	-185.16	1005.19	2.86	313403.88	1620496.90	N 39 21 9.71 W	80 50 31.47
	5648.00	23.13	98.63	5417.25	-515.14	-189.72	1031.29	3.25	313399.32	1620523.00	N 39 21 9.66 W	80 50 31.13
	5743.00	22.36	82.43	5504.95	-527.39	-190.14	1067.69	6.62	313398.90	1620559.40	N 39 21 9.67 W	80 50 30.67
	5838.00	22.47	69.39	5592.83	-530.46	-181.36	1102.61	5.23	313407.67	1620594.32	N 39 21 9.76 W	80 50 30.23
	5932.00	22.63	64.92	5679.65	-528.04	-167.37	1135.81	1.83	313421.66	1620627.52	N 39 21 9.90 W	80 50 29.81
	6026.00	24.45	44.16	5765.94	-517.29	-145.67	1165.84	9.02	313443.37	1620657.55	N 39 21 10.12 W	80 50 29.43
	6121.00	27.05	27.46	5851.58	-493.47	-112.30	1189.58	8.06	313476.74	1620681.29	N 39 21 10.45 W	80 50 29.13
	6215.00	33.10	18.08	5932.93	-458.21	-68.87	1207.43	8.13	313520.17	1620699.13	N 39 21 10.89 W	80 50 28.91
	6310.00	39.85	11.72	6009.31	-411.28	-14.32	1221.68	8.14	313574.71	1620713.39	N 39 21 11.43 W	80 50 28.74
	6404.00	47.96	9.56	6076.97	-354.63	49.71	1233.62	8.79	313638.74	1620725.32	N 39 21 12.06 W	80 50 28.60
	6498.00	51.54	3.59	6137.72	-289.92	120.93	1241.73	6.15	313709.96	1620733.43	N 39 21 12.77 W	80 50 28.51
	6593.00	56.29	3.59	6193.74	-217.26	197.56	1241.09	8.35	313786.58	1620732.79	N 39 21 13.52 W	80 50 28.54
	6688.00	63.27	352.68	6241.58	-137.41	279.13	1232.69	7.85	313868.14	1620724.40	N 39 21 14.33 W	80 50 28.66
	6782.00	70.10	348.21	6278.80	-52.33	364.15	1218.29	8.50	313953.16	1620710.00	N 39 21 15.17 W	80 50 28.86
	6876.00	78.27	344.86	6304.41	37.61	452.00	1197.20	9.34	314041.01	1620688.91	N 39 21 16.03 W	80 50 29.14
	6971.00	82.30	343.37	6320.43	131.08	542.04	1171.57	4.51	314131.04	1620663.28	N 39 21 16.92 W	80 50 29.49

Comments	MD (ft)	Incl (°)	Azim (°)	Grid (°)	TVD (ft)	VSEC (ft)	NS (ft)	EW (ft)	DLS (*/100R)	Northing (RUS)	Easting (RUS)	Latitude (N/S ° ' ")	Longitude (E/W ° ' ")
Landing Point	7066.00	87.37	343.07		6328.98	225.60	632.60	1144.27	5.35	314221.60	1620635.97	N 39 21 17.81	W 80 50 29.85
	7160.00	90.28	342.68		6330.91	319.52	722.40	1116.60	3.12	314311.40	1620608.30	N 39 21 18.69	W 80 50 30.22
	7255.00	91.23	341.32		6329.66	414.49	812.74	1087.24	1.75	314401.73	1620578.95	N 39 21 19.58	W 80 50 30.61
	7350.00	91.40	338.63		6327.48	509.44	901.97	1054.72	2.84	314490.95	1620546.44	N 39 21 20.46	W 80 50 31.04
	7444.00	91.46	337.24		6325.13	603.27	989.05	1019.42	1.48	314578.03	1620511.14	N 39 21 21.31	W 80 50 31.51
	7539.00	91.12	338.32		6322.99	698.10	1076.97	983.51	1.19	314665.95	1620475.22	N 39 21 22.18	W 80 50 31.98
	7633.00	90.62	341.32		6321.57	792.06	1165.18	951.09	3.24	314754.15	1620442.81	N 39 21 23.04	W 80 50 32.41
	7728.00	90.78	339.97		6320.41	887.05	1254.80	919.61	1.43	314843.77	1620411.33	N 39 21 23.92	W 80 50 32.83
	7822.00	91.01	340.73		6318.94	981.03	1343.32	888.00	0.84	314932.28	1620379.72	N 39 21 24.79	W 80 50 33.25
	7917.00	90.90	340.99		6317.35	1076.01	1433.05	856.86	0.30	315022.01	1620348.58	N 39 21 25.68	W 80 50 33.66
	8012.00	90.17	341.62		6316.47	1171.01	1523.04	826.41	1.01	315111.99	1620318.13	N 39 21 26.56	W 80 50 34.07
	8106.00	90.50	341.11		6315.92	1265.00	1612.11	796.37	0.65	315201.06	1620288.10	N 39 21 27.44	W 80 50 34.47
	8201.00	90.84	342.66		6314.81	1359.98	1702.39	766.84	1.67	315291.33	1620258.56	N 39 21 28.32	W 80 50 34.86
	8295.00	90.28	341.78		6313.89	1453.96	1791.89	738.14	1.11	315380.83	1620229.86	N 39 21 29.20	W 80 50 35.24
	8389.00	90.50	341.93		6313.25	1547.94	1881.22	708.86	0.28	315470.15	1620200.59	N 39 21 30.08	W 80 50 35.63
	8483.00	90.34	342.39		6312.56	1641.92	1970.69	680.07	0.52	315559.63	1620171.80	N 39 21 30.96	W 80 50 36.01
	8578.00	90.39	342.54		6311.95	1736.89	2061.28	651.44	0.17	315650.21	1620143.18	N 39 21 31.85	W 80 50 36.40
	8672.00	90.73	342.08		6311.03	1830.86	2150.83	622.88	0.61	315739.75	1620114.61	N 39 21 32.74	W 80 50 36.78
	8767.00	90.22	341.92		6310.25	1925.84	2241.18	593.53	0.56	315830.09	1620085.26	N 39 21 33.62	W 80 50 37.17
	8861.00	90.45	341.31		6309.70	2019.83	2330.38	563.88	0.69	315919.29	1620055.62	N 39 21 34.50	W 80 50 37.56
	8956.00	90.39	341.88		6309.00	2114.82	2420.51	533.89	0.60	316009.42	1620025.62	N 39 21 35.39	W 80 50 37.96
	9050.00	90.56	341.95		6308.22	2208.81	2509.87	504.71	0.20	316098.77	1619996.45	N 39 21 36.27	W 80 50 38.35
	9145.00	90.22	341.99		6307.58	2303.79	2600.20	475.30	0.36	316189.10	1619967.04	N 39 21 37.15	W 80 50 38.74
	9239.00	89.94	341.60		6307.44	2397.78	2689.49	445.94	0.51	316278.39	1619937.68	N 39 21 38.03	W 80 50 39.13
	9334.00	90.39	342.01		6307.17	2492.77	2779.74	416.27	0.64	316368.63	1619908.02	N 39 21 38.92	W 80 50 39.53
	9428.00	90.45	341.71		6306.48	2586.76	2869.07	387.01	0.33	316457.96	1619878.75	N 39 21 39.80	W 80 50 39.92
	9523.00	90.06	341.77		6306.06	2681.75	2959.28	357.24	0.42	316548.17	1619848.99	N 39 21 40.69	W 80 50 40.31
	9617.00	90.50	341.96		6305.60	2775.74	3048.61	327.98	0.51	316637.49	1619819.73	N 39 21 41.56	W 80 50 40.70
	9711.00	90.39	341.47		6304.87	2869.73	3137.86	298.49	0.53	316726.74	1619790.24	N 39 21 42.44	W 80 50 41.09
	9806.00	90.11	341.58		6304.45	2964.72	3227.97	268.39	0.32	316816.84	1619760.14	N 39 21 43.33	W 80 50 41.49
	9900.00	90.39	341.61		6304.04	3058.72	3317.16	238.71	0.30	316906.02	1619730.46	N 39 21 44.20	W 80 50 41.89
	9995.00	90.45	341.78		6303.35	3153.71	3407.35	208.87	0.19	316996.21	1619700.63	N 39 21 45.09	W 80 50 42.29
	10089.00	90.06	341.22		6302.93	3247.70	3496.49	179.05	0.73	317085.34	1619670.80	N 39 21 45.97	W 80 50 42.68
	10184.00	90.22	340.15		6302.70	3342.70	3586.14	147.63	1.14	317174.99	1619639.38	N 39 21 46.85	W 80 50 43.10
	10278.00	89.78	340.50		6302.70	3436.69	3674.65	115.98	0.60	317263.50	1619607.74	N 39 21 47.72	W 80 50 43.52
	10373.00	90.67	340.91		6302.32	3531.69	3764.31	84.59	1.03	317353.16	1619576.35	N 39 21 48.60	W 80 50 43.94
	10467.00	90.56	340.70		6301.32	3625.68	3853.08	53.68	0.25	317441.92	1619545.44	N 39 21 49.47	W 80 50 44.35
	10556.00	89.94	340.84		6300.49	3814.68	4031.53	-8.57	0.34	317529.36	1619483.20	N 39 21 51.23	W 80 50 45.17
	10844.00	90.62	340.44		6299.57	4002.67	4208.90	-70.89	0.42	317797.72	1619420.88	N 39 21 52.97	W 80 50 46.00
	10939.00	90.45	340.91		6298.69	4097.67	4298.54	-102.32	0.53	317887.36	1619389.45	N 39 21 53.85	W 80 50 46.42
	11033.00	90.45	340.38		6297.95	4191.66	4387.23	-133.48	0.56	317976.04	1619358.30	N 39 21 54.72	W 80 50 46.83
	11127.00	90.39	340.70		6297.26	4285.66	4475.86	-164.79	0.35	318064.66	1619326.98	N 39 21 55.60	W 80 50 47.25
	11316.00	90.78	339.27		6295.33	4474.61	4653.43	-229.47	0.78	318242.22	1619262.30	N 39 21 57.34	W 80 50 48.10
	11411.00	90.78	340.60		6294.03	4569.58	4742.65	-262.06	1.40	318331.44	1619229.71	N 39 21 58.22	W 80 50 48.54
	11600.00	90.62	340.50		6291.73	4758.56	4920.85	-324.99	0.10	318509.64	1619166.79	N 39 21 59.97	W 80 50 49.37
	11695.00	90.50	340.21		6290.80	4853.55	5010.32	-356.93	0.33	318599.10	1619134.85	N 39 22 0.85	W 80 50 49.79
	11790.00	90.50	340.26		6289.97	4948.54	5099.72	-389.05	0.05	318688.49	1619102.73	N 39 22 1.73	W 80 50 50.22
	11884.00	90.73	340.46		6288.96	5042.53	5188.24	-420.65	0.32	318777.01	1619071.14	N 39 22 2.60	W 80 50 50.64
	12073.00	90.28	340.68		6287.29	5231.52	5366.47	-483.51	0.27	318955.23	1619008.27	N 39 22 4.35	W 80 50 51.47
	12167.00	90.56	341.00		6286.60	5325.51	5455.26	-514.37	0.45	319044.02	1618977.42	N 39 22 5.22	W 80 50 51.88
	12262.00	89.89	337.17		6286.23	5420.44	5543.99	-548.27	4.09	319132.74	1618943.52	N 39 22 6.09	W 80 50 52.33
	12356.00	89.66	338.52		6286.60	5514.30	5631.04	-583.72	1.46	319219.79	1618908.07	N 39 22 6.95	W 80 50 52.80
	12451.00	89.72	338.54		6287.11	5609.21	5719.45	-618.49	0.07	319308.19	1618873.30	N 39 22 7.82	W 80 50 53.26
	12545.00	89.78	340.43		6287.57	5703.17	5807.48	-651.43	2.01	319396.22	1618840.37	N 39 22 8.68	W 80 50 53.70
	12639.00	89.78	339.36		6287.98	5797.15	5895.75	-683.74	1.14	319484.49	1618808.06	N 39 22 9.55	W 80 50 54.12
	12734.00	89.06	341.52		6288.12	5892.14	5985.26	-715.55	2.29	319574.00	1618776.25	N 39 22 10.43	W 80 50 54.55
	12828.00	89.83	340.61		6288.21	5986.14	6074.18	-746.05	1.00	319662.90	1618745.75	N 39 22 11.30	W 80 50 54.95
	12922.00	89.00	341.57		6288.35	6080.13	6163.10	-776.51	1.04	319751.82	1618715.29	N 39 22 12.18	W 80 50 55.36

RECEIVED  
 Office of Oil and Gas  
 Environmental Protection  
 WV Department of

Comments	MD (ft)	Incl (°)	Azim (°)	Grid (°)	TVD (ft)	VSEC (ft)	NS (ft)	EW (ft)	DLS (°/100ft)	Northing (ftUS)	Easting (ftUS)	Latitude (N/S ° ' ")	Longitude (E/W ° ' ")
	13017.00	90.11	341.65		6288.26	6175.13	6253.25	-806.48	0.14	319841.97	1618685.32	N 39 22 13.07	W 80 50 55.76
	13111.00	89.89	341.73		6288.26	6269.12	6342.49	-836.01	0.25	319931.20	1618655.79	N 39 22 13.94	W 80 50 56.15
	13205.00	90.06	341.98		6288.30	6363.11	6431.82	-865.29	0.32	320020.53	1618626.52	N 39 22 14.82	W 80 50 56.54
	13300.00	89.16	342.27		6288.94	6458.09	6522.23	-894.44	1.00	320110.93	1618597.36	N 39 22 15.71	W 80 50 56.93
	13394.00	89.66	342.03		6289.91	6552.07	6611.70	-923.26	0.59	320200.40	1618568.55	N 39 22 16.59	W 80 50 57.31
	13489.00	89.55	342.31		6290.57	6647.04	6702.13	-952.34	0.32	320290.83	1618539.47	N 39 22 17.48	W 80 50 57.70
	13583.00	89.66	342.54		6291.21	6741.01	6791.74	-980.73	0.27	320380.43	1618511.09	N 39 22 18.36	W 80 50 58.08
	13678.00	89.61	344.03		6291.82	6835.93	6882.72	-1008.05	1.57	320471.41	1618483.77	N 39 22 19.26	W 80 50 58.44
	13772.00	89.27	342.03		6292.74	6929.86	6972.62	-1035.48	2.16	320561.30	1618456.33	N 39 22 20.14	W 80 50 58.81
	13867.00	89.61	341.69		6293.67	7024.85	7062.90	-1065.06	0.51	320651.57	1618426.76	N 39 22 21.03	W 80 50 59.20
	13961.00	89.50	342.16		6294.40	7118.83	7152.25	-1094.22	0.51	320740.93	1618397.60	N 39 22 21.91	W 80 50 59.59
	14056.00	89.16	341.63		6295.51	7213.81	7242.54	-1123.74	0.66	320831.21	1618368.08	N 39 22 22.80	W 80 50 59.98
	14245.00	89.50	342.21		6297.72	7402.78	7422.20	-1182.39	0.36	321010.86	1618309.43	N 39 22 24.56	W 80 51 0.77
	14339.00	89.22	341.06		6298.77	7496.76	7511.40	-1212.01	1.26	321100.06	1618279.82	N 39 22 25.44	W 80 51 1.16
	14433.00	89.83	341.45		6299.55	7590.76	7600.41	-1242.21	0.77	321189.06	1618249.61	N 39 22 26.31	W 80 51 1.56
	14528.00	89.78	341.24		6299.87	7685.76	7690.42	-1272.60	0.23	321279.07	1618219.23	N 39 22 27.20	W 80 51 1.97
	14623.00	89.50	340.54		6300.47	7780.75	7780.19	-1303.70	0.79	321368.83	1618188.13	N 39 22 28.08	W 80 51 2.38
	14716.00	89.72	340.53		6301.10	7873.75	7867.87	-1334.69	0.24	321456.50	1618157.14	N 39 22 28.94	W 80 51 2.79
	14811.00	89.44	340.54		6301.80	7968.74	7957.44	-1366.35	0.29	321546.07	1618125.49	N 39 22 29.82	W 80 51 3.21
	14905.00	89.72	340.80		6302.49	8062.74	8046.13	-1397.46	0.41	321634.76	1618094.37	N 39 22 30.70	W 80 51 3.62
	15094.00	89.89	341.74		6303.13	8251.73	8225.12	-1458.15	0.51	321813.74	1618033.69	N 39 22 32.46	W 80 51 4.43
	15189.00	89.66	341.84		6303.50	8346.72	8315.36	-1487.84	0.26	321903.98	1618004.00	N 39 22 33.34	W 80 51 4.83
	15282.00	89.94	342.54		6303.83	8439.70	8403.91	-1516.28	0.81	321992.52	1617975.56	N 39 22 34.21	W 80 51 5.20
	15377.00	89.50	341.77		6304.29	8534.68	8494.33	-1545.39	0.93	322082.94	1617946.45	N 39 22 35.10	W 80 51 5.59
	15471.00	89.94	342.62		6304.75	8628.66	8583.83	-1574.13	1.02	322172.43	1617917.71	N 39 22 35.98	W 80 51 5.98
	15566.00	89.94	342.28		6304.85	8723.63	8674.41	-1602.78	0.36	322263.00	1617889.06	N 39 22 36.87	W 80 51 6.36
	15661.00	90.00	341.74		6304.90	8818.61	8764.76	-1632.12	0.57	322353.35	1617859.72	N 39 22 37.76	W 80 51 6.75
	15755.00	89.72	340.58		6305.13	8912.61	8853.72	-1662.48	1.27	322442.31	1617829.37	N 39 22 38.64	W 80 51 7.15
	15850.00	89.94	340.63		6305.41	9007.61	8943.33	-1694.02	0.24	322531.91	1617797.83	N 39 22 39.52	W 80 51 7.57
	15945.00	89.78	340.53		6305.64	9102.60	9032.93	-1725.61	0.20	322621.51	1617766.24	N 39 22 40.40	W 80 51 7.99
	16039.00	89.89	340.55		6305.91	9196.60	9121.56	-1756.93	0.12	322710.13	1617734.93	N 39 22 41.27	W 80 51 8.41
	16134.00	89.94	340.82		6306.05	9291.60	9211.21	-1788.35	0.29	322799.78	1617703.51	N 39 22 42.15	W 80 51 8.82
	16228.00	89.72	340.39		6306.33	9385.60	9299.87	-1819.56	0.51	322888.44	1617672.29	N 39 22 43.02	W 80 51 9.24
	16322.00	89.78	340.77		6306.74	9479.59	9388.53	-1850.82	0.41	322977.09	1617641.04	N 39 22 43.89	W 80 51 9.65
	16417.00	89.72	340.56		6307.16	9574.59	9478.17	-1882.27	0.23	323066.72	1617609.59	N 39 22 44.78	W 80 51 10.07
	16606.00	89.94	341.93		6307.72	9763.58	9657.13	-1943.04	0.73	323245.67	1617548.83	N 39 22 46.54	W 80 51 10.88
	16700.00	89.94	341.22		6307.82	9857.58	9746.31	-1972.75	0.76	323334.85	1617519.12	N 39 22 47.41	W 80 51 11.27
	16889.00	89.83	340.61		6308.20	10046.58	9924.92	-2034.54	0.33	323513.45	1617457.32	N 39 22 49.17	W 80 51 12.10
	17078.00	89.78	341.85		6308.84	10235.57	10103.86	-2095.36	0.66	323692.39	1617396.51	N 39 22 50.93	W 80 51 12.90
	17267.00	89.89	341.56		6309.38	10424.55	10283.31	-2154.68	0.16	323871.82	1617337.19	N 39 22 52.69	W 80 51 13.69
	17361.00	89.89	340.61		6309.56	10518.55	10372.23	-2185.16	1.01	323960.74	1617306.72	N 39 22 53.57	W 80 51 14.10
	17456.00	90.39	340.16		6309.33	10613.55	10461.72	-2217.05	0.71	324050.22	1617274.83	N 39 22 54.45	W 80 51 14.52
	17550.00	89.72	340.07		6309.24	10707.53	10550.11	-2249.02	0.72	324138.61	1617242.86	N 39 22 55.31	W 80 51 14.95
	17644.00	90.17	340.04		6309.33	10801.52	10638.47	-2281.08	0.48	324226.97	1617210.79	N 39 22 56.18	W 80 51 15.37
	17739.00	90.06	340.31		6309.14	10896.51	10727.84	-2313.30	0.31	324316.34	1617178.58	N 39 22 57.06	W 80 51 15.80
	17928.00	90.11	339.54		6308.86	11085.48	10905.36	-2378.18	0.41	324493.84	1617113.71	N 39 22 58.81	W 80 51 16.66
	18117.00	90.00	338.27		6308.68	11274.35	11081.69	-2446.20	0.67	324670.16	1617045.69	N 39 23 0.54	W 80 51 17.56
	18211.00	89.89	339.18		6308.77	11368.27	11169.28	-2480.31	0.98	324757.75	1617011.58	N 39 23 1.40	W 80 51 18.01
	18306.00	90.11	338.48		6308.77	11463.20	11257.87	-2514.61	0.77	324846.34	1616977.28	N 39 23 2.27	W 80 51 18.46
	18400.00	89.83	337.98		6308.82	11557.09	11345.16	-2549.48	0.61	324933.63	1616942.42	N 39 23 3.13	W 80 51 18.93
	18495.00	90.47	338.18		6308.82	11651.97	11433.30	-2584.94	0.42	325021.75	1616906.95	N 39 23 3.99	W 80 51 19.39
	18589.00	90.34	339.17		6308.50	11745.89	11520.86	-2619.12	1.05	325109.31	1616872.77	N 39 23 4.85	W 80 51 19.85
	18683.00	90.06	340.30		6308.27	11839.86	11609.04	-2651.68	1.21	325197.49	1616840.21	N 39 23 5.72	W 80 51 20.28
	18872.00	89.88	340.42		6308.35	12028.85	11787.04	-2715.21	0.11	325375.48	1616776.69	N 39 23 7.47	W 80 51 21.12
	19062.00	89.94	342.20		6308.63	12218.84	11967.02	-2776.09	0.94	325555.45	1616715.81	N 39 23 9.24	W 80 51 21.93
	19155.00	89.94	342.14		6308.73	12311.82	12055.55	-2804.56	0.06	325643.98	1616687.34	N 39 23 10.11	W 80 51 22.31
	19249.00	89.94	342.04		6308.83	12405.80	12145.07	-2833.24	0.21	325733.49	1616658.67	N 39 23 10.99	W 80 51 22.69
	19343.00	89.94	341.97		6308.93	12499.78	12234.55	-2862.04	0.39	325822.96	1616629.86	N 39 23 11.87	W 80 51 23.08

WV Department of  
Environmental Protection

Office of Oil and Gas

RECEIVED

Comments	MD (ft)	Incl (°)	Azim Grid (°)	TVD (ft)	VSEC (ft)	NS (ft)	EW (ft)	DLS (°/100ft)	Northing (ftUS)	Easting (ftUS)	Latitude (N/S ° ' ")	Longitude (E/W ° ' ")
	19437.00	90.17	342.05	6308.84	12593.77	12323.95	-2891.08	0.26	325912.36	1616600.83	N 39 23 12.75 W	80 51 23.46
	19532.00	90.00	341.52	6308.70	12688.76	12414.19	-2920.77	0.59	326002.60	1616571.14	N 39 23 13.64 W	80 51 23.86
	19626.00	90.22	342.33	6308.52	12782.74	12503.55	-2949.93	0.89	326091.95	1616541.98	N 39 23 14.51 W	80 51 24.25
	19815.00	90.06	341.73	6308.05	12971.71	12683.33	-3008.24	0.33	326271.72	1616483.67	N 39 23 16.28 W	80 51 25.02
	20004.00	90.50	340.60	6307.13	13160.70	12862.20	-3069.26	0.64	326450.59	1616422.66	N 39 23 18.04 W	80 51 25.84
	20098.00	90.50	341.53	6306.31	13254.70	12951.11	-3099.76	0.99	326539.49	1616392.16	N 39 23 18.92 W	80 51 26.24
	20192.00	90.73	342.36	6305.30	13348.68	13040.48	-3128.89	0.92	326628.86	1616363.03	N 39 23 19.79 W	80 51 26.63
	20381.00	90.34	342.93	6303.54	13537.59	13220.86	-3185.27	0.37	326809.23	1616306.66	N 39 23 21.57 W	80 51 27.38
	20475.00	90.17	342.59	6303.12	13631.55	13310.64	-3213.13	0.40	326899.00	1616278.80	N 39 23 22.45 W	80 51 27.75
	20569.00	90.28	343.32	6302.75	13725.49	13400.51	-3240.68	0.79	326988.87	1616251.25	N 39 23 23.34 W	80 51 28.12
	20664.00	90.06	342.82	6302.47	13820.43	13491.39	-3268.34	0.58	327079.75	1616223.58	N 39 23 24.23 W	80 51 28.49
	20758.00	89.94	342.35	6302.47	13914.39	13581.08	-3296.48	0.52	327169.43	1616195.45	N 39 23 25.11 W	80 51 28.87
Final Survey	20799.00	90.11	342.76	6302.45	13955.38	13620.20	-3308.77	1.08	327208.55	1616183.16	N 39 23 25.50 W	80 51 29.03
PTB	20828.00	90.11	342.76	6302.39	13984.36	13647.89	-3317.36	0.00	327236.24	1616174.57	N 39 23 25.77 W	80 51 29.15

Survey Type: Def Survey

Survey Error Model: ISCWSA Rev 0 \*\*\* 3-D 95.000% Confidence 2.7955 sigma  
 Survey Program:

Description	Part	MD From (ft)	MD To (ft)	EOU Freq (ft)	Hole Size (in)	Casing Diameter (in)	Survey Tool Type	Borehole / Survey
	1	0.000	29.000	1/98.425	30.000	30.000	NAL_NSG+MSHOT-Depth Only	Original Borehole / CNX SHR-37H-HSM Surveys 0ft to 20828ft MD
	1	29.000	29.000	Act Stns	30.000	30.000	NAL_NSG+MSHOT-Depth Only	Original Borehole / CNX SHR-37H-HSM Surveys 0ft to 20828ft MD
	1	29.000	399.000	Act Stns	30.000	30.000	NAL_NSG+MSHOT	Original Borehole / CNX SHR-37H-HSM Surveys 0ft to 20828ft MD
	1	399.000	5583.000	Act Stns	30.000	30.000	NAL_MWD-NON_SLB	Original Borehole / CNX SHR-37H-HSM Surveys 0ft to 20828ft MD
	1	5583.000	20828.000	Act Stns	30.000	30.000	NAL_MWD_1.0_DEG	Original Borehole / CNX SHR-37H-HSM Surveys 0ft to 20828ft MD

RECEIVED  
 Office of Oil and Gas  
 JUL 12 2021  
 WV Department of  
 Environmental Protection