

LATITUDE 39°32'30"

9,123'

LATITUDE 39°30'00" 4,170' TO BOTTOM HOLE

Antero Resources Corporation Well No. Forster Unit 1H


AS DRILLED DATA: WELL 1H TOP HOLE INFORMATION: N: 377,232ft E: 1,638,300ft LAT: 39°31'43.09" LON: 80°46'56.44" BOTTOM HOLE INFORMATION: N: 363,037ft E: 1,643,057ft LAT: 39°29'23.46" LON: 80°45'53.19" WEST VIRGINIA COORDINATE SYSTEM OF 1927 NORTH ZONE. ZONE WAS DERIVED FROM MEASUREMENTS TAKEN WITH TRIMBLE GEOXT TAKEMETER MAPPING GRADE GPS UNIT. PLAT ORIENTATION, CORNER, AND WELL REFERENCE TIE LINES ARE BASED ON GRID NORTH.

(NAD) 83 (UTM) ZONE 17 COORDS: WELL 1H TOP HOLE INFORMATION: N: 4,375,474m E: 518,721m BOTTOM HOLE INFORMATION: N: 4,371,174m E: 520,242m

(NAD) 27 (UTM) ZONE 17 COORDS: WELL 1H TOP HOLE INFORMATION: N: 14,354,486ft E: 1,701,790ft POINT OF ENTRY INFORMATION: N: 14,354,410ft E: 1,702,003ft BOTTOM HOLE INFORMATION: N: 14,340,377ft E: 1,706,781ft

NOTE: 1 WATER WELL WAS LOCATED WITHIN 2000' OF THE CENTER OF PAD

WELL NO. 1H

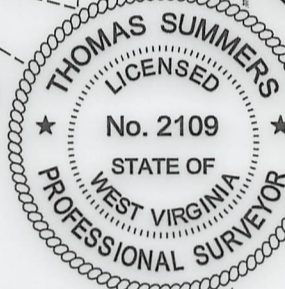

I THE UNDERSIGNED, HEREBY CERTIFY THAT THIS PLAT IS CORRECT TO THE BEST OF MY KNOWLEDGE AND BELIEF AND SHOWS ALL THE INFORMATION REQUIRED BY LAW AND THE RULES ISSUED AND PERSCRIBED BY THE DEPARTMENT OF ENVIRONMENTAL PROTECTION.



STATE OF WEST VIRGINIA, DIVISION OF ENVIRONMENTAL PROTECTION, OFFICE OF OIL AND GAS


WILLOW LAND SURVEYING PLLC 220 MASONIC AVE. PENNSBORO WEST VIRGINIA 26415

JOB # 20-014WA DRAWING # FORSTER1HAD SCALE 1" = 2000' MINIMUM DEGREE OF ACCURACY SUBMETER PROVEN SOURCE OF ELEV. SUBMETER MAPPING GRADE GPS

STATE OF WEST VIRGINIA DEPARTMENT OF ENERGY DIVISION OF OIL AND GAS

LEGEND: Surface Owner Boundary Lines +/- Interior Surface Tracts +/- Proposed Well Path As Drilled Well Path

DATE 05/11/23 OPERATOR'S WELL# FORSTER UNIT #1H

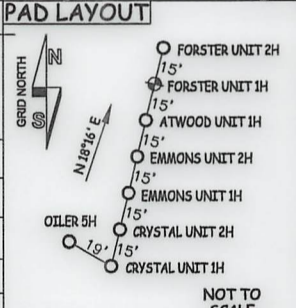

NOTE: 1. NO OCCUPIED DWELLINGS OR BUILDINGS TWO THOUSAND FIVE HUNDRED (2,500) SQUARE FEET OR LARGER USED TO HOUSE OR SHELTER DAIRY CATTLE OR POULTRY HUSBANDRY ARE LOCATED WITHIN SIX HUNDRED TWENTY-FIVE (625) FEET OF THE CENTER OF THE WELL PAD. 2. TOP HOLE DATA SHOWN HEREON WAS PROVIDED BY ANTERO RESOURCES CORPORATION. 3. AS DRILLED DATA WAS PROVIDED BY ANTERO RESOURCES CORPORATION. 4. WLS IS NOT CERTIFYING THE DATA AND INFORMATION PROVIDED LISTED IN NOTES 2 AND 3, ONLY THE RELATIONSHIP TO THE DATA AND INFORMATION PROVIDED TO THE LEASE BOUNDARIES. 5. WLS IS BY NO MEANS RESPONSIBLE FOR ANY ERRORS OR INACCURACIES WITH THE DATA AND INFORMATION THAT HAS BEEN PROVIDED.

WELL TYPE: OIL \_\_\_ GAS X LIQUID INJECTION \_\_\_ WASTE DISPOSAL \_\_\_ 47 - 095 - 02803 (IF "GAS") PRODUCTION X STORAGE \_\_\_ DEEP \_\_\_ SHALLOW X STATE COUNTY PERMIT LOCATION: ELEVATION 1,223' -AS BUILT WATERSHED OUTLET MIDDLE ISLAND CREEK QUADRANGLE PORTER FALLS 7.5' DISTRICT ELLSWORTH COUNTY TYLER SURFACE OWNER ANTERO MIDSTREAM LLC ACREAGE 50 ACRES +/-

OIL & GAS ROYALTY OWNER ELAINE L. OILER; ELSIE M. SNIVELY; JON MICHAEL DUMARS ET UX; ROBERT LOUIS BARD; LEASE ACREAGE 50 AC±: 53.75 AC±; 47.5 AC±; 30 AC±; VICTOR ALLEN CONWAY ET UX; JOYCE WILCOX; ELIZABETH G. MORRISON RICHIE; BRC APPALACHIAN MINERALS I LLC; BILLIE BLOYD; PHILLIP RONALD WILCOX; BRC APPALACHIAN MINERALS I LLC; BRC APPALACHIAN MINERALS I LLC; FIRST UNITED METHODIST CHURCH OF HUNTINGTON; 4.19 AC±; 29.67 AC±; 54.56 AC±; 93.25 AC±; 70 AC±; MARY JANE LEMASTERS; LOIS GAMBLE; DAVID E. BOWYER; TINA LOUISE ZEDIKER ET AL.; ANDREW HAUGHT ET UX 50 AC±; 10 AC±; 33 AC±; 35 AC±; 351.25 AC±

PROPOSED WORK: DRILL \_\_\_ CONVERT \_\_\_ DRILL DEEPER \_\_\_ REDRILL \_\_\_ FLAOURCE OR STIMULATE \_\_\_ PLUG OFF OLD FORMATION \_\_\_ PERFORATE NEW FORMATION \_\_\_ OTHER PHYSICAL CHANGE IN WELL (SPECIFY) AS DRILLED PLUG & ABANDON CLEAN OUT & REPLUG TARGET FORMATION MARCELLUS ESTIMATED DEPTH 6,994' TVD 22,041' MD WELL OPERATOR ANTERO RESOURCES CORP. DESIGNATED AGENT KEVIN ELLIS ADDRESS 1615 WYNKOOP ST. ADDRESS 535 WHITE OAKS BLVD BRIDGEPORT, WV 26330

WV NORTH ZONE GRID NORTH

3,697' TO BOTTOM HOLE LONGITUDE 80°45'00"

4,747' LONGITUDE 80°45'00"

Table listing landowners and their acreage for various units (1H, 2H) in the Ellsworth District, Tyler County. Owners include Elsie M. Snively, Elaine L. Oiler, Jon Michael Dumars et ux, Robert Louis Bard, Victor Allen Conway et ux, Joyce Wilcox, Susan Lancaster Green, Elizabeth G. Morrison Richie, Thomas P. Jobes, BRC Appalachian Minerals I LLC, Billie Bloyd, Phillip Ronald Wilcox, BRC Appalachian Minerals I LLC, Daniel Ferrell, Isabel Marie Minges, First United Methodist Church of Huntington, Mary Jane Lemasters, Lois Gamble, David E. Bowyer, Tina Louise Zediker et al., Andrew Haught et ux, Karen & Roger Enterprises LLC, and Martina Louise Zediker et al.

09/22/2023