





Tribune Resources



Borehole:		Well:		Field:		Structure:	
BFT 2H		BFT 2H		WV Tyler County (NAD 27)		Precision 578	
				BFT Lease Line 2			
Gravity & Magnetic Parameters				Surface Location		Miscellaneous	
Model: HDGM 2024 Dip: 66.168° Date: 28-Dec-2024				NAD27 West Virginia State Plane, Northern Zone, US Feet			
MagDec: -8.031° FS: 61477.827aT Gravity FS: 999.35mgals (9.80665 Based)				Lat: N 39 27 38.95 Northing: 362176.3891US Grid Conv: -0.758°		Site: BFT 2H TVD Ref: RKB (907.000 ft above MSL)	
				Lon: W 80 41 24.27 Easting: 1663996.8381US Scale Fact: 0.99994488		Plan: Tribune Resources BFT 2H Rev7 SLS 28Dec24	


Surface	0.00	0.00	0.00	0.00	0.00	0.00	0.00	0.00	0.00	
Final 3rd Party MWD	6.249.00	36.58	251.79	5.882.14	-5.11.09	-335.91	-1.604.54	4.575.14	3.51	
Final SLS MWD	6.276.00	35.51	249.95	5.903.07	-5.14.08	-341.12	-1.619.55	4.596.97	5.63	
LP	7.979.00	87.86	149.13	6.917.67	-182.08	-1.312.71	-1.910.47	6.010.67	2.61	
Final SLS MWD	19.805.00	90.08	150.79	6.928.51	-12.008.36	-11.555.81	-3.996.67	6.021.51	0.03	
PTB	19.854.00	90.08	150.79	6.928.44	-12.005.36	-11.558.58	-4.020.58	6.021.44	0.01	

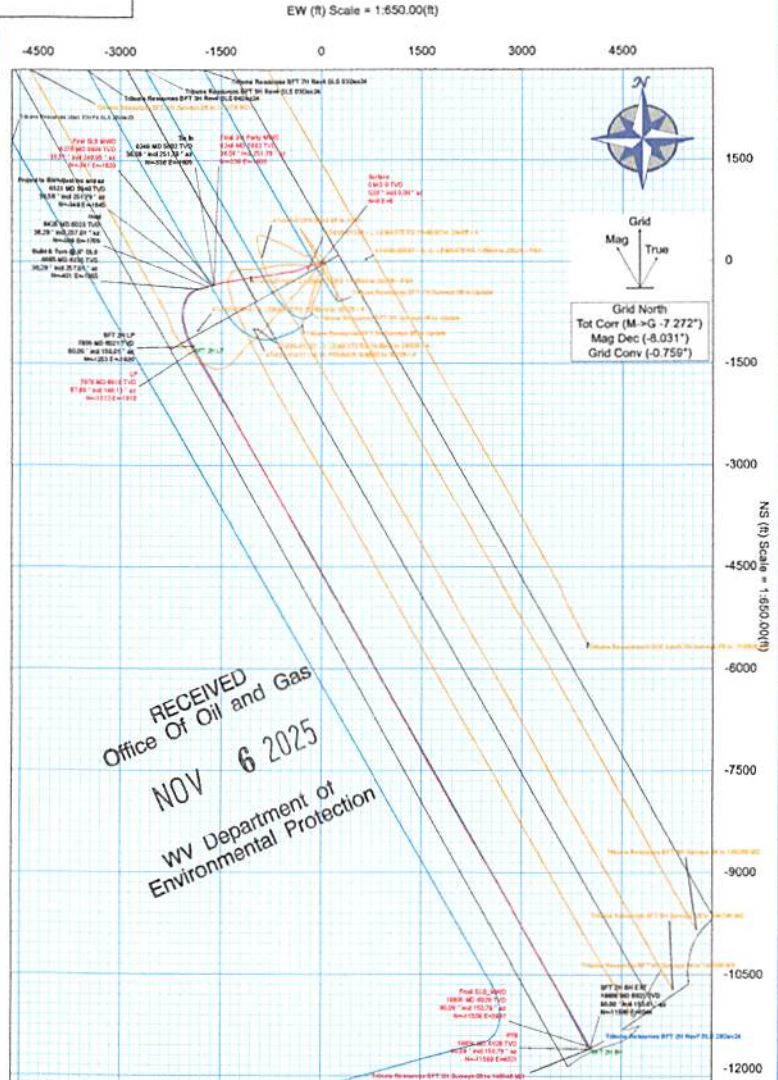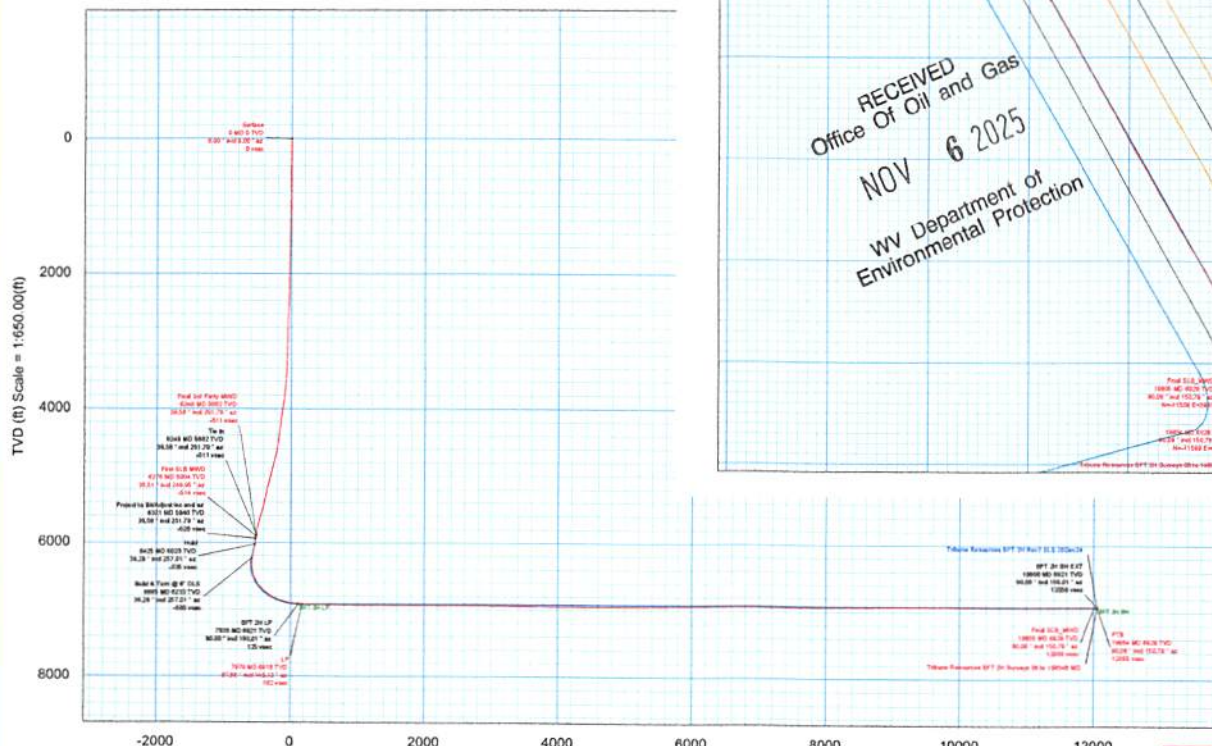

CONTROLLED	
Drawn by	J. Shuman
Checked by	
Drawn by	
Checked by	

12/19/2025



Tribune Resources BFT 2H Surveys Off to 19854ft MD Survey Geodetic
Report
Definitive Survey

Report Date: January 07, 2025 - 06:50 PM (UTC 0)
Client: Tribune Resources
Field: WV Tyler County (HAD 27)
Structure / Skit: Tribune Resources BFT Pad / BFT 2H
Well: BFT 2H
Borehole: BFT 2H
UBH / API / Job Number: Unknown / Unknown / Unknown
Survey Name / Version: Tribune Resources BFT 2H Surveys Off to 19854ft MD / 2
Survey Date: December 03, 2024
Tort / AHD / DOI / ERD Ratio: 270.072' / 14608.111' R / 7.058' / 2.131
Coordinate Reference System: NAD27 West Virginia State Plane, Northern Zone, US Feet
Location Lat / Long: N 39°27'38.94714", W 80°41'24.27374"
Location Grid N/E Y/X: N 39°27'38.94714", E 1063998.828 RUS
CRS Grid Convergence Angle: -0.759"
Grid Scale Factor: 0.99994488(Applied)
Engine Version: 2024.4.0.4

Survey / DLS Computation: Minimum Curvature / Lubinski
Vertical Section Azimuth: 150.010 (Grid North)
Vertical Section Origin: 0.000 ft, 0.000 ft
TVD Reference Datum: RKB
TVD Reference Elevation: 907.000 ft above MSL
Sealed / Ground Elevation: 890.000 ft above MSL
Magnetic Declination: -8.031"
Total Gravity Field Strength: 999.340 mgn (9.80665 Beesd)
Gravity Model: GARM
Total Magnetic Field Strength: 51477.627 nT
Magnetic Dip Angle: 66.168°
Declination Date: December 28, 2024
Magnetic Declination Model: HDGM 2024
North Reference: Grid
Total Corr Mag: -7.272"
Local Coord Referenced To: Well Head

RECEIVED
Office Of Oil and Gas
NOV 6 2025
WV Department of
Environmental Protection

Comments	MD	Incl	Azim	TVD	VSEC	NS	EW	TVDSS	DLS	Northing	Easting	Latitude	Longitude
	(m)	(°)	(°)	(m)	(m)	(m)	(m)	(m)	(m/100m)	(m)	(m)	(N/S ° ° °)	(E/W ° ° °)
Surface	0.00	0.00	0.00	0.00	0.00	0.00	0.00	-607.00		352.175.39	1,663,966.83	N 39°27'38.95"	W 80°41'24.27"
	130.00	0.27	244.28	130.00	-0.02	-0.13	-0.28	-277.00	0.21	352.175.26	1,663,966.55	N 39°27'38.95"	W 80°41'24.28"
	190.00	0.58	233.98	190.00	0.00	-0.37	-0.05	-717.00	0.53	352.175.02	1,663,966.18	N 39°27'38.94"	W 80°41'24.28"
	284.00	2.20	246.18	283.97	-0.15	-1.38	-0.66	-623.03	1.74	352.174.01	1,663,964.14	N 39°27'38.93"	W 80°41'24.31"
	373.00	4.48	248.47	372.81	-0.84	-3.35	-7.48	-534.19	2.57	352.172.05	1,663,969.35	N 39°27'38.91"	W 80°41'24.31"
	461.00	5.07	246.92	460.50	-1.81	-4.13	-14.26	-446.50	0.69	352.169.26	1,663,962.57	N 39°27'38.88"	W 80°41'24.40"
	552.00	3.72	235.24	551.24	-2.05	-6.39	-20.38	-355.76	1.77	352.166.00	1,663,978.45	N 39°27'38.85"	W 80°41'24.53"
	568.00	3.97	236.90	567.20	-1.98	-4.99	-21.27	-339.80	1.71	352.165.40	1,663,975.58	N 39°27'38.85"	W 80°41'24.54"
	642.00	4.56	239.03	641.00	-1.79	-6.00	-25.94	-268.00	0.83	352.163.48	1,663,970.89	N 39°27'38.82"	W 80°41'24.60"
	731.00	4.57	233.55	729.89	-1.30	-16.87	-32.01	-177.31	0.81	352.158.43	1,663,964.82	N 39°27'38.78"	W 80°41'24.68"
	821.00	4.67	236.00	819.38	-0.78	-21.15	-38.21	-87.42	0.52	352.154.25	1,663,958.02	N 39°27'38.73"	W 80°41'24.74"
	910.00	4.23	248.05	908.12	-1.21	-24.21	-44.37	1.12	1.03	352.151.19	1,663,952.48	N 39°27'38.70"	W 80°41'24.84"
	1000.00	4.20	254.43	997.87	-2.55	-26.28	-50.84	90.87	0.44	352.149.12	1,663,946.19	N 39°27'38.68"	W 80°41'24.91"
	1089.00	4.21	253.90	1086.63	-4.15	-28.05	-56.92	179.63	0.05	352.147.33	1,663,939.51	N 39°27'38.66"	W 80°41'24.99"
	1179.00	3.86	258.09	1176.41	-5.88	-29.60	-63.06	269.41	0.51	352.145.79	1,663,933.77	N 39°27'38.65"	W 80°41'25.07"
	1269.00	4.18	257.44	1268.19	-7.90	-30.94	-69.23	359.19	0.36	352.144.45	1,663,927.81	N 39°27'38.63"	W 80°41'25.15"
	1358.00	4.28	252.09	1354.95	-6.47	-32.67	-75.56	447.95	0.46	352.142.73	1,663,921.28	N 39°27'38.61"	W 80°41'25.23"
	1448.00	4.67	249.05	1444.66	-10.77	-35.07	-82.32	537.66	0.71	352.140.33	1,663,914.52	N 39°27'38.59"	W 80°41'25.32"
	1537.00	4.79	251.67	1533.34	-12.12	-37.59	-89.37	626.34	0.26	352.137.81	1,663,907.48	N 39°27'38.56"	W 80°41'25.41"
	1627.00	3.84	289.51	1623.09	-14.38	-38.80	-95.95	716.09	1.81	352.136.60	1,663,900.88	N 39°27'38.55"	W 80°41'25.49"
	1716.00	3.88	292.95	1711.89	-17.00	-39.19	-101.92	804.89	0.50	352.136.21	1,663,894.91	N 39°27'38.55"	W 80°41'25.57"
	1806.00	4.43	252.82	1801.65	-18.98	-40.59	-108.26	894.65	1.02	352.134.80	1,663,888.57	N 39°27'38.53"	W 80°41'25.65"
	1896.00	4.99	253.98	1890.35	-20.65	-42.67	-115.27	983.35	0.64	352.132.72	1,663,881.57	N 39°27'38.51"	W 80°41'25.74"
	1985.00	4.68	262.41	1979.96	-22.55	-45.10	-123.28	1072.66	0.78	352.130.30	1,663,873.85	N 39°27'38.49"	W 80°41'25.84"
	2075.00	6.83	261.80	2069.43	-24.61	-46.12	-132.60	1162.43	1.28	352.127.28	1,663,864.23	N 39°27'38.45"	W 80°41'25.95"
	2164.00	7.92	247.30	2157.69	-26.47	-52.14	-143.29	1250.69	1.39	352.123.26	1,663,853.55	N 39°27'38.41"	W 80°41'26.09"
	2254.00	8.88	246.65	2246.72	-28.06	-57.28	-155.39	1330.72	1.07	352.118.11	1,663,841.45	N 39°27'38.36"	W 80°41'26.20"
	2343.00	8.01	254.84	2334.76	-30.44	-61.63	-167.68	1427.76	1.67	352.113.77	1,663,829.16	N 39°27'38.32"	W 80°41'26.40"
	2433.00	7.98	261.83	2423.89	-34.30	-64.16	-179.92	1516.89	1.08	352.111.24	1,663,816.92	N 39°27'38.29"	W 80°41'26.56"
	2523.00	8.43	261.87	2512.97	-38.14	-65.98	-192.03	1605.97	0.50	352.109.42	1,663,804.21	N 39°27'38.27"	W 80°41'26.72"
	2612.00	8.76	259.20	2600.97	-40.99	-68.39	-205.72	1693.87	0.12	352.107.11	1,663,791.12	N 39°27'38.25"	W 80°41'26.87"
	2702.00	8.77	259.69	2689.92	-47.68	-71.38	-219.08	1782.62	0.43	352.104.02	1,663,777.78	N 39°27'38.21"	W 80°41'27.05"
	2792.00	8.90	252.55	2778.85	-51.05	-75.17	-232.37	1871.85	0.55	352.100.23	1,663,764.47	N 39°27'38.17"	W 80°41'27.22"
	2881.00	9.03	248.48	2866.76	-53.57	-78.79	-245.44	1959.76	0.73	352.095.61	1,663,751.41	N 39°27'38.13"	W 80°41'27.39"
	2971.00	8.85	247.57	2903.31	-54.37	-81.94	-250.77	1996.31	0.62	352.093.45	1,663,746.08	N 39°27'38.10"	W 80°41'27.48"
	3022.00	8.41	242.05	3006.14	-55.70	-85.66	-264.88	2099.14	0.90	352.089.84	1,663,731.96	N 39°27'38.04"	W 80°41'27.64"
	3111.00	9.01	243.77	3094.11	-58.38	-88.69	-276.88	2187.11	0.73	352.080.71	1,663,719.96	N 39°27'37.98"	W 80°41'27.79"
	3201.00	10.65	249.04	3182.79	-60.15	-90.78	-289.37	2275.79	2.08	352.074.62	1,663,705.87	N 39°27'37.91"	W 80°41'27.97"
	3290.00	11.93	250.58	3270.06	-61.13	-101.78	-303.63	2363.93	1.48	352.069.62	1,663,689.52	N 39°27'37.85"	W 80°41'28.15"
	3380.00	12.73	248.35	3357.99	-64.28	-113.53	-325.32	2450.99	1.03	352.061.87	1,663,671.53	N 39°27'37.78"	W 80°41'28.40"
	3470.00	13.66	251.14	3445.61	-67.77	-120.63	-344.59	2538.61	1.25	352.054.77	1,663,652.26	N 39°27'37.71"	W 80°41'28.65"
	3560.00	14.64	254.22	3532.88	-72.61	-127.16	-365.59	2625.88	1.37	352.048.24	1,663,631.26	N 39°27'37.64"	W 80°41'28.91"
	3649.00	15.75	257.42	3618.77	-78.98	-132.85	-388.21	2711.77	1.56	352.042.55	1,663,608.64	N 39°27'37.58"	W 80°41'29.20"
	3739.00	16.76	259.55	3705.17	-86.98	-137.88	-412.89	2798.17	1.30	352.037.54	1,663,583.96	N 39°27'37.53"	W 80°41'29.51"
	3828.00	17.48	260.04	3790.23	-95.95	-142.50	-436.67	2883.23	0.83	352.032.90	1,663,558.18	N 39°27'37.45"	W 80°41'29.84"
	3918.00	18.34	262.29	3875.67	-105.85	-146.74	-460.87	2968.67	1.23	352.028.88	1,663,533.66	N 39°27'37.40"	W 80°41'30.19"
	4007.00	18.12	264.95	3960.40	-116.89	-149.83	-483.06	3053.40	0.57	352.025.57	1,663,503.17	N 39°27'37.32"	W 80°41'30.54"
	4097.00	18.51	264.94	4045.84	-128.92	-152.33	-521.85	3136.84	0.43	352.023.06	1,663,475.00	N 39°27'37.30"	W 80°41'30.90"
	4186.00	19.84	262.22	4129.90	-140.58	-159.62	-560.89	3222.90	1.80	352.019.79	1,663,445.97	N 39°27'37.34"	W 80°41'31.27"
	4276.00	20.94	258.04	4214.27	-151.33	-161.02	-591.76	3307.27	2.03	352.014.39	1,663,415.10	N 39°27'37.28"	W 80°41'31.66"
	4366.00	22.11	258.30	4297.99	-161.63	-167.79	-614.08	3390.99	1.30	352.007.62	1,663,382.78	N 39°27'37.21"	W 80°41'32.07"
	4456.00	22.88	258.09	4380.22	-172.25	-174.78	-647.41	3473.22	0.87	352.000.05	1,663,349.45	N 39°27'37.14"	W 80°41'32.50"
	4545.00	24.33	256.42	4462.68	-183.53	-182.09	-682.89	3556.89	1.62	351.993.31	1,663,314.17	N 39°27'37.07"	W 80°41'32.95"
	4635.00	25.12	260.50	4544.43	-196.07	-188.97	-719.70	3637.43	1.31	351.986.44	1,663,277.17	N 39°27'36.99"	W 80°41'33.40"
	4725.00	27.21	261.90	4625.21	-210.43	-196.02	-758.92	3718.21	2.42	351.980.39	1,663,237.96	N 39°27'36.92"	W 80°41'33.92"
	4814.00	30.25	264.80	4703.25	-227.42	-198.92	-801.40	3796.25	3.76	351.975.49	1,663,195.48	N 39°27'36.87"	W 80°41'34.40"
	4904.00	31.16	263.97	4780.63	-246.39	-204.42	-847.13	3873.63	1.12	351.970.99	1,663,149.75	N 39°27'36.82"	W 80°41'35.04"
	4994.00	31.17	262.24	4857.54	-264.65	-210.49	-893.37	3950.64	0.99	351.965.39	1,663,103.51	N 39°27'36.75"	W 80°41'35.63"
	5083.00	31.84	261.78	4933.52	-282.07	-216.48	-939.42	4028.52	0.80	351.968.83	1,663,057.46	N 39°27'36.69"	W 80°41'36.21"
	5173.00	32.98	260.14	5008.55	-300.48	-220.79	-987.17	4106.95	1.41	351.962.62	1,663,009.71	N 39°27'36.62"	W 80°41'36.82"
	5263.00	34.50	262.17	5084.43	-319.89	-229.19	-1036.68	4185.43	1.90	351.946.23	1,662,960.20	N 39°27'36.55"	W 80°41'37.49"
	5353.00	36.00	261.55	5157.92	-339.01	-236.54	-1088.10	4263.95	1.71	351.938.87	1,662,906.79	N 39°27'36.47"	W 80°41'38.11"
	5442.00	34.62	260.24	5230.55	-357.36	-244.67	-1138.89	4343.55	1.77	351.930.74	1,662,858.00	N 39°27'36.38"	W 80°41'38.75"
	5532.00	32.22	258.72	5306.67	-373.80	-253.70	-1187.63	4423.67	2.82	351.921.71	1,662,		


Survey Error Model:
Survey Program:

ISO15926-3 - D 95% Confidence 2.7925 sigma

Description	Part	MD From (ft)	MD To (ft)	EOU Pres (ft)	Expected Max Inclination (deg)	Survey Tool Code	Vendor / Tool	Borehole / Survey
	1	0.000	0.249,000 Act Str			A00118_MWD		SPT 2H / Tribune Resources SPT 2H Surveys Oil to 195542 MD
	1	0.249,000	19,854,000 Act Str			B00318_MWD+IGRF		SPT 2H / Tribune Resources SPT 2H Surveys Oil to 195542 MD

EOU Geometry:

End MD (ft)	Well Size (in)	Casing Size (in)	Name
660,000	17.500	13.375	
3,000,000	12.250	9.625	
0,249,000	8.750	8.750	
19,854,000	8.500	5.500	

RECEIVED
Office Of Oil and Gas
NOV 6 2025
WV Department of
Environmental Protection