



Tribune Resources



Borehole:	BFT 6H	Well:	BFT 6H	Field:	WV Tyler County (NAD 27)	Structure:	Tribune Resources BFT Pad
-----------	--------	-------	--------	--------	--------------------------	------------	---------------------------

Gravity & Magnetic Parameters	Surface Location	Measurements
Model: HOGM 2024 MagDec: -8.031°	Dip: 66.173° Date: 06-Dec-2024 Gravity FS: 999.35mgal (9.80665 Based)	NAD27 West Virginia State Plane, Northern Zone, US Feet Lat: N 39 27 39.00 Northing: 362180.631US Easting: 1864028.421US Grid Conv: -0.7689° Scale Fact: 0.99994483
		Slot: BFT 6H TVD Ref: RKB (907,000 ft above MSL) Plan: Tribune Resources BFT 6H Rev6 SLB 16Dec24

Target Name	Slack	Direction	Latitude	Longitude	Depth	TVD	VSM	SLB	Local Count
BFT Lease Line 3	Proble	N/A	N 39 27 32.80	W 80 41 36.80	101617.20	100260.77	0.00	8.47	-1028.71
BFT Lease Line 7	Proble	N/A	N 39 28 36.08	W 80 42 5.71	308080.88	100270.46	0.00	-4828.82	-1028.71
BFT Lease Line 4	Proble	N/A	N 39 27 33.04	W 80 41 36.81	101606.97	100261.89	0.00	8.82	-1028.71
BFT Lease Line 6	Proble	N/A	N 39 27 32.80	W 80 41 36.81	101617.20	100260.77	0.00	8.47	-1028.71
BFT 6H Bit	Point	N/A	N 39 28 53.87	W 80 40 15.21	301463.78	100270.46	0.00	-4828.82	-1028.71
BFT 6H LF	Point	N/A	N 39 27 33.04	W 80 41 36.81	101606.97	100261.89	0.00	8.82	-1028.71

Comments	Survey MD (ft)	Instrument (ft)	Annular (ft)	TVD (ft)	VSM (ft)	SLB (ft)	EW (ft)	Sub-Sea (ft)	Dist (m)
Surface	0.00	0.00	0.00	0.00	0.00	0.00	0.00	0.00	-907.00
Final 3rd Party MWD	5,981.00	17.56	291.72	5,866.14	-771.06	375.43	-892.06	4,959.14	0.75
Final SLB_MWD	6,093.00	18.08	289.10	5,972.77	-797.46	387.37	-924.18	5,065.77	0.85
Final SLB_MWD	19,443.00	90.00	149.66	6,913.58	11,878.26	-10,700.13	5,223.05	6,006.58	0.19
PTB	19,479.00	90.00	149.66	6,913.58	11,914.26	-10,731.20	5,241.24	6,006.58	0.00

CONTROLLED

Plan and
Surveying
Copy number
Date
Drawn By
Checked By


Tribune Resources BFT 6H Rev6 SLB 16Dec24

1 of 3


24-01-2025

J.C. Sams

for

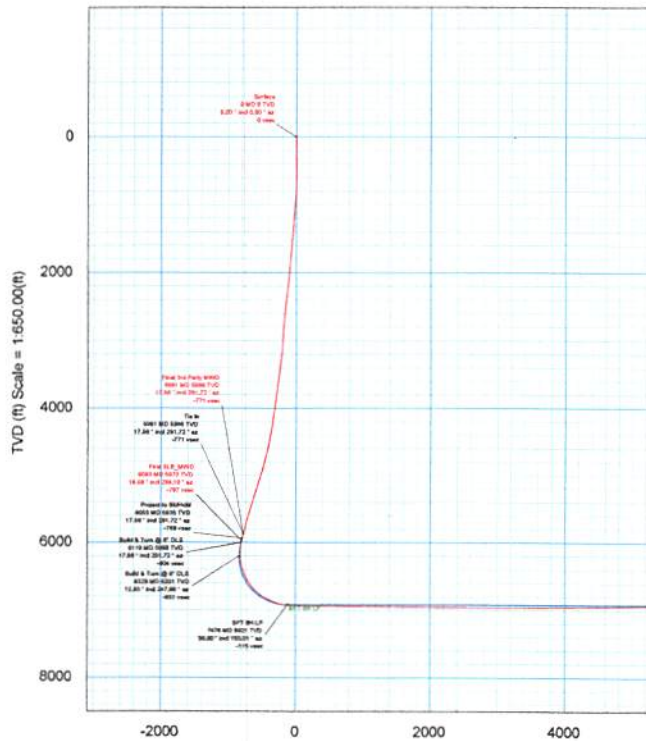

Vertical Section (ft) Azim = 150.01° Scale = 1:650.00 (ft) Origin = 0N/-S, 0E/-W

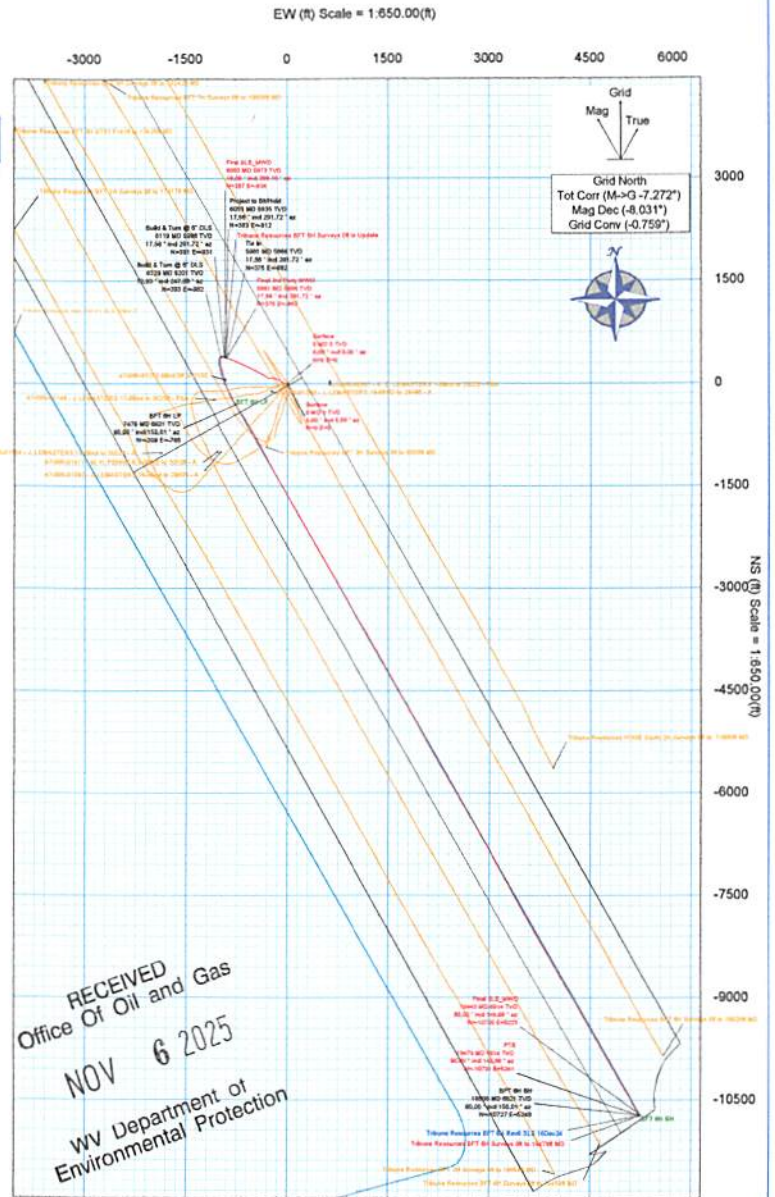

RECEIVED
Office Of Oil and Gas
NOV 6 2025
WV Department of
Environmental Protection

12/19/2025



Tribune Resources BFT 6H Surveys Off to 19479ft MD Survey Geodetic Report

Report Date: October 24, 2025 - 09:19 PM (UTC 0)
Client: Tribune Resources
Field: WV Tyler County (NAD 27)
Structure / Shot: Tribune Resources BFT Pad / BFT 6H
Well: BFT 6H
Borehole: BFT 6H
USNG / API / JobNumber: Unknown / Unknown / Unknown
Survey Name / Version: Tribune Resources BFT 6H Surveys Off to 19479ft MD / 1
Survey Date: December 06, 2024
Tort / AHD / DDI / ERD Ratio: 227.459 " / 13852.528 ft / 6.945 / 1.990
Coordinate Reference System: NAD27 West Virginia State Plane, Northern Zone, US Feet
Location Lat / Long: N 39°27'39.02280" W 80°41'23.85735"
Location Grid N/E Y/X: N 352160.030 S/E 1664026.420 S/E
CRS Grid Convergence Angle: -0.759"
Grid Scale Factor: 0.99994488(Applied)
Engine Version: 2025.1.0.1

Survey / DLS Computation: Minimum Curvature / Lubinski
Vertical Section Azimuth: 150.010 (Grid North)
Vertical Section Origin: 0.000 ft, 0.000 ft
TVD Reference Datum: RKB
TVD Reference Elevation: 907.000 ft above MSL
Seabed / Ground Elevation: 800.000 ft above MSL
Magnetic Declination: -0.031"
Total Gravity Field Strength: 999.3407mgm (9.80095 Based)
Gravity Model: GARM
Total Magnetic Field Strength: 51485.8 nT
Magnetic Dip Angle: 66.173"
Declination Date: December 06, 2024
Magnetic Declination Model: HDGM 2024
North Reference: Grid
Local Coord Referenced To: Well Head

Comments	MD	Ind	Azim	TVD	VSEC	NS	EW	TVDSS	DLS	Northing	Easting	Latitude	Longitude
Surface	(ft)	(ft)	(°)	(ft)	(ft)	(ft)	(ft)	(ft)	(ft)	(ft)	(ft)	(°N)	(°W)
	0.00	0.00	0.00	0.00	0.00	0.00	0.00	-607.00	0.00	352.180.63	1.664.026.42	N 39°27'39.00"	W 80°41'23.89"
	130.00	0.72	158.00	130.00	0.81	-0.76	0.31	-777.00	0.55	352.178.88	1.664.026.73	N 39°27'39.00"	W 80°41'23.89"
	189.00	0.90	166.02	188.99	1.62	-1.55	0.56	-718.01	0.36	352.178.06	1.664.026.99	N 39°27'39.00"	W 80°41'23.89"
	284.00	1.04	172.35	283.98	3.14	-3.13	0.85	-623.02	0.19	352.177.50	1.664.027.27	N 39°27'39.07"	W 80°41'23.89"
	373.00	0.70	216.68	372.97	4.10	-4.37	0.63	-534.03	0.82	352.176.27	1.664.027.05	N 39°27'39.06"	W 80°41'23.89"
	461.00	1.40	240.29	460.95	4.31	-5.33	-0.62	-448.05	0.92	352.175.30	1.664.025.80	N 39°27'38.99"	W 80°41'23.90"
	502.00	1.91	245.80	501.91	4.15	-4.50	-2.97	-305.09	0.59	352.174.13	1.664.023.45	N 39°27'38.94"	W 80°41'23.93"
	568.00	2.06	243.23	567.90	4.10	-4.74	-3.47	-338.10	1.09	352.173.89	1.664.022.95	N 39°27'38.94"	W 80°41'23.94"
	641.00	2.87	245.49	640.84	3.86	-4.09	-4.30	-266.16	1.12	352.172.54	1.664.020.12	N 39°27'38.92"	W 80°41'23.98"
	731.00	3.72	264.64	730.66	2.42	-4.30	-11.26	-176.31	1.53	352.171.34	1.664.015.16	N 39°27'38.91"	W 80°41'24.04"
	821.00	4.98	280.02	820.44	-1.74	-4.30	-17.86	-86.56	2.48	352.172.34	1.664.008.56	N 39°27'38.92"	W 80°41'24.12"
	910.00	5.24	295.85	909.08	-6.02	-6.27	-25.17	2.08	0.74	352.175.37	1.664.001.25	N 39°27'38.95"	W 80°41'24.22"
	1,000.00	5.17	301.53	998.71	-14.99	-1.35	-32.33	91.71	0.58	352.179.28	1.663.994.10	N 39°27'38.99"	W 80°41'24.31"
	1,089.00	4.98	303.64	1,087.36	-21.97	2.68	-38.96	180.36	0.30	352.183.52	1.663.987.46	N 39°27'39.03"	W 80°41'24.39"
	1,179.00	4.77	305.42	1,177.04	-28.87	7.22	-45.26	270.04	0.29	352.187.85	1.663.981.16	N 39°27'39.07"	W 80°41'24.48"
	1,269.00	4.70	302.13	1,266.73	-35.54	11.35	-51.43	359.73	0.31	352.191.98	1.663.974.89	N 39°27'39.11"	W 80°41'24.55"
	1,359.00	4.90	297.33	1,355.42	-41.96	15.03	-57.90	448.42	0.50	352.195.85	1.663.968.53	N 39°27'39.14"	W 80°41'24.64"
	1,448.00	5.27	296.90	1,445.07	-48.86	18.66	-65.00	538.07	0.41	352.199.30	1.663.961.42	N 39°27'39.18"	W 80°41'24.73"
	1,537.00	5.57	294.29	1,533.67	-55.59	22.29	-72.58	626.67	0.44	352.202.92	1.663.953.84	N 39°27'39.21"	W 80°41'24.83"
	1,627.00	6.24	293.30	1,623.16	-63.05	26.02	-81.05	716.19	0.75	352.206.85	1.663.945.37	N 39°27'39.25"	W 80°41'24.94"
	1,716.00	5.68	307.14	1,711.71	-70.99	30.59	-89.01	804.71	1.73	352.211.23	1.663.937.42	N 39°27'39.29"	W 80°41'25.04"
	1,805.00	5.67	306.59	1,800.28	-78.08	35.87	-96.05	893.28	0.66	352.216.51	1.663.930.38	N 39°27'39.34"	W 80°41'25.13"
	1,895.00	5.97	303.58	1,889.81	-87.35	41.11	-103.52	982.81	0.48	352.221.74	1.663.922.91	N 39°27'39.40"	W 80°41'25.22"
	1,985.00	6.42	299.51	1,979.29	-95.88	46.18	-111.80	1,072.29	0.70	352.226.81	1.663.914.83	N 39°27'39.44"	W 80°41'25.33"
	2,074.00	7.16	296.23	2,067.86	-104.93	51.34	-120.87	1,160.66	0.83	352.231.97	1.663.906.46	N 39°27'39.49"	W 80°41'25.45"
	2,164.00	7.84	296.56	2,156.89	-114.99	57.01	-131.25	1,249.89	0.76	352.237.64	1.663.896.17	N 39°27'39.55"	W 80°41'25.58"
	2,254.00	8.32	295.27	2,246.00	-125.57	62.73	-142.53	1,339.00	0.74	352.243.36	1.663.883.89	N 39°27'39.60"	W 80°41'25.73"
	2,343.00	8.36	291.47	2,334.06	-135.93	67.85	-154.38	1,427.06	0.82	352.248.47	1.663.872.95	N 39°27'39.65"	W 80°41'25.85"
	2,433.00	8.85	287.10	2,423.05	-146.12	72.28	-167.08	1,516.05	0.91	352.252.90	1.663.858.35	N 39°27'39.70"	W 80°41'26.04"
	2,523.00	8.90	283.00	2,511.97	-155.93	75.88	-180.48	1,604.97	0.70	352.256.51	1.663.845.85	N 39°27'39.73"	W 80°41'26.21"
	2,612.00	9.00	278.90	2,599.89	-165.00	78.50	-194.07	1,692.89	0.73	352.259.13	1.663.832.36	N 39°27'39.75"	W 80°41'26.38"
	2,702.00	8.77	274.74	2,688.81	-173.33	80.16	-207.86	1,781.81	0.76	352.260.79	1.663.818.57	N 39°27'39.77"	W 80°41'26.56"
	2,791.00	8.49	272.30	2,776.80	-180.70	80.88	-221.19	1,869.80	0.52	352.261.61	1.663.805.24	N 39°27'39.77"	W 80°41'26.73"
	2,881.00	8.73	267.99	2,865.79	-187.48	81.01	-234.65	1,958.79	0.76	352.261.64	1.663.791.78	N 39°27'39.77"	W 80°41'26.90"
	2,972.00	8.36	264.58	2,911.28	-190.48	80.57	-241.47	2,044.77	1.36	352.261.23	1.663.778.46	N 39°27'39.77"	W 80°41'27.09"
	3,022.00	7.77	260.75	3,005.34	-195.63	78.89	-254.68	2,098.34	0.84	352.259.52	1.663.771.75	N 39°27'39.75"	W 80°41'27.16"
	3,112.00	8.05	270.93	3,094.48	-201.02	78.01	-268.99	2,187.48	1.59	352.258.64	1.663.759.44	N 39°27'39.74"	W 80°41'27.31"
	3,201.00	9.03	287.72	3,182.51	-208.39	80.24	-279.88	2,275.51	3.00	352.260.87	1.663.746.56	N 39°27'39.78"	W 80°41'27.48"
	3,291.00	9.18	302.93	3,271.39	-221.01	86.29	-292.63	2,364.39	2.87	352.268.92	1.663.733.80	N 39°27'39.82"	W 80°41'27.64"
	3,381.00	8.43	302.64	3,360.33	-233.26	93.75	-304.21	2,453.33	0.83	352.274.38	1.663.722.22	N 39°27'39.85"	W 80°41'27.81"
	3,470.00	7.09	298.49	3,448.51	-243.74	99.89	-314.53	2,541.51	1.63	352.280.52	1.663.711.80	N 39°27'39.89"	W 80°41'27.92"
	3,560.00	8.12	304.68	3,537.72	-254.22	108.16	-324.84	2,630.72	1.46	352.286.79	1.663.701.79	N 39°27'40.01"	W 80°41'28.05"
	3,650.00	8.48	305.24	3,626.78	-265.98	113.60	-335.29	2,719.78	0.41	352.294.23	1.663.691.15	N 39°27'40.08"	W 80°41'28.19"
	3,739.00	7.75	302.06	3,714.89	-277.25	120.58	-345.74	2,807.89	0.96	352.301.20	1.663.680.70	N 39°27'40.15"	W 80°41'28.35"
	3,829.00	8.59	299.66	3,803.97	-288.45	127.15	-356.76	2,896.97	1.07	352.307.77	1.663.669.68	N 39°27'40.21"	W 80°41'28.47"
	3,919.00	8.95	298.16	3,892.96	-300.00	133.67	-368.57	2,985.95	0.26	352.314.29	1.663.657.87	N 39°27'40.28"	W 80°41'28.62"
	4,008.00	9.47	296.30	3,980.85	-311.94	140.39	-380.81	3,073.85	1.01	352.321.01	1.663.645.63	N 39°27'40.34"	W 80°41'28.78"
	4,098.00	9.15	297.94	4,069.65	-324.37	147.36	-393.59	3,162.66	0.43	352.327.99	1.663.632.85	N 39°27'40.41"	W 80°41'28.94"
	4,187.00	9.42	297.76	4,157.49	-336.53	154.07	-406.29	3,250.49	0.31	352.334.70	1.663.620.16	N 39°27'40.47"	W 80°41'29.10"
	4,277.00	10.55	300.41	4,246.13	-348.92	161.67	-419.91	3,339.13	1.36	352.342.30	1.663.608.53	N 39°27'40.59"	W 80°41'29.25"
	4,367.00	11.20	299.58	4,334.51	-364.62	170.16	-434.62	3,427.51	0.74	352.350.78	1.663.591.83	N 39°27'40.63"	W 80°41'29.47"
	4,456.00	11.94	298.93	4,421.70	-379.79	178.60	-450.34	3,514.70	1.02	352.359.22	1.663.578.10	N 39°27'40.71"	W 80°41'29.61"
	4,546.00	12.56	297.48	4,509.65	-395.84	187.33	-467.33	3,602.65	0.70	352.367.95	1.663.559.12	N 39°27'40.79"	W 80°41'29.85"
	4,636.00	14.25	297.23	4,596.23	-413.21	196.81	-485.85	3,690.23	1.80	352.377.43	1.663.540.80	N 39°27'40.88"	W 80°41'30.12"
	4,725.00	15.69	297.29	4,683.17	-432.76	207.45	-506.32	3,778.17	1.60	352.388.08	1.663.520.13	N 39°27'40.99"	W 80°41'30.39"
	4,815.00	17.09	295.74	4,769.51	-453.93	218.78	-529.05	3,862.51	1.63	352.399.40	1.663.497.40	N 39°27'41.10"	W 80°41'30.68"
	4,904.00	18.39	293.57	4,854.28	-476.03	230.07	-553.70	3,947.28	1.64	352.410.69	1.663.472.78	N 39°27'41.20"	W 80°41'31.00"
	4,994.00	19.32	292.58	4,839.45	-499.28	241.48	-580.45	4,032.45	1.09	352.422.08	1.663.446.00	N 39°27'41.31"	W 80°41'31.34"
	5,084.00	20.82	293.13	5,024.22	-523.36	252.20	-608.30	4,117.22	0.70	352.433.82	1.663.418.15	N 39°27'41.43"	W 80°41'31.70"
	5,174.00	20.70	294.05	5,108.63	-548.60	263.86	-636.06	4,201.63	1.05	352.446.48	1.663.389.80	N 39°27'41.55"	W 80°41'32.06"
	5,263.00	21.46	295.02	5,191.67	-574.78	276.31	-665.91	4,284.67	0.87	352.459.92	1.663.360.55	N 39°27'41.68"	W 80°41'32.41"
	5,353.00	21.34	294.64	5,275.47	-601.61	283.10	-695.71	4,368.47	0.20	352.473.71	1.666		


Survey Type: Definitive Survey

Survey Error Model: ISOWSA Rev 4 *** 3-D 95 % Confidence 2.7935 sigma

Survey Program:

Description	Part	MD From (ft)	MD To (ft)	CDU Pres (ft)	Expected Max Inclination (deg)	Survey Tool Code	Vendor / Tool	Borehole / Survey
	1	0.000	5,001.000 Act Str			A001MB_MWYD		BFT OH / Tribune Resources BFT OH Surveys 02 to 19470R MD
	1	5,001.000	19,479.000 Act Str			A000MB_MWYD-WR1+US		BFT OH / Tribune Resources BFT OH Surveys 02 to 19470R MD

CDU Geometry:

End MD (ft)	Hole Size (in)	Casing Size (in)	Name
650.000	17.500	13.375	
3,000.000	12.250	9.625	
5,001.000	8.750	5.500	
19,479.000	8.500	5.500	

RECEIVED
Office Of Oil and Gas
NOV 6 2025
WV Department of
Environmental Protection