



Tribune Resources



Borehole:	Well:	Field:	Structure:
BFT 7H	BFT 7H	WV Tyler County (NAD 27)	Precision 578

Gravity & Magnetic Parameters	Surface Location	Miscellaneous
Model: HDGM 2024 Dip: 66.162° Date: 21-Jan-2025	NAD27 West Virginia State Plane, Northern Zone, US Feet	Slot: BFT 7H
MagDec: -8.033° PS: 01468.916mT Gravity PS: 989.35mgn (8.0665 Based)	Lat: N 39 27 38.84 Northing: 952163.55RU9 Grid Conv: -0.7599°	TVD Ref: RCB (907.000 R above MSL)
	Lon: W 80 41 23.66 Easting: 1664044.7RU9 Scale Fact: 0.99994408	Plan: Tribune Resources BFT 7H Rev6 SLS 21Jan25

Comments	Survey MWD (ft)	Horizontal (ft)	Vertical (ft)	NS (ft)	EW (ft)	Sub Sea (ft)	Sub Sea (ft)
Surface	0.00	0.00	0.00	0.00	0.00	0.00	-907.00
Final 3rd Party MWD	5,955.00	7.34	163.75	5,916.31	-583.89	-564.70	189.66
Final SLB MWD	6,004.00	5.26	164.26	5,965.01	-589.11	-569.67	191.14
Landing Point	7,438.00	89.25	327.91	6,934.50	-203.42	-187.00	6,027.50
Final SLB MWD	18,777.00	89.99	341.67	6,791.80	-11,542.90	-10,084.65	-5,618.61
PTB	18,809.00	89.99	341.67	6,791.80	-11,542.90	-10,084.65	-5,618.61

CONTROLLED

Drawn by: J. E. Eames

Checked by: J. E. Eames

Date: 21-Jan-2025

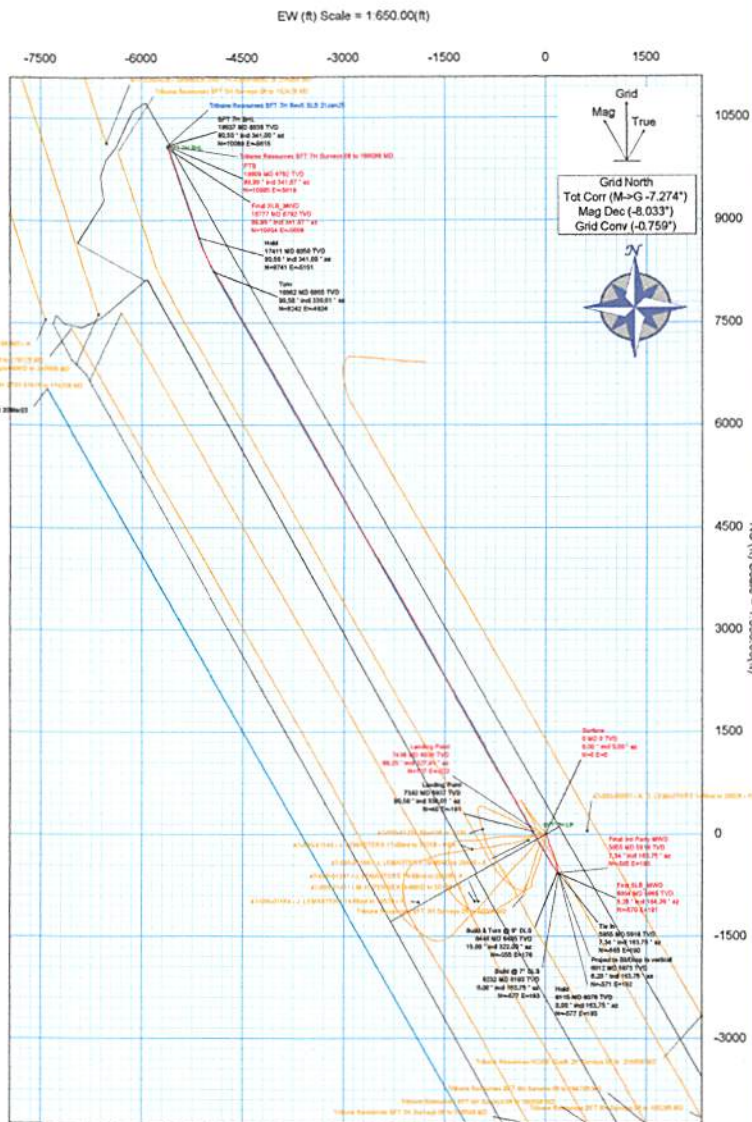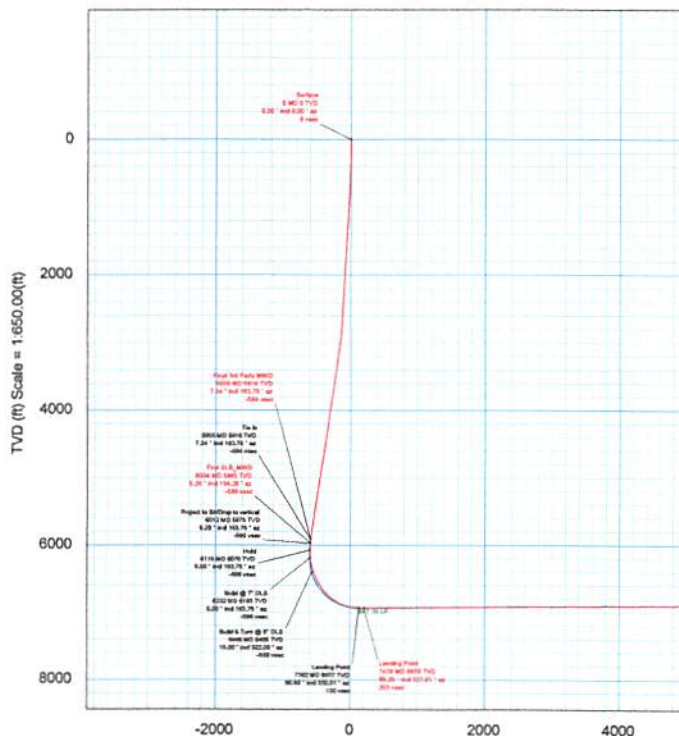

12/19/2025



Tribune Resources BFT 7H Surveys Off to 18809ft MD Survey Geodetic Report

Report Date: January 28, 2025 - 09:50 PM (UTC 0)
Client: Tribune Resources
Field: WV Tyler County (NAD 27)
Structure / Skid: Tribune Resources BFT Pad / BFT 7H
Well: BFT 7H
Borehole: Unknown / Unknown / Unknown
Survey Name / Version: Tribune Resources BFT 7H Surveys Off to 18809ft MD / 1
Survey Date: December 03, 2024
Tort / AHD / DDI / ERD Ratio: 267.535' / 12778.476' R / 6.967' / 1.842
Coordinate Reference System: NAD27 West Virginia State Plane, Northern Zone, US Feet
Location Lat / Long: N 39°27'38.8363" W 80°41'23.6613"
Location Grid N/E Y/X: N 39°27'38.8363" E 1664044.703 RUS
CRS Grid Convergence Angle: -0.759°
Grid Scale Factor: 0.99994489(Applied)
Engine Version: 2024.4.0.4

Survey / DLS Computation: Minimum Curvature / Lubinski
Vertical Section Azimuth: 330.010° (Grid North)
Vertical Section Origin: 0.000 ft, 0.000 ft
TVD Reference Datum: RXB
TVD Reference Elevation: 907.000 ft above MSL
Seated / Ground Elevation: 880.000 ft above MSL
Magnetic Declination: -8.053°
Total Gravity Field Strength: 999.3407mgm (9.80665 Based)
Gravity Model: GARM
Total Magnetic Field Strength: 51468.916 nT
Magnetic Dip Angle: 66.152°
Declination Date: January 21, 2025
Magnetic Declination Model: HDGM 2024
North Reference: Local North
Local North Offset: -7.274°
Local Coord Referenced To: Well Head

Comments	MD	Incl	TVD		VSEIC	NS	EW	TVDSS	DLS	Northing	Easting	Latitude	Longitude
Surface	(ft)	(°)	(ft)	(ft)	(ft)	(ft)	(ft)	(ft)	(ft/100ft)	(ft)	(ft)	(N ° ' ")	(E ° ' ")
	0.00	0.00	0.00	0.00	0.00	0.00	0.00	-607.00		352.163.55	1.664.044.70	N 39°27'38.84"	W 80°41'23.66"
	186.00	0.13	136.56	186.00	-0.21	-0.16	0.14	-718.00	0.07	352.163.39	1.664.044.84	N 39°27'38.87"	W 80°41'23.68"
	283.00	0.88	157.27	283.00	-1.03	-0.91	0.49	-624.00	0.81	352.162.64	1.664.045.19	N 39°27'38.83"	W 80°41'23.65"
	373.00	1.86	158.92	372.97	-3.18	-2.93	1.29	-534.03	1.12	352.160.62	1.664.045.99	N 39°27'38.81"	W 80°41'23.64"
	460.00	1.77	150.69	459.92	-5.94	-5.44	2.46	-447.08	0.33	352.158.11	1.664.047.16	N 39°27'38.78"	W 80°41'23.67"
	551.00	1.82	145.15	550.88	-8.79	-7.85	3.98	-358.12	0.20	352.155.70	1.664.048.68	N 39°27'38.76"	W 80°41'23.61"
	641.00	1.78	143.40	640.83	-11.00	-10.15	5.63	-268.17	0.08	352.153.40	1.664.050.33	N 39°27'38.74"	W 80°41'23.58"
	731.00	2.49	146.90	730.77	-14.94	-12.91	7.53	-178.23	0.80	352.150.64	1.664.052.23	N 39°27'38.71"	W 80°41'23.56"
	820.00	3.67	153.02	819.84	-18.72	-17.07	9.87	-87.36	1.37	352.146.48	1.664.054.58	N 39°27'38.67"	W 80°41'23.53"
	910.00	3.30	161.75	909.48	-25.13	-22.09	11.99	2.48	0.72	352.141.46	1.664.056.70	N 39°27'38.62"	W 80°41'23.50"
	999.00	3.17	157.71	998.33	-30.08	-26.80	13.73	91.33	0.29	352.136.75	1.664.058.43	N 39°27'38.57"	W 80°41'23.46"
	1089.00	2.46	153.13	1088.23	-34.47	-30.83	15.55	181.23	0.83	352.132.72	1.664.060.25	N 39°27'38.53"	W 80°41'23.43"
	1178.00	2.67	141.93	1177.14	-38.43	-34.17	17.69	270.14	0.61	352.129.39	1.664.062.39	N 39°27'38.50"	W 80°41'23.47"
	1268.00	3.52	146.46	1267.00	-43.26	-38.12	20.51	360.00	0.98	352.125.43	1.664.065.21	N 39°27'38.46"	W 80°41'23.39"
	1357.00	3.16	145.46	1355.85	-48.44	-42.42	23.41	448.85	0.41	352.121.14	1.664.068.11	N 39°27'38.42"	W 80°41'23.36"
	1447.00	3.32	138.78	1445.71	-53.47	-46.42	26.53	538.71	0.46	352.117.13	1.664.071.23	N 39°27'38.38"	W 80°41'23.32"
	1537.00	3.21	130.65	1535.56	-58.40	-50.02	30.16	628.56	0.53	352.113.53	1.664.074.86	N 39°27'38.35"	W 80°41'23.27"
	1626.00	3.14	140.40	1624.43	-63.15	-53.52	33.60	717.43	0.61	352.110.03	1.664.078.31	N 39°27'38.31"	W 80°41'23.22"
	1715.00	3.80	148.51	1713.27	-68.51	-57.92	36.70	806.27	0.92	352.105.64	1.664.081.40	N 39°27'38.27"	W 80°41'23.18"
	1805.00	3.85	160.10	1803.07	-74.40	-63.30	39.29	896.07	0.86	352.100.25	1.664.083.99	N 39°27'38.22"	W 80°41'23.15"
	1894.00	3.97	175.85	1891.86	-80.18	-69.18	40.53	984.88	1.21	352.094.37	1.664.086.23	N 39°27'38.18"	W 80°41'23.11"
	1984.00	3.49	174.45	1981.67	-85.47	-75.02	41.02	1074.87	0.54	352.088.54	1.664.088.72	N 39°27'38.14"	W 80°41'23.11"
	2074.00	3.87	176.10	2071.48	-90.65	-80.78	41.36	1164.48	0.50	352.082.78	1.664.088.08	N 39°27'38.10"	W 80°41'23.12"
	2163.00	3.76	175.87	2160.29	-95.92	-86.69	41.69	1253.29	0.21	352.076.86	1.664.086.39	N 39°27'38.06"	W 80°41'23.12"
	2253.00	4.01	174.91	2250.08	-101.43	-92.77	42.18	1343.08	0.29	352.070.79	1.664.086.88	N 39°27'38.03"	W 80°41'23.11"
	2343.00	3.61	173.05	2339.88	-106.89	-96.72	42.81	1432.88	0.47	352.064.84	1.664.087.51	N 39°27'38.01"	W 80°41'23.10"
	2432.00	3.48	173.28	2428.71	-111.95	-104.18	43.46	1521.71	0.15	352.059.38	1.664.088.16	N 39°27'37.97"	W 80°41'23.09"
	2522.00	3.18	175.26	2518.56	-116.72	-109.38	43.99	1611.56	0.39	352.054.18	1.664.088.69	N 39°27'37.93"	W 80°41'23.08"
	2611.00	3.13	173.24	2607.42	-121.19	-114.25	44.48	1700.42	0.14	352.049.30	1.664.089.18	N 39°27'37.89"	W 80°41'23.07"
	2701.00	2.44	170.08	2697.32	-125.24	-118.58	45.10	1790.32	0.79	352.044.98	1.664.089.80	N 39°27'37.87"	W 80°41'23.07"
	2791.00	4.11	168.52	2787.17	-130.10	-123.63	46.07	1880.17	1.86	352.039.93	1.664.090.77	N 39°27'37.82"	W 80°41'23.05"
	2881.00	6.25	165.60	2876.79	-137.88	-131.53	47.93	1969.79	2.39	352.032.02	1.664.092.63	N 39°27'37.78"	W 80°41'23.03"
	2970.00	6.85	161.80	2965.54	-142.20	-136.80	48.18	2058.54	1.90	352.027.76	1.664.093.68	N 39°27'37.75"	W 80°41'23.01"
	3060.00	7.29	160.58	3054.95	-147.50	-141.77	50.24	2148.85	0.80	352.021.79	1.664.094.94	N 39°27'37.71"	W 80°41'22.97"
	3150.00	8.39	155.12	3140.12	-152.80	-146.99	50.85	2239.12	1.49	352.007.57	1.664.101.55	N 39°27'37.67"	W 80°41'22.93"
	3240.00	8.68	152.80	3129.10	-157.00	-151.12	51.79	2329.10	0.67	351.995.44	1.664.107.49	N 39°27'37.63"	W 80°41'22.87"
	3330.00	7.32	143.68	3218.21	-161.83	-155.92	52.24	2418.85	2.24	351.984.64	1.664.114.08	N 39°27'37.59"	W 80°41'22.79"
	3420.00	7.91	148.43	3306.42	-166.76	-160.78	52.84	2508.48	1.08	351.974.80	1.664.120.54	N 39°27'37.55"	W 80°41'22.66"
	3510.00	8.66	157.55	3394.48	-171.30	-165.65	53.58	2598.48	1.54	351.963.21	1.664.126.27	N 39°27'37.51"	W 80°41'22.53"


Description	Part	MD From (ft)	MD To (ft)	EDU Prog (ft)	Expected Max Inclination (deg)	Survey Tool Code	Vendor / Tool	Donohoe / Survey
	1	0.000	5,000.000 Act Strs			A001MR_JAWD		SFT 7H / Tribune Resources SFT 7H Surveys 01 to 100000 MD
	1	5,000.000	16,800.000 Act Strs			B000MR_JAWD+IGRF		SFT 7H / Tribune Resources SFT 7H Surveys 02 to 100000 MD

EDU Geometry:

End MD (ft)	Hole Size (in)	Casing Size (in)	Name
050.000	17.500	13.375	
3,000.000	12.250	9.625	
5,012.000	8.750	6.500	
16,800.000	8.500	6.500	

RECEIVED
Office Of Oil and Gas
NOV 6 2025
WV Department of
Environmental Protection