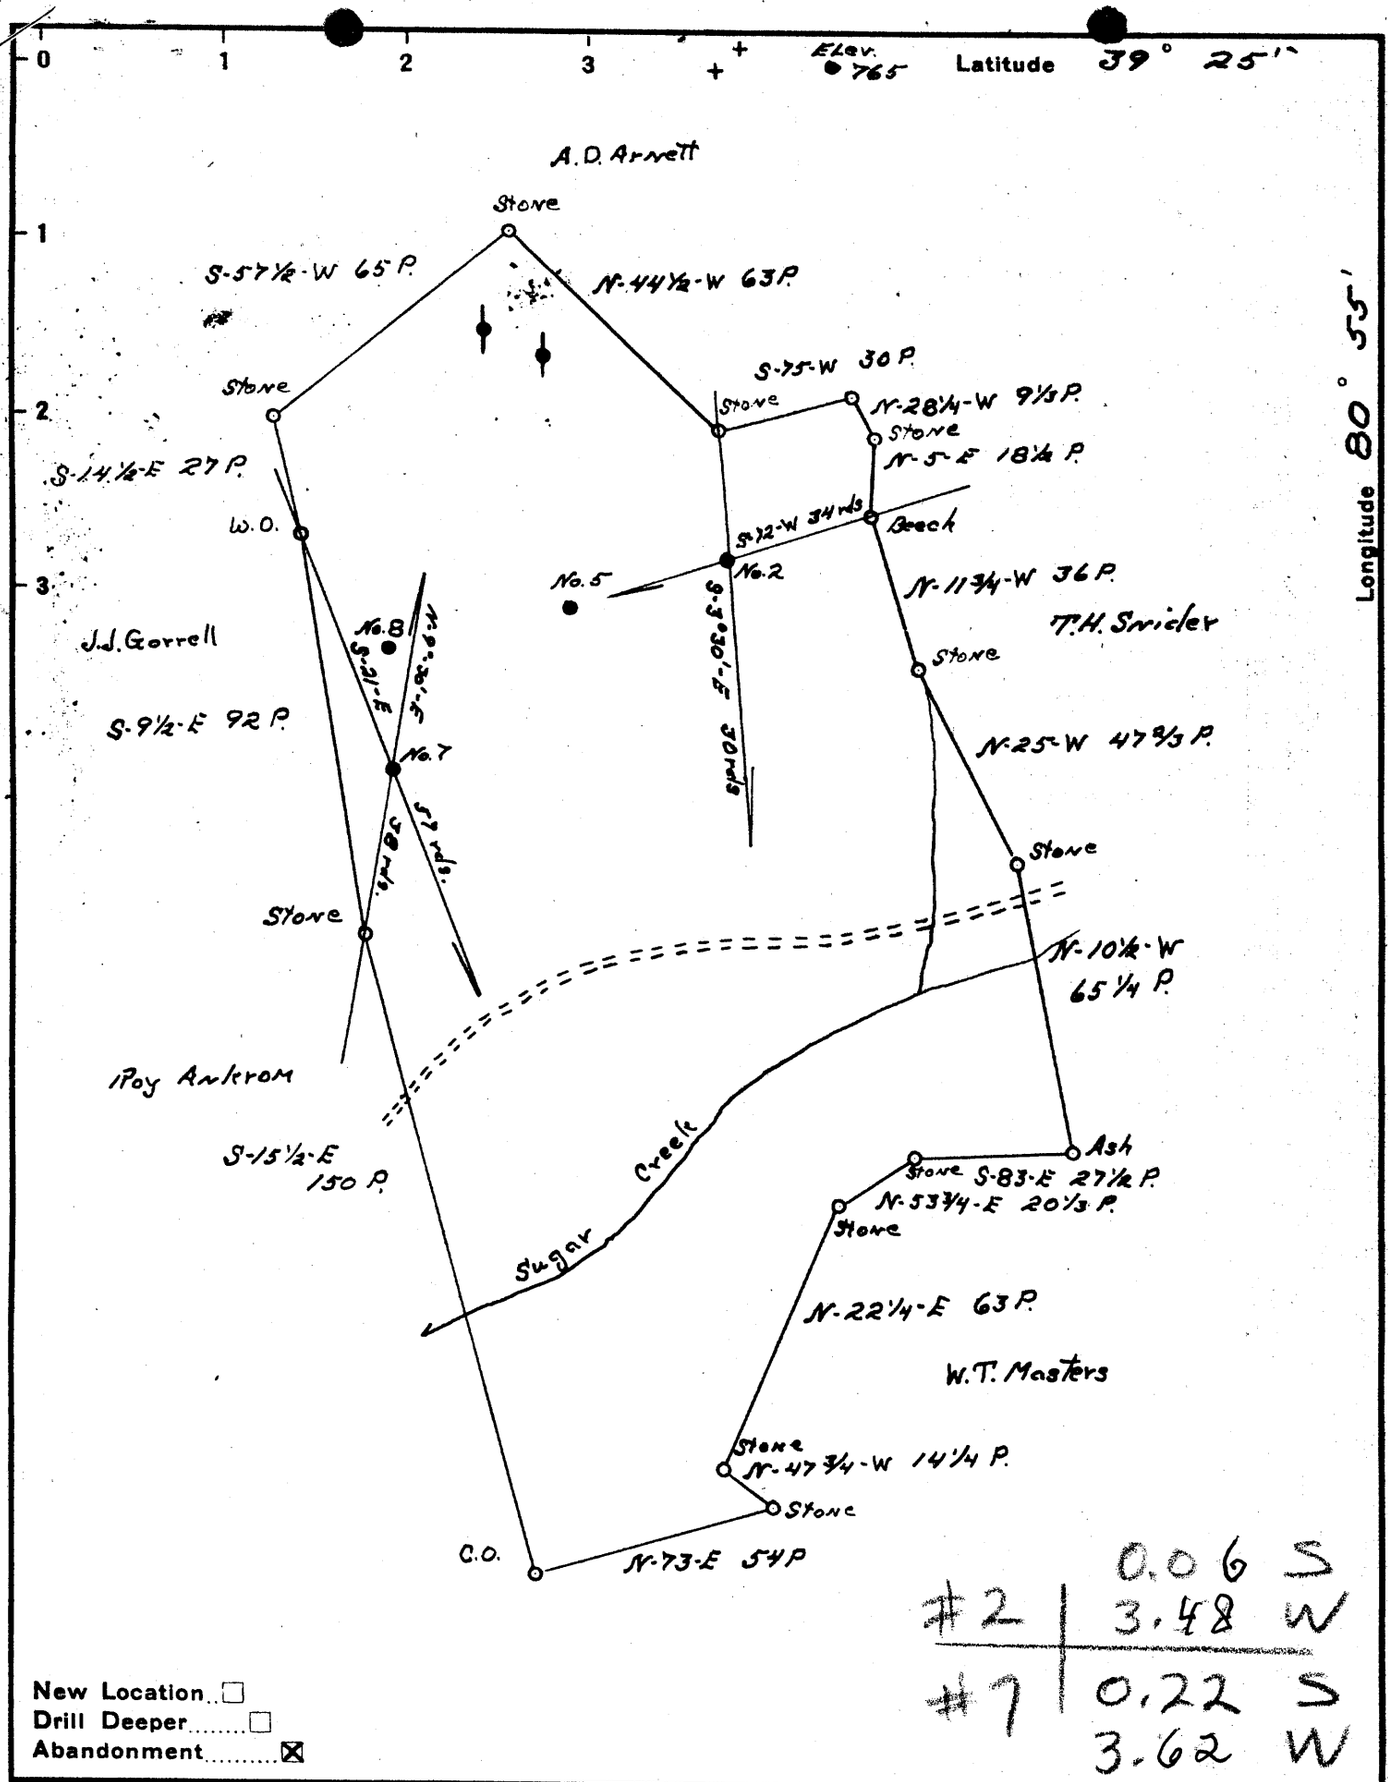

New Location ☐
Drill Deeper ☐
Abandonment ☒

Company American Oil Development Company
Address Sistersville West Virginia
Farm John Bullman
Tract ____ Acres 200 Lease No. ____ WC
Well (Farm) No. 2 + 7 Serial No. ____
Elevation (Spirit Level) 2-984.47 7-909.56
Quadrangle West Union
County Tyler District Meade
Engineer J. S. Fitzgerald
Engineer's Registration No. County Surveyor Tyler-Co
File No. ____ Drawing No. ____
Date 4-22-41 Scale 40 rds = 1 inch

PRINTED ON "IMPERIAL" TRACING CLOTH K & E CO., N. Y.

STATE OF WEST VIRGINIA
DEPARTMENT OF MINES
OIL AND GAS DIVISION
CHARLESTON

WELL LOCATION MAP

FILE NO. JyL-283-A-#2
JyL-284-A-#7 ←

+ Denotes location of well on United States Topographic Maps, scale 1 to 62,500, latitude and longitude lines being represented by border lines as shown.

— Denotes one inch spaces on border line of original tracing.