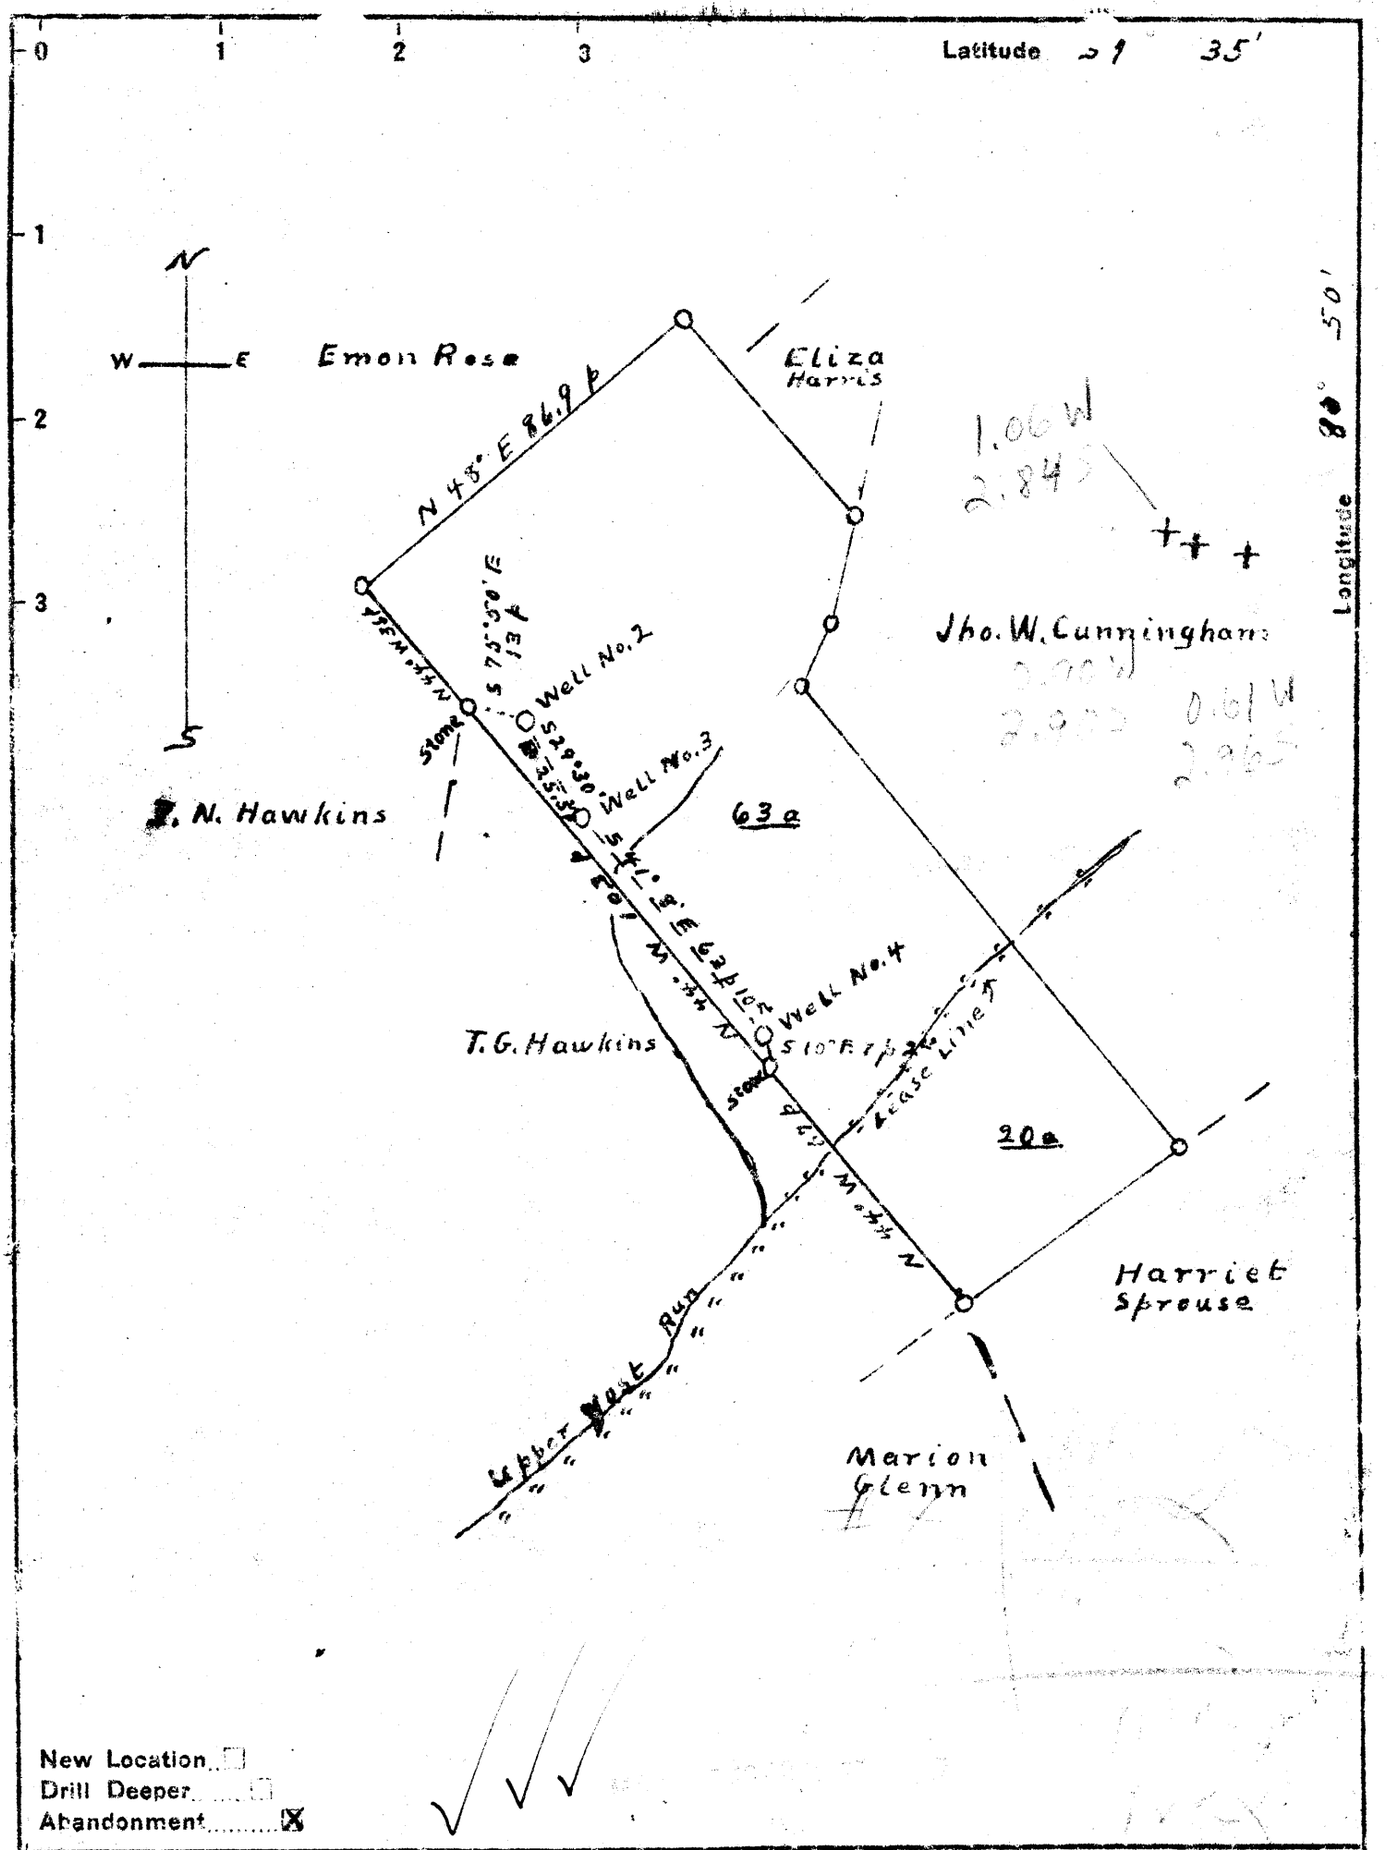

New Location ☐
Drill Deeper ☐
Abandonment ☒

Company J. R. Bull
Address Sistersville, W. Va.
Farm M. A. Gorrell
Tract 1 Acres 63 Lease No. 81328
Well (Farm) No. 2, 3 & 4 Serial No.
Elevation (Spirit Level) 2-1138', 3-1013', 4-1010'
Quadrangle New Martinsville
County Tyler District Ellsworth
Engineer Don L. Riggle
Engineer's Registration No.
File No. O & G-S.P. 11 Drawing No. 1377
Date Apr. 12, 1948 Scale 1" = 40 P

STATE OF WEST VIRGINIA
DEPARTMENT OF MINES
OIL AND GAS DIVISION
CHARLESTON

WELL LOCATION MAP

FILE NO. JYL-491-A-#4
JYL-493-A-#2
JYL-494-A-#3

+ Denotes location of well on United States Topographic Maps, scale 1 to 62,500, latitude and longitude lines being represented by border lines as shown.

— Denotes one inch spaces on border line of original tracing.

M. A. Gorrell No. 2, 3 & 4 — J. R. Bull — JYL-491-493-494-A