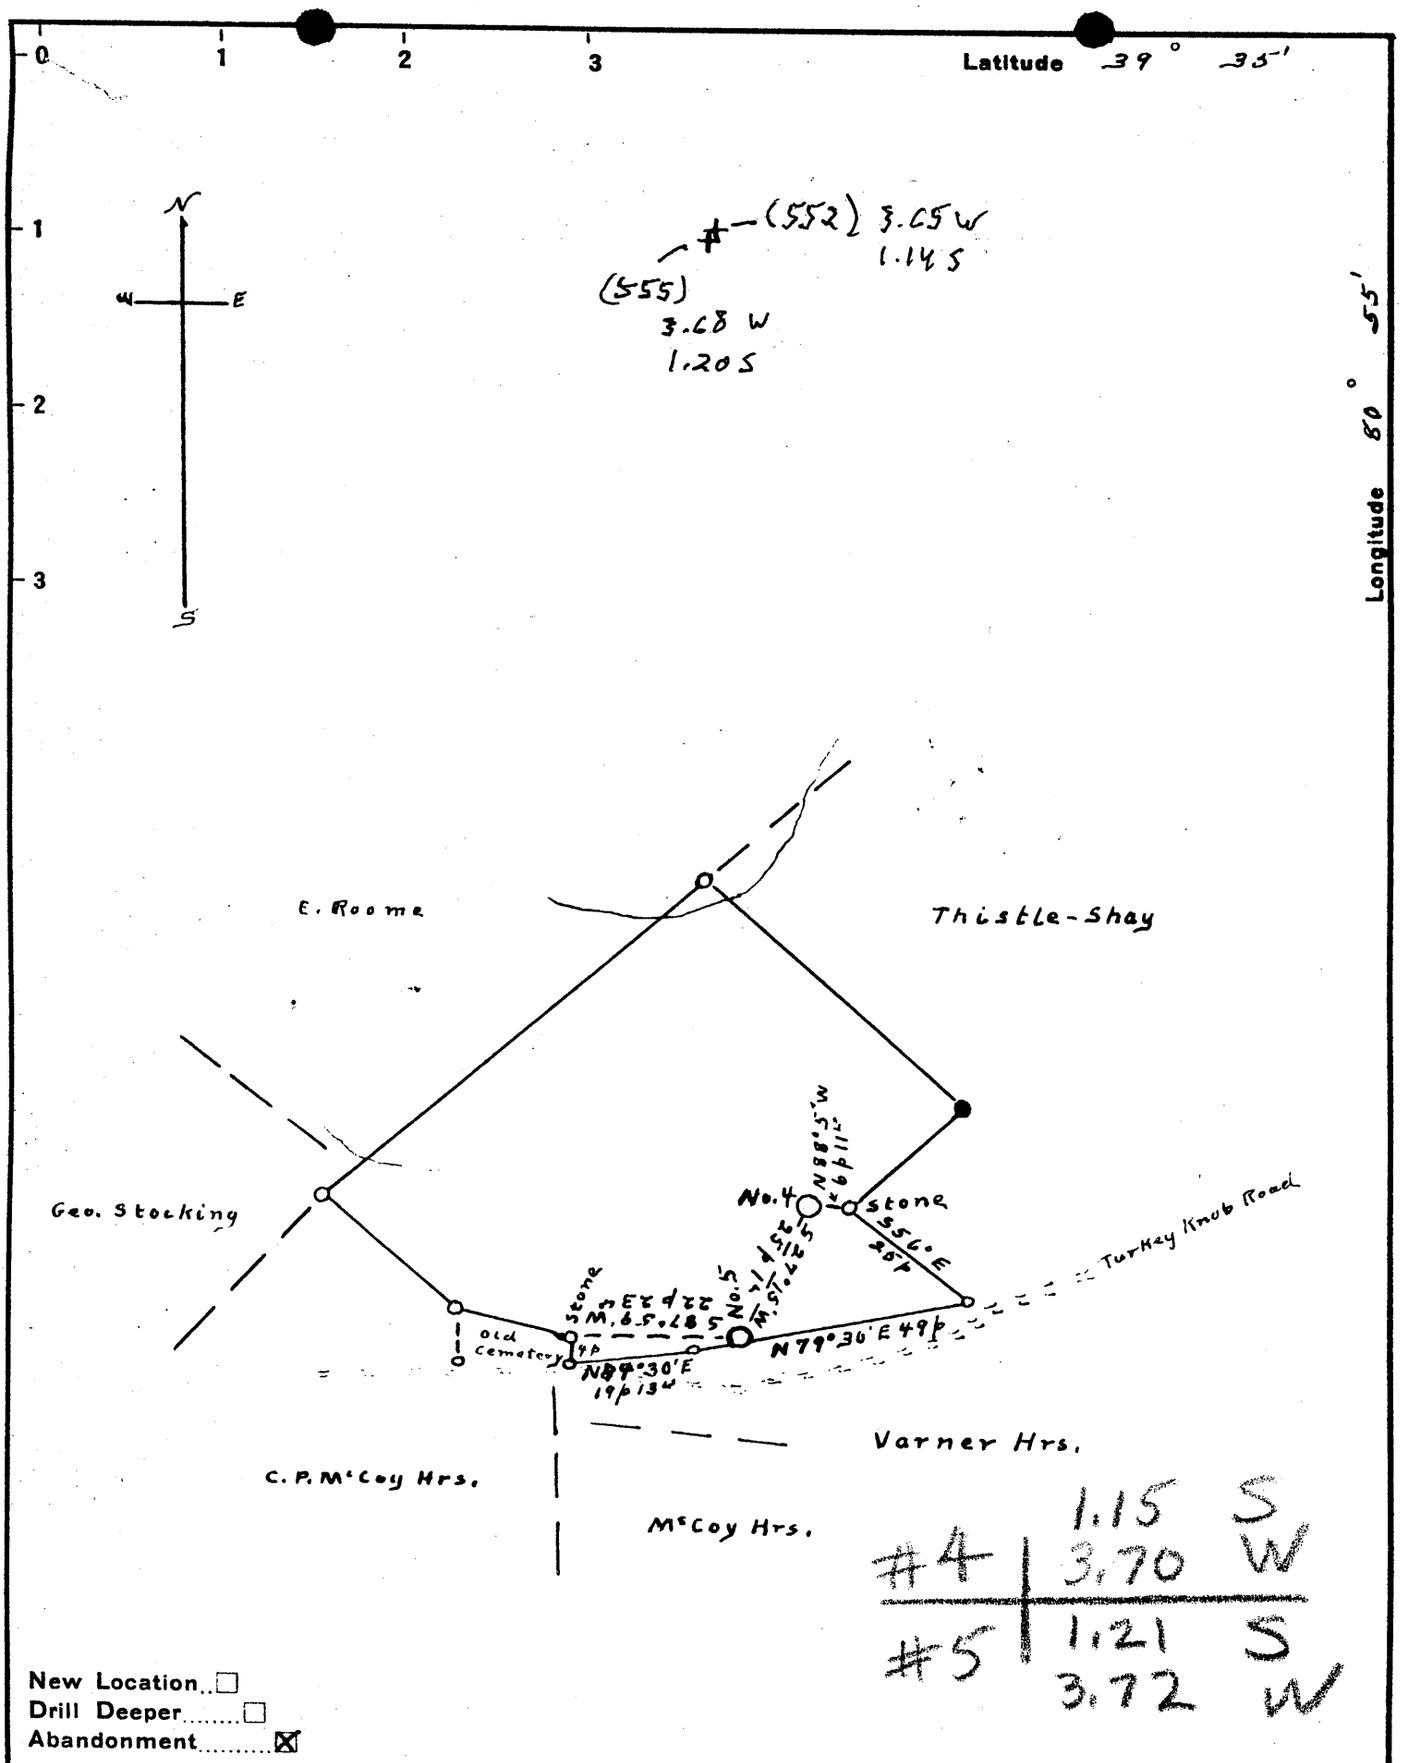

New Location ☐
Drill Deeper ☐
Abandonment ☒

Company J. R. Bull
Address Sistersville, W. Va.
Farm Geo. Graham
Tract 1 Acres 31 Lease No. 6069
Well (Farm) No. 4 + 5 Serial No.
Elevation (Spirit Level) No. 4 - 947' No. 5 - 988'
Quadrangle New Martinsville
County Tyler District Lincoln
Engineer Don L. Riggle
Approved by George R. Clark
Engineer's Registration No. 102
File No. 046-SP. 11 Drawing No. 1397
Date May 19, 48 Scale 1" = 30 p

"IMPERIAL" TRACING CLOTH
K & E CO., N. Y.

STATE OF WEST VIRGINIA
DEPARTMENT OF MINES
OIL AND GAS DIVISION
CHARLESTON

WELL LOCATION MAP

FILE NO. JYL-552-A-#4
JYL-555-A-#5

+ Denotes location of well on United States Topographic Maps, scale 1 to 62,500, latitude and longitude lines being represented by border lines as shown.

— Denotes one inch spaces on border line of original tracing.