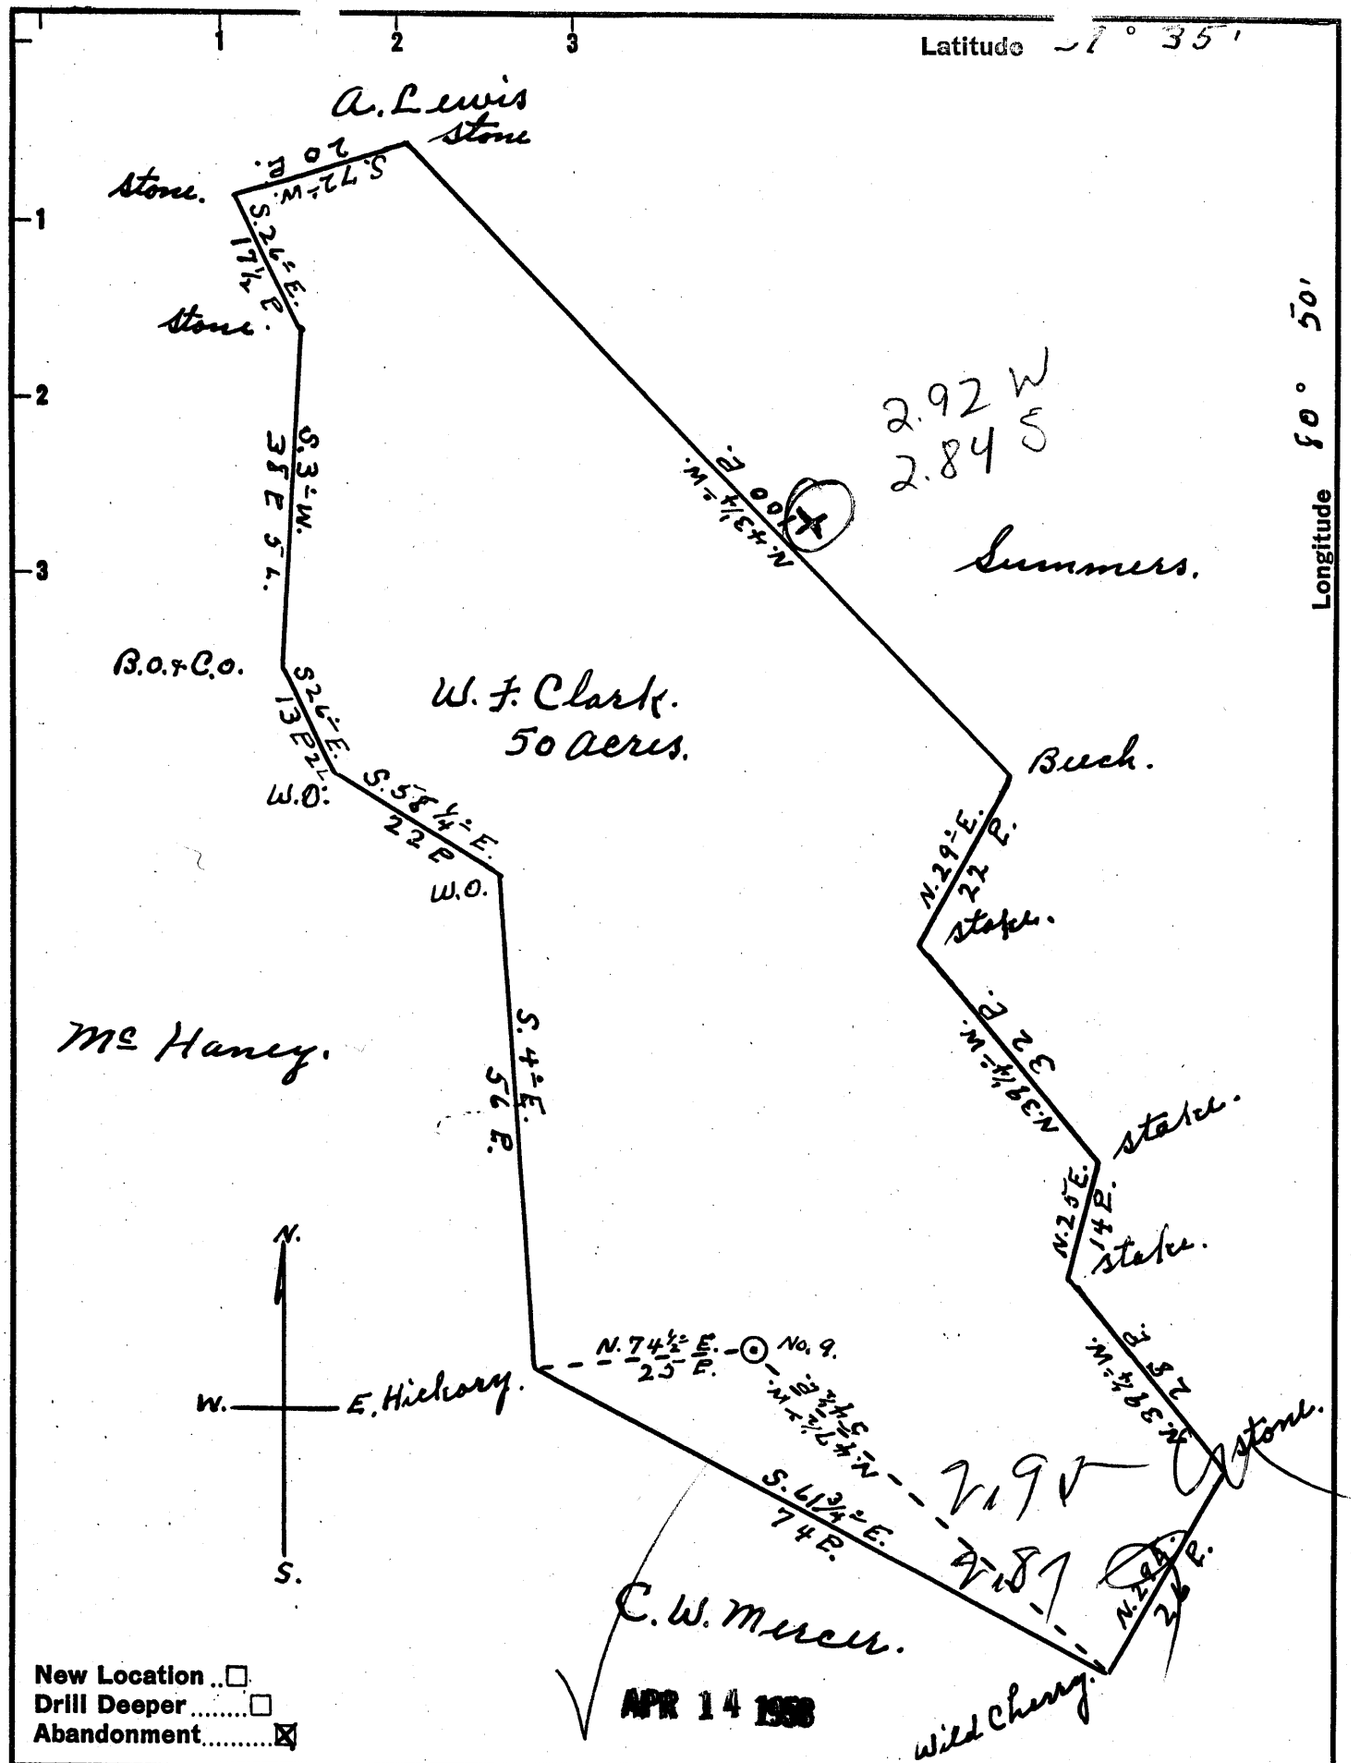

New Location ..☐
Drill Deeper .....☐
Abandonment.....☒

Company Daniel Henthorn
Address R. 2, Listersville, W.Va.
Farm W. F. Clark
Tract _____ Acres 50 Lease No. _____
Well (Farm) No. 9 Serial No. _____
Elevation (Spirit Level) 806' (60)
Quadrangle New Martinsville
County Tyler District Ellsworth
Engineer Parker E. Peters
By Jno Triplett, Surveyor.
Engineer's Registration No. 485
File No. _____ Drawing No. _____
Date Mar. 25 1958 Scale 1" = 20 P.

62390

STATE OF WEST VIRGINIA
DEPARTMENT OF MINES
OIL AND GAS DIVISION
CHARLESTON

WELL LOCATION MAP

FILE NO. JYL-889-A

+ Denotes location of well on United States Topographic Maps, scale 1 to 62,500, latitude and longitude lines being represented by border lines as shown.

— Denotes one inch spaces on border line of original tracing.

W.F. CLARK No. 9 — DANIEL HENTHORN — JYL-889-A