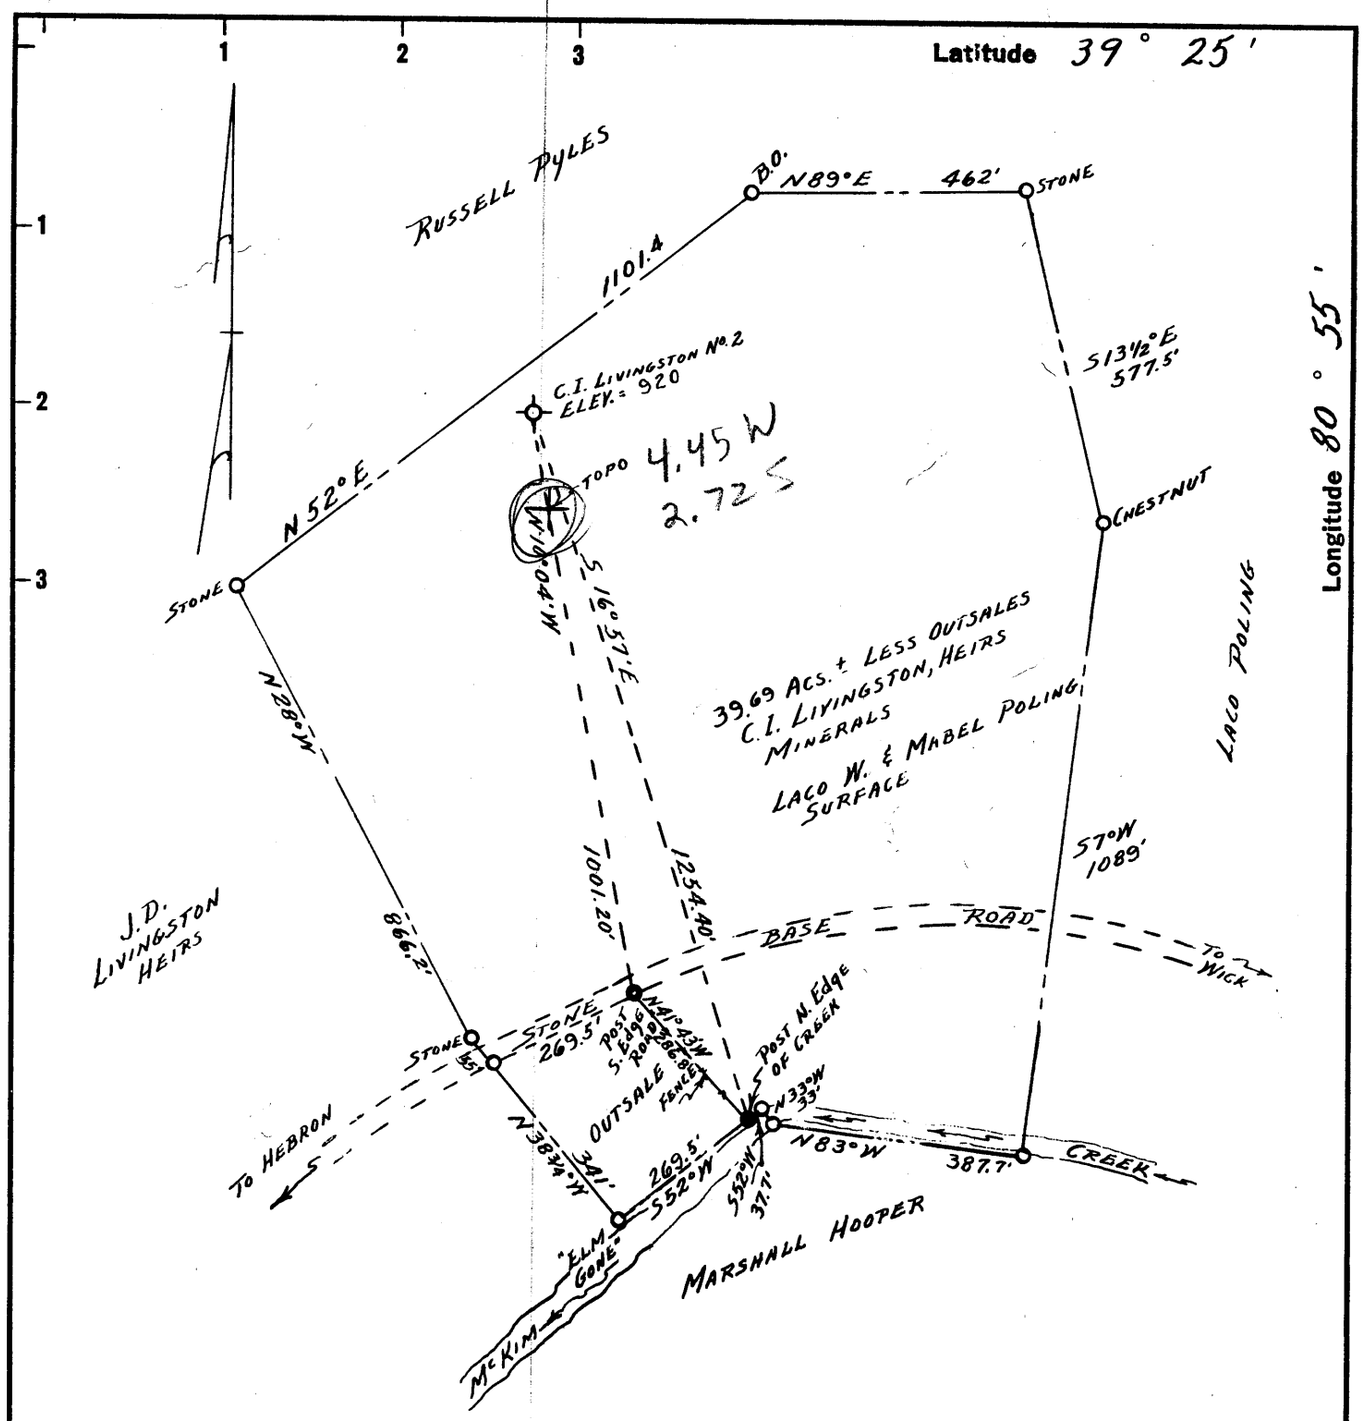

"I, THE UNDERSIGNED, HEREBY CERTIFY THAT THIS MAP IS CORRECT TO THE BEST OF MY KNOWLEDGE & BELIEF AND SHOWS ALL THE INFORMATION REQUIRED BY PARAGRAPH 6 OF THE RULES & REGULATIONS OF THE OIL & GAS SECTION OF THE MINING LAWS OF WEST VIRGINIA."

By Paul H Dean


New Location ..☐
Drill Deeper .....☐
Abandonment.....■

APR 29 1963

Company WILLIAM CASSADY
Address 4303 WHITED DRIVE, VIENNA, W. VA.
Farm LACO POLING SURFACE & C.I. LIVINGSTON, HRS. MINERALS
Tract 1 Acres 39.69 ± Lease No. 755
SOUTH PENN. MAP # N35
Well (Farm) No. 2 Serial No.
Elevation (Spirit Level) 920
Quadrangle WEST UNION
County TYLER District MLADE
Engineer Paul H Dean
Engineer's Registration No. 1856
File No. 136-3 Pg. 35 Drawing No. 63-17
Date APRIL 8, 1963 Scale 1" = 300'

STATE OF WEST VIRGINIA
DEPARTMENT OF MINES
OIL AND GAS DIVISION
CHARLESTON

WELL LOCATION MAP

FILE NO. TYL-930-A

+ Denotes location of well on United States Topographic Maps, scale 1 to 62,500, latitude and longitude lines being represented by border lines as shown.

— Denotes one inch spaces on border line of original tracing.

K+E 166 IMPERIAL TRACING CLOTH T.M. 69288

C.I. LIVINGSTON HEIRS No. 2 — WM. CASSADY — TYL-930-A
(LACO POLING — SURFACE)