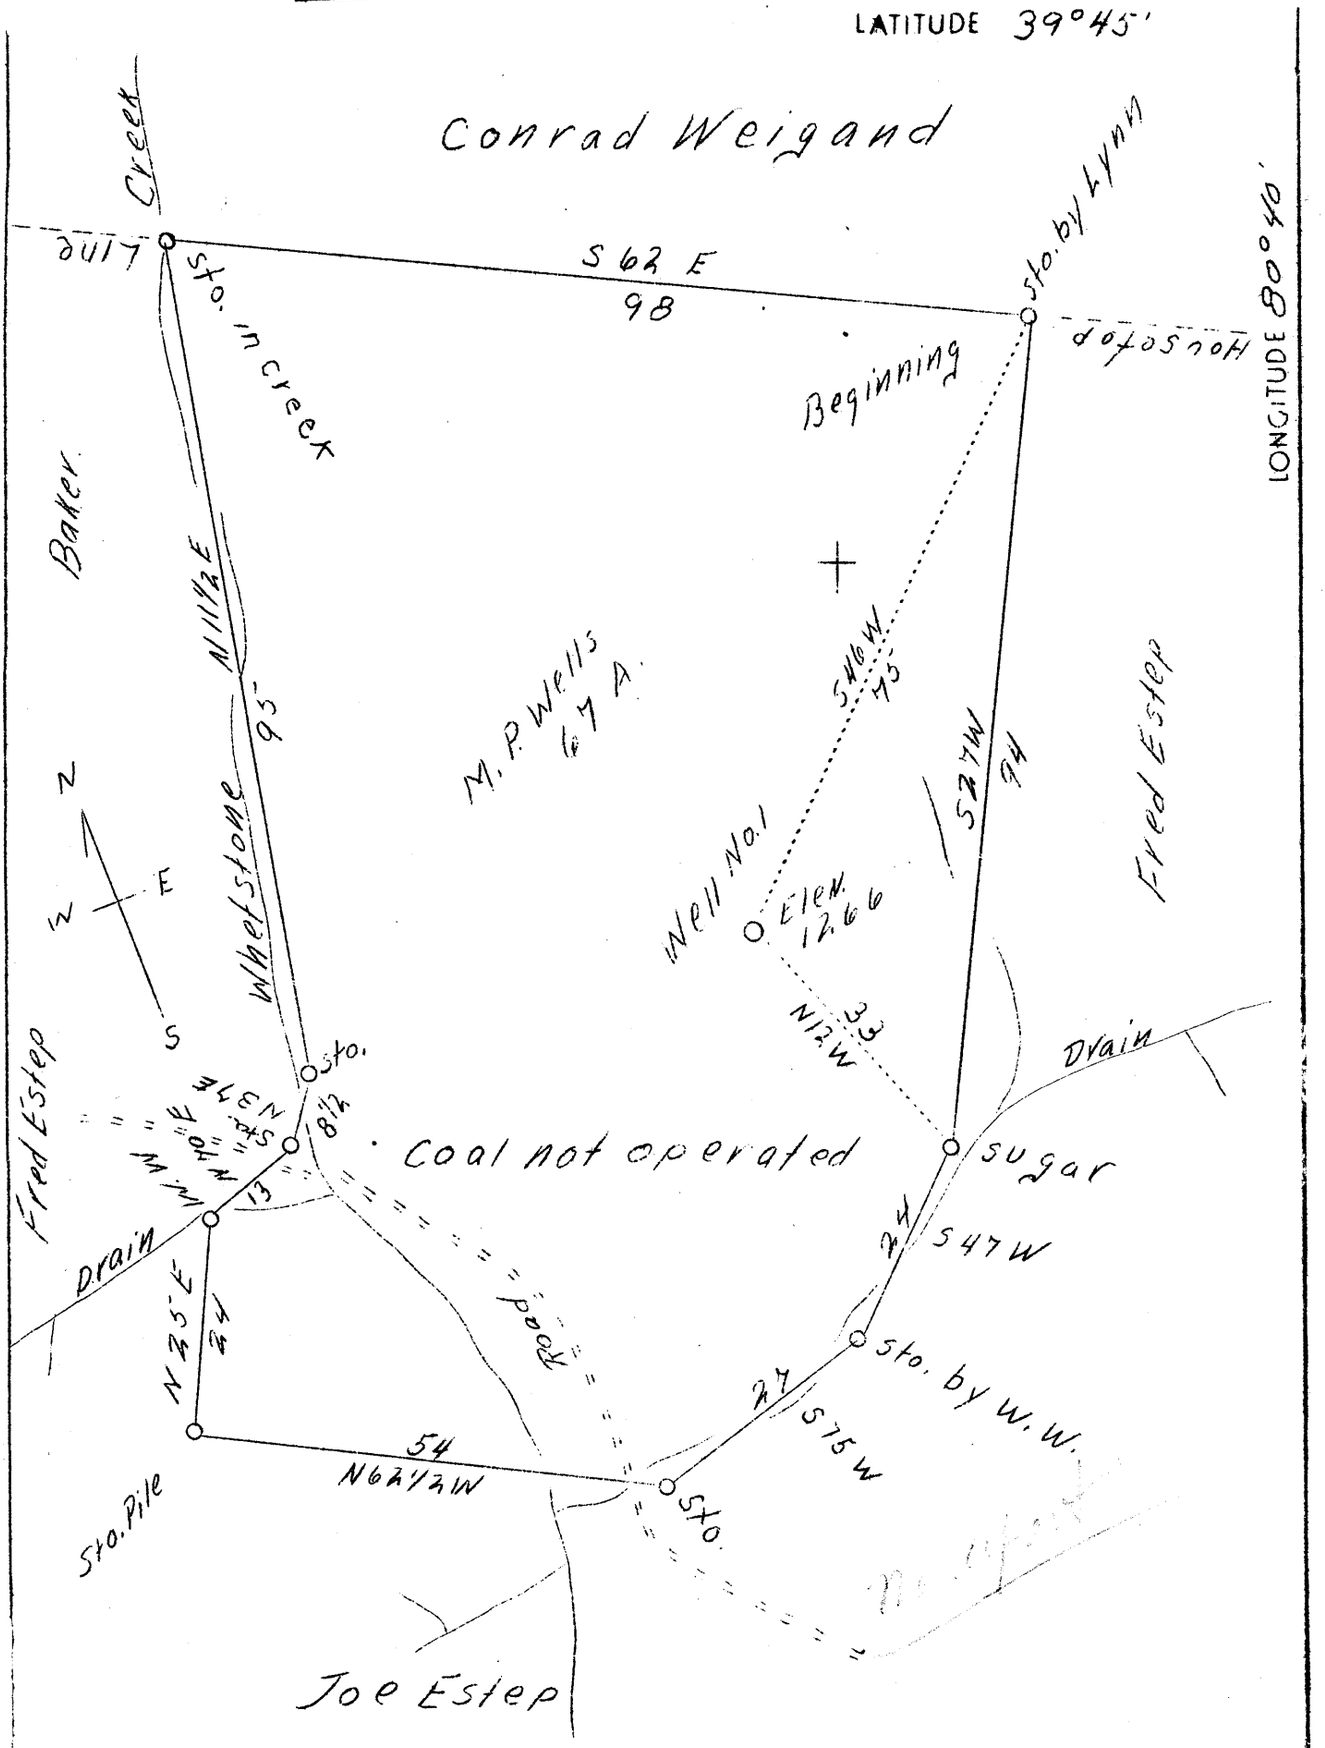

Company	S.J. Brendel Co.
Address	Pittsburgh, Pa.
Farm	M.P.Wells
Tract	1
Acres	67
Well (Farm)	1
Elevation SL.	1266
Quadrangle	Littleton
County	Wetzel
District	Proctor
Engineer	J.M. Cochran
Engineer's Reg. No.	Co. Surveyor
Date	Feb. 20,1939
Scale	1" 20 Rods.

STATE OF WEST VIRGINIA
Department of Mines
OIL AND GAS DIVISION
CHARLESTON

W E L L L O C A T I O N M A P

File No Wet-221

x Denotes location of well on United States Topographic Maps, scale 1 to 62,500, latitude and longitude lines being represented by border lines as shown.

-Denotes one inch spaces on border line of original tracing.