

West Virginia Department of Environmental Protection  
Office of Oil & Gas  
**WELL LOCATION FORM: GPS**

API: 47- 103 - 0992 WELL NO: 57

FARM NAME: L.S. Hoyt No.57

RESPONSIBLE PARTY NAME: H.G. Energy, LLC

COUNTY: Wetzel DISTRICT: Grant

QUADRANGLE: Pine Grove 7.5'

SURFACE OWNER: Dallison Lumber, Inc.

ROYALTY OWNER: Ascent Resources, Inc.

UTM GPS NORTHING: 4,383,704 (NAD 83)

UTM GPS EASTING: 529,221 (NAD 83) GPS ELEVATION: 1420 ft  
373 m.

The Responsible Party named above has chosen to submit GPS coordinates in lieu of preparing a new well location plat for a plugging permit on the above well. The Office of Oil & Gas will not accept GPS coordinates that do not meet the following requirements:

1. Datum: NAD 1983, Zone:17 North, Coordinate Units: meters, Altitude: height above mean sea level (MSL) - meters.
2. Accuracy to Datum - 3.05 meters
3. Data Collection Method:

Survey Grade GPS	<input type="checkbox"/>	Post Processed Differential	<input type="checkbox"/>
		Real-Time Differential	<input type="checkbox"/>
Mapping Grade GPS	<input checked="" type="checkbox"/>	Post Processed Differential	<input checked="" type="checkbox"/>
		Real-Time Differential	<input type="checkbox"/>

Received  
Office of Oil & Gas  
SEP 26 2016

I the undersigned, hereby certify this data is correct to the best of my knowledge and belief and shows all the information required by law and the regulations issued and prescribed by the Office of Oil and Gas.


Diane White Diane C. White  
Signature

Designated Agent  
Title

September 13, 2016  
Date

10300992F

SUBJECT WELL  
L.S. Hoyt No.57  
47-103-0992

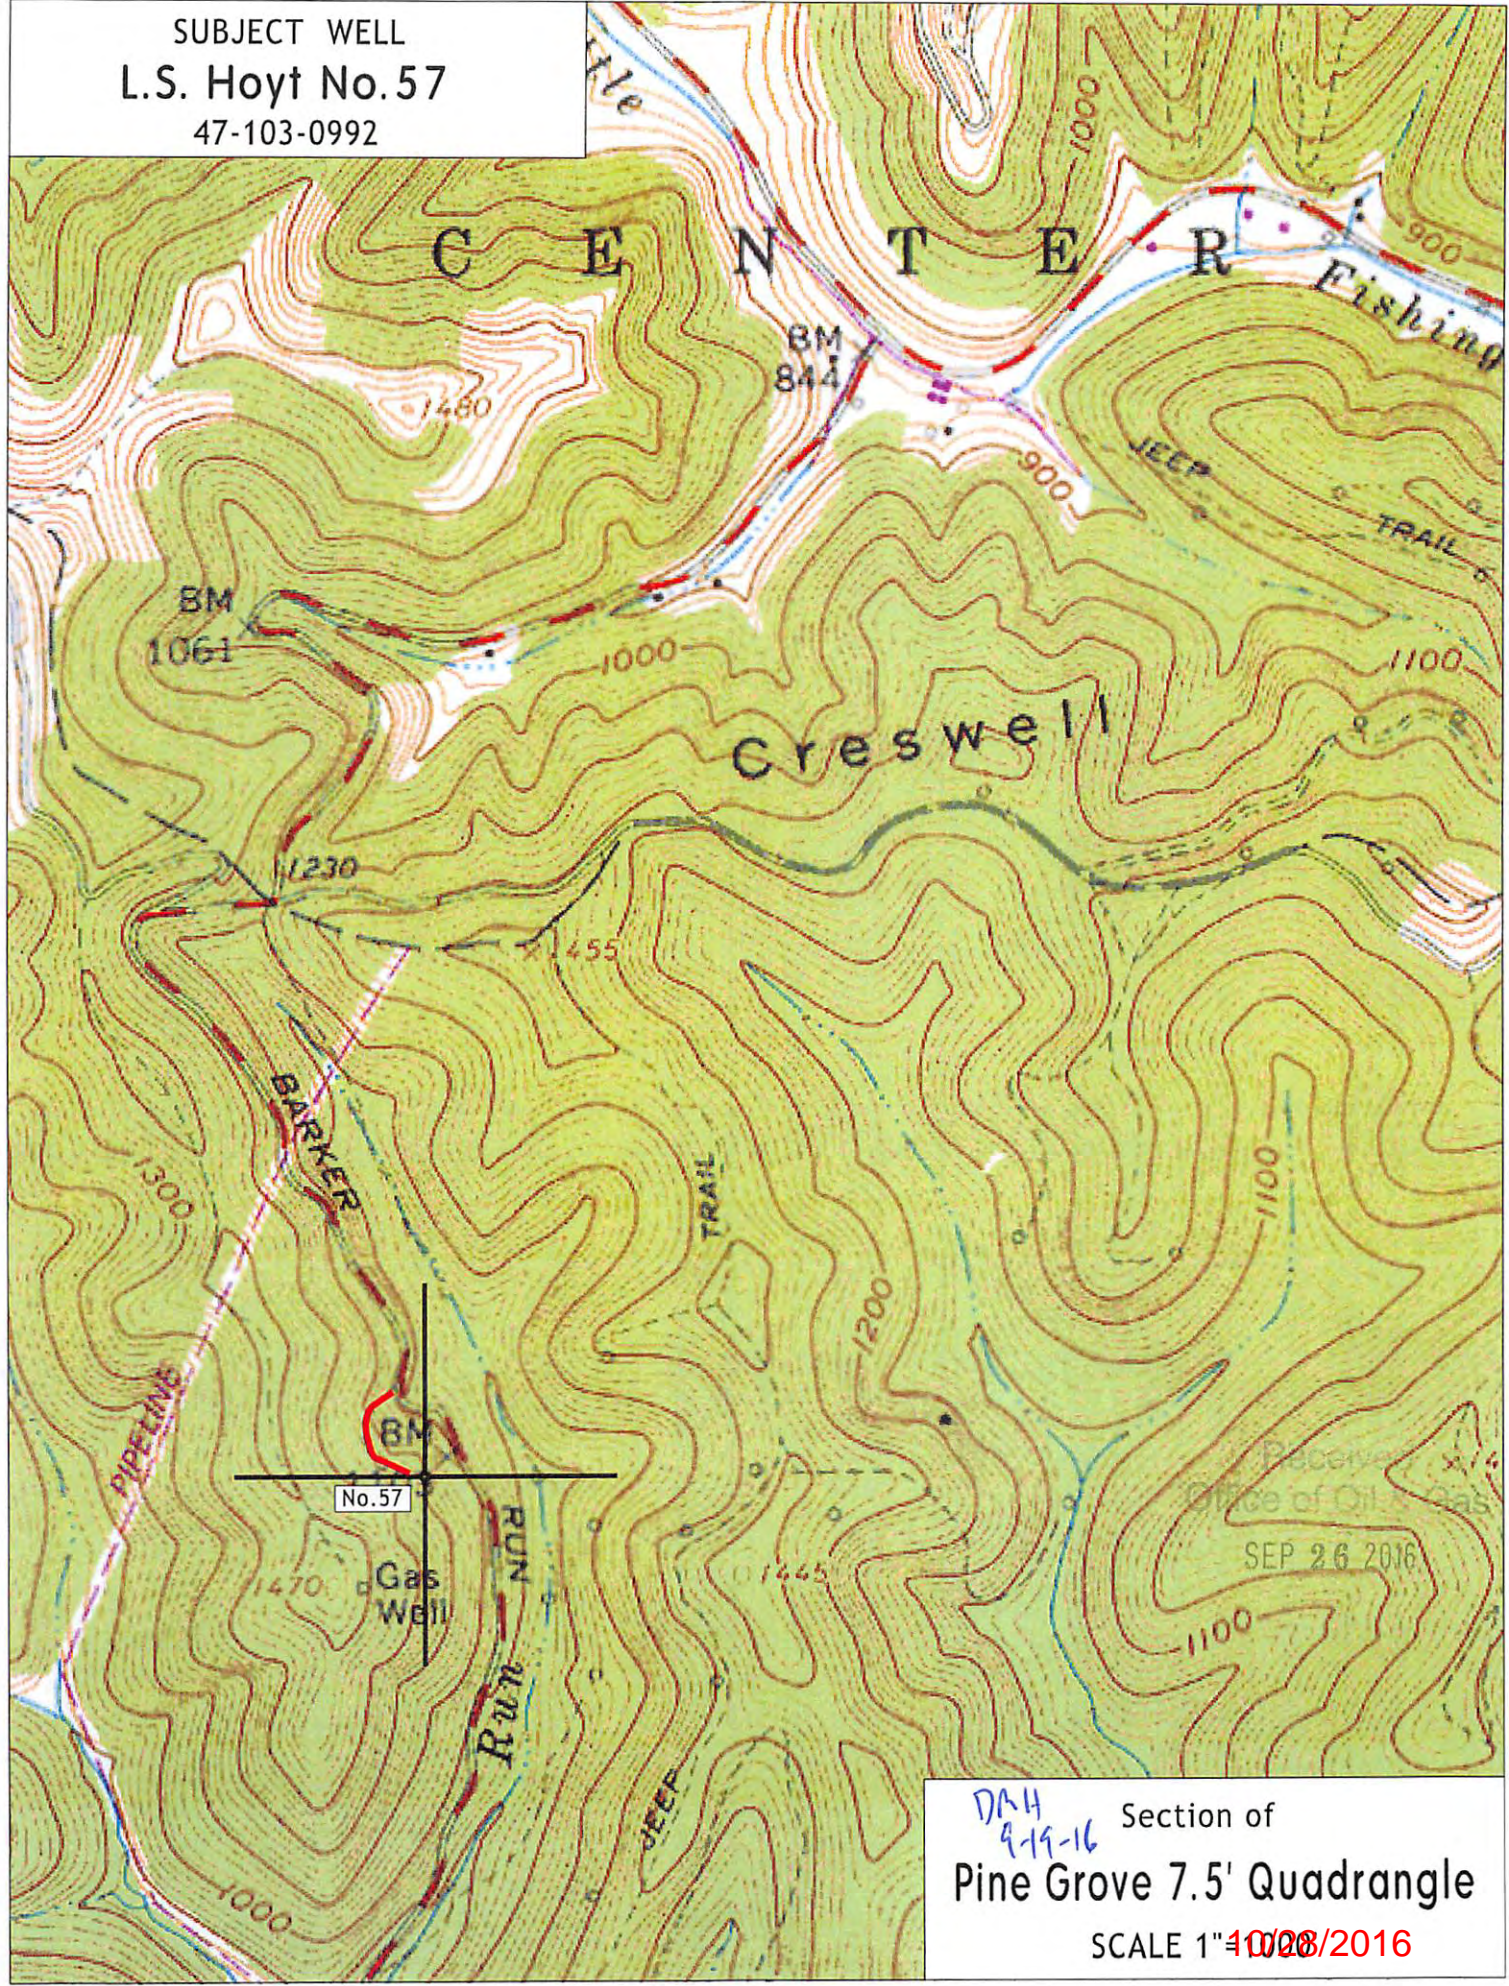

DAH  
9-19-16 Section of  
Pine Grove 7.5' Quadrangle  
SCALE 1" = 1000'  
10/28/2016