

WW-7
8-30-06



West Virginia Department of Environmental Protection
Office of Oil and Gas

WELL LOCATION FORM: GPS

API: 47-103-01028 WELL NO.: 3

FARM NAME: S. J. Long

RESPONSIBLE PARTY NAME: Tribune Resources

COUNTY: Wetzel DISTRICT: Grant

QUADRANGLE: Centerpoint

SURFACE OWNER: Wesley Stoneking & Joe Stoneking

ROYALTY OWNER: _____

UTM GPS NORTHING: 4381474.24

UTM GPS EASTING: 521624.22 GPS ELEVATION: 785'

The Responsible Party named above has chosen to submit GPS coordinates in lieu of preparing a new well location plat for a plugging permit or assigned API number on the above well. The Office of Oil and Gas will not accept GPS coordinates that do not meet the following requirements:

- Datum: NAD 1983, Zone: 17 North, Coordinate Units: meters, Altitude: height above mean sea level (MSL) – meters.
- Accuracy to Datum – 3.05 meters
- Data Collection Method:

Survey grade GPS _____: Post Processed Differential _____

Real-Time Differential _____

Mapping Grade GPS _____: Post Processed Differential X

Real-Time Differential _____

- Letter size copy of the topography map showing the well location.

I the undersigned, hereby certify this data is correct to the best of my knowledge and belief and shows all the information required by law and the regulations issued and prescribed by the Office of Oil and Gas.


Anna C. Bratt Agent
Signature Title

4-17-19
Date

RECEIVED
Office of Oil and Gas

MAY 16 2019

WV Department of
Environmental Protection

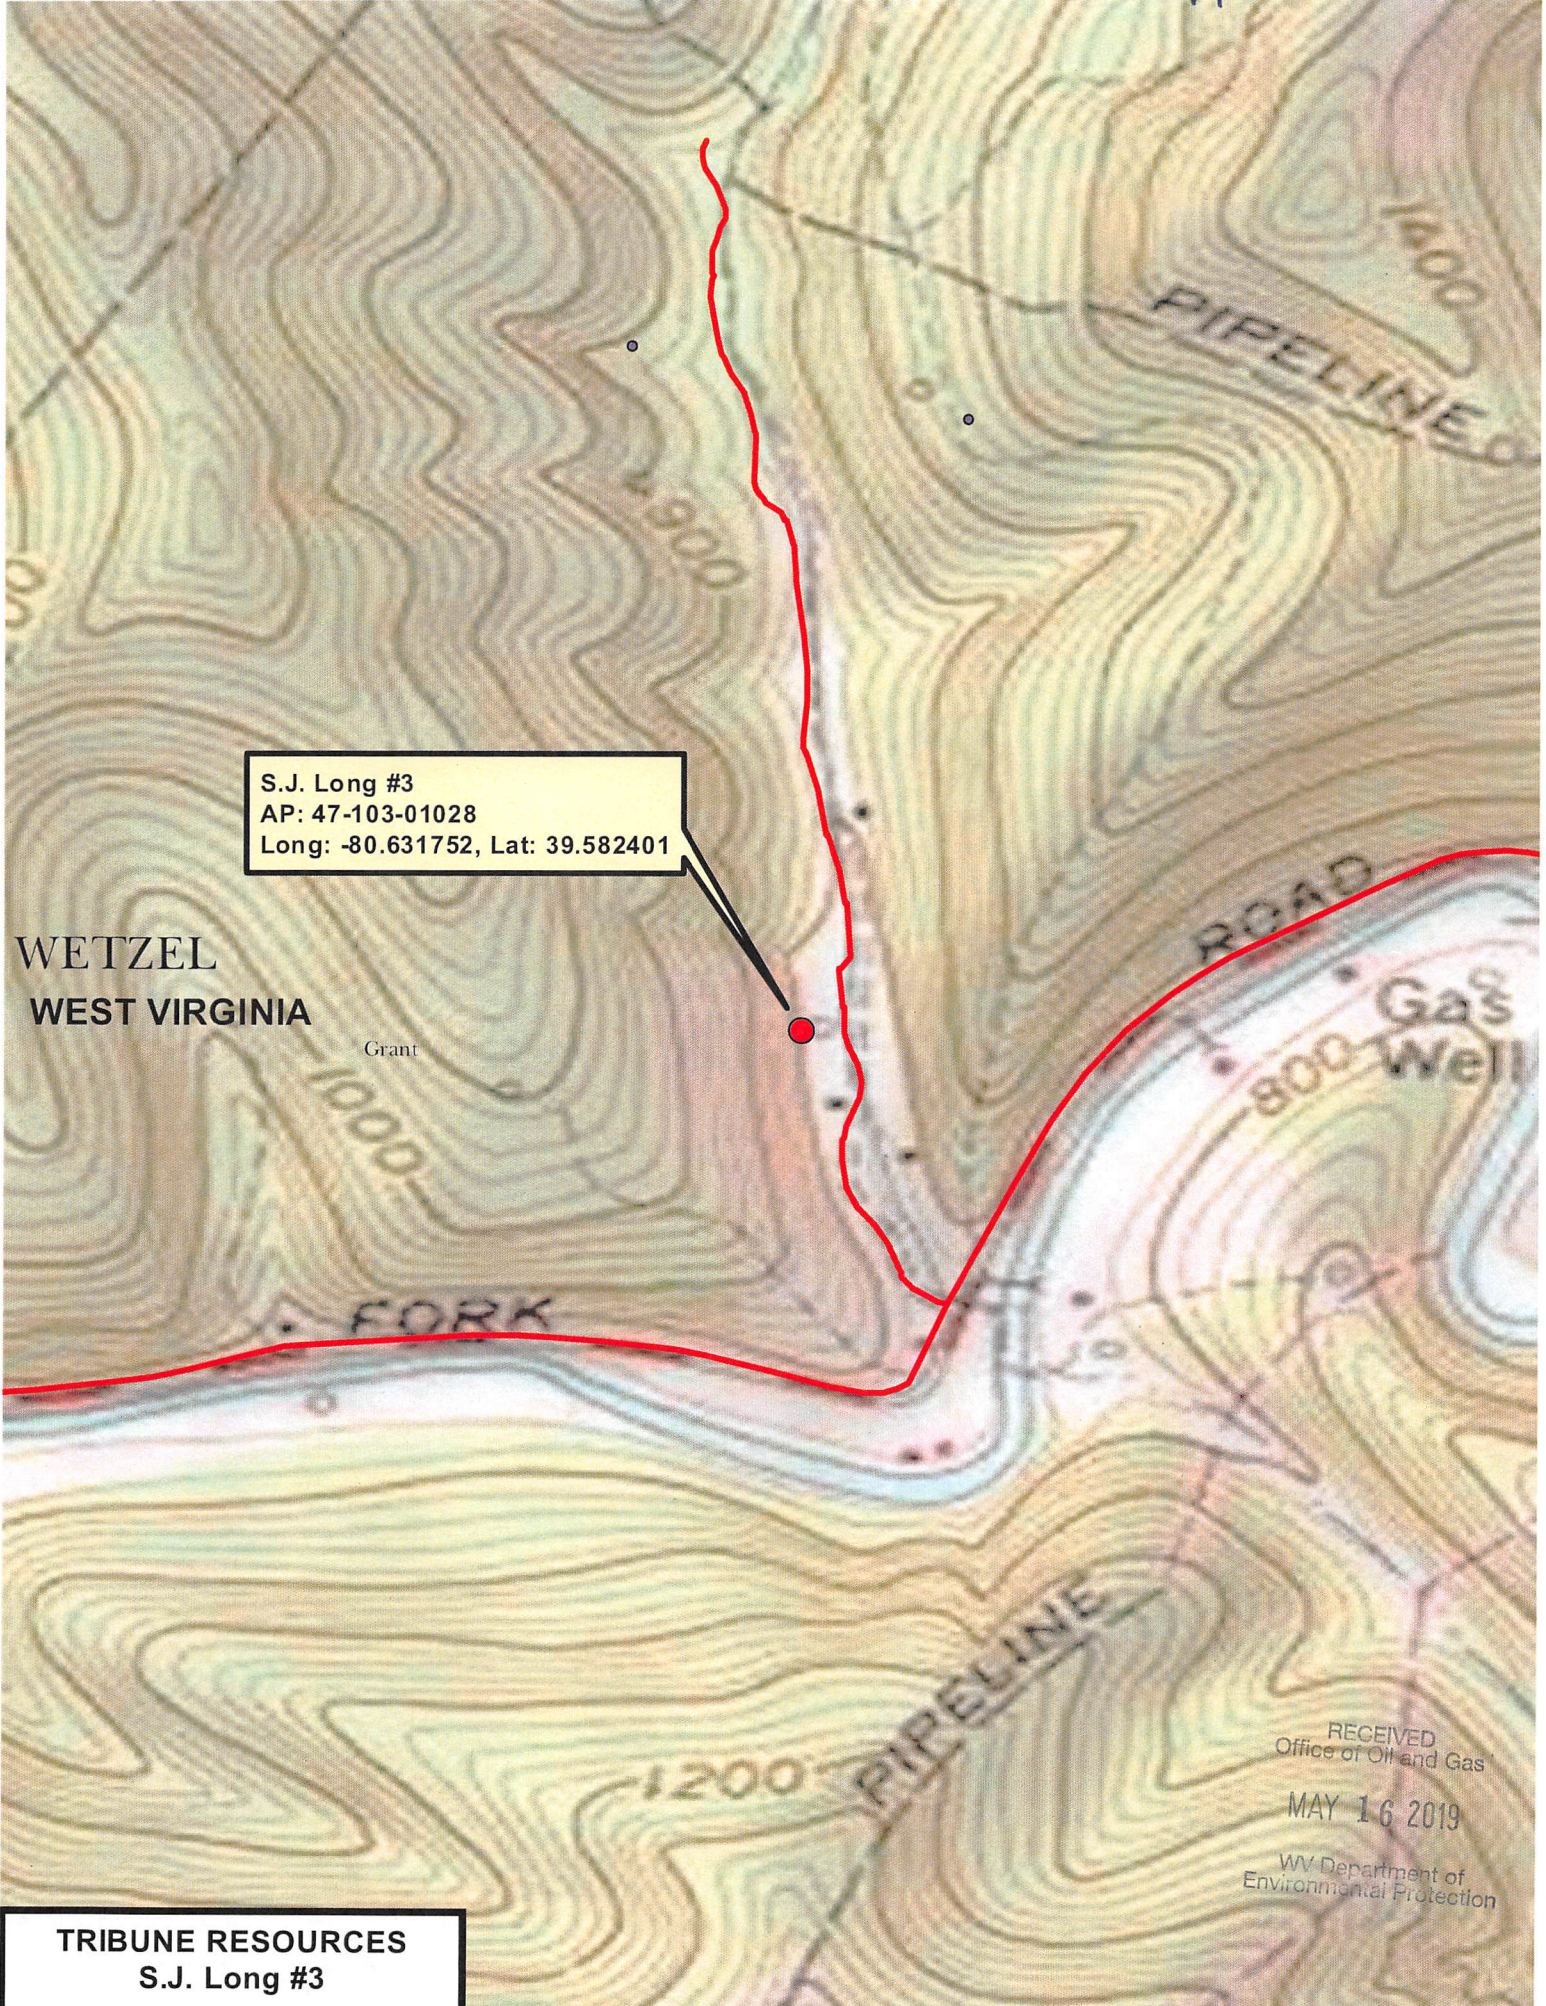

TRIBUNE RESOURCES
S.J. Long #3