

ALLGAS ROAD


SM

02/10/2023



38 39 32'30" 40 41 INTERIOR—GEOLOGICAL SURVEY, RESTON, VIRG. 542000E

SCALE 1:24 000

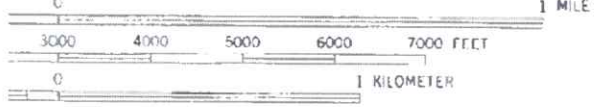

INTERVAL 20 FEET
VERTICAL DATUM OF 1929



Revisions shown in purple compiled in cooperation with State of West Virginia agencies from aerial photographs taken 1976. This information not field checked.

ROAD CLASSIFICATION

Heavy-duty Light-duty

Medium-duty Unimproved

Slate Route

RECEIVED
Office of Oil and Gas
JAN 09 2023

BIG RUN
SE/4 LITTLETON
N3930—

WV Department of
Environmental Protection

1
AMS 4865 II :

NATIONAL MAP ACCURACY STANDARDS
GEOLOGICAL SURVEY, RESTON, VA. 22092
MAPS AND SYMBOLS IS AVAILABLE ON REQUEST

SM

WW-7
8-30-06



West Virginia Department of Environmental Protection
Office of Oil and Gas

WELL LOCATION FORM: GPS

API: 47-103-01036 WELL NO.: 7256

FARM NAME: I.D. MORGAN

RESPONSIBLE PARTY NAME: WEST VIRGINIA LAND RESOURCES INC.

COUNTY: WETZEL DISTRICT: GRANT

QUADRANGLE: BIG RUN W.VA

SURFACE OWNER: MAGNOLIA LAND PARTNERS

ROYALTY OWNER: _____

UTM GPS NORTHING: 4,373,301 m (1315')

UTM GPS EASTING: 539,977 m GPS ELEVATION: 401 m

The Responsible Party named above has chosen to submit GPS coordinates in lieu of preparing a new well location plat for a plugging permit or assigned API number on the above well. The Office of Oil and Gas will not accept GPS coordinates that do not meet the following requirements:

- Datum: NAD 1983, Zone: 17 North, Coordinate Units: meters, Altitude: height above mean sea level (MSL) – meters.
- Accuracy to Datum – 3.05 meters
- Data Collection Method:

Survey grade GPS _____ : Post Processed Differential _____

Real-Time Differential _____

Mapping Grade GPS X : Post Processed Differential X

Real-Time Differential _____

- Letter size copy of the topography map showing the well location.

I the undersigned, hereby certify this data is correct to the best of my knowledge and belief and shows all the information required by law and the regulations issued and prescribed by the Office of Oil and Gas.

Parvinder Reddy
Signature

Professional Geoscientist
Title
District Engineer

DECEMBER 22, 2022
Date