



Diversified Gas & Oil Corporation
 100 Diversified Way
 Pileville KY, 41051

47-103-01052

Well Plugging Map

Legend

- Well
- Pits
- Pad
- Access Road
- Public Roads


RECEIVED
Office of Oil and Gas
OCT 03 2025
WV Department of
Environmental Protection



1" = 500'

0 255 510

ft

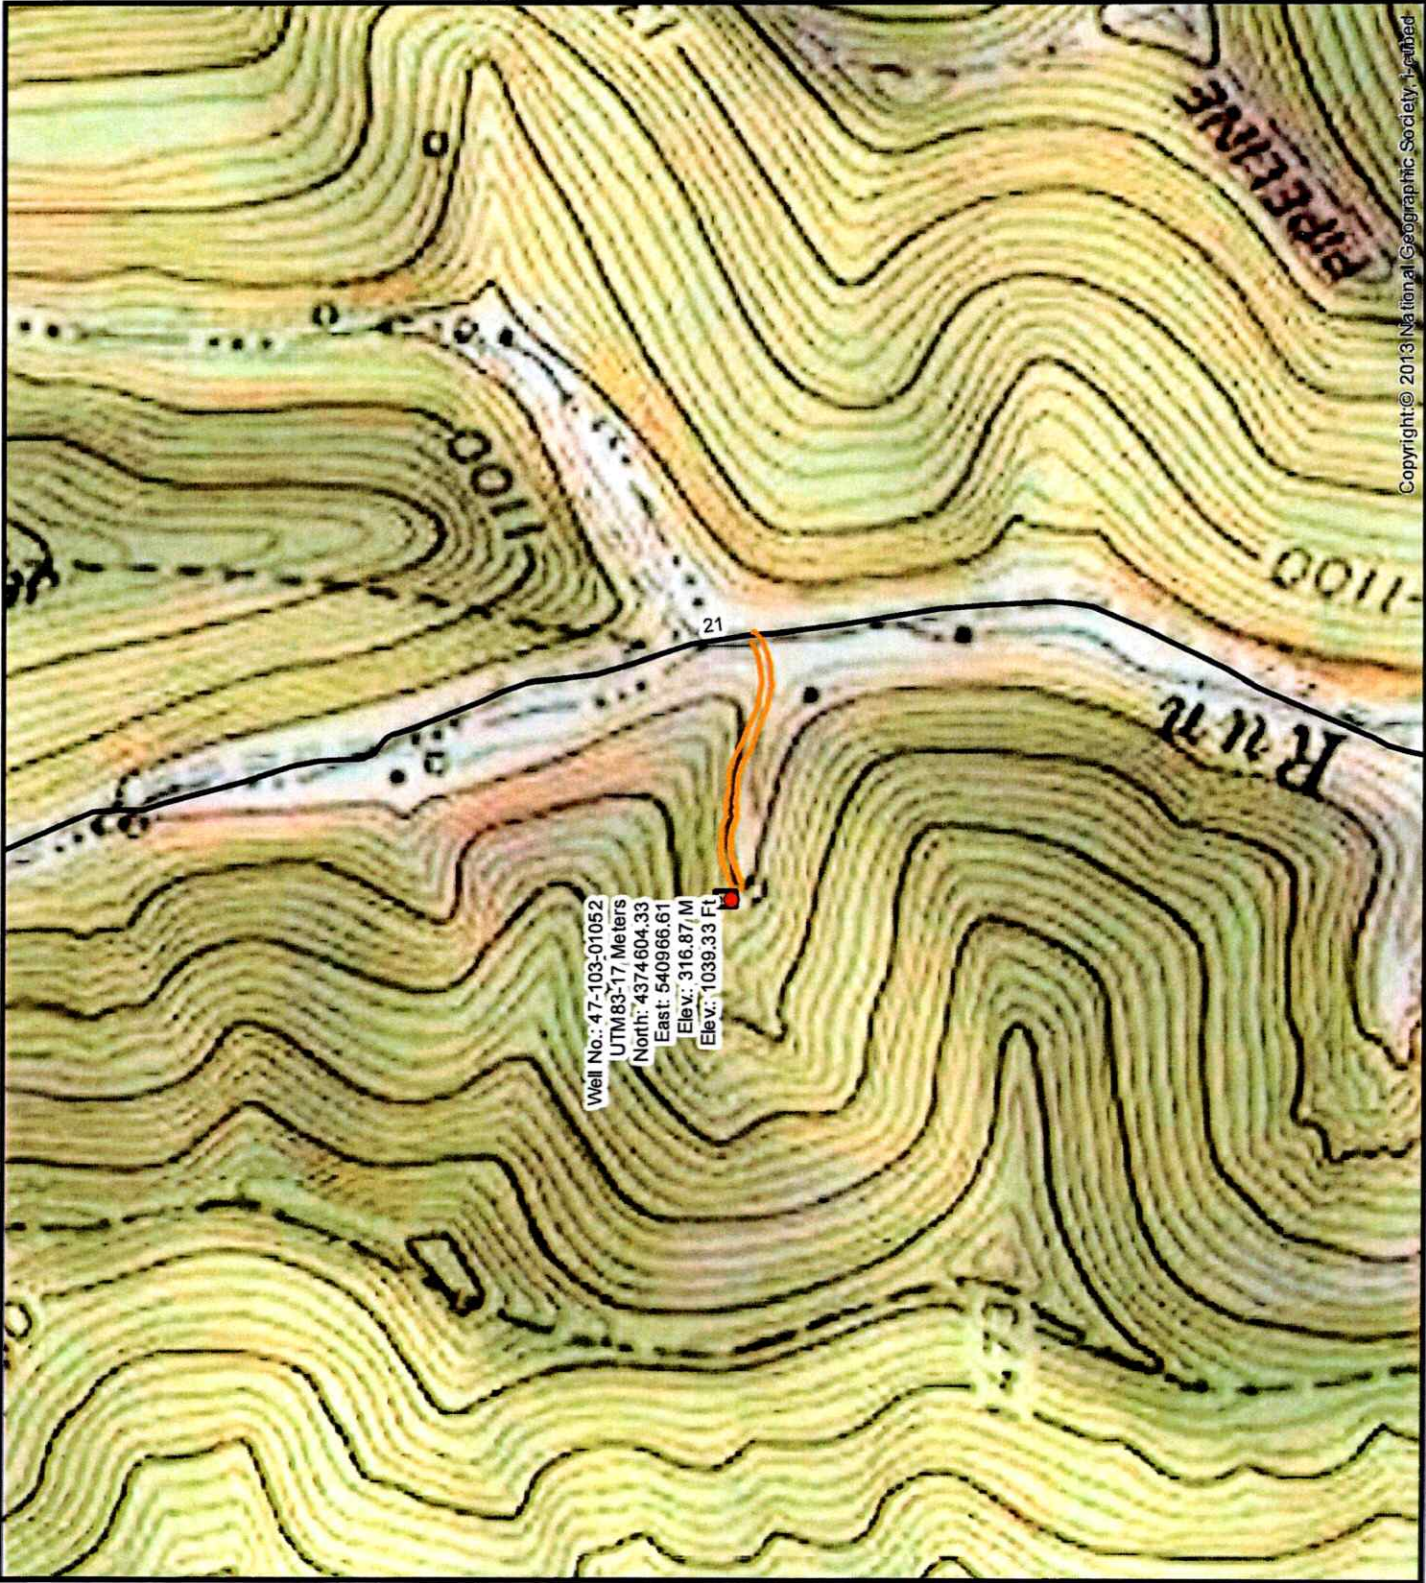

Copyright © 2013 National Geographic Society. Leashed



Diversified Gas & Oil
Corporation
100 Diversified Way
Pikeville KY, 41051

47-103-01052

Well Plugging Map

Legend

- Well
- Pits
- Pad
- Access Road
- Public Roads

RECEIVED
Office of Oil and Gas

OCT 03 2025

WV Department of
Environmental Protection



Secondary Pit

Primary Pit

Well No.: 47-103-01052
UTM 183-17, Meters
North: 4374604.33
East: 540966.61
Elev.: 316.87 M
Elev.: 1039.33 Ft

Source: Esri Map, Earthstar Geographics and the US UserCommunity

10/17/2025

WW-7
8-30-06



West Virginia Department of Environmental Protection
Office of Oil and Gas
WELL LOCATION FORM: GPS

API: 4710301052 WELL NO.: Dave Norris #3
FARM NAME: Norris
RESPONSIBLE PARTY NAME: Diversified Production, LLC
COUNTY: Wetzel DISTRICT: Grant
QUADRANGLE: Big Run 7.5'
SURFACE OWNER: Nila Ensminger, Est.
ROYALTY OWNER: See Attached
UTM GPS NORTHING: 4374604.33
UTM GPS EASTING: 540966.61 GPS ELEVATION: 1039.33'

The Responsible Party named above has chosen to submit GPS coordinates in lieu of preparing a new well location plat for a plugging permit or assigned API number on the above well. The Office of Oil and Gas will not accept GPS coordinates that do not meet the following requirements:

1. Datum: NAD 1983, Zone: 17 North, Coordinate Units: meters, Altitude: height above mean sea level (MSL) – meters.
2. Accuracy to Datum – 3.05 meters
3. Data Collection Method:

Survey grade GPS ____: Post Processed Differential ____
Real-Time Differential ____

Mapping Grade GPS X: Post Processed Differential X
Real-Time Differential ____


4. Letter size copy of the topography map showing the well location.

I the undersigned, hereby certify this data is correct to the best of my knowledge and belief and shows all the information required by law and the regulations issued and prescribed by the Office of Oil and Gas.


Signature

Chris Veazey - Director of Administration

Title

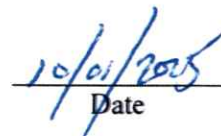
Date

RECEIVED
Office of Oil and Gas

OCT 03 2025

WV Department of
Environmental Protection

10/17/2025