

Well# 7512
BIG RUN WV 7.5' Quad
Scale: 1" = 500'

Gas



1300

1100

1500


Well# 7512

Run

Dickenpaw

1300

PIPELINE

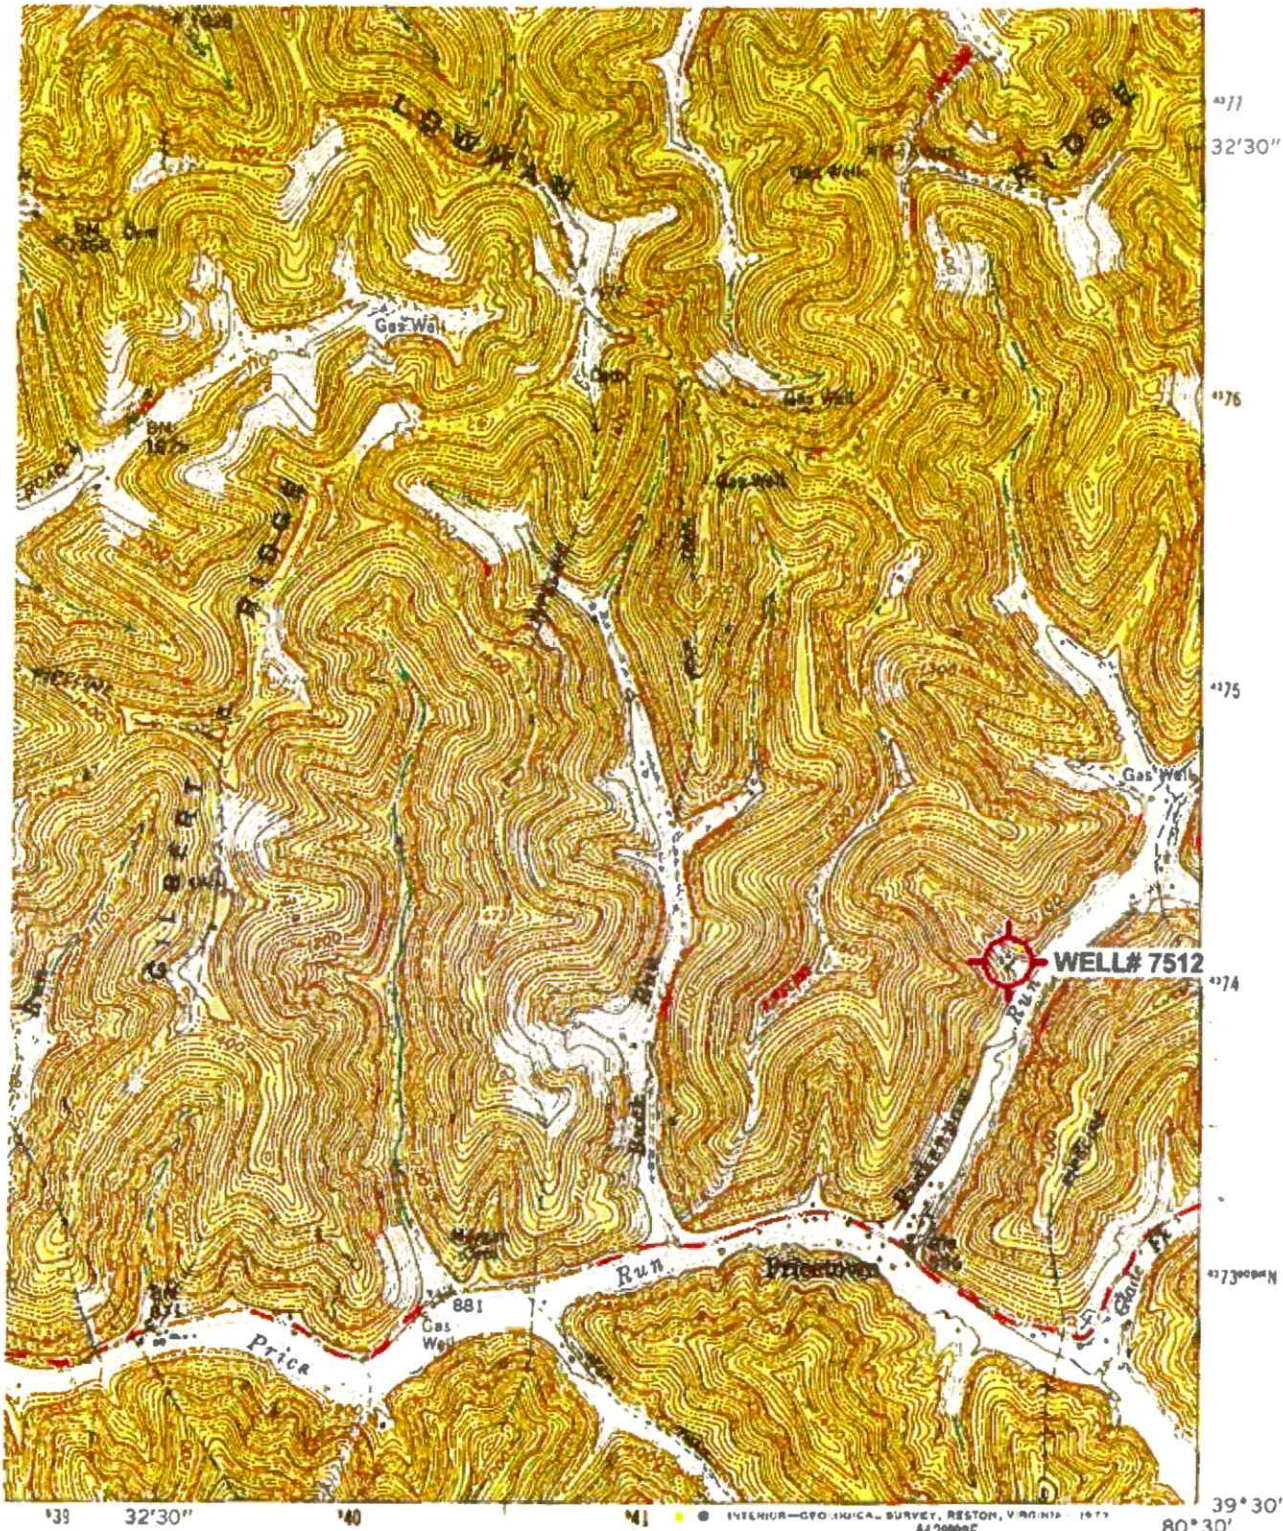

1 MILE
 328 FEET
 1:62,500



ROAD CLASSIFICATION

Heavy-duty	—————	Light-duty	—————
Medium-duty	—————	Unimproved dirt
	—————	Slate Route	—————

BIG RUN, W. VA.
 SE/4 LITTLETON 15' QUADRANGLE
 N3930 - W8030/7.5

1960

(WALLACE)
 4502 N.W.
 RECEIVED
 Office of Oil and Gas
JAN 31 2025
 W.V. Department of
 Environmental Protection
02/07/2025

Well# 7512
Scale: 1" = 2000'

Well# 7512

Princeton

RECEIVED
Office of Oil and Gas
JAN 31 2025
Environmental Protection


02/07/2025

WW-7
8-30-06



West Virginia Department of Environmental Protection
Office of Oil and Gas
WELL LOCATION FORM: GPS

API: 47-103-01435 WELL NO.: 7512
FARM NAME: S. C. STEVENS 3
RESPONSIBLE PARTY NAME: WEST VIRGINIA LAND RESOURCES INC.
COUNTY: WETZEL DISTRICT: GRANT
QUADRANGLE: BIG RUN WV
SURFACE OWNER: DOUGLAS SMITH
ROYALTY OWNER: _____
UTM GPS NORTHING: 4,374,236 m
UTM GPS EASTING: 542,331 m GPS ELEVATION: 288 m

The Responsible Party named above has chosen to submit GPS coordinates in lieu of preparing a new well location plat for a plugging permit or assigned API number on the above well. The Office of Oil and Gas will not accept GPS coordinates that do not meet the following requirements:

1. Datum: NAD 1983, Zone: 17 North, Coordinate Units: meters, Altitude: height above mean sea level (MSL) – meters.
2. Accuracy to Datum 3.05 meters
3. Data Collection Method:

Survey grade GPS : Post Processed Differential
Real-Time Differential _____
Mapping Grade GPS _____ : Post Processed Differential _____
Real-Time Differential _____

4. **Letter size copy of the topography map showing the well location.**

I the undersigned, hereby certify this data is correct to the best of my knowledge and belief and shows all the information required by law and the regulations issued and prescribed by the Office of Oil and Gas.

[Signature] PS 2002 JANUARY 3, 2025
Signature Title Date

RECEIVED
Office of Oil and Gas

JAN 31 2025

WV Department of
Environmental Protection

02/07/2025