

WW-7
8-30-06



West Virginia Department of Environmental Protection
Office of Oil and Gas
WELL LOCATION FORM: GPS

API: 47-103-01846 WELL NO.: 6324

FARM NAME: MARY R. KOCHER

RESPONSIBLE PARTY NAME: WEST VIRGINIA LAND RESOURCES, Inc

COUNTY: WETZEL DISTRICT: GRANT

QUADRANGLE: WALLACE, WV 7.5'

SURFACE OWNER: MARY R. KOCHER

ROYALTY OWNER: _____

UTM GPS NORTHING: 4,371,012.0 m

UTM GPS EASTING: 544,613.6 m GPS ELEVATION: 389.1 m (1276')

The Responsible Party named above has chosen to submit GPS coordinates in lieu of preparing a new well location plat for a plugging permit or assigned API number on the above well. The Office of Oil and Gas will not accept GPS coordinates that do not meet the following requirements:

- Datum: NAD 1983, Zone: 17 North, Coordinate Units: meters, Altitude: height above mean sea level (MSL) – meters.
- Accuracy to Datum – 3.05 meters
- Data Collection Method:

Survey grade GPS : Post Processed Differential _____
Real-Time Differential

Mapping Grade GPS _____ : Post Processed Differential _____
Real-Time Differential _____

RECEIVED
Office of Oil and Gas
DEC 11 2020
WV Department of
Environmental Protection

- Letter size copy of the topography map showing the well location.


I the undersigned, hereby certify this data is correct to the best of my knowledge and belief and shows all the information required by law and the regulations issued and prescribed by the Office of Oil and Gas.

Professional Surveyor
Title

APRIL 8, 2020
Date

UNITED STATES
DEPARTMENT OF THE INTERIOR
GEOLOGICAL SURVEY

488 II SE
(BIG RUN)

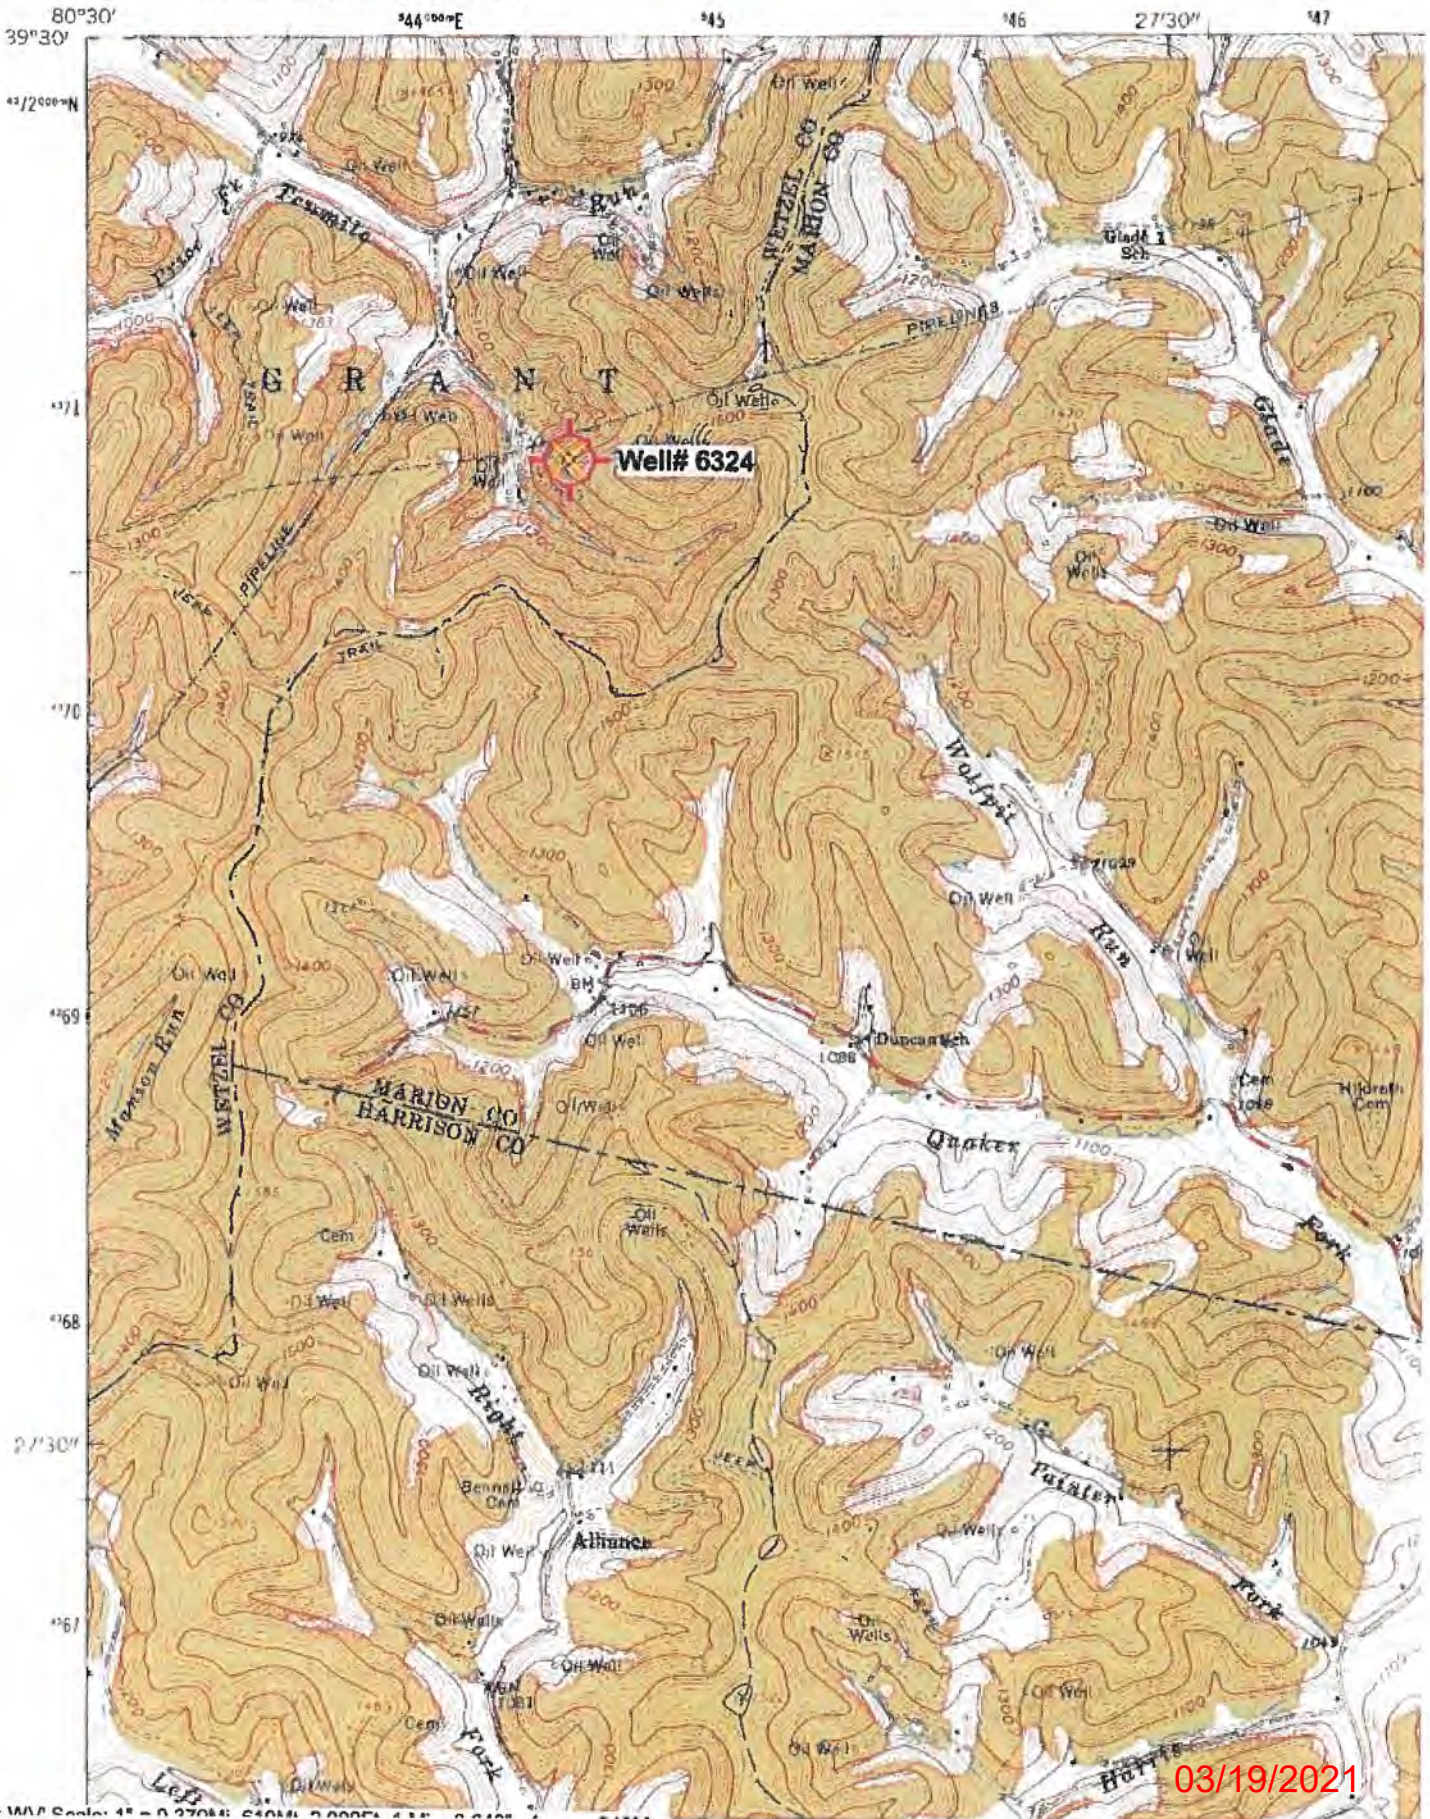

03/19/2021