

WW-7
8-30-06



West Virginia Department of Environmental Protection
Office of Oil and Gas
WELL LOCATION FORM: GPS

API: 47-103-01970 WELL NO.: C.C. Pennick No. 54

FARM NAME: _____

RESPONSIBLE PARTY NAME: Ascent Resources - Marcellus LLC

COUNTY: Wetzel DISTRICT: Green

QUADRANGLE: Center Point, WV

SURFACE OWNER: WV Dept. of Natural Resources - Division of Commerce

ROYALTY OWNER: Ascent Resources - Marcellus LLC

UTM GPS NORTHING: 4370369.9

UTM GPS EASTING: 526081.0 GPS ELEVATION: 1259.05'

The Responsible Party named above has chosen to submit GPS coordinates in lieu of preparing a new well location plat for a plugging permit or assigned API number on the above well. The Office of Oil and Gas will not accept GPS coordinates that do not meet the following requirements:

1. Datum: NAD 1983, Zone: 17 North, Coordinate Units: meters, Altitude: height above mean sea level (MSL) – meters.
2. Accuracy to Datum – 3.05 meters
3. Data Collection Method:

Survey grade GPS : Post Processed Differential _____

Real-Time Differential _____

Mapping Grade GPS _____ : Post Processed Differential _____

Real-Time Differential _____

4. Letter size copy of the topography map showing the well location.

I the undersigned, hereby certify this data is correct to the best of my knowledge and belief and shows all the information required by law and the regulations issued and prescribed by the Office of Oil and Gas.


Signature

Sr. Regulatory Analyst

Title


RECEIVED
8/31/15
SEP 14 2015

WV Department of
Environmental Protection
11/13/2015

WELL NAME: G.C. PENNICK No. 54
QUAD: CENTER POINT, WV

RECEIVED
Office of Oil and Gas
SEP 14 2015
WV Department of
Environmental Protection

C.C. PENNICK
No. 54
095-01938

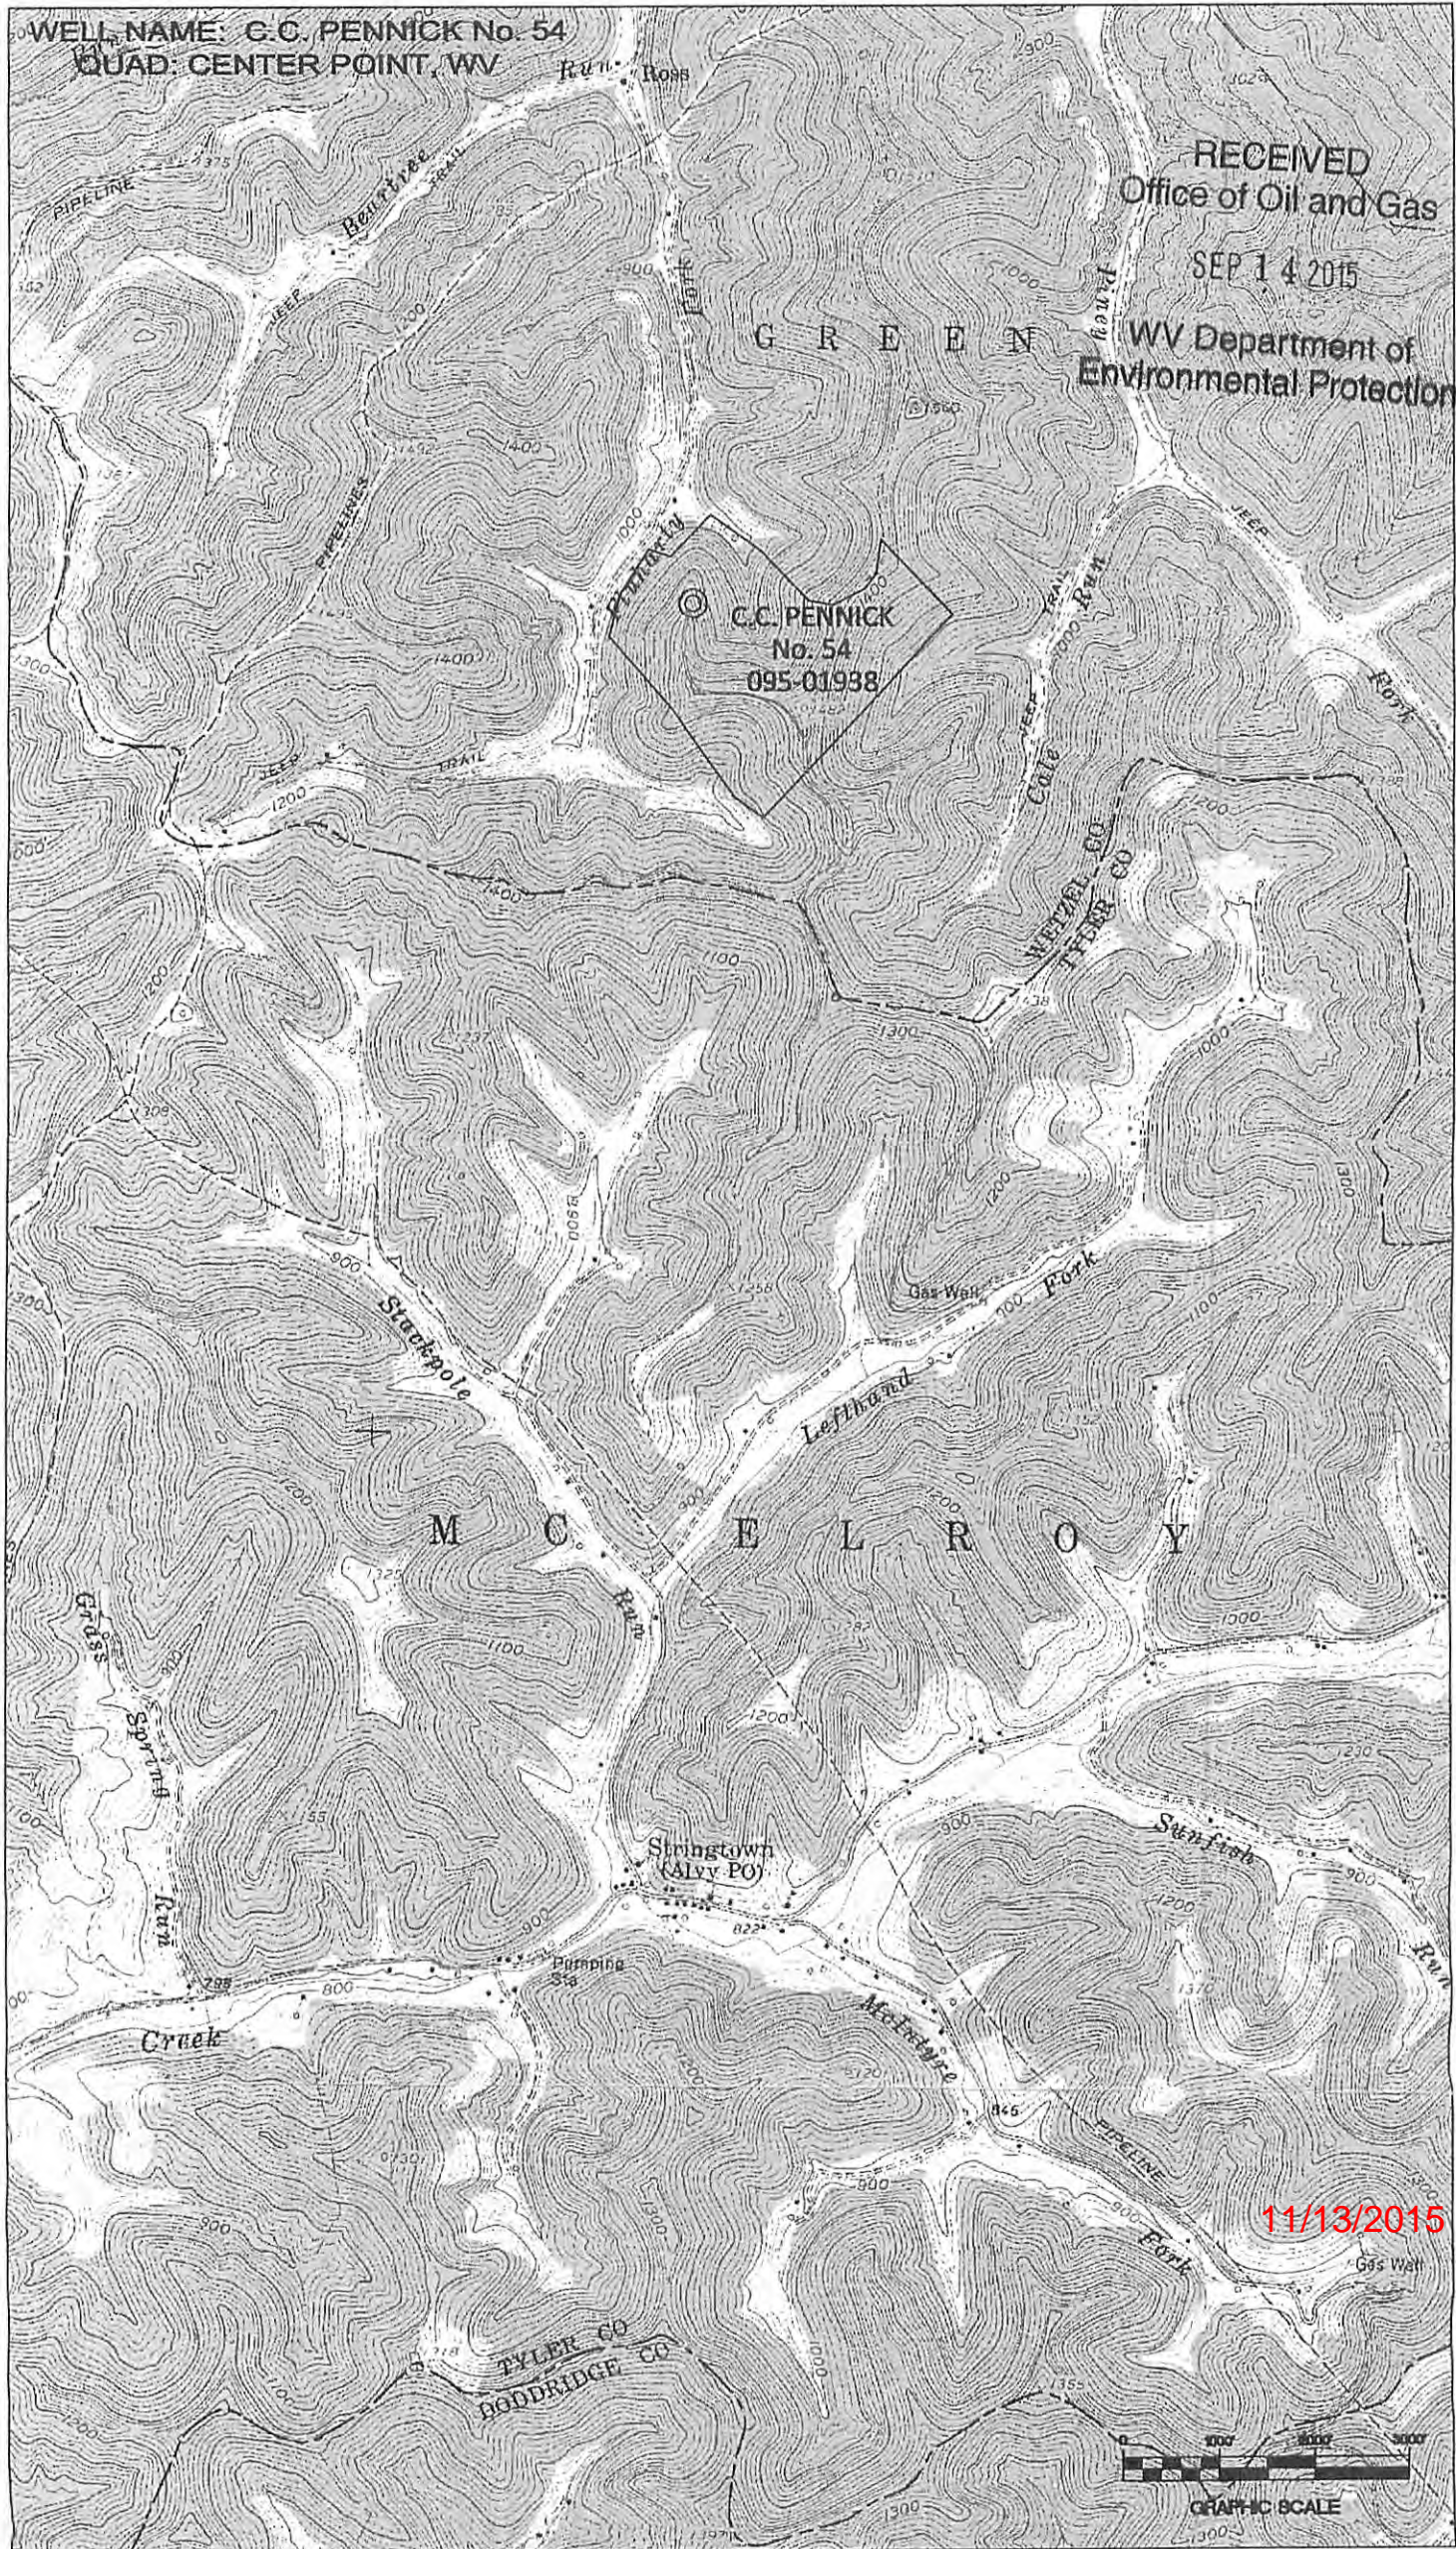

11/13/2015

