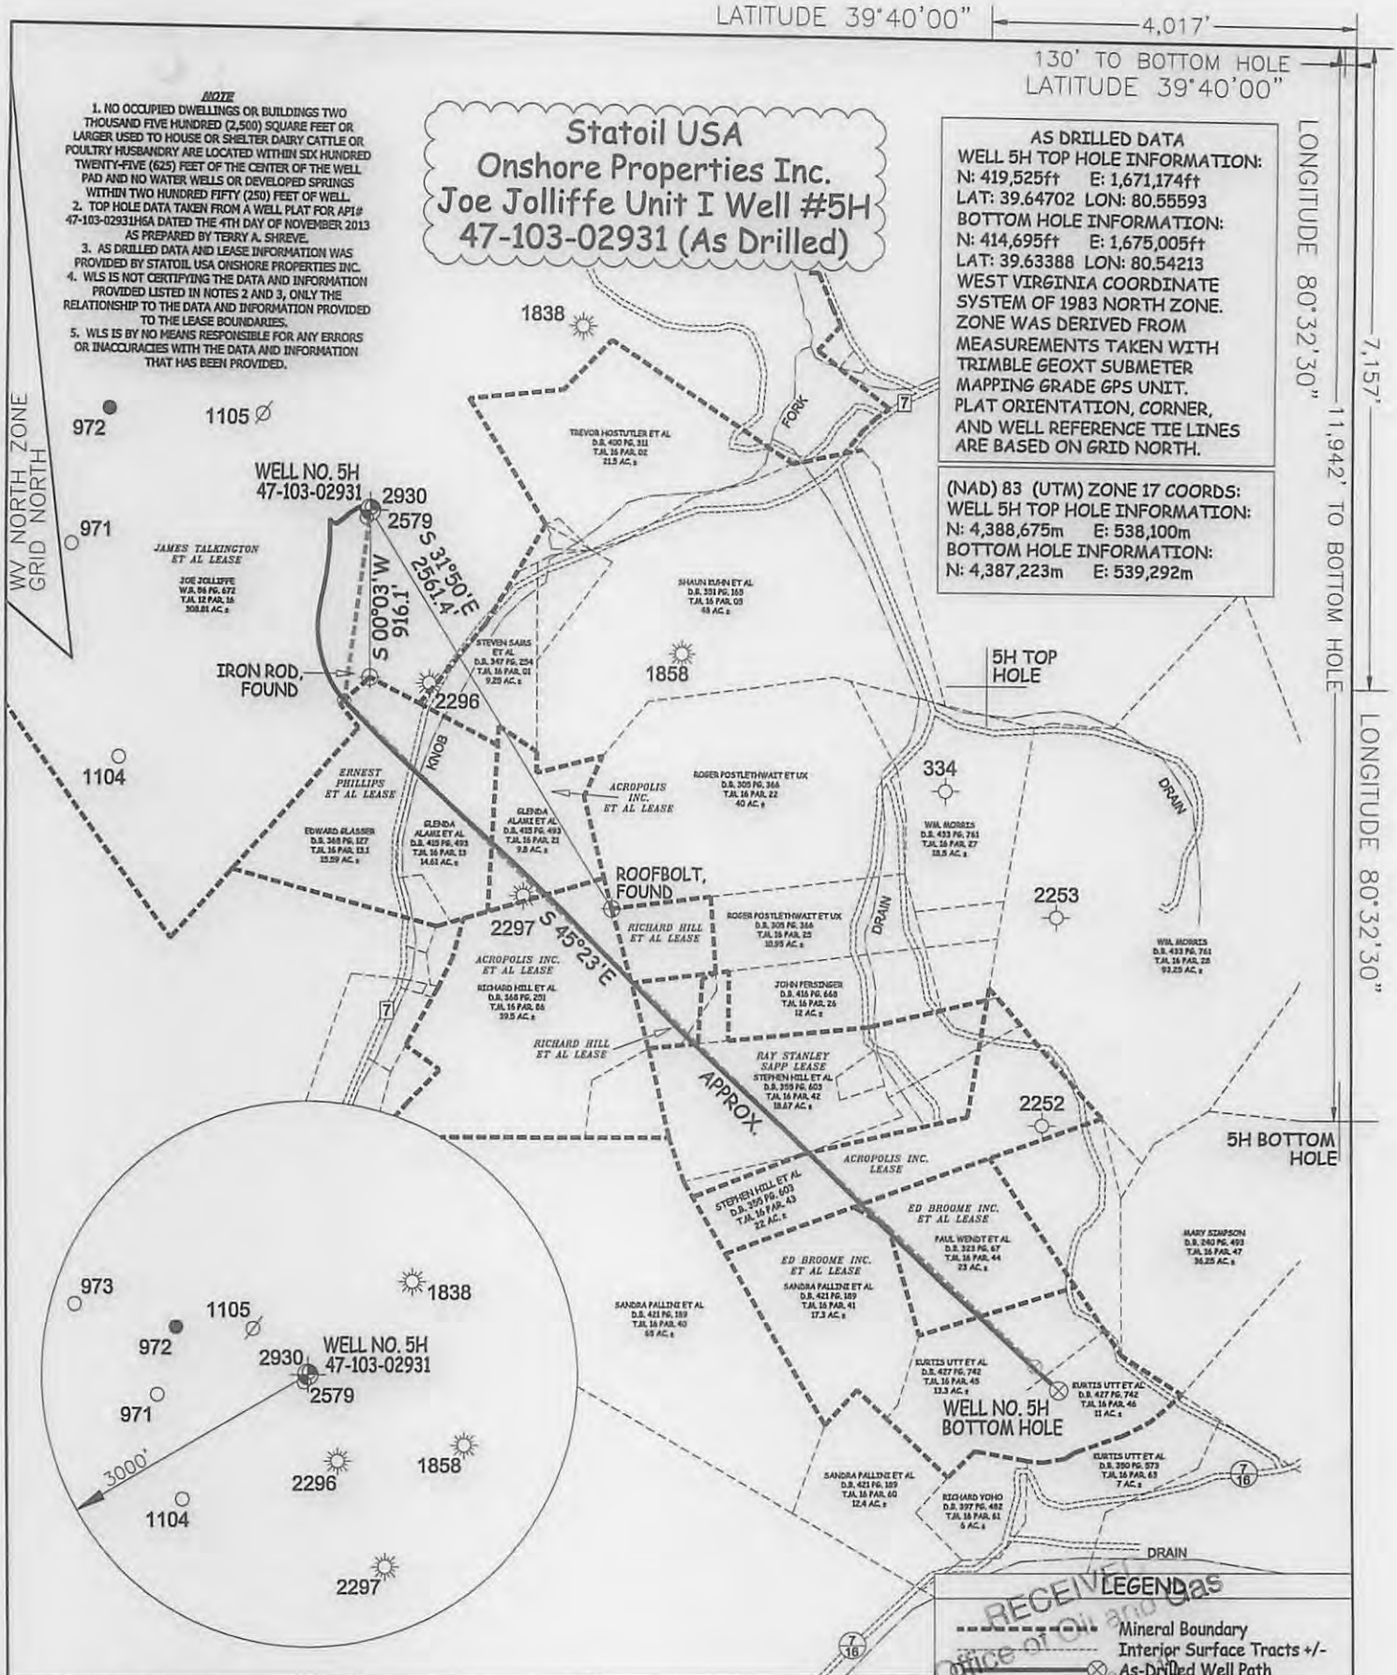

RECEIVED
Office of Oil and Gas
MAY 1 6 2015
WV Department of
Environmental Protection

JOB # 15-007WS
DRAWING # JOEJOLLIFFE5HAD
SCALE 1" = 1000'
MINIMUM DEGREE OF ACCURACY SUBMETER
PROVEN SOURCE OF ELEV. SUBMETER MAPPING GRADE GPS

STATE OF WEST VIRGINIA, DIVISION OF ENVIRONMENTAL PROTECTION, OFFICE OF OIL AND GAS

WILLOW LAND SURVEYING PLLC
P.O. BOX 17
PENNSBORO, WV 26415

DATE 03/24/15
OPERATOR'S WELL# JOE JOLLIFFE UNIT I WELL #5H

STATE OF WEST VIRGINIA
DEPARTMENT OF ENERGY
DIVISION OF OIL AND GAS

API WELL #
47 – 103 – 02931
STATE COUNTY PERMIT

WELL TYPE: OIL ___ GAS X LIQUID INJECTION ___ WASTE DISPOSAL ___
(IF "GAS") PRODUCTION X STORAGE ___ DEEP ___ SHALLOW X
LOCATION: ELEVATION 1,336' WATERSHED WEST VIRGINIA FORK FISH CREEK
QUADRANGLE LITTLETON 7.5' DISTRICT CENTER COUNTY WETZEL
SURFACE OWNER JOE B. JOLLIFFE ACREAGE 308.81 ACRES +/-
OIL & GAS ROYALTY OWNER JAMES TALKINGTON ET AL; STEVEN SAMS ET AL; LEASE ACREAGE 287 ACRES±; 9.25 ACRES±;
SHAUN KUHN ET AL; ROGER POSTLETHWAIT ET UX; ROGER POSTLETHWAIT ET UX; JOSEPHINE 48 ACRES±; 10.95 ACRES±; 12 ACRES±; 19.63 ACRES±
WOLFE ET AL; RAY STANLEY SAPP;ACROPOLIS INC.; PAUL WENDT ET UX; ACROPOLIS INC. ET AL 22 ACRES±; 22 ACRES±; 36.75 ACRES±
PROPOSED WORK: DRILL ___ CONVERT ___ DRILL DEEPER ___ REDRILL ___ FRACTURE OR STIMULATE ___
PLUG OFF OLD FORMATION ___ PERFORATE NEW FORMATION ___ OTHER PHYSICAL CHANGE IN WELL
(SPECIFY) (x) AS DRILLED PLUG & ABANDON CLEAN OUT & REPLUG
TARGET FORMATION MARCELLUS ESTIMATED DEPTH 7,521' TVD 13,670' MD

WELL OPERATOR STATOIL USA ONSHORE PROPERTIES INC. DESIGNATED AGENT WILLIAM T. FAHEY
ADDRESS 2103 CITYWEST BLVD. SUITE 800 ADDRESS 2116 PENNSYLVANIA AVE.
HOUSTON, TX 77042 WEIRTON, WV 26062

COUNTY NAME PERMIT
06/05/2015

FORM WW-6