FORM WW 6

11,440'

LATITUDE 39°32'30"

LONGITUDE 80°32'30"

5,154'

NAD '27 GRID NORTH

EQT PRODUCTION COMPANY
ROBINSON LEASE
1,100 ACRES±
WELL NO. WV 513917
(BIG192 H13)

(S.P.C. NORTH ZONE) (UTM(M) ZONE 17 NORTH)

NAD'27 S.P.C.(FT)	N. 376,081.5	E. 1,694,739.1
NAD'27 GEO.	LAT-(N) 39.527516	LONG-(W) 80.582222
NAD'83 UTM (M)	N. 4,375,410.9	E. 535,921.8
LANDING POINT		
NAD'27 S.P.C.(FT)	N. 376,125.9	E. 1,693,298.3
NAD'27 GEO.	LAT-(N) 39.527590	LONG-(W) 80.587332
NAD'83 UTM (M)	N. 4,375,417.1	E. 535,482.6
BOTTOM HOLE		
NAD'27 S.P.C.(FT)	N. 379,492.1	E. 1,692,269.2
NAD'27 GEO.	LAT-(N) 39.536797	LONG-(W) 80.591125
NAD'83 UTM (M)	N. 4,376,437.4	E. 535,152.0

LEGEND

- LEASE LINE
- SURFACE LINE
- PROPOSED PATH
- AS DRILLED PATH
- OFFSET LINE
- TIE LINE
- CREEK
- ROAD
- COUNTY ROUTE
- PROPOSED WELL
- EXISTING WELL
- TAX MAP–PARCEL 00–00

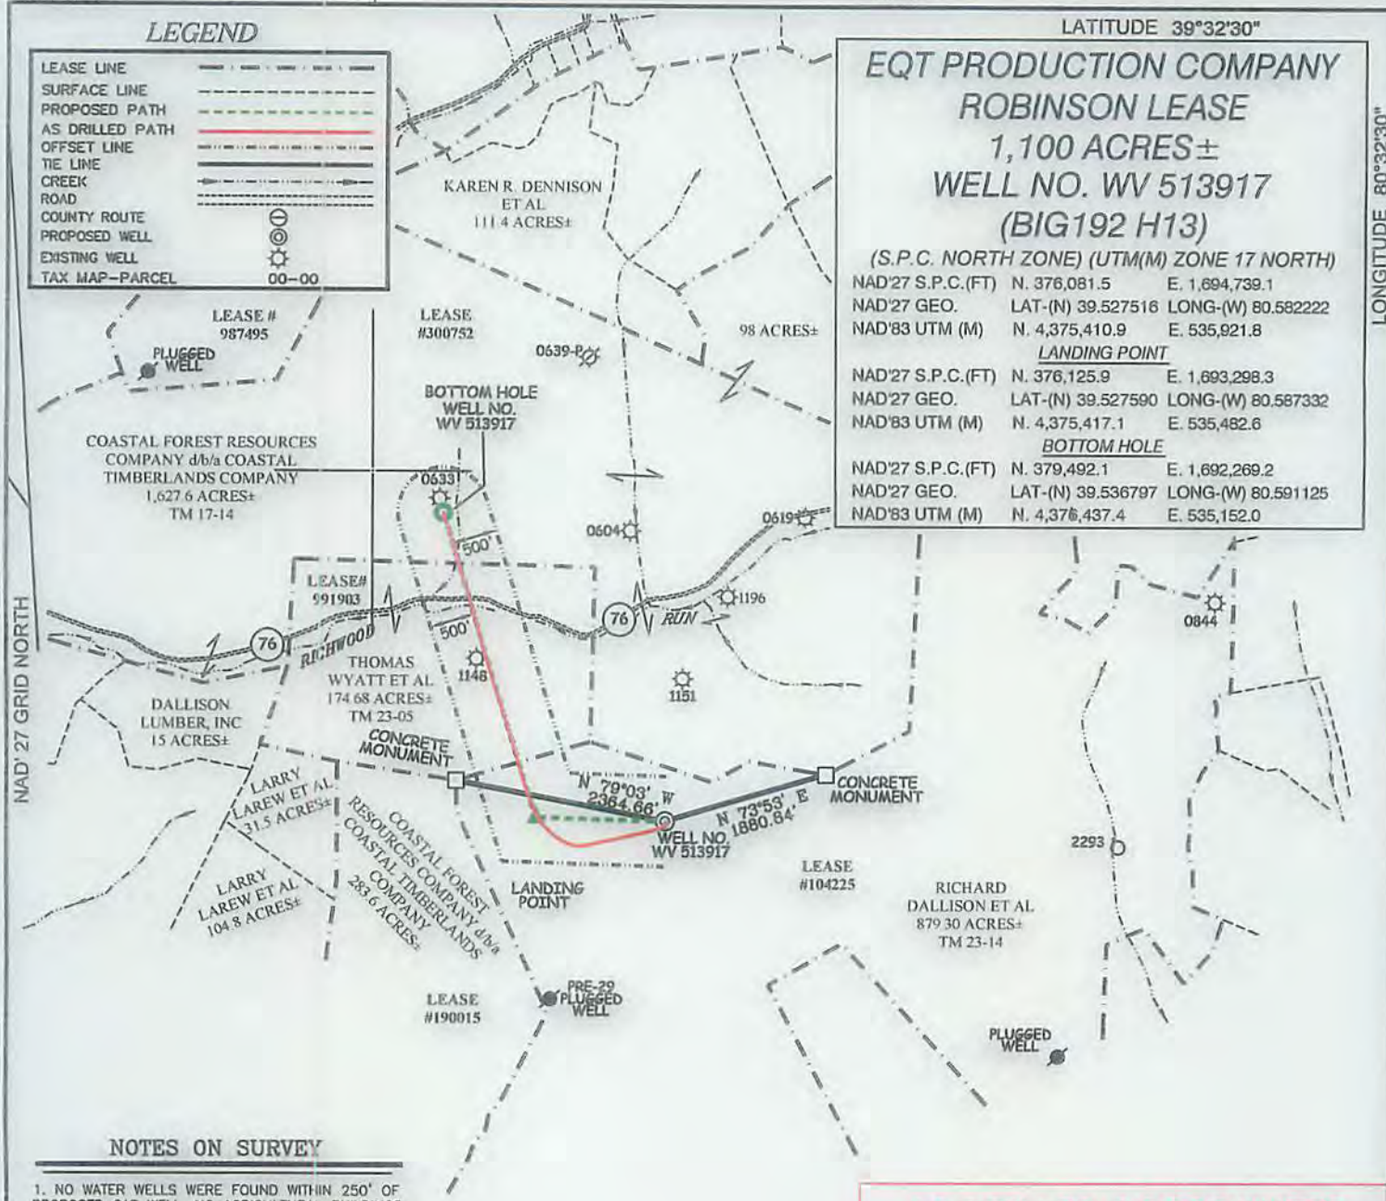

NOTES ON SURVEY

1. NO WATER WELLS WERE FOUND WITHIN 250' OF PROPOSED GAS WELL. NO AGRICULTURAL BUILDINGS ≥ 2500 SQ. FT. OR DWELLINGS WERE FOUND WITHIN 625' OF THE CENTER OF PROPOSED WELL PAD.
2. AS DRILLED INFORMATION PROVIDED BY EQT.

ROYALTY OWNERS		
GLADY WILLEY ET AL	175 AC.±	LEASE NO. 991903
MILLS WETZEL LANDS INC.	1000 AC.±	LEASE NO. 300752

AS DRILLED COORDINATES FOR WELL NO. WV 513917

(S.P.C. NORTH ZONE) (UTM(M) ZONE 17 NORTH)

NAD'27 S.P.C.(FT)	N. 376,081.5	E. 1,694,739.1
NAD'27 GEO.	LAT-(N) 39.527516	LONG-(W) 80.582222
NAD'83 UTM (M)	N. 4,375,410.9	E. 535,921.8
BOTTOM HOLE		
NAD'27 S.P.C.(FT)	N. 379,492.7	E. 1,692,270.6
NAD'27 GEO.	LAT-(N) 39.536799	LONG-(W) 80.591120
NAD'83 UTM (M)	N. 4,376,437.6	E. 535,152.4

Professional Energy Consultants
A DIVISION OF SMITH LAND SURVEYING, INC.
SLS
SURVEYORS ENGINEERS ENVIRONMENTAL PROJECT MGMT.
(304) 462-5634 WWW.SLSSURVEYS.COM

I THE UNDERSIGNED, HEREBY CERTIFY THAT THIS PLAT IS CORRECT TO THE BEST OF MY KNOWLEDGE AND BELIEF AND SHOWS ALL THE INFORMATION REQUIRED BY LAW AND THE REGULATIONS ISSUED AND PRESCRIBED BY THE DIVISION OF ENVIRONMENTAL PROTECTION.

P.S. 2288 Earl N. Thompson

EARL N. THOMPSON LICENSED No. 2288 STATE OF WEST VIRGINIA PROFESSIONAL SURVEYOR

(+) DENOTES LOCATION OF WELL ON UNITED STATES TOPOGRAPHIC MAPS.

DATE AUGUST 03 , 20 12

REVISED 09/17/12, 07/09/14, 08/05/14 & 06/22/15

OPERATORS WELL NO. WV 513917

API WELL NO. 47 — 103 — 03041H
STATE COUNTY PERMIT

MINIMUM DEGREE OF ACCURACY 1 / 200

FILE NO. 7797AD513917

SCALE 1" = 2000'

HORIZONTAL & VERTICAL CONTROL DETERMINED BY DGPS (SURVEY GRADE TIE TO CORS NETWORK)

STATE OF WEST VIRGINIA
DIVISION OF ENVIRONMENTAL PROTECTION
OFFICE OF OIL AND GAS

WELL TYPE: OIL ___ GAS X LIQUID INJECTION ___ WASTE DISPOSAL ___ IF "GAS" PRODUCTION X STORAGE ___ DEEP ___ SHALLOW X

LOCATION :

ELEVATION 1,452' (PAD ELEVATION) WATERSHED AUNTY RUN OF SOUTH FORK FISHING CREEK

DISTRICT GRANT COUNTY WETZEL QUADRANGLE BIG RUN 7.5'

SURFACE OWNER RICHARD DALLISON ET AL ACREAGE 879.30±

ROYALTY OWNER ED BROOME, INC ET AL ACREAGE 1,100± 10/16/2015

PROPOSED WORK : LEASE NO. 104225

DRILL X CONVERT ___ DRILL DEEPER ___ REDRILL ___ FRACTURE OR STIMULATE X PLUG OFF OLD FORMATION ___ PERFORATE NEW FORMATION ___ PLUG AND ABANDON ___ CLEAN OUT AND REPLUG ___ OTHER ___

PHYSICAL CHANGE IN WELL (SPECIFY) ___ TARGET FORMATION MARCELLUS

ESTIMATED DEPTH TVD 7,631'

COUNTY NAME

PERMIT

WELL OPERATOR EQT PRODUCTION COMPANY **DESIGNATED AGENT** REX C. RAY

ADDRESS 115 PROFESSIONAL PLACE P.O. BOX 280 BRIDGEPORT, WV 26330 **ADDRESS** 115 PROFESSIONAL PLACE P.O. BOX 280 BRIDGEPORT, WV 26330