


REFERENCES TO PROPOSED HORIZONTAL WELLS SURFACE LOCATIONS


(103-03099) 2H    1H (103-03098)  
 (103-03101) 4H    3H (103-03100)  
 (103-03103) 6H    5H (103-03102) (PILOT HOLE)  
 (103-03105) 8H    7H (103-03104)  
 10H    9H  
 12HU

API # & DISTANCE TO WELL	
103-00900 : N 01°02'49" E 1337'	103-02503 : N 09°51'36" W 34'
103-02133 : N 12°06'50" E 1288'	103-01771 : S 75°27'14" W 1377'
095-00781 : N 27°25'09" E 1195'	103-02214 : N 88°36'12" E 1060'
103-01162 : N 29°21'40" E 1194'	103-00860 : S 30°39'50" W 494'
103-00902 : N 32°23'25" W 819'	103-02393 : S 53°49'14" W 748'
103-30621 : N 22°42'14" E 964'	103-02505 : S 55°24'19" E 729'
103-01696 : N 62°44'47" W 741'	103-02134 : S 12°32'54" W 484'
FOUND IN FIELD : N 45°06'02" E 246'	103-02504 : S 06°34'28" W 976'
103-00781 : N 45°13'49" E 61'	103-72663 : S 13°04'57" W 1037'
103-00874 : N 71°36'23" W 769'	103-72670 : S 25°06'41" E 1067'

FILE #: TRB1  
 DRAWING #: 2890  
 SCALE: PLAT: 1" = 1800'  
 TICK: 1" = 2000'  
 MINIMUM DEGREE OF ACCURACY: 1/200  
 PROVEN SOURCE OF ELEVATION: SUBMETER MAPPING GRADE GPS

I, THE UNDERSIGNED, HEREBY CERTIFY THAT THIS PLAT IS CORRECT TO THE BEST OF MY KNOWLEDGE AND BELIEF AND SHOWS ALL THE INFORMATION REQUIRED BY LAW AND THE REGULATIONS ISSUED AND PRESCRIBED BY THE DEPARTMENT OF ENVIRONMENTAL PROTECTION.

Signed:   
 L.L.S. #2124 : Ernest J. Benchek III

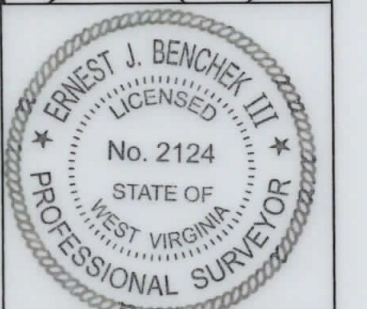

(+) DENOTES LOCATION OF WELL ON UNITED STATES TOPOGRAPHIC MAPS WYDEP

OFFICE OF OIL & GAS  
 601 57TH STREET  
 CHARLESTON, WV 25304

Well Type:  Oil  Waste Diposal  Production  Deep  
 Gas  Liquid Injection  Storage  Shallow

WATERSHED: FISHING CREEK AS-BUILT ELEVATION: 1,286.8'  
 COUNTY/DISTRICT: WETZEL / GREEN QUADRANGLE: CENTER POINT, WV - BOTTOM HOLE  
 SURFACE OWNER: COASTAL LUMBER COMPANY ACREAGE: 154.51 +/-  
 OIL & GAS ROYALTY OWNER: CHARLES W. MCCOY JR ET AL ACREAGE: 793.515 +/-  
 LEASE NUMBERS:

DRILL  CONVERT  DRILL DEEPER  REDRILL  FRACTURE OR STIMULATE   
 PLUG OFF FORMATION  PERFORATE NEW FORMATION  PLUG & ABANDON   
 CLEAN OUT & REPLUG  OTHER CHANGE  (SPECIFY):

TARGET FORMATION: MARCELLUS ESTIMATED DEPTH: TMD: 17,708' TVD: 7,339'  
 WELL OPERATOR: TRIBUNE RESOURCES, LLC DESIGNATED AGENT: HARMAN BROWN  
 ADDRESS: 3861 AMBASSADOR CAFFERY PARKWAY SUITE 600 ADDRESS: 18396 MOUNTAINEER HIGHWAY  
 CITY: LAFAYETTE STATE: LA ZIP CODE: 70503 CITY: WILEYVILLE STATE: WV ZIP CODE: 26581