



---

west virginia department of environmental protection

---

Office of Oil and Gas  
601 57<sup>th</sup> Street, S.E.  
Charleston, WV 25304  
(304) 926-0450  
fax: (304) 926-0452

Jim Justice , Governor  
Austin Caperton , Cabinet Secretary  
www.dep.wv.gov

Friday, July 21, 2017  
WELL WORK PERMIT  
Horizontal 6A / New Drill

SWN PRODUCTION COMPANY, LLC  
POST OFFICE BOX 12359

SPRING, TX 773914954

Re: Permit approval for DANIEL DURIG WTZ 201H  
47-103-03187-00-00

This well work permit is evidence of permission granted to perform the specified well work at the location described on the attached pages and located on the attached plat, subject to the provisions of Chapter 22 of the West Virginia Code of 1931, as amended, and all rules and regulations promulgated thereunder, and to any additional specific conditions and provisions outlined in the pages attached hereto. Notification shall be given by the operator to the Oil and Gas Inspector at least 24 hours prior to the construction of roads, locations, and/or pits for any permitted work. In addition, the well operator shall notify the same inspector 24 hours before any actual well work is commenced and prior to running and cementing casing. Spills or emergency discharges must be promptly reported by the operator to 1-800-642-3074 and to the Oil and Gas Inspector.

Please be advised that form WR-35, Well Operators Report of Well Work is to be submitted to this office within 90 days of completion of permitted well work, as should form WR-34 Discharge Monitoring Report within 30 days of discharge of pits, if applicable. Failure to abide by all statutory and regulatory provisions governing all duties and operations hereunder may result in suspension or revocation of this permit and, in addition, may result in civil and/or criminal penalties being imposed upon the operators.

Per 35 CSR 4-5.2.g this permit will expire in two (2) years from the issue date unless permitted well work is commenced. If there are any questions, please feel free to contact me at (304) 926- 0450.



James A. Martin  
Chief

Operator's Well Number: DANIEL DURIG WTZ 201H  
Farm Name: DANIEL DURIG (REMAINDERMAN), ARTHUR DURIG & SHIP  
U.S. WELL NUMBER: 47-103-03187-00-00  
Horizontal 6A / New Drill  
Date Issued: 7/21/2017

Promoting a healthy environment.

07/21/2017

# PERMIT CONDITIONS

West Virginia Code § 22-6A-8(d) allows the Office of Oil and Gas to place specific conditions upon this permit. Permit conditions have the same effect as law. Failure to adhere to the specified permit conditions may result in enforcement action.

## CONDITIONS

---

1. This proposed activity may require permit coverage from the United States Army Corps of Engineers (USACE). Through this permit, you are hereby being advised to consult with USACE regarding this proposed activity.
2. If the operator encounters an unanticipated void, or an anticipated void at an unanticipated depth, the operator shall notify the inspector within 24 hours. Modifications to the casing program may be necessary to comply with W. Va. Code § 22-6A-5a (12), which requires drilling to a minimum depth of thirty feet below the bottom of the void, and installing a minimum of twenty (20) feet of casing. Under no circumstance should the operator drill more than one hundred (100) feet below the bottom of the void or install less than twenty (20) feet of casing below the bottom of the void.
3. When compacting fills, each lift before compaction shall not be more than 12 inches in height, and the moisture content of the fill material shall be within limits as determined by the Standard Proctor Density test of the actual soils used in specific engineered fill, ASTM D698, Standard Test Method for Laboratory Compaction Characteristics of Soil Using Standard Effort, to achieve 95 % compaction of the optimum density. Each lift shall be tested for compaction, with a minimum of two tests per lift per acre of fill. All test results shall be maintained on site and available for review.
4. Operator shall install signage per § 22-6A-8g (6) (B) at all source water locations included in their approved water management plan within 24 hours of water management plan activation.
5. Oil and gas water supply wells will be registered with the Office of Oil and Gas and all such wells will be constructed and plugged in accordance with the standards of the Bureau for Public Health set forth in its Legislative rule entitled *Water Well Regulations*, 64 C.S.R. 19. Operator is to contact the Bureau of Public Health regarding permit requirements. In lieu of plugging, the operator may transfer the well to the surface owner upon agreement of the parties. All drinking water wells within fifteen hundred feet of the water supply well shall be flow tested by the operator upon request of the drinking well owner prior to operating the water supply well.
6. Pursuant to the requirements pertaining to the sampling of domestic water supply wells/springs the operator shall, no later than thirty (30) days after receipt of analytical data provide a written copy to the Chief and any of the users who may have requested such analyses.
7. 24 hours prior to the initiation of the completion process the operator shall notify the Chief or his designee.
8. During the completion process the operator shall monitor annular pressures and report any anomaly noticed to the chief or his designee immediately.
9. If any explosion or other accident causing loss of life or serious personal injury occurs in or about a well or well work on a well, the well operator or its contractor shall give notice, stating the particulars of the explosion or accident, to the oil and gas inspector and the Chief, within 24 hours of said accident.
10. During the casing and cementing process, in the event cement does not return to the surface, the oil and gas inspector shall be notified within 24 hours.

# PERMIT CONDITIONS

17 10305137

11. The operator shall provide to the Office of Oil and Gas the dates of each of the following within 30 days of their occurrence: completion of construction of the well pad, commencement of drilling, cessation of drilling, completion of any other permitted well work, and completion of the well. Such notice shall be provided by sending an email to [DEPOOGNotify@wv.gov](mailto:DEPOOGNotify@wv.gov).

STATE OF WEST VIRGINIA  
DEPARTMENT OF ENVIRONMENTAL PROTECTION, OFFICE OF OIL AND GAS  
WELL WORK PERMIT APPLICATION

1) Well Operator: SWN Production Co., LLC 494512924 103- Wetzel 12-Proctor 681-Wileyville  
Operator ID County District Quadrangle

2) Operator's Well Number: Daniel Durig WTZ 201H Well Pad Name: Daniel Durig WTZ Pad

3) Farm Name/Surface Owner: Daniel Durig Public Road Access: Macedonia Ridge Road

4) Elevation, current ground: 1400.9' Elevation, proposed post-construction: 1400.9'

5) Well Type (a) Gas  Oil \_\_\_\_\_ Underground Storage \_\_\_\_\_

Other \_\_\_\_\_

(b) If Gas Shallow  Deep \_\_\_\_\_

Horizontal

6) Existing Pad: Yes or No yes

*DmH*  
*3-1-17*

7) Proposed Target Formation(s), Depth(s), Anticipated Thickness and Expected Pressure(s): \_\_\_\_\_

Target Formation- Marcellus, Target Top TVD- 7221, Target Base TVD-7258', Anticipated Thickness- 37', Associated Pressure- 4720

8) Proposed Total Vertical Depth: 7233' at the heel

9) Formation at Total Vertical Depth: Marcellus

10) Proposed Total Measured Depth: 11603'

11) Proposed Horizontal Leg Length: 3916.00'

12) Approximate Fresh Water Strata Depths: 427'

13) Method to Determine Fresh Water Depths: Salinity Profile

14) Approximate Saltwater Depths: 1664'

15) Approximate Coal Seam Depths: 1155'

16) Approximate Depth to Possible Void (coal mine, karst, other): none that we are aware of.

17) Does Proposed well location contain coal seams directly overlying or adjacent to an active mine? Yes \_\_\_\_\_ No

(a) If Yes, provide Mine Info: Name: \_\_\_\_\_  
Depth: \_\_\_\_\_  
Seam: \_\_\_\_\_  
Owner: \_\_\_\_\_


RECEIVED  
Office of Oil and Gas

MAY 23 2017

WV Department of  
Environmental Protection

18)

**CASING AND TUBING PROGRAM**

TYPE	Size (in)	New or Used	Grade	Weight per ft. (lb/ft)	FOOTAGE: For Drilling (ft)	INTERVALS: Left in Well (ft)	CEMENT: Fill-up (Cu. Ft.)/CTS
Conductor	20"	New	H-40	94#	100'	100'	CTS
Fresh Water	13 3/8"	New	H-40	54.5#	527'	527'	502 sx/CTS
Coal	9 5/8"	New	J-55	40#	2691'	2691'	1036 sx/CTS
Intermediate	7"	New	HCP-110	20#	If Needed	If Needed	If Needed/As Needed
Production	5 1/2"	New	HCP-110	20#	11603'	11603'	Lead 847sx tail 1139sx/100' inside int. 
Tubing	2 3/8"	New	HCP-110	4.7#	Approx. 7233'	Approx. 7233'	
Liners							

*DmH  
3-1-17*

TYPE	Size (in)	Wellbore Diameter (in)	Wall Thickness (in)	Burst Pressure (psi)	Anticipated Max. Internal Pressure (psi)	Cement Type	Cement Yield (cu. ft./k)
Conductor	20"	30"	0.25	2120	0.020	Class A	1.19/50% Excess
Fresh Water	13 3/8"	17.5"	0.380	2740	0.020	Class A	1.19/50% Excess
Coal	9 5/8"	12 1/4"	0.395	3950	0.020	Class A	1.19/50% Excess
Intermediate	7"	8 3/4"	0.317	4360	0.020	Class A	1.20/15% Excess
Production	5 1/2"	8 3/4"	0.361	12360	0.020	Class A	1.20/15% Excess
Tubing	2 3/8"	4.778"	0.190				
Liners							

**PACKERS**

Kind:				
Sizes:				
Depths Set:				

RECEIVED  
Office of Oil and Gas

MAY 23 2017

WV Department of  
Environmental Protection

19) Describe proposed well work, including the drilling and plugging back of any pilot hole:

Drill and stimulate any potential zones between and including the Benson to Marcellus. \*\*If we should encounter a void place basket above and below void area- balance cement to bottom of void and grout from basket to surface. Run casing not less than 20' below void nor more than 50' below void. (\*If freshwater is encountered deeper than anticipated it must be protected, set casing 50' below and cts.)

*Durig  
3-1-17*

20) Describe fracturing/stimulating methods in detail, including anticipated max pressure and max rate:

Well will be perforated within the target formation and stimulated with a slurry of water, sand, and chemical additives at a high rate. This will be performed in stages with the plug and perf method along the wellbore until the entire lateral has been stimulated within the target formation. All stage plugs are then drilled out and the well is flowed back to surface. The well is produced through surface facilities consisting of high pressure production units, vertical separation units, water and oil storage tanks. Max press and anticipated max rate- 9000 lbs @ 80 barrels a minute.

21) Total Area to be disturbed, including roads, stockpile area, pits, etc., (acres): 8.1

22) Area to be disturbed for well pad only, less access road (acres): 3.9

23) Describe centralizer placement for each casing string:

All casing strings will be ran with a centralizer at a minimum of 1 per every 3 joints of casing.

24) Describe all cement additives associated with each cement type:

See Attachment \*\*\*

25) Proposed borehole conditioning procedures:

All boreholes will be conditioned with circulation and rotation for a minimum of one bottoms up and continuing until operator is satisfied with borehole conditions.

RECEIVED  
Office of Oil and Gas

MAY 23 2017

\*Note: Attach additional sheets as needed.



### Schlumberger Cement Additives

	Product Name	Product Use	Chemical Name	CAS Number
Surface	S001	accelerator	calcium chloride	10043-52-4
Intermediate	S001	accelerator	calcium chloride	10043-52-4
Kick Off Plug	D080	dispersant	sodium polynaphthalene sulfonate	9008-63-3
	D801	retarder	aromatic polymer derivative	proprietary
	D047	antifoam	polypropylene glycol	25322-69-4
Production-Lead	D167	fluid loss	aliphatic amide polymer	proprietary
	D154	extender	non-crystalline silica	7631-86-9
	D400	gas migration	boric acid	10043-35-3
	D046	antifoam	polypropylene glycol	25322-69-4
			fullers earth (attapulgate)	8031-18-3
	D201	retarder	chrySTALLINE silica	14808-60-7
			metal oxide	proprietary
D202	dispersant	sulphonated synthetic polymer	proprietary	
		formaldehyde (impurity)	proprietary	
Production-Tail	D046	antifoam	polypropylene glycol	25322-69-4
			fullers earth (attapulgate)	8031-18-3
	D167	fluid loss	aliphatic amide polymer	proprietary
	D065	dispersant	sodium polynaphthalene sulfonate	9008-63-3
			sodium sulfates	7757-82-6
	D201	retarder	chrySTALLINE silica	14808-60-7
			metal oxide	proprietary
D153	anti-settling	chrySTALLINE silica	14808-60-7	

DMH  
2/1/17

4710311-805

RECEIVED  
Office of Oil and Gas

**MAY 23 2017**

WV Department of  
Environmental Protection




MAY 23 2017

WV Department of  
Environmental Protection

Southwestern Energy Company

Proposed Drilling Program

Well: DANIEL DURIG WTZ 201 Re-entry Rig: TBD  
 Field: VICTORY FIELD Prospect: VICTORY  
 County: WETZEL State: WV  
 SHL: 39.7168 Latitude -80.6392 Longitude  
 BHL: 39.7226 Latitude -80.6520 Longitude  
 KB Elev: 1,427 ft MSL KB: 26 ft AGL GL Elev: 1,401 ft MSL

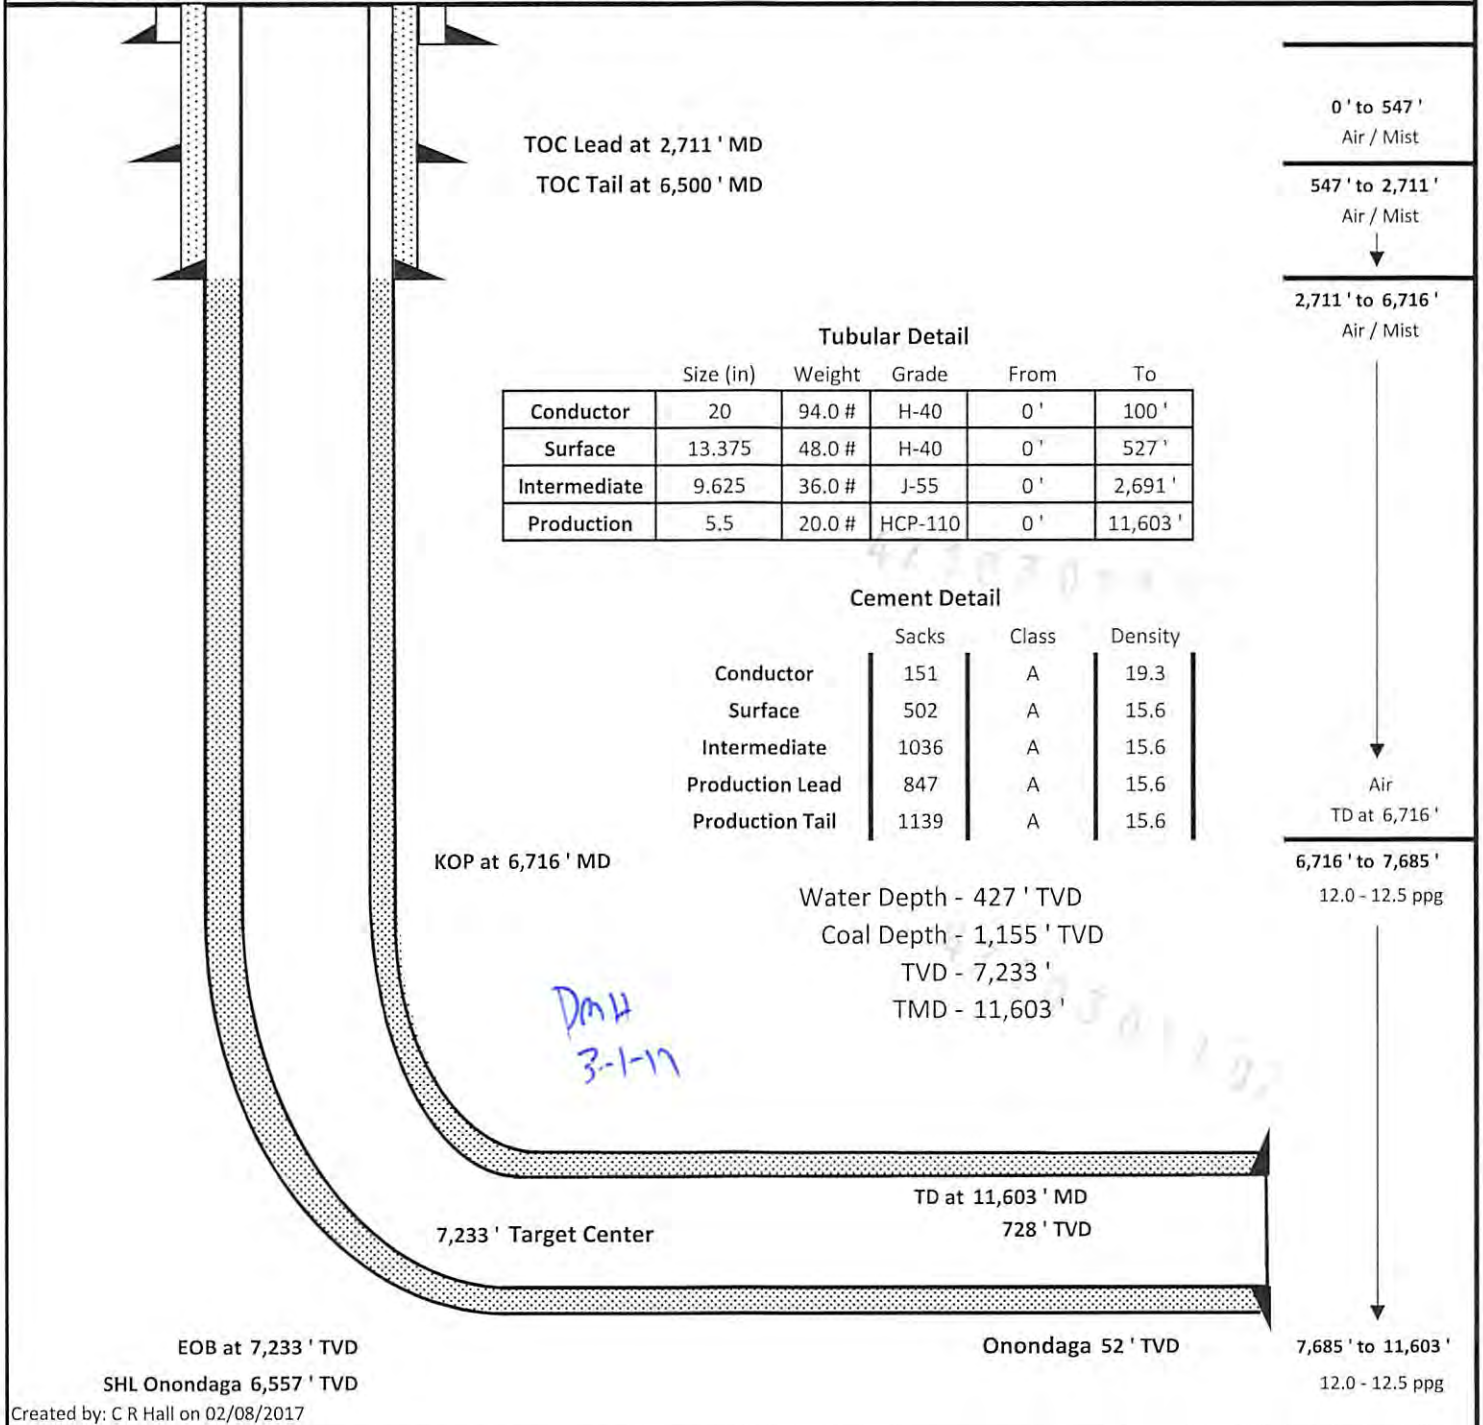

Created by: C R Hall on 02/08/2017

07/21/2017

WW-9  
(4/16)

MAY 23 2017

API Number 47 - 103 - \_\_\_\_\_  
Operator's Well No. Daniel Durig WTZ 201H

WV Department of  
Environmental Protection

STATE OF WEST VIRGINIA  
DEPARTMENT OF ENVIRONMENTAL PROTECTION  
OFFICE OF OIL AND GAS

FLUIDS/ CUTTINGS DISPOSAL & RECLAMATION PLAN

Operator Name SWN Production Company, LLC OP Code 494512924

Watershed (HUC 10) Laurel Run Quadrangle Wileyville

Do you anticipate using more than 5,000 bbls of water to complete the proposed well work? Yes  No

Will a pit be used? Yes  No

If so, please describe anticipated pit waste: closed loop system in place at this time- cuttings will be taken to a permitted landfill

Will a synthetic liner be used in the pit? Yes  No  If so, what ml.?

Proposed Disposal Method For Treated Pit Wastes:

- Land Application
- Underground Injection ( UIC Permit Number \_\_\_\_\_ )
- Reuse (at API Number \_\_\_\_\_ at next anticipated well, API # will be included with the WR-34/DDMR &/or permit addendum )
- Off Site Disposal (Supply form WW-9 for disposal location)
- Other (Explain flow back fluids will be put in steel tanks and reused or taken to a permitted disposal facility)

*Dmit  
3-1-17*

Will closed loop system be used? If so, describe: yes

Drilling medium anticipated for this well (vertical and horizontal)? Air, freshwater, oil based, etc. at drill to KOP, fluid drill with SOBM from KOP to TD

-If oil based, what type? Synthetic, petroleum, etc. synthetic oil base

Additives to be used in drilling medium? see attached sheets

Drill cuttings disposal method? Leave in pit, landfill, removed offsite, etc. landfill

-If left in pit and plan to solidify what medium will be used? (cement, lime, sawdust)

-Landfill or offsite name/permit number? meadow SWF-1032, SS grading SWF-4902, Northwestern SWF-1025, Short Creek 1034/WW0109517/CID28726, Carbon Limestone 28726-CID28726

Arden Landfill 10072, American 02-12954, Country Wide 38390/CID38390, Pine Grove 13688  
Permittee shall provide written notice to the Office of Oil and Gas of any load of drill cuttings or associated waste rejected at any West Virginia solid waste facility. The notice shall be provided within 24 hours of rejection and the permittee shall also disclose where it was properly disposed.

I certify that I understand and agree to the terms and conditions of the GENERAL WATER POLLUTION PERMIT issued on August 1, 2005, by the Office of Oil and Gas of the West Virginia Department of Environmental Protection. I understand that the provisions of the permit are enforceable by law. Violations of any term or condition of the general permit and/or other applicable law or regulation can lead to enforcement action.

I certify under penalty of law that I have personally examined and am familiar with the information submitted on this application form and all attachments thereto and that, based on my inquiry of those individuals immediately responsible for obtaining the information, I believe that the information is true, accurate, and complete. I am aware that there are significant penalties for submitting false information, including the possibility of fine or imprisonment.

Company Official Signature [Signature]

Company Official (Typed Name) Dee Southall

Company Official Title Regulatory Supervisor

Subscribed and sworn before me this 8th day of February, 2017

Brittany R Woody  
My commission expires 11/27/2017

Notary Public



07/21/2017

SWN Production Company, LLC

Proposed Revegetation Treatment: Acres Disturbed 8.1 Prevegetation pH \_\_\_\_\_

Lime as determined by pH test min. 2 Tons/acre or to correct to pH 3.9

Fertilizer type 10-20-20

Fertilizer amount 600 lbs/acre

Mulch Hay/Straw 2.5 Tons/acre

RECEIVED  
Office of Oil and Gas

MAY 23 2017

WV Department of  
Environmental Protection

Seed Mixtures

**Temporary**

**Permanent**

Seed Type lbs/acre

Seed Type lbs/acre

**\*\*See Attachment**

Attach:

Maps(s) of road, location, pit and proposed area for land application (unless engineered plans including this info have been provided). If water from the pit will be land applied, include dimensions (L x W x D) of the pit, and dimensions (L x W), and area in acreage, of the land application area.

Photocopied section of involved 7.5' topographic sheet.

Plan Approved by: 

Comments:

927030

Title: oil and gas inspector Date: 3-1-17

Field Reviewed? (  ) Yes (  ) No

## Drilling Mediums

Synthetic Oil

Brine

Barite

Calcium Chloride

Lime

Organophilic Bentonite

Primary and Secondary Emulsifiers

Gilsonite

Calcium Carbonate

Friction Reducers

RECEIVED  
Office of Oil and Gas

MAY 23 2017

WV Department of  
Environmental Protection

07/21/2017



# WVD Seeding Specification



To Order Seed contact Lyndsi Eddy Flippo office 570-996-4271 cell 501-269-5451 lyndsi\_eddy@swn.com (please allow 7 to 10 days for delivery)

NON-ORGANIC PROPERTIES		
Seed Mixture: ROW Mix	SWN Supplied	
Orchardgrass	40%	
Timothy	15%	
Annual Ryegrass	15%	
Brown Top Millet	5%	
Red Top	5%	
Medium Red Clover	5%	All legumes are innoculated at 5x normal rate
White Clover	5%	
Birdsfoot Trefoil	5%	
Rough Bluegrass	5%	
<p>Apply @ 100lbs per acre April 16th- Oct. 14th</p>		<p>Apply @ 200lbs per acre Oct. 15th- April 15th PLUS 50lbs per acre of Winter Wheat</p>

SOIL AMENDMENTS	
10-20-20 Fertilizer	*Apply @ 500lbs per Acre
Pelletized Lime	Apply @ 2 Tons per Acre
*unless otherwise dictated by soil test results	

Seeding Calculation Information:
1452' of 30' ROW/LOD is One Acre
871' of 50' ROW/LOD is One Acre
622' of 70' ROW/LOD is One Acre

**Synopsis:**  
Every 622 linear feet in a 70' ROW/LOD, you should be using (2) 50lb bags of seed, (4) 50lb bags of fertilizer and (80) 50lb bags of Lime (2x seed in winter months + 50lb Winter Wheat/ac).

**Special Considerations:**  
Landowner Special Considerations including CREP program participants require additional guidance that is not given here. Discuss these requirements with SWN supervision at the beginning of the project to allow time for special seed delivery.

ORGANIC PROPERTIES	
Seed Mixture: SWN Production Organic Mix	SWN Supplied
Organic Timothy	50%
Organic Red or White Clover	50%
OR	
Organic Perennial Ryegrass	50%
Organic Red or White Clover	50%
<p>Apply @ 100lbs per acre April 16th- Oct. 14th</p>	
<p>Organic Fertilizer @ 200lbs per Acre</p>	
<p>Apply @ 200lbs per acre Oct. 15th- April 15th</p>	
<p>Pelletized Lime @ 2 Tons per Acre</p>	

WETLANDS (delineated as jurisdictional wetlands)	
Seed Mixture: Wetland Mix	SWN Supplied
VA Wild Ryegrass	20%
Annual Ryegrass	20%
Fowl Bluegrass	20%
Cosmos 'Sensation'	10%
Redtop	5%
Golden Tickseed	5%
Maryland Senna	5%
Showy Tickseed	5%
Fox Sedge	2.5%
Soft Rush	2.5%
Woolgrass	2.5%
Swamp Verbena	2.5%
<p>Apply @ 25lbs per acre April 16th- Oct. 14th</p>	
<p>Apply @ 50lbs per acre Oct. 15th- April 15th</p>	
<p>NO FERTILIZER OR LIME INSIDE WETLAND LIMITS</p>	

WV 10803101

RECEIVED  
 Office of Oil and Gas  
 MAY 23 2017  
 WV Department of  
 Environmental Protection

# MARCELLUS WELL DRILLING PROCEDURES AND WELL SITE SAFETY PLAN



SWN Production Company, LLC  
179 Innovation Drive  
Jane Lew, West Virginia 26378

**API NO. 47-XXX-XXXXX**  
**WELL NAME: Daniel Durig WTZ 201H**  
**Wileyville QUAD**  
**Proctor DISTRICT**  
**Wetzel COUNTY, WEST VIRGINIA**

Submitted by:

  
Dee Southall

Date: 2/8/2017

Title: Regulatory Supervisor

SWN Production Co., LLC

Approved by:

  
Title: Oil & Gas Inspector

Date: 3-1-17

Approved by:

\_\_\_\_\_  
Title: \_\_\_\_\_

Date: \_\_\_\_\_

SWN PRODUCTION COMPANY, LLC

RECEIVED  
Office of Oil and Gas

MAY 23 2017

WV Department of  
Environmental Protection

07/21/2017

Latitude: 39°45'00"

SURFACE HOLE 3995'

BOTTOM HOLE 9439'

JACKSON SURVEYING INC.




P.O. Box 1460
677 W. Main St.
Clarksburg, WV 26302
304-623-5851

Table with 2 columns: Location Type (SHL, LPL, BHL) and UTM Coordinates (NORTHING, EASTING).

GRID NORTH
UTM, NAD83 DATUM, ZONE 17, US FT

WELL BORE TABLE FOR SURFACE / ROYALTY OWNERS. Table with 4 columns: TRACT, SURFACE OWNER (S) / ROYALTY OWNER (R), TAX PARCEL, ACRES.

Table with 5 columns: LINE, BEARING, DISTANCE, DESCRIPTION, MONUMENT. Includes curve length and description for line L3.

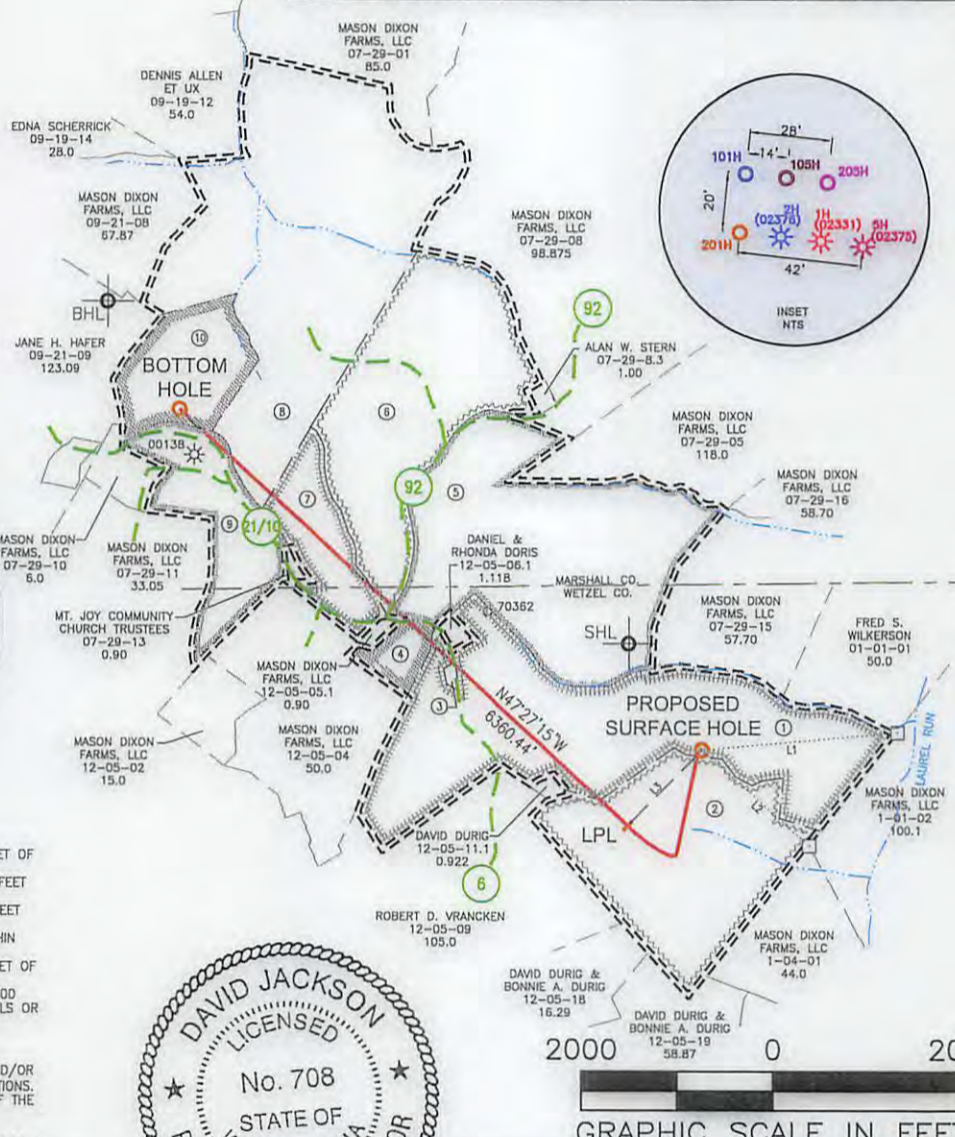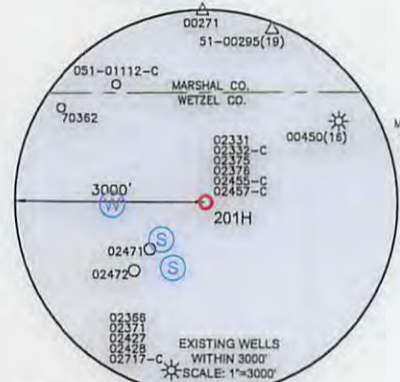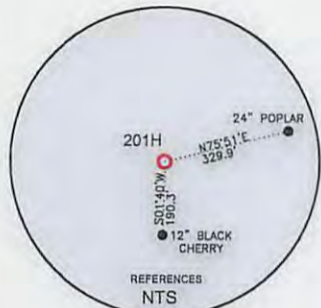

BOTTOM HOLE 8545'

SURFACE HOLE 12086'


Longitude: 80°37'30"

WELL RESTRICTIONS

- List of 6 well restrictions regarding dwellings, agriculture, water wells, streams, trout streams, and ground intake.

NOTES ON SURVEY

- Notes on survey including boundary information, disclaimer, and certification by the surveyor.

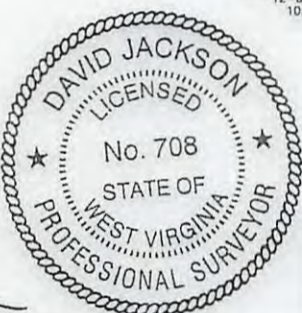

P.S. 708

Signature of David L. Jackson

COMPANY: SWN Production Company, LLC

State of West Virginia logo and WVDEP Office of Oil & Gas address: 601 57th Street, Charleston, WV 25034.

MINIMUM DEGREE OF ACCURACY: 1/200
PROVEN SURVEY SOURCE OF GRADE GPS ELEVATION: (NAVD 88, US FT)

DANIEL DURIG WTZ
OPERATOR'S WELL #: 201H
API WELL #: 47 103 03187 H64

WELL TYPE: OIL [ ] WASTE DISPOSAL [ ] PRODUCTION [X] DEEP [ ] GAS [X] LIQUID INJECTION [ ] STORAGE [ ] SHALLOW [X]
WATERSHED: LAUREL RUN - (HUC-10 FISH CREEK) ELEVATION: 1400.9'
DISTRICT: PROCTOR COUNTY: WETZEL QUADRANGLE: WILEYVILLE, WV
SURFACE OWNER: DANIEL DURIG (REMAINDERMAN), ARTHUR DURIG & SHIRLEY ANN DURIG (LE) ACREAGE: ±151.58
OIL & GAS ROYALTY OWNER: O.C. YOHO AND MARY YOHO (ARTHUR T. DURIG AND SHIRLEY ANN DURIG (LIFE ESTATE), DANIEL DURIG (REMAINDERMAN) ACREAGE: ±151.58
DRILL [X] DRILL DEEPER [ ] REDRILL [ ] FRACTURE OR STIMULATE [X] PLUG OFF OLD FORMATION [ ] PERFORATE NEW FORMATION [X]
CONVERT [ ] PLUG & ABANDON [ ] CLEAN OUT & REPLUG [ ] OTHER CHANGE [ ] (SPECIFY)
TARGET FORMATION: MARCELLUS ESTIMATED DEPTH: 7,232 TVD 14,071 TMD


WELL OPERATOR: SWN PRODUCTION COMPANY, LLC DESIGNATED AGENT: DEE SOUTHALL
ADDRESS: P.O. BOX 1300 ADDRESS: P.O. BOX 1300
CITY: JANE LEW STATE: WV ZIP CODE: 26378 CITY: JANE LEW STATE: WV ZIP CODE: 26378

Table with 2 columns: LEGEND (Proposed Surface Hole, Existing Wellhead, Landing Point, Existing Water Well, Existing Spring) and REVISIONS/DATE.

JACKSON SURVEYING

INC.

P.O. Box 1460  
677 W. Main St.  
Clarksburg, WV 26302  
304-623-5851

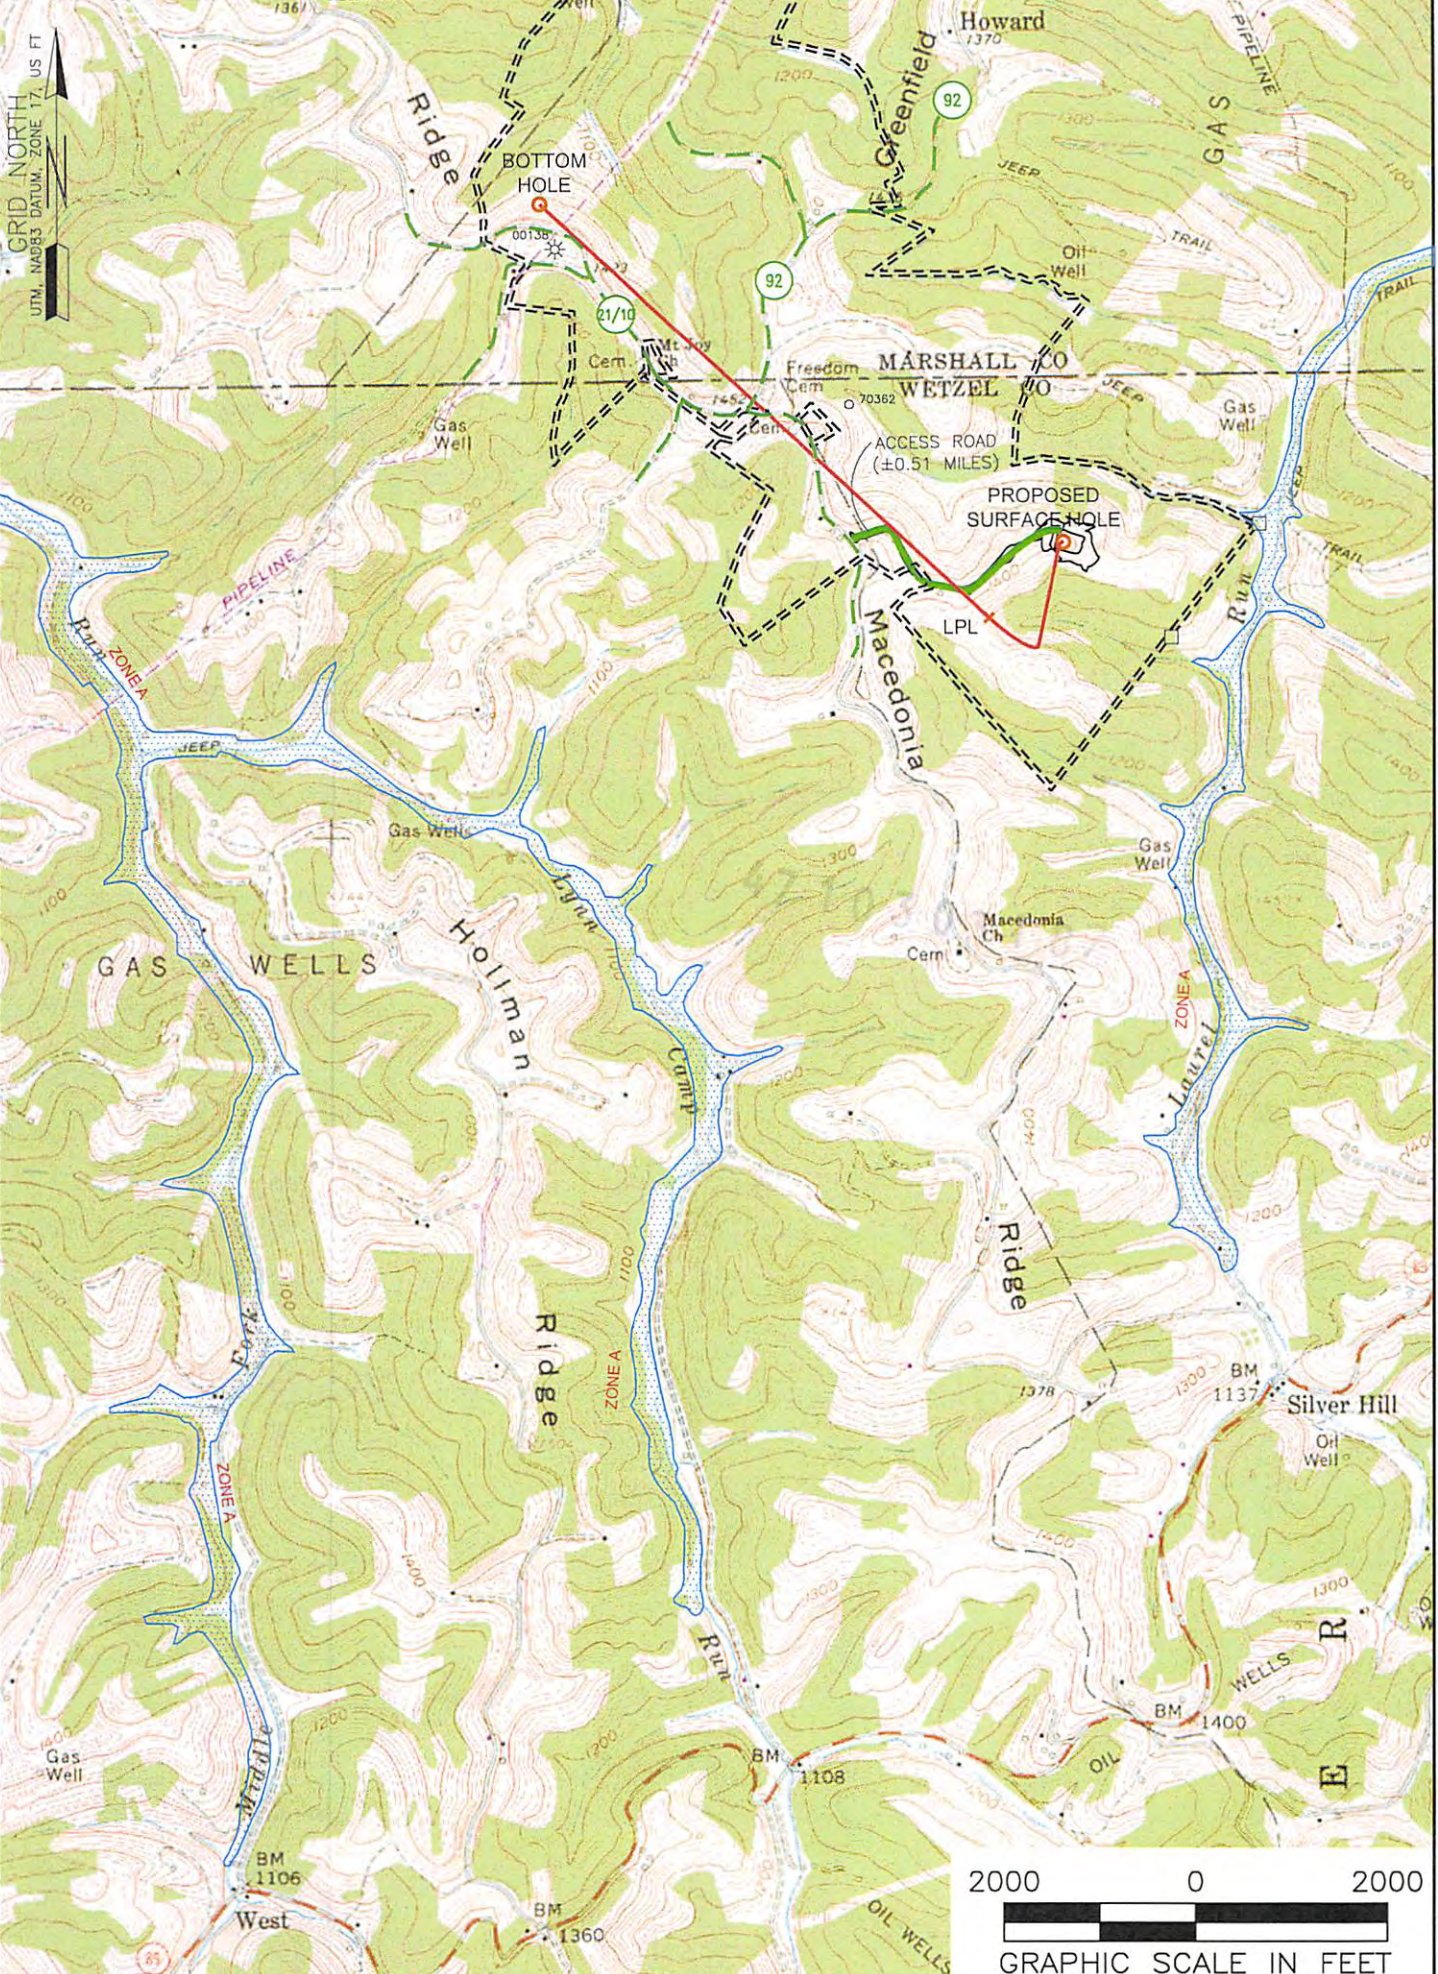

NOTES ON SURVEY

1. SURFACE AND ROYALTY OWNER INFORMATION AND THEIR BOUNDARIES SHOWN HEREON WERE PLOTTED FROM DEEDS AND/OR TAX PARCEL MAPS PROVIDED BY CLIENT AND/OR FIELD LOCATIONS. THIS PLAT DOES NOT REPRESENT A BOUNDARY SURVEY OF THE PARCELS SHOWN HEREON.
- 2.
- 3.
4. ALL INSETS ARE GRID NORTH UNLESS OTHERWISE DEPICTED.

LEGEND:

- PROPOSED SURFACE HOLE / BOTTOM HOLE
- EXISTING / PRODUCING WELLHEAD
- x LPL
- FLOOD PLAIN
- ACCESS ROAD
- PUBLIC ROAD
- ACCESS ROAD TO PREV. SITE
- LEASE BOUNDARY
- PROPOSED PATH

07/21/2017

WELL OPERATOR: SWN PRODUCTION COMPANY, LLC	WELL (FARM) NAME: DANIEL DURIG WTZ	WELL # 201H	SERIAL #
ADDRESS: P.O. BOX 1300 JANE LEW, WV 26378	COUNTY - CODE WETZEL - 103	DISTRICT; PROCTOR	
SURFACE OWNER: DANIEL DURIG	USGS 7 1/2 QUADRANGLE MAP NAME WILEYVILLE, WV		



**INFORMATION SUPPLIED UNDER WEST VIRGINIA CODE  
Chapter 22, Article 6A, Section 5(a)(5)  
IN LIEU OF FILING LEASE(S) AND OTHER CONTINUING CONTRACT(S)**

Under the oath required to make the verification on page 1 of this Notice and Application, I depose and say that I am the person who signed the Notice and Application for the Applicant, and that –

- (1) the tract of land is the same tract described in this Application, partly or wholly depicted in the accompanying plat, and described in the Construction and Reclamation Plan;
- (2) the parties and recordation data (if recorded) for lease(s) or other continuing contract(s) by which the Applicant claims the right to extract, produce or market the oil or gas are as follows:

Lease Name or Number	Grantor, Lessor, etc.	Grantee, Lessee, etc.	Royalty	Book/Page
See Exhibit				

RECEIVED  
Office of Oil and Gas  
  
MAY 23 2017  
  
WV Department of  
Environmental Protection

**Acknowledgement of Possible Permitting/Approval  
In Addition to the Office of Oil and Gas**

The permit applicant for the proposed well work addressed in this application hereby acknowledges the possibility of the need for permits and/or approvals from local, state, or federal entities in addition to the DEP, Office of Oil and Gas, including but not limited to the following:

- WV Division of Water and Waste Management
- WV Division of Natural Resources WV Division of Highways
- U.S. Army Corps of Engineers
- U.S. Fish and Wildlife Service
- County Floodplain Coordinator

The applicant further acknowledges that any Office of Oil and Gas permit in no way overrides, replaces, or nullifies the need for other permits/approvals that may be necessary and further affirms that all needed permits/approvals should be acquired from the appropriate authority before the affected activity is initiated.


Well Operator: SWN Production Company, LLC.  
 By:   
 Its: Caleb Weaver - Landman

EXHIBIT "A"

Attached to and made a part of the State of West Virginia Oil and Gas Permit Form, WV-643, by SWN Production Company, L.L.C., Operator  
Daniel Durig W/TZ 201H  
Wetzel County, West Virginia

5 7-29-14 724477

#	TWD	LEASE #	LESSOR	LESSEE	ROYALTY	8K/PG	SIGRAGE OWNER	Block/Prpg Must Describe Trct Parcel	DEEDED ACRES
1	12-5-6	724419-000	O. C. Yoho and Mary Yoho, his wife (Arthur and Shirley Durig, Life Estate; Daniel Durig, Remainderman) Manufacturers Light and Heat Company Columbia Gas Transmission Corporation Columbia Natural Resources, LLC Chesapeake Appalachia, L.L.C.	Manufacturers Light and Heat Company  Columbia Gas Transmission Corporation Columbia Natural Resources, LLC Chesapeake Appalachia, L.L.C. SWN Production Company, LLC	12.50%	45A/228  268/184 84A/129 402/448 157A/540	Daniel Durig ( Remainderman), Arthur Durig and Shirley Ann Durig (L/E) (S/R)	442/701	151.580000
2	12-5-11	724418-000	O. C. Yoho and Mary Yoho, his wife (Arthur and Shirley Durig, Life Estate; Daniel Durig, Remainderman) Manufacturers Light and Heat Company Columbia Gas Transmission Corporation Columbia Natural Resources, LLC Chesapeake Appalachia, L.L.C.	Manufacturers Light and Heat Company  Columbia Gas Transmission Corporation Columbia Natural Resources, LLC Chesapeake Appalachia, L.L.C. SWN Production Company, LLC	12.50%	45A/206  283/184 84A/129 402/448 157A/540	Daniel Durig ( Remainderman), Arthur Durig and Shirley Ann Durig (L/E) (S)	396/461	85.500000
3	12-05-6.2	724419-000	O. C. Yoho and Mary Yoho, his wife (Daniel Durig and Rhonda Durig) Manufacturers Light and Heat Company Columbia Gas Transmission Corporation Columbia Natural Resources, LLC Chesapeake Appalachia, L.L.C.	Manufacturers Light and Heat Company  Columbia Gas Transmission Corporation Columbia Natural Resources, LLC Chesapeake Appalachia, L.L.C. SWN Production Company, LLC	12.50%	45A/235  283/184 84A/129 402/448 157A/540	Daniel Durig and Rhonda K. Durig, husband and wife	396/461	0.800
4	12-05-05	723356-000	O. C. Yoho and Mary Yoho, his wife (Arthur and Shirley Durig, Life Estate; Daniel Durig, Remainderman) Manufacturers Light and Heat Company Columbia Gas Transmission Corporation Columbia Natural Resources, LLC Chesapeake Appalachia, L.L.C.	Manufacturers Light and Heat Company  Columbia Gas Transmission Corporation Columbia Natural Resources, LLC Chesapeake Appalachia, L.L.C. SWN Production Company, LLC	12.50%	45A/202  268/184 84A/129 402/448 157A/540	Arthur and Shirley Durig, Life Estate; Daniel Durig, Remainderman	396/461	9.100
5	7-29-14	724485-000	T. J. Yoho and Echeel Yoho, his wife, Tracy Yoho, widower, George N. Yoho, widower, Agatha Barbuto and Joseph Barbuto, her husband, Maxine Horton and Maxine Horton as Attorney-in-Fact for William Horton, Sherald Youcum and Eufa Youcum, his wife (Black Gold Group, LTD.); Nancy Nonemaker; Tammy Kay Boehm; Lisa Lee Ann Bowen; Onward E. Burge, Sarah Burge, and Stephen W. Burge, Trustees of the Onward E. Burge Trust Dated June 21, 2010; Onward E. Burge, Sarah Burge, and Stephen W. Burge, Trustees of the Sarah L. Burge Trust Dated June 21, 2010; Carol Darrow, Jack R. Hammers; Paul F. Hammer; Janet Hinerman; Sharon Hinerman-Hall; DeMn D. Horton; HS LLC; Teresa Lynn Lemley; Erica Mesore; Kimele Ann Matthews; Dennis McFadden; Hancy McFadden Metheny; Susan D. Moore; Virginia Carol Riffe; Deborah Yoho Showalter; Brent Alan Solder; Bryan Seider; Julie Dawn Solder; Scott Eric Solder; Shirley Terak; Toni Jo Mason Living Trust; Berneda Ward; Joseph L. Watkins; WesBanco Trust & Investment Services, Trustee under the Stoy K. Whitley and Twila O. Whitley Trust Agreement; Charlene Dee Wildman; Chalmer C. Youcum; James E. Youcum; Lindsay Noel Youcum; Paul F. Youcum; Quentin A. Youcum, Sr.; Thomas Leon Youcum; Bradley Scott Yoho; Clayton Garth Yoho; Darren Lee Yoho; Donna Yoho; Jeffrey Jay Yoho; Kevin Mark Yoho)	Manufacturers Light and Heat Company  Columbia Gas Transmission Corporation Columbia Natural Resources, LLC Chesapeake Appalachia, L.L.C.	12.50%	353/145  422/204 642/281 650/83 23A/424	Mason Dixon Farms, L.L.C.	646/100	128.400000

6 7-29-8.1 723780

7 7-29-8.2 723780

8 7-29-7 723334

**EXHIBIT "A"**  
Attached to and made a part of the State of West Virginia Oil and Gas Permit Form, WV-6AL, by SWN Production Company, L.L.C., Operator  
Daniel Durig WTZ 201K  
Wetzel County, West Virginia

WV	TRIP	LEASE #	LESSOR	LESSEE	ROYALTY	BN/P#	SURFACE OWNER	Book/Page Must describe The Parcel	DEEDED ACRES
1	12-5-6	724419-000	O. C. Yoho and Mary Yoho, his wife (Arthur and Shirley Durig, Life Estate; Daniel Durig, Remainderman) Manufacturers Light and Heat Company Columbia Gas Transmission Corporation Columbia Natural Resources, LLC Chesapeake Appalachia, L.L.C.	Manufacturers Light and Heat Company  Columbia Gas Transmission Corporation Columbia Natural Resources, LLC Chesapeake Appalachia, L.L.C. SWN Production Company, LLC	12.50%	45A/285  263/164 84A/129 402/446 157A/540	Daniel Durig ( Remainderman), Arthur Durig and Shirley Ann Durig (LE) (S/R)	442/701	151.580000
2	12-5-11	724419-000	O. C. Yoho and Mary Yoho, his wife (Arthur and Shirley Durig, Life Estate; Daniel Durig, Remainderman) Manufacturers Light and Heat Company Columbia Gas Transmission Corporation Columbia Natural Resources, LLC Chesapeake Appalachia, L.L.C.	Manufacturers Light and Heat Company  Columbia Gas Transmission Corporation Columbia Natural Resources, LLC Chesapeake Appalachia, L.L.C. SWN Production Company, LLC	12.50%	45A/206  263/164 84A/129 402/446 157A/540	Daniel Durig ( Remainderman), Arthur Durig and Shirley Ann Durig (LE) (S)	396/461	85.500000
3	12-05-6-2	724419-000	O. C. Yoho and Mary Yoho, his wife (Daniel Durig and Rhonda Durig)  Manufacturers Light and Heat Company Columbia Gas Transmission Corporation Columbia Natural Resources, LLC Chesapeake Appalachia, L.L.C.	Manufacturers Light and Heat Company  Columbia Gas Transmission Corporation Columbia Natural Resources, LLC Chesapeake Appalachia, L.L.C. SWN Production Company, LLC	12.50%	45A/285  263/164 84A/129 402/446 157A/540	Daniel Durig and Rhonda K. Durig, husband and wife	396/461	0.500
4	12-05-05	723356-000	O. C. Yoho and Mary Yoho, his wife (Arthur and Shirley Durig, Life Estate; Daniel Durig, Remainderman)  Manufacturers Light and Heat Company Columbia Gas Transmission Corporation Columbia Natural Resources, LLC Chesapeake Appalachia, L.L.C.	Manufacturers Light and Heat Company  Columbia Gas Transmission Corporation Columbia Natural Resources, LLC Chesapeake Appalachia, L.L.C. SWN Production Company, LLC	12.50%	45A/202  263/164 84A/129 402/446 157A/540	Arthur and Shirley Durig, Life Estate; Daniel Durig, Remainderman	395/461	9.100
5	7-29-14	724485-000	T. J. Yoho and Ethel Yoho, his wife, Tracy Yoho, widower, George N. Yoho, widower, Agatha Barbuto and Joseph Barbuto, her husband, Maxine Horton and Maxine Horton as Attorney-in-Fact for William Horton, Gerald Yocum and Eula Yocum, his wife (Black Gold Group, LTD.) Nancy Nonemaker; Tammy Kay Boehm; Lisa Lee Ann Bowen; Onward E. Burge, Sarah Burge, and Stephan W. Burge, Trustees of the Onward E. Burge Trust Dated June 21, 2010; Onward E. Burge, Sarah Burge, and Stephan W. Burge, Trustees of the Sarah L. Burge Trust Dated June 21, 2010; Carol Darrow; Jack R. Hammers; Paul F. Hammen; Janet Kinerman; Sharon Kinerman-Hall; Debra D. Horton; HS LLC; Teresa Lynn Lemley; Erica Mason; Kimela Ann Matthews; Dennis McFadden; Nancy McFadden McHenry; Susan D. Moore; Virginia Carol Riffle; Deborah Yoho Shawhan; Brent Alan Snider; Bryan Snider; Julia Dawn Snider; Scott Eric Snider; Shirley Yerek; Yoni Jo Mason Living Trust; Bernada Ward; Joseph L. Watkins; Westbank Trust & Investment Services, Trustee under the Stoy K. Whipkey and Twila O. Whipkey Trust Agreement; Charlene Dee Wildman; Chalmer C. Yocum; James E. Yocum; Lindsay Noel Yocum; Paul F. Yocum; Quentin A. Yocum, Sr.; Thomas Leon Yocum; Bradley Scott Yoho; Clayton Garth Yoho; Darren Lee Yoho; Donna Yoho; Jeffery Jay Yoho; Kevin Mark Yoho)	Manufacturers Light and Heat Company  Columbia Gas Transmission Corporation Columbia Natural Resources, LLC Chesapeake Appalachia, L.L.C.	12.50%	353/145  422/204 643/281 650/88 38A/424	Mason Dixon Farms, L.L.C.	646/103	129.400000

EXHIBIT "A"

Attached to and made a part of the State of West Virginia Oil and Gas Permit Form, WW-641, by SWN Production Company, L.L.C., Operator  
Daniel Durg WIZ 201H  
Wetzel County, West Virginia

5	7-29-14	724477-000	T. J. Yoho and Ethesel Yoho, his wife, Trece Yoho, widow, George N. Yoho, widow, Agatha Barbuto and Joseph Barbuto, her husband, Maxine Horton and Maxine Horton as Attorney-in-Fact for William Horton, Sherald Yocum and Eula Yocum, his wife (Black Gold Group, LTD.; Nancy Koenemaber; Tammy Kay Boehm; Lisa Lee Ann Bowen; Onward E. Burge, Sarah Burge, and Stephen W. Burge, Trustees of the Onward E. Burge Trust Dated June 21, 2010; Onward E. Burge, Sarah Burge, and Stephen W. Burge, Trustees of the Sarah L. Burge Trust Dated June 21, 2010; Carol Derrrow; Jack R. Hammers; Paul F. Hammers; Janet Hinerman; Sharon Hinerman-Halt; Dávin D. Horton; H3 LLC; Manager Enterprises LLC; Teresa Lynn Lemley; Erica Mason; Kimela Ann Matthews; Denals McFadden; Nancy McFadden Metheny; Susan D. Moore; Virginia Carol Riffe; Deborah Yoho Showalter; Brent Alan Snider; Bryan Snider; Julie Dawn Snider; Scott Eric Snider; Shirley Terrell; Toni Jo Mason Living Trust; Bernada Ward; Joseph L. Watkins; WesBanco Trust & Investment Services, Trustee under the Stoy K. Whippley and Twila O. Whippley Trust Agreement dated August 25, 1999; Charlene Dee Wildman; Chalmer C. Yocum; James E. Yocum; Lindsay Noel Yocum; Paul F. Yocum; Quentin A. Yocum, Sr.; Thomas Leon Yocum; Bradley Scott Yohoy; Clayton Garth Yoho; Darren Lee Yoho; Donna Yoho; Jeffrey Jay Yohoy; Kevin Mark Yoho)	Manufacturers Light and Heat Company	12.50%	353/341	Mason Dixon Farms, L.L.C.	646/103	128,400,000
			Manufacturers Light and Heat Company			Columbia Gas Transmission Corporation		422/204	
			Columbia Gas Transmission Corporation			Columbia Natural Resources, LLC		642/281	
			Columbia Natural Resources, LLC			Chesapeake Appalachia, L.L.C.		650/63	
			Chesapeake Appalachia, L.L.C.			SWN Production Company, LLC		33A/42A	
6	7-29-8.1	723780-000	George N. Yoho, widower (Jack R. Hammers; Paul F. Hammers; Erica M. Mason; Toni Jo Mason Living Trust; Onward E. Burge, Sarah Burge, and Stephen W. Burge, Trustees of the Onward E. Burge Trust Dated June 21, 2010; Onward E. Burge, Sarah Burge, and Stephen W. Burge, Trustees of the Sarah L. Burge Trust Dated June 21, 2010; WesBanco Trust & Investment Services, Trustee under the Stoy K. Whippley and Twila O. Whippley Trust Agreement dated August 25, 1999)	Manufacturers Light and Heat Company	12.50%	353/103	Alton W. Stern, Life Estate; Alan W. Stern, Diane E. Stern, Deborah E. Perri, and Beverly J. Davenport, Remaindermen	700/118	110,000,000
			Manufacturers Light and Heat Company			Columbia Gas Transmission Corporation		422/204	
			Columbia Gas Transmission Corporation			Columbia Natural Resources, LLC		642/281	
			Columbia Natural Resources, LLC			Chesapeake Appalachia, L.L.C.		650/63	
			Chesapeake Appalachia, L.L.C.			SWN Production Company, LLC		33A/42A	
7	7-29-8.2	723780-000	George N. Yoho, widower (Jack R. Hammers; Paul F. Hammers; Erica M. Mason; Toni Jo Mason Living Trust; Onward E. Burge, Sarah Burge, and Stephen W. Burge, Trustees of the Onward E. Burge Trust Dated June 21, 2010; Onward E. Burge, Sarah Burge, and Stephen W. Burge, Trustees of the Sarah L. Burge Trust Dated June 21, 2010; WesBanco Trust & Investment Services, Trustee under the Stoy K. Whippley and Twila O. Whippley Trust Agreement dated August 25, 1999)	Manufacturers Light and Heat Company	12.50%	353/103	Mason Dixon Farms, L.L.C.	646/103	52,120,000
			Manufacturers Light and Heat Company			Columbia Gas Transmission Corporation		422/204	
			Columbia Gas Transmission Corporation			Columbia Natural Resources, LLC		642/281	
			Columbia Natural Resources, LLC			Chesapeake Appalachia, L.L.C.		650/63	
			Chesapeake Appalachia, L.L.C.			SWN Production Company, LLC		33A/42A	
8	7-29-7	723354-000	George N. Yoho, widower (Jack R. Hammers; Paul F. Hammers; Erica M. Mason; Toni Jo Mason Living Trust; Onward E. Burge, Sarah Burge, and Stephen W. Burge, Trustees of the Onward E. Burge Trust Dated June 21, 2010; Onward E. Burge, Sarah Burge, and Stephen W. Burge, Trustees of the Sarah L. Burge Trust Dated June 21, 2010; WesBanco Trust & Investment Services, Trustee under the Stoy K. Whippley and Twila O. Whippley Trust Agreement dated August 25, 1999)	Manufacturers Light and Heat Company	12.50%	353/383	Mason Dixon Farms, L.L.C.	646/103	162,000,000
			Manufacturers Light and Heat Company			Columbia Gas Transmission Corporation		422/204	
			Columbia Gas Transmission Corporation			Columbia Natural Resources, LLC		642/281	
			Columbia Natural Resources, LLC			Chesapeake Appalachia, L.L.C.		650/63	
			Chesapeake Appalachia, L.L.C.			SWN Production Company, LLC		33A/42A	

EXHIBIT "A"

Attached to and made a part of the State of West Virginia Oil and Gas Permit Form, WV-6AL, by SWN Production Company, L.L.C., Operator  
Daniel Durig WTX 201H  
Wetzel County, West Virginia

9	7-29-12	723780-000	George N. Yoho, widower (Jack R. Hammers; Paul F. Hammers; Erica M. Mason; Tom Jo Mason Living Trust; Orward E. Burge, Sarah Burge, and Stephen W. Burge, Trustees of the Orward E. Burge Trust Dated June 21, 2010; Orward E. Burge, Sarah Burge, and Stephen W. Burge, Trustees of the Sarah L. Burge Trust Dated June 21, 2010; Westaco Trust & Investment Services, Trustee under the Stoy K. Whipkey and Twila Q. Whipkey Trust Agreement dated August 25, 1999)	Manufacturers Light and Heat Company	12.50%	353/103	Mason Dixon Farms, L.L.C.	648/103	25,160
			Manufacturers Light and Heat Company	Columbia Gas Transmission Corporation		422/204			
			Columbia Gas Transmission Corporation	Columbia Natural Resources, LLC		642/281			
			Columbia Natural Resources, LLC	Chesapeake Appalachia, L.L.C.		650/83			
			Chesapeake Appalachia, L.L.C.	SWN Production Company, LLC		33A/42A			
10	7-29-9	723780-000	George N. Yoho, widower (Jack R. Hammers; Paul F. Hammers; Erica M. Mason; Tom Jo Mason Living Trust; Orward E. Burge, Sarah Burge, and Stephen W. Burge, Trustees of the Orward E. Burge Trust Dated June 21, 2010; Orward E. Burge, Sarah Burge, and Stephen W. Burge, Trustees of the Sarah L. Burge Trust Dated June 21, 2010; Westaco Trust & Investment Services, Trustee under the Stoy K. Whipkey and Twila Q. Whipkey Trust Agreement dated August 25, 1999)	Manufacturers Light and Heat Company	12.50%	353/103	Mason Dixon Farms, L.L.C.	648/103	25,000
			Manufacturers Light and Heat Company	Columbia Gas Transmission Corporation		422/204			
			Columbia Gas Transmission Corporation	Columbia Natural Resources, LLC		642/281			
			Columbia Natural Resources, LLC	Chesapeake Appalachia, L.L.C.		650/83			
			Chesapeake Appalachia, L.L.C.	SWN Production Company, LLC		33A/42A			



SWN Production Company, LLC  
P O Box 12359  
Spring, Texas 77391-2359  
www.swn.com

February 22, 2017

Ms. Laura Adkins  
WV DEP Office of Oil & Gas  
601 57<sup>th</sup> St., SE  
Charleston, WV 25304

**RE:** SWN's proposed New Well: Daniel Durig WTZ 201H in Wetzel County, West Virginia, Drilling under Macedonia Ridge Road.

Dear Ms. Adkins:

SWN Production Company, LLC ("SWN") is applying for a drilling permit for the above referenced well. The State of West Virginia has raised some concern as to SWN's right to drill under Macedonia Ridge Road. Please be advised that SWN has leased all mineral owners under said route as it relates to the above-referenced well and unit.

Thank you.

Sincerely,

Caleb Weaver  
Landman  
SWN Production Company, LLC  
PO Box 1300  
Jane Lew, WV 26378

RECEIVED  
Office of Oil and Gas  
MAY 23 2017  
WV Department of  
Environmental Protection

**STATE OF WEST VIRGINIA**  
**DEPARTMENT OF ENVIRONMENTAL PROTECTION, OFFICE OF OIL AND GAS**  
**NOTICE CERTIFICATION**

Date of Notice Certification: \_\_\_\_\_

API No. 47- \_\_\_\_\_ - \_\_\_\_\_

Operator's Well No. Daniel Durig WTZ 201H

Well Pad Name: Daniel Durig WTZ Pad

**Notice has been given:**

Pursuant to the provisions in West Virginia Code § 22-6A, the Operator has provided the required parties with the Notice Forms listed below for the tract of land as follows:

State: <u>WV</u>	UTM NAD 83 Easting: <u>525892.63</u>
County: <u>103- Wetzel</u>	Northing: <u>4393245.81</u>
District: <u>Proctor</u>	Public Road Access: <u>Macedonia Ridge Road</u>
Quadrangle: <u>Wileyville</u>	Generally used farm name: <u>Daniel Durig</u>
Watershed: <u>Laurel Run</u>	

Pursuant to West Virginia Code § 22-6A-7(b), every permit application filed under this section shall be on a form as may be prescribed by the secretary, shall be verified and shall contain the following information: (14) A certification from the operator that (i) it has provided the owners of the surface described in subdivisions (1), (2) and (4), subsection (b), section ten of this article, the information required by subsections (b) and (c), section sixteen of this article; (ii) that the requirement was deemed satisfied as a result of giving the surface owner notice of entry to survey pursuant to subsection (a), section ten of this article six-a; or (iii) the notice requirements of subsection (b), section sixteen of this article were waived in writing by the surface owner; and Pursuant to West Virginia Code § 22-6A-11(b), the applicant shall tender proof of and certify to the secretary that the notice requirements of section ten of this article have been completed by the applicant.

<p>Pursuant to West Virginia Code § 22-6A, the Operator has attached proof to this Notice Certification that the Operator has properly served the required parties with the following:</p> <p>*PLEASE CHECK ALL THAT APPLY</p> <p><input type="checkbox"/> 1. NOTICE OF SEISMIC ACTIVITY or <input type="checkbox"/> NOTICE NOT REQUIRED BECAUSE NO SEISMIC ACTIVITY WAS CONDUCTED</p> <p><input type="checkbox"/> 2. NOTICE OF ENTRY FOR PLAT SURVEY or <input type="checkbox"/> NO PLAT SURVEY WAS CONDUCTED</p> <p><input checked="" type="checkbox"/> 3. NOTICE OF INTENT TO DRILL or <input type="checkbox"/> NOTICE NOT REQUIRED BECAUSE NOTICE OF ENTRY FOR PLAT SURVEY WAS CONDUCTED or</p> <p style="padding-left: 100px;"><input type="checkbox"/> WRITTEN WAIVER BY SURFACE OWNER (PLEASE ATTACH)</p> <p><input checked="" type="checkbox"/> 4. NOTICE OF PLANNED OPERATION</p> <p><input checked="" type="checkbox"/> 5. PUBLIC NOTICE</p> <p><input checked="" type="checkbox"/> 6. NOTICE OF APPLICATION</p>	<p><b>OOG OFFICE USE ONLY</b></p> <p><input type="checkbox"/> RECEIVED/ NOT REQUIRED</p> <p><input type="checkbox"/> RECEIVED</p> <p><input type="checkbox"/> RECEIVED/ NOT REQUIRED</p> <p><input type="checkbox"/> RECEIVED</p> <p><input type="checkbox"/> RECEIVED</p> <p><input type="checkbox"/> RECEIVED</p>
<p>RECEIVED Office of Oil and Gas <b>MAY 23 2017</b> WV Department of Environmental Protection</p>	

**Required Attachments:**


The Operator shall attach to this Notice Certification Form all Notice Forms and Certifications of Notice that have been provided to the required parties and/or any associated written waivers. For the Public Notice, the operator shall attach a copy of the Class II Legal Advertisement with publication date verification or the associated Affidavit of Publication. The attached Notice Forms and Certifications of Notice shall serve as proof that the required parties have been noticed as required under West Virginia Code § 22-6A. Pursuant to West Virginia Code § 22-6A-11(b), the Certification of Notice to the person may be made by affidavit of personal service, the return receipt card or other postal receipt for certified mailing.

**Certification of Notice is hereby given:**

THEREFORE, I \_\_\_\_\_, have read and understand the notice requirements within West Virginia Code § 22-6A. I certify that as required under West Virginia Code § 22-6A, I have served the attached copies of the Notice Forms, identified above, to the required parties through personal service, by registered mail or by any method of delivery that requires a receipt or signature confirmation. I certify under penalty of law that I have personally examined and am familiar with the information submitted in this Notice Certification and all attachments, and that based on my inquiry of those individuals immediately responsible for obtaining the information, I believe that the information is true, accurate and complete. I am aware that there are significant penalties for submitting false information, including the possibility of fine and imprisonment.

Well Operator: SWN Production Co., LLC  
By: Dee Southall  
Its: Regulatory Supervisor  
Telephone: 304-884-1614

Address: P.O. Box 1300  
Jane Lew, WV 26378  
Facsimile: \_\_\_\_\_  
Email: Dee\_Southall@swn.com

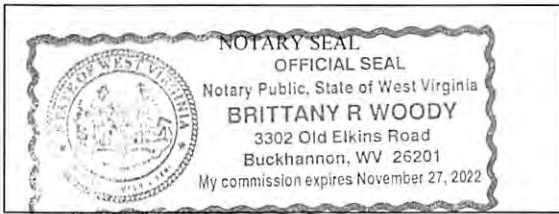

Subscribed and sworn before me this 8th day of February 2017  
Brittany R Woody Notary Public  
My Commission Expires 11/27/2022

**Oil and Gas Privacy Notice:**

The Office of Oil and Gas processes your personal information, such as name, address and telephone number, as part of our regulatory duties. Your personal information may be disclosed to other State agencies or third parties in the normal course of business or as needed to comply with statutory or regulatory requirements, including Freedom of Information Act requests. Our office will appropriately secure your personal information. If you have any questions about our use or your personal information, please contact DEP's Chief Privacy Officer at [deprivacyofficer@wv.gov](mailto:deprivacyofficer@wv.gov).

4710303101

RECEIVED  
Office of Oil and Gas  
MAY 23 2017  
WV Department of  
Environmental Protection



STATE OF WEST VIRGINIA  
DEPARTMENT OF ENVIRONMENTAL PROTECTION, OFFICE OF OIL AND GAS  
NOTICE OF APPLICATION

Notice Time Requirement: notice shall be provided no later than the filing date of permit application.

Date of Notice: 5/22/17 Date Permit Application Filed: 5/22/17

Notice of:

- PERMIT FOR ANY WELL WORK
- CERTIFICATE OF APPROVAL FOR THE CONSTRUCTION OF AN IMPOUNDMENT OR PIT

Delivery method pursuant to West Virginia Code § 22-6A-10(b)

- PERSONAL SERVICE
- REGISTERED MAIL
- METHOD OF DELIVERY THAT REQUIRES A RECEIPT OR SIGNATURE CONFIRMATION

Pursuant to W. Va. Code § 22-6A-10(b) no later than the filing date of the application, the applicant for a permit for any well work or for a certificate of approval for the construction of an impoundment or pit as required by this article shall deliver, by personal service or by registered mail or by any method of delivery that requires a receipt or signature confirmation, copies of the application, the erosion and sediment control plan required by section seven of this article, and the well plat to each of the following persons: (1) The owners of record of the surface of the tract on which the well is or is proposed to be located; (2) The owners of record of the surface tract or tracts overlying the oil and gas leasehold being developed by the proposed well work, if the surface tract is to be used for roads or other land disturbance as described in the erosion and sediment control plan submitted pursuant to subsection (c), section seven of this article; (3) The coal owner, operator or lessee, in the event the tract of land on which the well proposed to be drilled is located [sic] is known to be underlain by one or more coal seams; (4) The owners of record of the surface tract or tracts overlying the oil and gas leasehold being developed by the proposed well work, if the surface tract is to be used for the placement, construction, enlargement, alteration, repair, removal or abandonment of any impoundment or pit as described in section nine of this article; (5) Any surface owner or water purveyor who is known to the applicant to have a water well, spring or water supply source located within one thousand five hundred feet of the center of the well pad which is used to provide water for consumption by humans or domestic animals; and (6) The operator of any natural gas storage field within which the proposed well work activity is to take place. (c)(1) If more than three tenants in common or other co-owners of interests described in subsection (b) of this section hold interests in the lands, the applicant may serve the documents required upon the person described in the records of the sheriff required to be maintained pursuant to section eight, article one, chapter eleven-a of this code. (2) Notwithstanding any provision of this article to the contrary, notice to a lien holder is not notice to a landowner, unless the lien holder is the landowner. W. Va. Code R. § 35-8-5.7.a requires, in part, that the operator shall also provide the Well Site Safety Plan ("WSSP") to the surface owner and any water purveyor or surface owner subject to notice and water testing as provided in section 15 of this rule.

Application Notice  WSSP Notice  E&S Plan Notice  Well Plat Notice is hereby provided to:

SURFACE OWNER(s) ✓  
 Name: Daniel Durig & Arthur and Shirley Durig L/E  
 Address: 3116 Macedonia Ridge Road  
 New Martinsville, WV 26155  
 Name: \_\_\_\_\_  
 Address: \_\_\_\_\_

COAL OWNER OR LESSEE ✓  
 Name: Consolidation Coal Company  
 Address: 1000 Consol Energy Drive  
 Canonsburg, PA 15317  
 COAL OPERATOR  
 Name: \_\_\_\_\_  
 Address: \_\_\_\_\_

SURFACE OWNER(s) (Road and/or Other Disturbance)  
 Name: \_\_\_\_\_  
 Address: \_\_\_\_\_  
 Name: \_\_\_\_\_  
 Address: \_\_\_\_\_

SURFACE OWNER OF WATER WELL AND/OR WATER PURVEYOR(s)  
 Name: See Attachment #1  
 Address: \_\_\_\_\_

SURFACE OWNER(s) (Impoundments or Pits)  
 Name: \_\_\_\_\_  
 Address: \_\_\_\_\_

OPERATOR OF ANY NATURAL GAS STORAGE FIELD  
 Name: \_\_\_\_\_  
 Address: \_\_\_\_\_

\*Please attach additional forms if necessary

RECEIVED  
Office of Oil and Gas

MAY 23 2017

WV Department of  
Environmental Protection

07/21/2017

**STATE OF WEST VIRGINIA**  
**DEPARTMENT OF ENVIRONMENTAL PROTECTION, OFFICE OF OIL AND GAS**  
**NOTICE OF APPLICATION**

**Notice Time Requirement:** notice shall be provided no later than the **filing date of permit application.**

**Date of Notice:** 5/22/17 **Date Permit Application Filed:** 5/22/17

**Notice of:**

RECEIVED  
Office of Oil and Gas

**MAY 23 2017**

- PERMIT FOR ANY WELL WORK
- CERTIFICATE OF APPROVAL FOR THE CONSTRUCTION OF AN IMPOUNDMENT OR PIT

WV Department of  
Environmental Protection

**Delivery method pursuant to West Virginia Code § 22-6A-10(b)**

- PERSONAL SERVICE
- REGISTERED MAIL
- METHOD OF DELIVERY THAT REQUIRES A RECEIPT OR SIGNATURE CONFIRMATION

Pursuant to W. Va. Code § 22-6A-10(b) no later than the filing date of the application, the applicant for a permit for any well work or for a certificate of approval for the construction of an impoundment or pit as required by this article shall deliver, by personal service or by registered mail or by any method of delivery that requires a receipt or signature confirmation, copies of the application, the erosion and sediment control plan required by section seven of this article, and the well plat to each of the following persons: (1) The owners of record of the surface of the tract on which the well is or is proposed to be located; (2) The owners of record of the surface tract or tracts overlying the oil and gas leasehold being developed by the proposed well work, if the surface tract is to be used for roads or other land disturbance as described in the erosion and sediment control plan submitted pursuant to subsection (c), section seven of this article; (3) The coal owner, operator or lessee, in the event the tract of land on which the well proposed to be drilled is located [sic] is known to be underlain by one or more coal seams; (4) The owners of record of the surface tract or tracts overlying the oil and gas leasehold being developed by the proposed well work, if the surface tract is to be used for the placement, construction, enlargement, alteration, repair, removal or abandonment of any impoundment or pit as described in section nine of this article; (5) Any surface owner or water purveyor who is known to the applicant to have a water well, spring or water supply source located within one thousand five hundred feet of the center of the well pad which is used to provide water for consumption by humans or domestic animals; and (6) The operator of any natural gas storage field within which the proposed well work activity is to take place. (c)(1) If more than three tenants in common or other co-owners of interests described in subsection (b) of this section hold interests in the lands, the applicant may serve the documents required upon the person described in the records of the sheriff required to be maintained pursuant to section eight, article one, chapter eleven-a of this code. (2) Notwithstanding any provision of this article to the contrary, notice to a lien holder is not notice to a landowner, unless the lien holder is the landowner. W. Va. Code R. § 35-8-5.7.a requires, in part, that the operator shall also provide the Well Site Safety Plan ("WSSP") to the surface owner and any water purveyor or surface owner subject to notice and water testing as provided in section 15 of this rule.

Application Notice  WSSP Notice  E&S Plan Notice  Well Plat Notice is hereby provided to:

SURFACE OWNER(s)

Name: \_\_\_\_\_  
Address: \_\_\_\_\_

Name: \_\_\_\_\_  
Address: \_\_\_\_\_

SURFACE OWNER(s) (Road and/or Other Disturbance)

Name: \_\_\_\_\_  
Address: \_\_\_\_\_

Name: \_\_\_\_\_  
Address: \_\_\_\_\_

SURFACE OWNER(s) (Impoundments or Pits)

Name: \_\_\_\_\_  
Address: \_\_\_\_\_

COAL OWNER OR LESSEE

Name: Daniel Durig  
Address: 3116 Macedonia Ridge Road  
New Martinsville, WV 26155

COAL OPERATOR

Name: \_\_\_\_\_  
Address: \_\_\_\_\_

SURFACE OWNER OF WATER WELL AND/OR WATER PURVEYOR(s)

Name: See Attachment #1  
Address: \_\_\_\_\_

OPERATOR OF ANY NATURAL GAS STORAGE FIELD

Name: \_\_\_\_\_  
Address: \_\_\_\_\_

\*Please attach additional forms if necessary

Attachment #1

**Daniel Durig WTZ Pad - Water Purveyors w/in 1500'**

**Sources**

**Landowner**  
Daniel Durig

**Address**  
3116 Macedonia Ridge Road Cameron WV 26033 2 springs



5780071000

RECEIVED  
Office of Oil and Gas  
MAY 23 2017  
WV Department of  
Environmental Protection

MAY 23 2017

WV Department of  
Environmental Protection

**Notice is hereby given:**

Pursuant to West Virginia Code § 22-6A-10(b), notice is hereby given that the undersigned well operator has applied for a permit for well work or for a certificate of approval for the construction of an impoundment or pit.

**This Notice Shall Include:**

Pursuant to W. Va. Code § 22-6A-10(b), this notice shall include: (1) copies of the application; (2) the erosion and sediment control plan required by section seven of this article; and (3) the well plat.

Pursuant to W. Va. Code § 22-6A-10(f), this notice shall include: (1) a statement of the time limits for filing written comments; (2) who may file written comments; (3) the name and address of the secretary for the purpose of filing the comments and obtaining additional information; and (4) a statement that the persons may request, at the time of submitting written comments, notice of the permit decision and a list of persons qualified to test water.

Pursuant to W. Va. Code R. § 35-8-5.7.a, the operator shall provide the Well Site Safety Plan to the surface owner and any water purveyor or surface owner subject to notice and water testing as provided in section 15 of this rule.

Pursuant to W. Va. Code R. § 35-8-15.2.c, this notice shall: (1) contain a statement of the surface owner's and water purveyor's right to request sampling and analysis; (2) advise the surface owner and water purveyor of the rebuttable presumption for contamination or deprivation of a fresh water source or supply; advise the surface owner and water purveyor that refusal to allow the operator to conduct a pre-drilling water well test constitutes a method to rebut the presumption of liability; (3) advise the surface owner and water purveyor of his or her independent right to sample and analyze any water supply at his or her own expense; advise the surface owner and water purveyor whether or not the operator will utilize an independent laboratory to analyze any sample; and (4) advise the surface owner and or water purveyor that he or she can obtain from the Chief a list of water testing laboratories in the subject area capable of and qualified to test water supplies in accordance with standard acceptable methods.

Additional information related to horizontal drilling may be obtained from the Secretary, at the WV Department of Environmental Protection headquarters, located at 601 57<sup>th</sup> Street, SE, Charleston, WV 25304 (304-926-0450) or by visiting [www.dep.wv.gov/oil-and-gas/pages/default.aspx](http://www.dep.wv.gov/oil-and-gas/pages/default.aspx).

**Well Location Restrictions**

Pursuant to W. Va. Code § 22-6A-12, Wells may not be drilled within two hundred fifty feet measured horizontally from any existing water well or developed spring used for human or domestic animal consumption. The center of well pads may not be located within six hundred twenty-five feet of an occupied dwelling structure, or a building two thousand five hundred square feet or larger used to house or shelter dairy cattle or poultry husbandry. This limitation is applicable to those wells, developed springs, dwellings or agricultural buildings that existed on the date a notice to the surface owner of planned entry for surveying or staking as provided in section ten of this article or a notice of intent to drill a horizontal well as provided in subsection (b), section sixteen of this article was provided, whichever occurs first, and to any dwelling under construction prior to that date. This limitation may be waived by written consent of the surface owner transmitted to the department and recorded in the real property records maintained by the clerk of the county commission for the county in which such property is located. Furthermore, the well operator may be granted a variance by the secretary from these distance restrictions upon submission of a plan which identifies the sufficient measures, facilities or practices to be employed during well site construction, drilling and operations. The variance, if granted, shall include terms and conditions the department requires to ensure the safety and protection of affected persons and property. The terms and conditions may include insurance, bonding and indemnification, as well as technical requirements. (b) No well pad may be prepared or well drilled within one hundred feet measured horizontally from any perennial stream, natural or artificial lake, pond or reservoir, or a wetland, or within three hundred feet of a naturally reproducing trout stream. No well pad may be located within one thousand feet of a surface or ground water intake of a public water supply. The distance from the public water supply as identified by the department shall be measured as follows: (1) For a surface water intake on a lake or reservoir, the distance shall be measured from the boundary of the lake or reservoir. (2) For a surface water intake on a flowing stream, the distance shall be measured from a semicircular radius extending upstream of the surface water intake. (3) For a groundwater source, the distance shall be measured from the wellhead or spring. The department may, in its discretion, waive these distance restrictions upon submission of a plan identifying sufficient measures, facilities or practices to be employed during well site construction, drilling and operations to protect the waters of the state. A waiver, if granted, shall impose any permit conditions as the secretary considers necessary. (c) Notwithstanding the foregoing provisions of this section, nothing contained in this section prevents an operator from conducting the activities permitted or authorized by a Clean Water Act Section 404 permit or other approval from the United States Army Corps of Engineers within any waters of the state or within the restricted areas referenced in this section. (d) The well location restrictions set forth in this section shall not apply to any well on a multiple well pad if at least one of the wells was permitted prior to the effective date of this article. (e) The secretary shall, by December 31, 2012, report to the Legislature on the noise, light, dust and volatile organic compounds generated by the drilling of horizontal wells as they relate to the well location restrictions regarding occupied dwelling structures pursuant to this section. Upon a finding, if any, by the secretary that the well location restrictions regarding occupied dwelling structures are inadequate or otherwise require alteration to address the items

07/21/2017

examined in the study required by this subsection, the secretary shall have the authority to propose for promulgation legislative rules establishing guidelines and procedures regarding reasonable levels of noise, light, dust and volatile organic compounds relating to drilling horizontal wells, including reasonable means of mitigating such factors, if necessary.

**Water Well Testing:**

Pursuant to West Virginia Code § 22-6A-10(d), notification shall be made, with respect to surface landowners identified in subsection (b) or water purveyors identified in subdivision (5), subsection (b) of this section, of the opportunity for testing their water well. The operator shall provide an analysis to such surface landowner or water purveyor at their request:

**Water Testing Laboratories:**

Pursuant to West Virginia Code § 22-6A-10(i), persons entitled to notice pursuant to subsection (b) of this section may contact the department to ascertain the names and locations of water testing laboratories in the subject area capable and qualified to test water supplies in accordance with standard accepted methods. In compiling that list of names the department shall consult with the state Bureau for Public Health and local health departments. A surface owner and water purveyor has an independent right to sample and analyze any water supply at his or her own expense. The laboratory utilized by the operator shall be approved by the agency as being certified and capable of performing sample analyses in accordance with this section.

**Rebuttable Presumption for Contamination or Deprivation of a Fresh Water Source or Supply:**

W. Va. Code § 22-6A-18 requires that (b) unless rebutted by one of the defenses established in subsection (c) of this section, in any action for contamination or deprivation of a fresh water source or supply within one thousand five hundred feet of the center of the well pad for horizontal well, there is a rebuttable presumption that the drilling and the oil or gas well or either was the proximate cause of the contamination or deprivation of the fresh water source or supply. (c) In order to rebut the presumption of liability established in subsection (b) of this section, the operator must prove by a preponderance of the evidence one of the following defenses: (1) The pollution existed prior to the drilling or alteration activity as determined by a predrilling or prealteration water well test. (2) The landowner or water purveyor refused to allow the operator access to the property to conduct a predrilling or prealteration water well test. (3) The water supply is not within one thousand five hundred feet of the well. (4) The pollution occurred more than six months after completion of drilling or alteration activities. (5) The pollution occurred as the result of some cause other than the drilling or alteration activity. (d) Any operator electing to preserve its defenses under subdivision (1), subsection (c) of this section shall retain the services of an independent certified laboratory to conduct the predrilling or prealteration water well test. A copy of the results of the test shall be submitted to the department and the surface owner or water purveyor in a manner prescribed by the secretary. (e) Any operator shall replace the water supply of an owner of interest in real property who obtains all or part of that owner's supply of water for domestic, agricultural, industrial or other legitimate use from an underground or surface source with a comparable water supply where the secretary determines that the water supply has been affected by contamination, diminution or interruption proximately caused by the oil or gas operation, unless waived in writing by that owner. (f) The secretary may order the operator conducting the oil or gas operation to: (1) Provide an emergency drinking water supply within twenty-four hours; (2) Provide temporary water supply within seventy-two hours; (3) Within thirty days begin activities to establish a permanent water supply or submit a proposal to the secretary outlining the measures and timetables to be used in establishing a permanent supply. The total time in providing a permanent water supply may not exceed two years. If the operator demonstrates that providing a permanent replacement water supply cannot be completed within two years, the secretary may extend the time frame on case-by-case basis; and (4) Pay all reasonable costs incurred by the real property owner in securing a water supply. (g) A person as described in subsection (b) of this section aggrieved under the provisions of subsections (b), (e) or (f) of this section may seek relief in court... (i) Notwithstanding the denial of the operator of responsibility for the damage to the real property owner's water supply or the status of any appeal on determination of liability for the damage to the real property owner's water supply, the operator may not discontinue providing the required water service until authorized to do so by the secretary or a court of competent jurisdiction.

**Written Comment:**

Pursuant to West Virginia Code § 22-6A-11(a), all persons described in subsection (b), section ten of this article may file written comments with the secretary as to the location or construction of the applicant's proposed well work within thirty days after the application is filed with the secretary. All persons described in West Virginia Code § 22-6A-10(b) may file written comments as to the location or construction of the applicant's proposed well work to the Secretary at:

Chief, Office of Oil and Gas  
Department of Environmental Protection  
601 57<sup>th</sup> St. SE  
Charleston, WV 25304  
(304) 926-0450

RECEIVED  
Office of Oil and Gas

MAY 23 2017

WV Department of  
Environmental Protection

Such persons may request, at the time of submitting written comments, notice of the permit decision and a list of persons qualified to test water. **NOTE: YOU ARE NOT REQUIRED TO FILE ANY COMMENT.**

**Time Limits and Methods for Filing Comments.**

The law requires these materials to be served on or before the date the operator files its Application. You have **THIRTY (30) DAYS** after the filing date to file your comments. Comments must be filed in person or received in the mail by the Chief's office by the time stated above. You may call the Chief's office to be sure of the date. Check with your postmaster to ensure adequate delivery time or to arrange special expedited handling. If you have been contacted by the well operator and you have signed a "voluntary statement of no objection" to the planned work described in these materials, then the permit may be issued at any time.

Pursuant to West Virginia Code § 22-6A-11(c)(2), Any objections of the affected coal operators and coal seam owners and lessees shall be addressed through the processes and procedures that exist under sections fifteen, seventeen and forty, article six of this chapter, as applicable and as incorporated into this article by section five of this article. The written comments filed by the parties entitled to notice under subdivisions (1), (2), (4), (5) and (6), subsection (b), section ten of this article shall be considered by the secretary in the permit issuance process, but the parties are not entitled to participate in the processes and proceedings that exist under sections fifteen, seventeen or forty, article six of this chapter, as applicable and as incorporated into this article by section five of this article.

**Comment Requirements**

Your comments must be in writing and include your name, address and telephone number, the well operator's name and well number and the approximate location of the proposed well site including district and county from the application. You may add other documents, such as sketches, maps or photographs to support your comments.

Disclaimer: All comments received will be placed on our web site <http://www.dep.wv.gov/oil-and-gas/Horizontal-Permits/Pages/default.aspx> and the applicant will automatically be forwarded an email notice that such comments have been submitted. The applicant will be expected to provide a response to comments submitted by any surface owner, water purveyor or natural gas storage operator noticed within the application.

**Permit Denial or Condition**

The Chief has the power to deny or condition a well work permit. Pursuant to West Virginia Code § 22-6A-8(d), the permit may not be issued or be conditioned, including conditions with respect to the location of the well and access roads prior to issuance if the director determines that:

- (1) The proposed well work will constitute a hazard to the safety of persons;
- (2) The plan for soil erosion and sediment control is not adequate or effective;
- (3) Damage would occur to publicly owned lands or resources; or
- (4) The proposed well work fails to protect fresh water sources or supplies.

A permit may also be denied under West Virginia Code § 22-6A-7(k), the secretary shall deny the issuance of a permit if the secretary determines that the applicant has committed a substantial violation of a previously issued permit for a horizontal well, including the applicable erosion and sediment control plan associated with the previously issued permit, or a substantial violation of one or more of the rules promulgated under this article, and in each instance has failed to abate or seek review of the violation within the time prescribed by the secretary pursuant to the provisions of subdivisions (1) and (2), subsection (a), section five of this article and the rules promulgated hereunder, which time may not be unreasonable.

Pursuant to West Virginia Code § 22-6A-10(g), any person entitled to submit written comments to the secretary pursuant to subsection (a), section eleven of this article, shall also be entitled to receive from the secretary a copy of the permit as issued or a copy of the order modifying or denying the permit if the person requests receipt of them as a part of the written comments submitted concerning the permit application. Such persons may request, at the time of submitting written comments, notice of the permit decision and a list of persons qualified to test water.

RECEIVED  
Office of Oil and Gas

MAY 23 2017

WV Department of  
Environmental Protection

07/21/2017

WW-6A  
(8-13)

API NO. 47- \_\_\_\_\_ - \_\_\_\_\_  
OPERATOR WELL NO. Daniel Durig Wtz 201H  
Well Pad Name: Daniel Durig Wtz Pad


**Notice is hereby given by:**

Well Operator: SWN Production Co., LLC  
Telephone: 304-884-1614  
Email: Dee\_Southall@swn.com

Address: P.O. Box 1300  
Jane Lew, WV 26378  
Facsimile: \_\_\_\_\_

**Oil and Gas Privacy Notice:**

The Office of Oil and Gas processes your personal information, such as name, address and telephone number, as part of our regulatory duties. Your personal information may be disclosed to other State agencies or third parties in the normal course of business or as needed to comply with statutory or regulatory requirements, including Freedom of Information Act requests. Our office will appropriately secure your personal information. If you have any questions about our use or your personal information, please contact DEP's Chief Privacy Officer at [deprivacyofficer@wv.gov](mailto:deprivacyofficer@wv.gov).

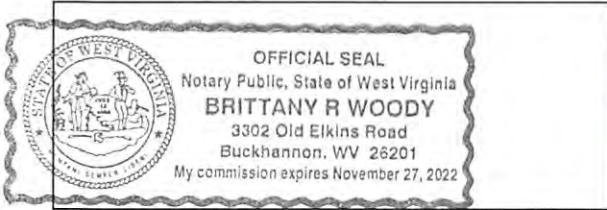

Subscribed and sworn before me this 8th day of February 2017  
Brittany R Woody Notary Public  
My Commission Expires 11/27/22

RECEIVED  
Office of Oil and Gas  
MAY 23 2017  
WV Department of  
Environmental Protection

07/21/2017

**STATE OF WEST VIRGINIA**  
**DEPARTMENT OF ENVIRONMENTAL PROTECTION, OFFICE OF OIL AND GAS**  
**NOTICE OF INTENT TO DRILL**

Pursuant to W. Va. Code § 22-6A-16(b), the Notice of Intent to Drill is only required if the notice requirements of W. Va. Code § 22-6A-10(a) have NOT been met or if the Notice of Intent to Drill requirement has NOT been waived in writing by the surface owner.

**Notice Time Requirement:** Notice shall be provided at least **TEN (10)** days prior to filing a permit application.

**Date of Notice:** 02/08/2017      **Date Permit Application Filed:** 5/23/17

**Delivery method pursuant to West Virginia Code § 22-6A-16(b)**

**HAND DELIVERY**       **CERTIFIED MAIL RETURN RECEIPT REQUESTED**

Pursuant to W. Va. Code § 22-6A-16(b), at least ten days prior to filing a permit application, an operator shall, by certified mail return receipt requested or hand delivery, give the surface owner notice of its intent to enter upon the surface owner's land for the purpose of drilling a horizontal well: *Provided*, That notice given pursuant to subsection (a), section ten of this article satisfies the requirements of this subsection as of the date the notice was provided to the surface owner: *Provided, however*, That the notice requirements of this subsection may be waived in writing by the surface owner. The notice, if required, shall include the name, address, telephone number, and if available, facsimile number and electronic mail address of the operator and the operator's authorized representative.

**Notice is hereby provided to the SURFACE OWNER(s):**

Name: Daniel Durig  
Address: 3116 Macedonia Ridge Rd.  
New Martinsville, WV 26155

Name: \_\_\_\_\_  
Address: \_\_\_\_\_

**Notice is hereby given:**

Pursuant to West Virginia Code § 22-6A-16(b), notice is hereby given that the undersigned well operator has an intent to enter upon the surface owner's land for the purpose of drilling a horizontal well on the tract of land as follows:

State:	<u>West Virginia</u>	UTM NAD 83	Easting:	<u>530,924.111</u>
County:	<u>Wetzel</u>		Northing:	<u>4,396,390.211</u>
District:	<u>Proctor</u>	Public Road Access:	<u>Macedonia Ridge Rd.</u>	
Quadrangle:	<u>Wileyville, WV</u>	Generally used farm name:	<u>Daniel Durig WTZ</u>	
Watershed:	<u>Laurel Run</u>			

**This Notice Shall Include:**

Pursuant to West Virginia Code § 22-6A-16(b), this notice shall include the name, address, telephone number, and if available, facsimile number and electronic mail address of the operator and the operator's authorized representative. Additional information related to horizontal drilling may be obtained from the Secretary, at the WV Department of Environmental Protection headquarters, located at 601 57<sup>th</sup> Street, SE, Charleston, WV 25304 (304-926-0450) or by visiting [www.dep.wv.gov/oil-and-gas/pages/default.aspx](http://www.dep.wv.gov/oil-and-gas/pages/default.aspx).

**Notice is hereby given by:**

Well Operator: SWN Production Company, LLC  
Address: PO Box 1300, 179 Innovation Drive  
Jane Lew, WV 26378  
Telephone: 832-540-1136  
Email: Steve\_Teel@SWN.com  
Facsimile: 304-471-2497

Authorized Representative: Steve Teel  
Address: PO Box 1300, 179 Innovation Drive  
Jane Lew, WV 26378  
Telephone: 832-540-1136  
Email: Steve\_Teel@SWN.com  
Facsimile: 304-471-2497

**Oil and Gas Privacy Notice:**

The Office of Oil and Gas processes your personal information, such as name, address and telephone number, as part of our regulatory duties. Your personal information may be disclosed to other State agencies or third parties in the normal course of business or as needed to comply with statutory or regulatory requirements, including Freedom of Information Act requests. Our office will appropriately secure your personal information. If you have any questions about our use or your personal information, please contact DEP's Chief Privacy Officer at [depprivacyofficer@wv.gov](mailto:depprivacyofficer@wv.gov).

RECEIVED  
Office of Oil and Gas

MAY 23 2017

WV Department of  
Environmental Protection

07/21/2017



**STATE OF WEST VIRGINIA**  
**DEPARTMENT OF ENVIRONMENTAL PROTECTION, OFFICE OF OIL AND GAS**  
**NOTICE OF PLANNED OPERATION**

**Notice Time Requirement:** notice shall be provided no later than the filing date of permit application.

**Date of Notice:** 02/08/2017      **Date Permit Application Filed:** 5/20/17

**Delivery method pursuant to West Virginia Code § 22-6A-16(c)**

- CERTIFIED MAIL                                       HAND
- RETURN RECEIPT REQUESTED                                      DELIVERY

Pursuant to W. Va. Code § 22-6A-16(c), no later than the date for filing the permit application, an operator shall, by certified mail return receipt requested or hand delivery, give the surface owner whose land will be used for the drilling of a horizontal well notice of the planned operation. The notice required by this subsection shall include: (1) A copy of this code section; (2) The information required to be provided by subsection (b), section ten of this article to a surface owner whose land will be used in conjunction with the drilling of a horizontal well; and (3) A proposed surface use and compensation agreement containing an offer of compensation for damages to the surface affected by oil and gas operations to the extent the damages are compensable under article six-b of this chapter. (d) The notices required by this section shall be given to the surface owner at the address listed in the records of the sheriff at the time of notice.

**Notice is hereby provided to the SURFACE OWNER(s)**

(at the address listed in the records of the sheriff at the time of notice):

Name: Daniel Durig  
Address: 3116 Macedonia Ridge Rd.  
New Martinsville, WV 26155

Name: \_\_\_\_\_  
Address: \_\_\_\_\_ /

**Notice is hereby given:**

Pursuant to West Virginia Code § 22-6A-16(c), notice is hereby given that the undersigned well operator has developed a planned operation on the surface owner's land for the purpose of drilling a horizontal well on the tract of land as follows:

State: <u>West Virginia</u>	UTM NAD 83	Easting: <u>530,924.111</u>
County: <u>Wetzel</u>		Northing: <u>4,396,390.211</u>
District: <u>Proctor</u>	Public Road Access: <u>Macedonia Ridge Rd.</u>	
Quadrangle: <u>Wileyville, WV</u>	Generally used farm name: <u>Daniel Durig WTZ</u>	
Watershed: <u>Laurel Run</u>		

**This Notice Shall Include:**

Pursuant to West Virginia Code § 22-6A-16(c), this notice shall include: (1) A copy of this code section; (2) The information required to be provided by **W. Va. Code § 22-6A-10(b)** to a surface owner whose land will be used in conjunction with the drilling of a horizontal well; and (3) A proposed surface use and compensation agreement containing an offer of compensation for damages to the surface affected by oil and gas operations to the extent the damages are compensable under article six-b of this chapter. Additional information related to horizontal drilling may be obtained from the Secretary, at the WV Department of Environmental Protection headquarters, located at 601 57<sup>th</sup> Street, SE, Charleston, WV 25304 (304-926-0450) or by visiting [www.dep.wv.gov/oil-and-gas/pages/default.aspx](http://www.dep.wv.gov/oil-and-gas/pages/default.aspx).

Well Operator: SWN Production Company, LLC  
Telephone: 832-540-1136  
Email: Steve\_Teel@SWN.com

Address: PO Box 1300, 179 Innovation Drive  
Jane Lew, WV 26378  
Facsimile: 304-471-2497

**Oil and Gas Privacy Notice:**

The Office of Oil and Gas processes your personal information, such as name, address and telephone number, as part of our regulatory duties. Your personal information may be disclosed to other State agencies or third parties in the normal course of business or as needed to comply with statutory or regulatory requirements, including Freedom of Information Act requests. Our office will appropriately secure your personal information. If you have any questions about our use or your personal information, please contact DEP's Chief Privacy Officer at [depprivacyofficer@wv.gov](mailto:depprivacyofficer@wv.gov).

RECEIVED  
Office of Oil and Gas

MAY 23 2017

WV Department of Environmental Protection **07/21/2017**



WEST VIRGINIA DEPARTMENT OF TRANSPORTATION

**Division of Highways**

1900 Kanawha Boulevard East • Building Five • Room 110  
Charleston, West Virginia 25305-0430 • (304) 558-3505

Jim Justice  
Governor

Thomas J. Smith, P. E.  
Secretary of Transportation/  
Commissioner of Highways

February 16, 2017

James A. Martin, Chief  
Office of Oil and Gas  
Department of Environmental Protection  
601 57<sup>th</sup> Street, SE  
Charleston, WV 25304

Subject: DOH Permit for the Daniel Durig Pad WTZ 201H Well Site, Wetzel County

47-103-03187

Dear Mr. Martin,

The West Virginia Division of Highways has transferred Permit # 06-2008-0012 to Southwestern Energy for the existing well pad. Access to the well site is off of Wetzel County Route 6 SLS.

The operator has signed an OIL AND GAS ROAD MAINTENANCE BONDING AGREEMENT and provided the required Bond. This operator is currently in compliance with the DOH OIL AND GAS POLICY dated January 3, 2012.

RECEIVED  
Office of Oil and Gas

MAY 23 2017

WV Department of  
Environmental Protection

Very Truly Yours,

Gary K. Clayton  
Regional Maintenance Engineer  
Central Office Oil & Gas Coordinator

Cc: Brittany Woody  
Southwestern Energy  
CH, OM, D-6  
File

47 10303107

Product Name	Product Use	Chemical Name	CAS Number
EC6734A (Champion Technologies)	Biocide	Hydrogen Peroxide	7722-84-1
		Acetic Acid	64-19-7
		Peroxyacetic Acid	79-21-0
GYPTRON T-390 (Champion Technologies)	Scale Inhibitor	Methanol	67-56-1
		Nonylphenol Ethoxylate	Proprietary
Bactron K-139 (Champion Technologies)	Biocide	Glutaraldehyde	111-30-8
		Quaternary Ammonium Compounds, Benzyl-C12-16-Alkyldimethyl, Chlorides	68424-85-1
		Ethanol	64-17-5
Bactron K-219 (Champion Technologies)	Biocide	Methanol	67-56-1
		Quaternary Ammonium Compounds, Benzyl-C12-16-Alkyldimethyl, Chlorides	68424-85-1
A264 (Schlumberger)	Corrosion Inhibitor	Methanol	67-56-1
		Aliphatic Acids	Proprietary
		Prop-2-yn-1-ol	107-19-7
		Aliphatic Alcohols, Ethoxylated #1	Proprietary
Myacide GA 25 (Schlumberger)	Biocide	Water	7732-18-5
		Glutaral	111-30-8
Scale Inhibitor B317 (Schlumberger)	Scale Inhibitor	Trisodium Ortho Phosphate	7601-54-9
		Ethane-1,2-diol	107-21-1
H215 (Schlumberger)	Hydrochloric Acid	Hydrochloric Acid	7647-01-0
J218 (Schlumberger)	Breaker	Diammonium Peroxidisulphate	7727-54-0
EB-Clean* J475 (Schlumberger)	Breaker	Diammonium Peroxidisulphate	7727-54-0
Water Gelling Agent J580 (Schlumberger)	Gel	Carbohydrate Polymer	Proprietary
Friction Reducer J609W (Schlumberger)	Friction Reducer	Ammonium Sulfate	7783-20-2
		Urea	57-13-6
Crosslinker J610 (Schlumberger)	Crosslinker	Potassium Hydroxide	1310-58-3
		Aliphatic Polyol	Proprietary
Iron Stabilizer L58 (Schlumberger)	Iron Stabilizer	Sodium Erythorbate	6381-77-7
40/70-Mesh Sand S012 (Schlumberger)	Sand	Crystalline Silica	14808-60-7
Sand S100 (Schlumberger)	Sand	Crystalline Silica	14808-60-7
EC6486A (Nalco Champion)	Scale Inhibitor	Amine Triphosphate	Proprietary
		Ethylene Glycol	107-21-1
SSA-2 (Halliburton)	Sand	Crystalline Silica	14808-60-7
FR-76 (Halliburton)	Friction Reducer	Inorganic salt	64742-47-8
		Hydrotreated light petroleum distillate	
LCA-1 (Halliburton)		Hydrotreated light petroleum distillate	Proprietary
SP BREAKER (Halliburton)	Breaker	Sodium Persulfate	7775-27-1

07/21/2017

Product Name	Product Use	Chemical Name	CAS Number
HAI-150E (Halliburton)	Corrosion Inhibitor	Methanol	NA
		Aliphatic Acids	
		Prop-2-yn-1-ol	
		Aliphatic Alcohols, Ethoxylated #1	
Hydrochloric Acid 10-30% (Halliburton)		Hydrochloric Acid	7647-01-0
WG-36 Gelling Agent (Halliburton)	Gel	Polysaccharide	9000-30-0
BC-140C (Halliburton)	Crosslinker		NA


47 900 07 10

# SWN PRODUCTION COMPANY DURIG WELL PAD ENLARGEMENT

EROSION AND SEDIMENTATION CONTROL PLAN  
CENTER DISTRICT, WETZEL COUNTY, WV  
DECEMBER 2016



**SITE LOCATION MAP**

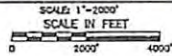


**NOTES:**

1. CONTRACTOR SHALL REFER TO OTHER PLANS WITHIN THIS CONSTRUCTION SET FOR OTHER PERTINENT INFORMATION. IT IS NOT THE ENGINEER'S INTENT THAT ANY SINGLE PLAN SHEET IN THIS SET OF DOCUMENTS FULLY DEPICT ALL WORK ASSOCIATED WITH THE PROJECT.
2. WV ONECALL WEB TICKET SERIAL NUMBER 16302336360, DATED 11-18-2016.

Engineer's Estimate of Quantities		
Erosion and Sediment Control Items		
Description	Estimated Quantity	Unit
18" Silt Fence	140	LF
30" Silt Fence	110	LF
Super Silt Fence	150	LF
12" Compost Filter Sock	320	LF
18" Compost Filter Sock	360	LF
24" Compost Filter Sock	1,000	LF
32" Compost Filter Sock	120	LF
Compost Filter Sock Sediment Trap	5	EA
Slope Stabilization	7,350	SY
Rock Construction Entrance	1	EA
Riprap Aprons	5	EA
Riprap Apron R-3 Aggregate	1.6	TH
Class 4 Geotextile (Apron Underlayment)	32	SY
Additional Items		
Description	Estimated Quantity	Unit
Site Restoration Area	0.43	Acres
Inlet Protection	4	EA
Storm Manholes	2	EA
Concrete Pipe Anchors	5	EA
Type DIV Endwalls	4	EA
Pad Inlet	4	EA
Geotextile Filter Bag	1	EA
WVDOH Guide Rail	265	LF
Concrete Washout Facility	1	EA
18x6-57520 Channel Lining	077	SY
Proposed Subsurface Drain	115	LF
Proposed Subsurface Drain Outlet	55	LF
Well Pad Perimeter Berm	2	EA
Well Pad Perimeter Berm	687	LF
10-Foot (Min.) Wide Bench	491	LF
5-Foot (Min.) Wide Bench	547	LF
Fill Foundation Key	111	LF
Existing Items to be Removed		
Description	Estimated Quantity	Unit
Existing Unpaved Pad/Access Road	650	SY
Existing Drainage Ditch	240	LF
Existing Storm Sewer	110	LF
Existing Riprap	35	SY
Existing Silt Fence	125	LF
Existing Gas Utility Items	1	LS



**SITE MAP**

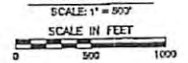

**DEVELOPER /OWNER**

SWN PRODUCTION COMPANY, LLC  
10000 ENERGY DRIVE  
SPRING, TX 77389-4954  
PHONE: 832-796-6372  
CONTACT: CARLA SUSZKOWSKI

**CIVIL ENGINEER**

CIVIL & ENVIRONMENTAL CONSULTANTS, INC.  
333 BALDWIN ROAD  
PITTSBURGH, PA 15205  
PH: (412) 429-2324  
FX: (412) 429-2114  
CONTACT: ROBERT C. BASSETT, P.E.

**REFERENCE**

1. USGS TOPOGRAPHIC MAP / ARCGIS MAP SERVICE: [http://g0114001arcgis.com/ArcGIS/USA\\_Topo\\_Maps](http://g0114001arcgis.com/ArcGIS/USA_Topo_Maps), ACCESSED 11/14/2016 WHEELVILLE, WV ROAD AND LITTLETON, WV ROAD.
2. AERIAL IMAGERY FROM Bing (2016 MICROSOFT CORPORATION); ACCESSED NOVEMBER 2016.

07/21/2017

# COMPANY, LLC ENLARGEMENT PROJECT

CONTROL PLANS  
WEST VIRGINIA

47 103 031 85



SHEET LIST TABLE	
SHEET NUMBER	SHEET TITLE
C000	COVER SHEET
D100	EXISTING CONDITIONS PLAN
C300	GEOTECHNICAL SLOPE REPAIR PLAN
C600	GEOTECHNICAL DETAILS AND CROSS-SECTIONS
DV00	EROSION AND SEDIMENTATION CONTROL PLAN
C601	EROSION AND SEDIMENTATION CONTROL DETAILS
C602	EROSION AND SEDIMENTATION CONTROL DETAILS
C603	EROSION AND SEDIMENTATION CONTROL DETAILS
C604	EROSION AND SEDIMENTATION CONTROL DETAILS
C605	EROSION AND SEDIMENTATION CONTROL DETAILS

NO.	DATE	DESCRIPTION
1	10/21/16	REVISED FOR DAVIS REQUEST
2	10/21/16	REVISED FOR DAVIS REQUEST
3	10/21/16	REVISED FOR DAVIS REQUEST
4	10/21/16	REVISED FOR DAVIS REQUEST

**Civil & Environmental Consultants, Inc.**  
333 Baldwin Road - Pittsburgh, PA 15205  
412-429-2324 • 800-365-2324  
www.civil.com

**SWN PRODUCTION COMPANY, LLC**  
**DURIG WELL PAD ENLARGEMENT PROJECT**  
**CENTER DISTRICT**  
**WETZEL COUNTY, WEST VIRGINIA**

**COVER SHEET**


DATE: DECEMBER 2016 (DRAWN BY: RCB)  
DWG SCALE: AS SHOWN (CHECKED BY: 103-227)  
PROJECT NO.: 103-227  
APPROVED BY: ZAC

GRANT NO.: **C000**

GEOTECHNICAL ENGINEER

*DML*  
*3-1-n*

CIVIL & ENVIRONMENTAL CONSULTANTS, INC.  
333 BALDWIN ROAD  
PITTSBURGH, PA 15205  
PH: (412) 779-5728  
FX: (412) 429-2114  
CONTACT: MIKE SCHUMAKER, P.E.

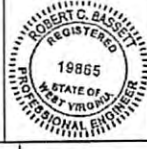


07/21/2017

# SWN PRODUCTION COMPANY, LLC DURIG WELL PAD ENLARGEMENT PROJECT

EROSION AND SEDIMENTATION CONTROL PLANS  
CENTER DISTRICT, WETZEL COUNTY, WEST VIRGINIA  
MAY 2017



SITE LOCATION MAP

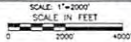

**WVDEP OOG  
ACCEPTED AS-BUILT**


*WJ* 5 / 30 / 2017

- NOTES:**
- CONTRACTOR SHALL REFER TO OTHER PLANS WITHIN THIS CONSTRUCTION SET FOR OTHER PERTINENT INFORMATION. IT IS NOT THE ENGINEER'S INTENT THAT ANY SINGLE DRAWING SHEET IN THIS SET OF DOCUMENTS FULLY DEPICT ALL WORK ASSOCIATED WITH THE PROJECT.
  - WV ONECALL WEB TICKET SERIAL NUMBER 16302336390, DATED 11-18-2016.

Engineer's Estimate of Quantities		
Erosion and Sediment Control Items		
Description	Estimated Quantity	Unit
18" Silt Fence	180	LF
80" Silt Fence	110	LF
Super Silt Fence	210	LF
12" Compost Filter Sock	330	LF
18" Compost Filter Sock	300	LF
24" Compost Filter Sock	1,000	LF
12" Compost Filter Sock	120	LF
Compost Filter Sock Sediment Trap	5	EA
Slope Stabilization	7,800	SY
Rock Construction Entrance	1	EA
Riprap Apron	5	EA
Riprap Apron R-3 Aggregate	1.6	TN
Class 4 Geotextile (Apron Underlayments)	32	SY
Additional Items		
Description	Estimated Quantity	Unit
Site Restoration Area	0.43	Acres
Inlet Protection	4	EA
Storm Manholes	2	EA
Concrete Pipe Anchors	5	EA
Type DW Endwalls	4	EA
Pad Inlet	4	EA
Geotextile Filter Bag	1	EA
IN-DOOR Guide Rail	285	LF
Concrete Washout Facility	1	EA
NAG-575BN Channel Lining	607	SY
Proposed Subsurface Drain	518	LF
Proposed Subsurface Drain Outlet	33	LF
Well Pad Perimeter Berm	2	EA
Well Pad Perimeter Berm	687	LF
10-foot (Min.) Wide Bench	401	LF
15-foot (Min.) Wide Bench	547	LF
Fill Foundation Key	111	LF
Existing Items to be Removed		
Description	Estimated Quantity	Unit
Existing Unimproved Pad/Access Road	650	SY
Existing Drainage Ditch	240	LF
Existing Storm Sewer	130	LF
Existing Riprap	36	SY
Existing Silt Fence	125	LF
Existing Gas Utility Items	1	LS



SITE MAP

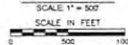

SHEET LIST TABLE	
SHEET NUMBER	SHEET TITLE
C000	COVER SHEET

EXISTING WELL: DURIG WTZ 1H 47-103-02331H

LAT: 39.716814  
LON: 80.639108

EXISTING WELL: DURIG WTZ 2H 47-103-02376H

LAT: 39.716818  
LON: 80.639157

EXISTING WELL: DURIG WTZ 5H 47-103-02375H

LAT: 39.716808  
LON: 80.639058

DEVELOPER / OWNER

SWN PRODUCTION COMPANY, LLC  
10000 ENERGY DRIVE  
SPRING, TX 77389-4954  
PHONE: 832-796-6372  
CONTACT: CARLA SUSZKOWSKI

CIVIL ENGINEER

CIVIL & ENVIRONMENTAL CONSULTANTS, INC.  
333 BALDWIN ROAD  
PITTSBURGH, PA 15205  
PH: (412) 429-2324  
FX: (412) 429-2114  
CONTACT: ROBERT C. BASSETT, P.E.

- REFERENCE**
- USGS TOPOGRAPHIC MAP / ARCIS MAP SERVICE: [http://data.arcgis.com/arcgis/rest/services/USA\\_Topo\\_Maps](http://data.arcgis.com/arcgis/rest/services/USA_Topo_Maps), ACCESSED 11/14/2016; WILEYVILLE, WV QUAD AND LITTLETON, WV QUAD.
  - AERIAL IMAGERY FROM Bing (2016 MICROSOFT CORPORATION), ACCESSED NOVEMBER 2016.

REVISION RECORD

NO.	DATE	DESCRIPTION
1	5/30/2017	ISSUED FOR AS-BUILT COMMENTS

**CEC**  
Civil & Environmental Consultants, Inc.  
333 Baldwin Road, Pittsburgh, PA 15205  
412-429-2324 / 412-429-2324  
www.cec-pa.com

SWN PRODUCTION COMPANY, LLC  
DURIG WELL PAD ENLARGEMENT PROJECT  
CENTER DISTRICT  
WETZEL COUNTY, WEST VIRGINIA

COVER SHEET


DATE: MAY 2017  
DRAWN BY: AS SHOWN  
CHECKED BY:  
APPROVED BY:



DRAWING NO  
**C000**



PROPOSED LIMIT OF DISTURBANCE

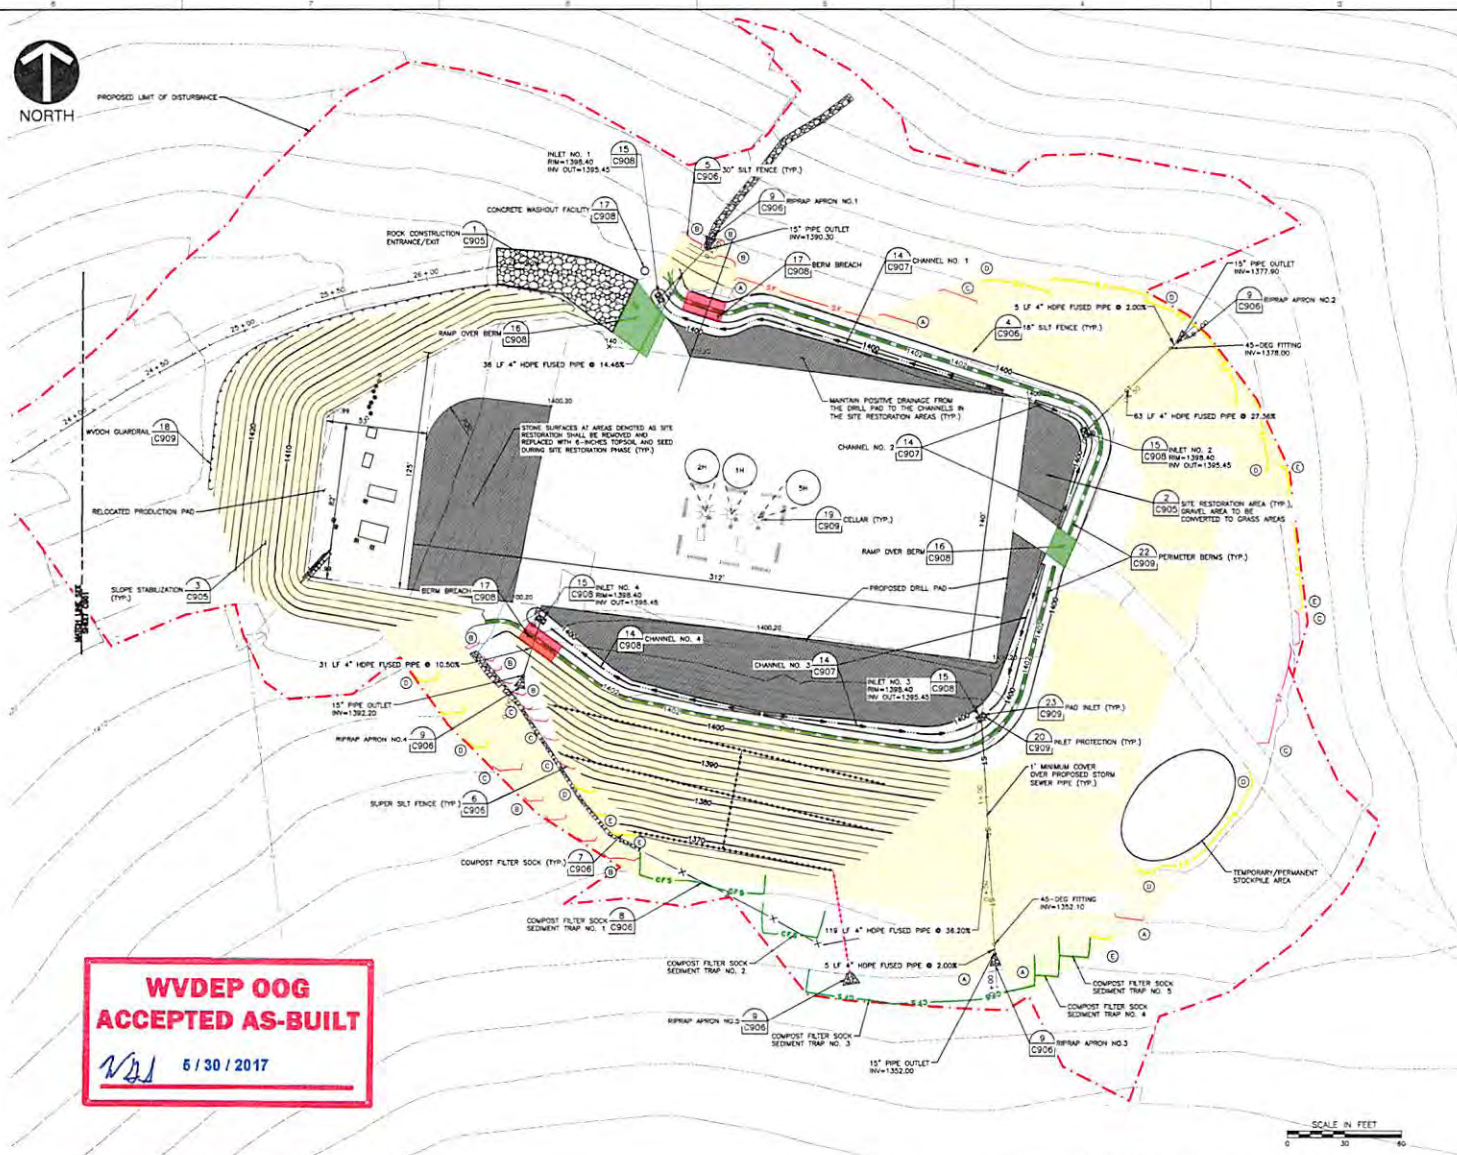

**SITE LOCATION MAP**  
SCALE IN FEET  
0 2000 4000

- LEGEND**
- 1200 --- EXISTING INDEX CONTOUR
  - 1100 --- EXISTING INTERMEDIATE CONTOUR
  - 1000 --- EXISTING UNPAVED PAD/ACCESS ROAD
  - 1000 --- EXISTING DIRT LANE
  - 1000 --- EXISTING FENCE
  - 1190 --- EXISTING RIPRAP
  - 1190 --- PROPOSED INDEX CONTOUR
  - 1190 --- PROPOSED INTERMEDIATE CONTOUR
  - 1190 --- PROPOSED DRILL PAD LIMITS
  - 1190 --- PROPOSED GUARDRAIL
  - 1190 --- PROPOSED SUBSURFACE DRAIN
  - 1190 --- PROPOSED DRAIN OUTLET
  - 1190 --- PROPOSED CHANNEL
  - 1190 --- PROPOSED BERM
  - 1190 --- PROPOSED STORM SEWER
  - 1190 --- PROPOSED SILET
  - 1190 --- PROPOSED MANHOLE
  - 1190 --- PROPOSED RIPRAP APRON
  - 1190 --- PROPOSED LIMIT OF DISTURBANCE
  - 1190 --- PROPOSED SALT FENCE
  - 1190 --- PROPOSED COMPOST FILTER SOCK
  - 1190 --- PROPOSED COMPOST FILTER SOCK TRAP
  - 1190 --- PROPOSED SLOPE STABILIZATION
  - 1190 --- PROPOSED ROOF CONSTRUCTION ENTRANCE
  - 1190 --- PROPOSED INLET FILTER BAG
  - 1190 --- PROPOSED SITE RESTORATION AREA
  - 1190 --- PROPOSED FILTER FENCE BARRIER ID
  - 1190 --- DETAIL NUMBER
  - 1190 --- SHEET NUMBER
  - 1190 --- BERM BREACH LOCATION
  - 1190 --- MOUNTABLE RAMP OVER BERM

**SEDIMENT BARRIER TABLE**

BARRIER ID	SIZE
(A)	18" FILTER FENCE
(B)	30" FILTER FENCE
(C)	SUPER SALT FENCE
(D)	24" COMPOST FILTER SOCK
(E)	32" COMPOST FILTER SOCK

NOTES:  
THE FOLLOWING SEDIMENT BARRIERS CAN BE SUBSTITUTED WITH APPROVAL FROM SWN PRODUCTION COMPANY, LLC:  
- 18" SALT FENCE FOR 12" COMPOST FILTER SOCK  
- 30" SALT FENCE FOR 18" COMPOST FILTER SOCK  
- SUPER SALT FENCE FOR 24" COMPOST FILTER SOCK



**WVDEP OOG  
ACCEPTED AS-BUILT**

*WJL* 5/30/2017

- REFERENCE**
- USGS TOPOGRAPHIC MAP / ARCGIS MAP SERVICE  
HTTP://DOTS.ARCGIS.COM/ARCSDE/TOPO\_MAPS/ Accessed 11/14/2016; WALEVILLE, WV QUAD AND LITTLETON, WV QUAD.
  - EXISTING CONDITIONS AND CONTOURS ARE DERIVED FROM A COMBINATION OF AS-BUILT TOPOGRAPHY FILE "DAMEL SURVEY WET 200156617.DWG" (07-18-2018 DWG) WAS PROVIDED BY SWN PRODUCTION COMPANY, LLC AUGUST 24, 2018 AND 3-METER SAMS DEM DATA, DATED 2003.
  - WETLAND AND STREAM DELINEATION PREPARED BY OTHERS.

**REVISION RECORD**

NO.	DATE	DESCRIPTION
1	11/14/2016	ISSUED FOR PERMITS
2	11/14/2016	REVISED PER WVAO COMMENTS

**Civil & Environmental Consultants, Inc.**  
333 Baldwin Road - Pittsburgh, PA 15205  
412-429-2324 - 800-366-2324  
www.cecinc.com

**SWN PRODUCTION COMPANY, LLC  
DURIG WELL PAD ENLARGEMENT PROJECT  
CENTER DISTRICT  
WETZEL COUNTY, WEST VIRGINIA**

**EROSION AND SEDIMENTATION CONTROL  
AND SITE RESTORATION PLAN**

DATE: MAY 2017 DRAWN BY: PJC  
DWG SCALE: 1"=20' CHECKED BY: PJC  
PROJECT NO: 17-007  
APPROVED BY: PJC

DRAWING NO: **C900**