



West Virginia Department of Environmental Protection
Office of Oil and Gas
WELL LOCATION FORM: GPS

API: 47-103-03188 WELL NO.: BIG 177 H2

FARM NAME: Coastal Forest Resources Co. dba Coastal Timberlands Co.

RESPONSIBLE PARTY NAME: EQT Production Company

COUNTY: Wetzel DISTRICT: Grant

QUADRANGLE: Big Run 7.5'

SURFACE OWNER: Coastal Forest Resources Co. dba Coastal Timberlands Co.

ROYALTY OWNER: Higgins Family Trust, et al.

UTM GPS NORTHING: 4381511

UTM GPS EASTING: 535728 GPS ELEVATION: 246 m (806 ft)

The Responsible Party named above has chosen to submit GPS coordinates in lieu of preparing a new well location plat for a plugging permit or assigned API number on the above well. The Office of Oil and Gas will not accept GPS coordinates that do not meet the following requirements:

1. Datum: NAD 1983, Zone: 17 North, Coordinate Units: meters, Altitude: height above mean sea level (MSL) – meters.
2. Accuracy to Datum – 3.05 meters
3. Data Collection Method:

Survey grade GPS _____ : Post Processed Differential _____
Real-Time Differential _____

Mapping Grade GPS X : Post Processed Differential X
Real-Time Differential _____

4. **Letter size copy of the topography map showing the well location.**

I the undersigned, hereby certify this data is correct to the best of my knowledge and belief and shows all the information required by law and the regulations issued and prescribed by the Office of Oil and Gas.

RECEIVED
Office of Oil and Gas

SEP 13 2021

WV Department of
Environmental Protection


Signature

PS# 2180
Title

6/9/2021
Date

Topo Quad: Big Run 7.5'

Scale: 1" = 2000'

4710303188

County: Wetzel


Date: June 07, 2021

District: Grant

Project No: 40-34-00-09

47-103-03188 BIG 177 H2

Topo

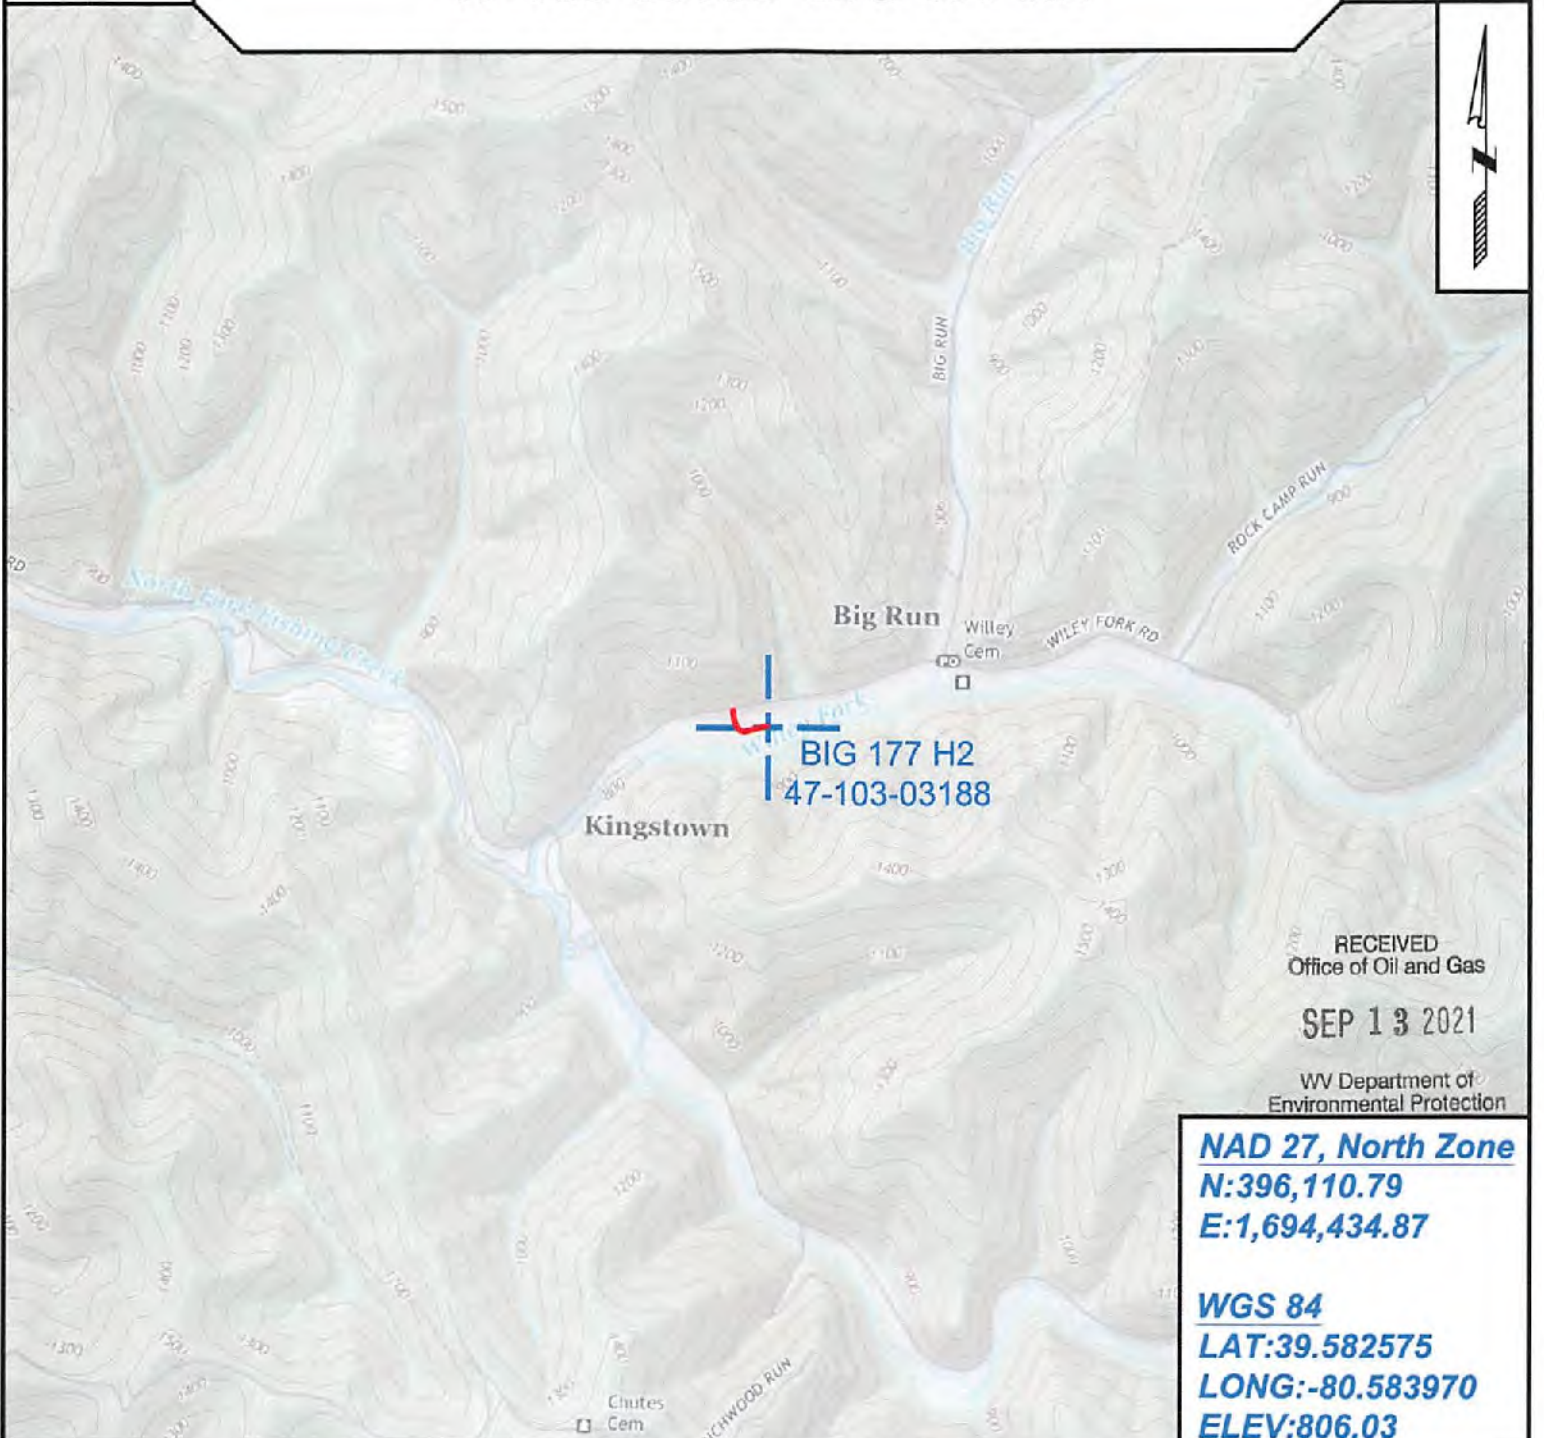

RECEIVED
Office of Oil and Gas

SEP 13 2021

WV Department of
Environmental Protection

NAD 27, North Zone
N:396,110.79
E:1,694,434.87

WGS 84
LAT:39.582575
LONG:-80.583970
ELEV:806.03



SURVEYING AND MAPPING SERVICES PERFORMED BY:

ALLEGHENY SURVEYS, INC.

1-800-482-8606
237 Birch River Road
Birch River, WV 26610
PH: (304) 649-8606
FAX: (304) 649-8608

PREPARED FOR:

EQT Production Company

400 Woodcliff Drive
Canonsburg, PA 15317

02/11/2022