

WW-7
8-30-06



West Virginia Department of Environmental Protection
Office of Oil and Gas
WELL LOCATION FORM: GPS

API: 47-103-30061 0333 WELL NO.: 7180

FARM NAME: LLOYD F. CAIN

RESPONSIBLE PARTY NAME: CONSOLIDATION COAL COMPANY

COUNTY: WETZEL DISTRICT: GRANT

QUADRANGLE: FOLSOM WV 7.5'

SURFACE OWNER: EVERETT & EDITH HAUGHT

ROYALTY OWNER: _____

UTM GPS NORTHING: 4,371,434 m (1076')

UTM GPS EASTING: 541,033 m GPS ELEVATION: 328 m

The Responsible Party named above has chosen to submit GPS coordinates in lieu of preparing a new well location plat for a plugging permit or assigned API number on the above well. The Office of Oil and Gas will not accept GPS coordinates that do not meet the following requirements:

- Datum: NAD 1983, Zone: 17 North, Coordinate Units: meters, Altitude: height above mean sea level (MSL) – meters.
- Accuracy to Datum – 3.05 meters
- Data Collection Method:

Survey grade GPS _____: Post Processed Differential _____
 Real-Time Differential _____
 Mapping Grade GPS X: Post Processed Differential X
 Real-Time Differential _____


RECEIVED
Office of Oil and Gas

SEP 27 2019

WV Department of
Environmental Protection

- Letter size copy of the topography map showing the well location.**

I the undersigned, hereby certify this data is correct to the best of my knowledge and belief and shows all the information required by law and the regulations issued and prescribed by the Office of Oil and Gas.

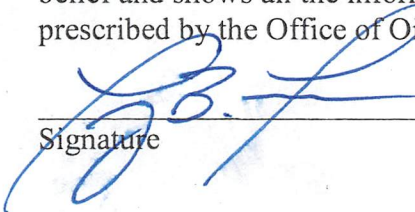

Signature

Professional Surveyor

Title

SEPTEMBER 17, 2019

Date

47-103-03333 P

FOLSOM QUADRANGLE
WEST VIRGINIA
7.5 MINUTE SERIES (TOPOGRAPHIC)
NE/4 CENTER POINT 15' QUADRANGLE

4953 III SW
(GLOVER GAP)

'39 32'30" '40 1 710 000 FEET '42 80° 30' 39° 30'



WELL #7180

RECEIVED
Office of Oil and Gas
SEP 27 2019
WV Department of
Environmental Protection

