



West Virginia Department of Environmental Protection
Office of Oil and Gas

WELL LOCATION FORM: GPS

API: 47-103-71350 WELL NO.: 8193

FARM NAME: H. A. FETTY

RESPONSIBLE PARTY NAME: WEST VIRGINIA LAND RESOURCES INC.

COUNTY: WETZEL DISTRICT: CHURCH

QUADRANGLE: HUNDRED W.VA,PA

SURFACE OWNER: JOHN W. HAYES

ROYALTY OWNER: _____

UTM GPS NORTHING: 4,389,704 m (1463')

UTM GPS EASTING: 551,290 m GPS ELEVATION: 446 m

The Responsible Party named above has chosen to submit GPS coordinates in lieu of preparing a new well location plat for a plugging permit or assigned API number on the above well. The Office of Oil and Gas will not accept GPS coordinates that do not meet the following requirements:

- Datum: NAD 1983, Zone: 17 North, Coordinate Units: meters, Altitude: height above mean sea level (MSL) – meters.
- Accuracy to Datum – 3.05 meters
- Data Collection Method:

Survey grade GPS _____ : Post Processed Differential _____

Real-Time Differential _____

Mapping Grade GPS X : Post Processed Differential X

Real-Time Differential _____

- Letter size copy of the topography map showing the well location.

I the undersigned, hereby certify this data is correct to the best of my knowledge and belief and shows all the information required by law and the regulations issued and prescribed by the Office of Oil and Gas.

Signature

Professional Surveyor

Title

MARCH 6, 2022


Date

RECEIVED
Office of Oil and Gas

APR 14 2022

WV Department of
Environmental Protection
04/22/2022

4710303501A

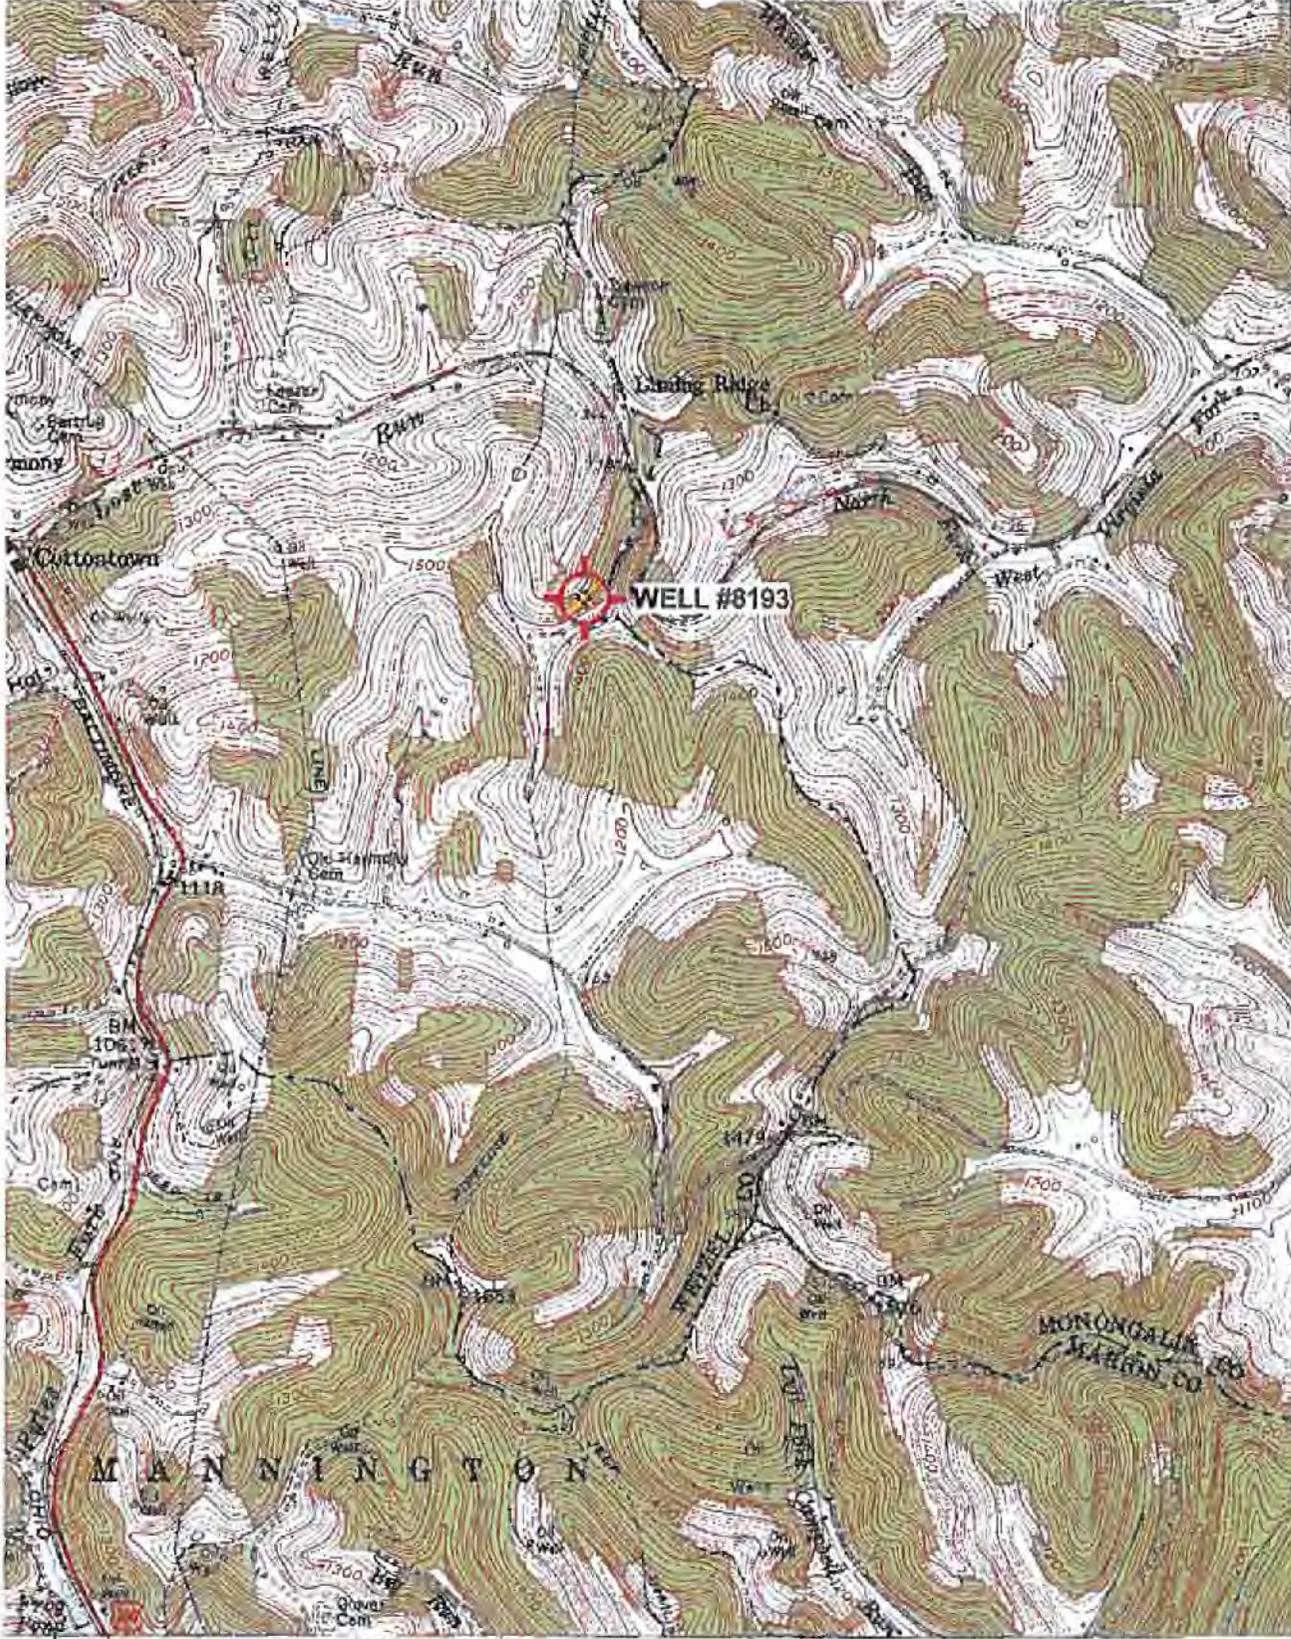

4291
40'

4289

North

120 000 FEET (PA.)

39°37'30"
80°22'30"

GAP 0.0 MI.
DNT 23 MI.

25' 1:250 000 FEET (PA.) *51

INTERNATIONAL SURVEY, RESTON, VIRGINIA—1977
452

1 MILE
7000 FEET
KILOMETER

ROAD CLASSIFICATION

- Heavy-duty —————
- Medium-duty —————
- Light-duty - - - - -
- Unimproved dirt - - - - -
- U S Route
- State Route



QUADRANGLE LOCATION

(MANNINGTON)
1952 1115E

RECEIVED
Office of Oil and Gas

APR 14 2022

HUNDRED, W. VA.—PA.
NW 1/4 MANNINGTON 15' QUADRANGLE
N3937.5—W8022.5/7.5

04/22/2022
Department of
Environmental Protection