


4710303565 P  
03/10/2023

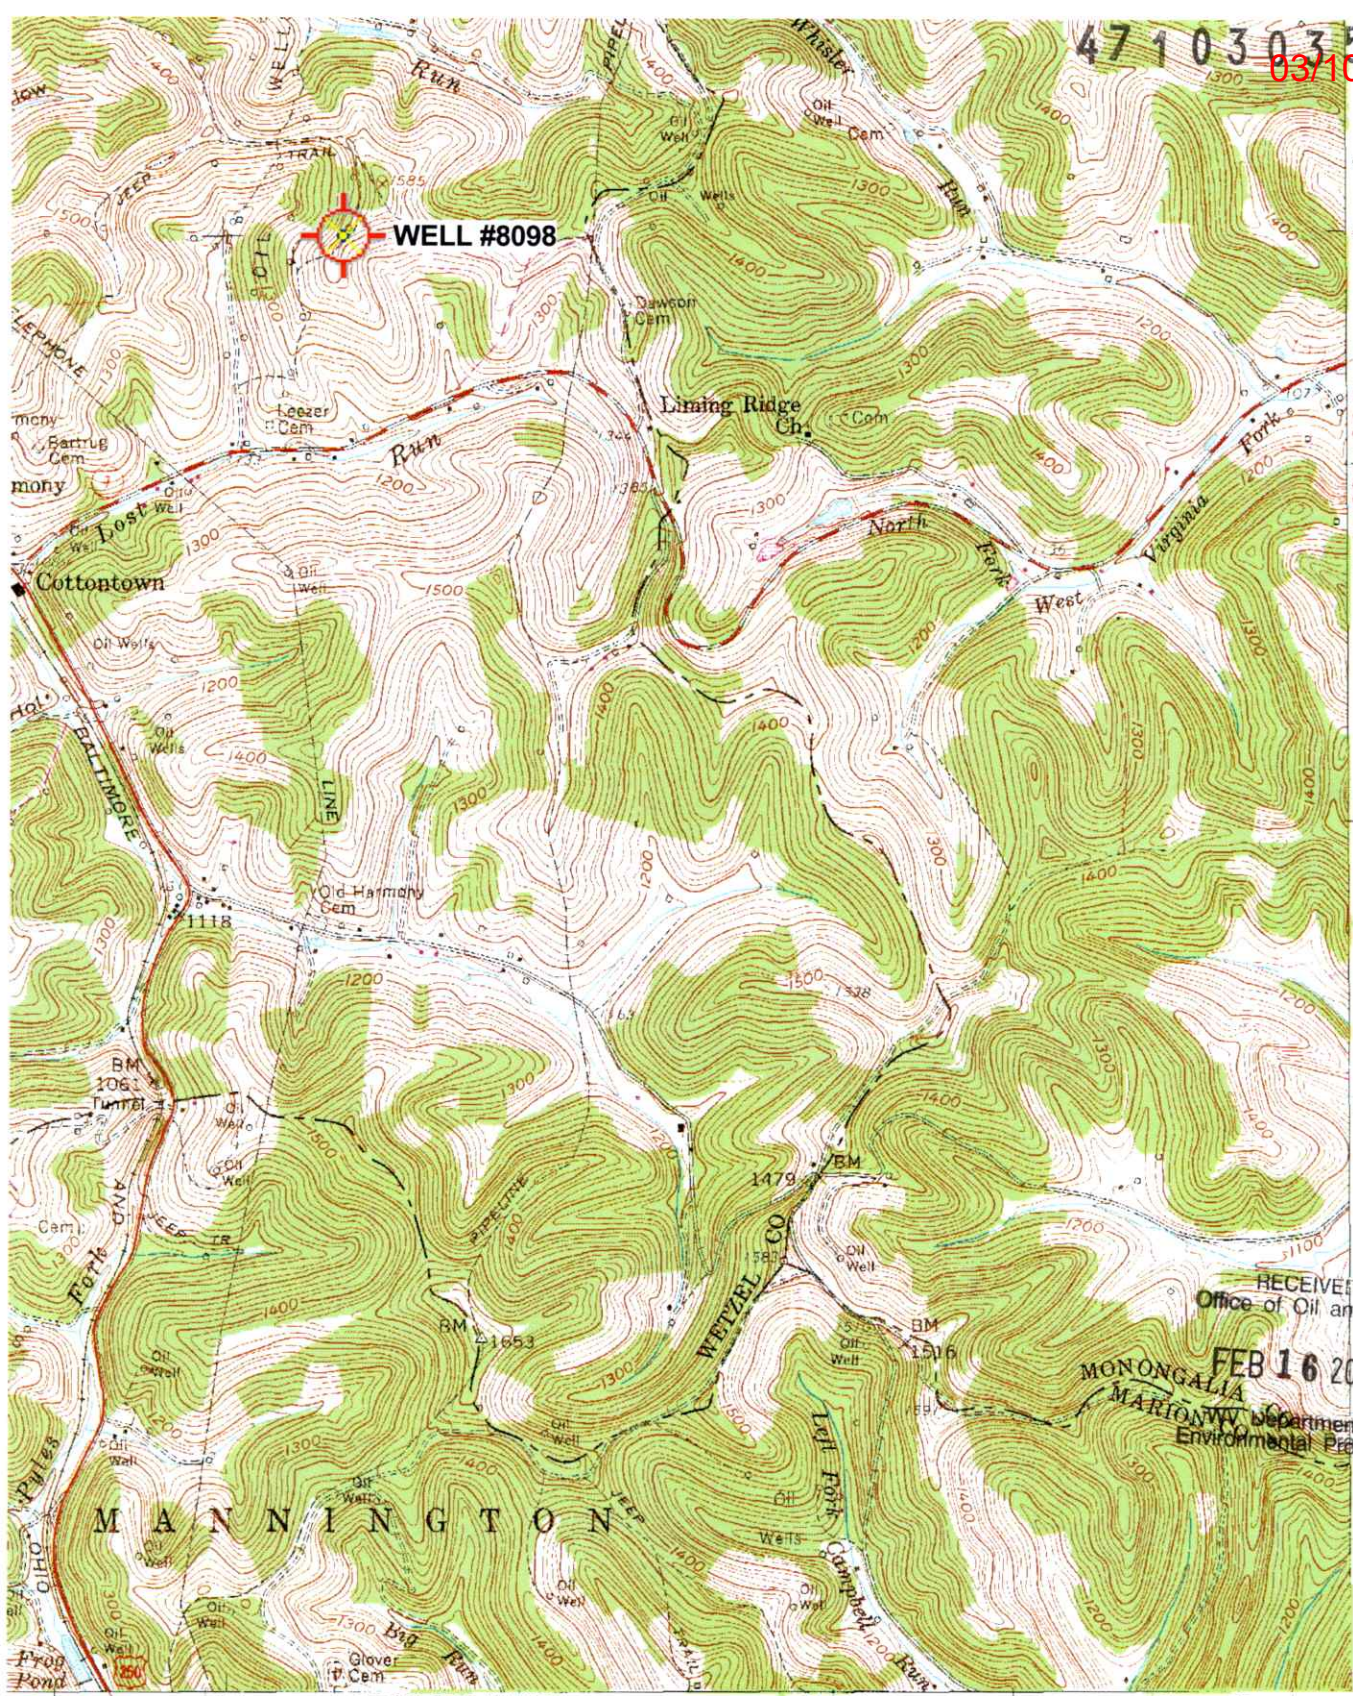

4391  
40'  
4389  
4388000N

RECEIVED  
Office of Oil and Gas  
FEB 16 2023  
MONONGALIA  
MARTIN  
Department of  
Environmental Protection

3AP 15 MI.  
7NT 23 MI.



125000 FEET (PA) 51  
52  
53  
ROAD CLASSIFICATION

Heavy-duty		Light-duty	
Medium-duty		Unimproved dirt	
	U.S. Route		State Route



QUADRANGLE LOCATION  
'Hundred; WV,PA' Scale: 1" = 0.379Mi 610Mt 2,000ft, 1 Mi = 2.640" . 1 cm = 240Mt

HUNDRED, W. VA.—PA.  
NW/4 MANNINGTON 15' QUADRANGLE  
N 3937.5—W 8022.5/7.5

(MANNINGTON)  
4963 III SE

03/10/2023

47 1 03 03 5 6 5 P

WW-7  
8-30-06



West Virginia Department of Environmental Protection  
Office of Oil and Gas

WELL LOCATION FORM: GPS

API: 47-103-30948 WELL NO.: 8098

FARM NAME: L. STANTON LEEZER

RESPONSIBLE PARTY NAME: WEST VIRGINIA LAND RESOURCES INC.

COUNTY: WETZEL DISTRICT: CHURCH

QUADRANGLE: HUNDRED W.VA, PA

SURFACE OWNER: LEEZER FAMILY IRREVOCABLE TRUST

ROYALTY OWNER: \_\_\_\_\_

UTM GPS NORTHING: 4,390,934 m

UTM GPS EASTING: 550,446 m GPS ELEVATION: 460 m (1509')

The Responsible Party named above has chosen to submit GPS coordinates in lieu of preparing a new well location plat for a plugging permit or assigned API number on the above well. The Office of Oil and Gas will not accept GPS coordinates that do not meet the following requirements:

- Datum: NAD 1983, Zone: 17 North, Coordinate Units: meters, Altitude: height above mean sea level (MSL) – meters.
- Accuracy to Datum – 3.05 meters
- Data Collection Method:  
Survey grade GPS \_\_\_\_: Post Processed Differential \_\_\_\_

RECEIVED  
Office of Oil and Gas

FEB 16 2023

WV Department of  
Environmental Protection

Real-Time Differential \_\_\_\_  
Mapping Grade GPS X: Post Processed Differential X  
Real-Time Differential \_\_\_\_

4. Letter size copy of the topography map showing the well location.

I the undersigned, hereby certify this data is correct to the best of my knowledge and belief and shows all the information required by law and the regulations issued and prescribed by the Office of Oil and Gas.

Signature

Professional Surveyor  
Title

JANUARY 25, 2023  
Date

Stephen McCoy