


RECEIVED
Office of Oil and Gas

FEB 27 2023

WV Department of Environmental Protection
(WALL 1982 2111)

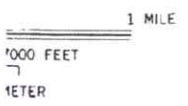

QUADRANGLE LOCATION

'Big Run; WV' Scale: 1" = 0.379Mi 610Mt 2,000Ft, 1 Mi = 2.640" , 1 cm = 240Mt

ROAD CLASSIFICATION

- Heavy-duty Light-duty
- Medium-duty Unimproved dirt

Slate Route

BIG RUN, W. VA.
SE/4 LITTLETON 15' QUADRANGLE
N3930—W8030/7.5

03/10/2023

47 1 03 03 5 6 8 P

WW-7
8-30-06



West Virginia Department of Environmental Protection
Office of Oil and Gas

WELL LOCATION FORM: GPS

API: 47-103-72322 WELL NO.: 7454

FARM NAME: DAVE NORRIS

RESPONSIBLE PARTY NAME: WEST VIRGINIA LAND RESOURCES INC.

COUNTY: WETZEL DISTRICT: GRANT

QUADRANGLE: BIG RUN W.VA

SURFACE OWNER: R.L. ENSMINGER EST. & NILA EINSMINGER

ROYALTY OWNER: _____

UTM GPS NORTHING: 4,374,235 m (1086')

UTM GPS EASTING: 541,267 m GPS ELEVATION: 331 m

The Responsible Party named above has chosen to submit GPS coordinates in lieu of preparing a new well location plat for a plugging permit or assigned API number on the above well. The Office of Oil and Gas will not accept GPS coordinates that do not meet the following requirements:

- Datum: NAD 1983, Zone: 17 North, Coordinate Units: meters, Altitude: height above mean sea level (MSL) – meters.
- Accuracy to Datum – 3.05 meters
- Data Collection Method:

Survey grade GPS _____: Post Processed Differential _____


Real-Time Differential _____

Mapping Grade GPS X: Post Processed Differential X

Real-Time Differential _____

- Letter size copy of the topography map showing the well location.

I the undersigned, hereby certify this data is correct to the best of my knowledge and belief and shows all the information required by law and the regulations issued and prescribed by the Office of Oil and Gas.

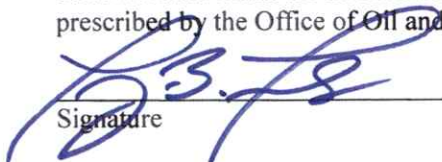
Signature

Professional Surveyor

Title

OCTOBER 28, 2022

Date

RECEIVED
Office of Oil and Gas

FEB 27 2023

WV Department of
Environmental Protection