


4710303623



32'30"
 376
 375
 374
 373000N
 39°30'

39 32'30" 40 41 80°30'

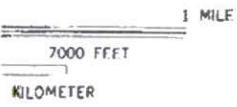

RECEIVED
 Office of Oil and Gas

OCT 18 2023

WV Department of
 Environmental Protection



ROAD CLASSIFICATION

- Heavy-duty (thick red line)
- Light-duty (thin red line)
- Medium-duty (dashed red line)
- Un improved dirt (dotted red line)
- Slate Route (dashed black line)

(WALLACE)
 1982 BY NW

BIG RUN, W. VA.

SE/4 LITTLETON 15' QUAD 11/10/2023

'Big Run: WV Scale: 1" = 0.379Mi 610Mt 2.000Ft. 1 Mi = 2.640" . 1 cm = 240Mi

WW-7
8-30-06

47-10303623



West Virginia Department of Environmental Protection
Office of Oil and Gas

WELL LOCATION FORM: GPS

API: 47-103- WELL NO.: 7320

FARM NAME: CHAS GILBERT

RESPONSIBLE PARTY NAME: WEST VIRGINIA LAND RESOURCES INC.

COUNTY: WETZEL DISTRICT: GRANT

QUADRANGLE: BIG RUN W.VA

SURFACE OWNER: COASTAL FOREST RESOURCES

ROYALTY OWNER: _____

UTM GPS NORTHING: 4,374,951 m

UTM GPS EASTING: 540,192 m GPS ELEVATION: 355 m

The Responsible Party named above has chosen to submit GPS coordinates in lieu of preparing a new well location plat for a plugging permit or assigned API number on the above well. The Office of Oil and Gas will not accept GPS coordinates that do not meet the following requirements:

- Datum: NAD 1983, Zone: 17 North, Coordinate Units: meters, Altitude: height above mean sea level (MSL) – meters.
- Accuracy to Datum – 3.05 meters
- Data Collection Method:

Survey grade GPS _____ : Post Processed Differential _____
 _____ Real-Time Differential _____
 Mapping Grade GPS X : Post Processed Differential X
 _____ Real-Time Differential _____


RECEIVED
Office of Oil and Gas

OCT 18 2023

WV Department of
Environmental Protection

- Letter size copy of the topography map showing the well location.

I the undersigned, hereby certify this data is correct to the best of my knowledge and belief and shows all the information required by law and the regulations issued and prescribed by the Office of Oil and Gas.

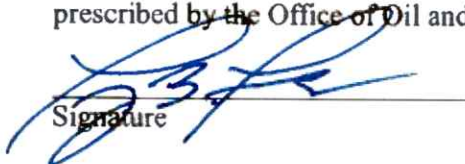
Signature

PS 2002
Title

OCTOBER 13, 2023

Date

11/10/2023