


47 1 03 0 3 6 7 9

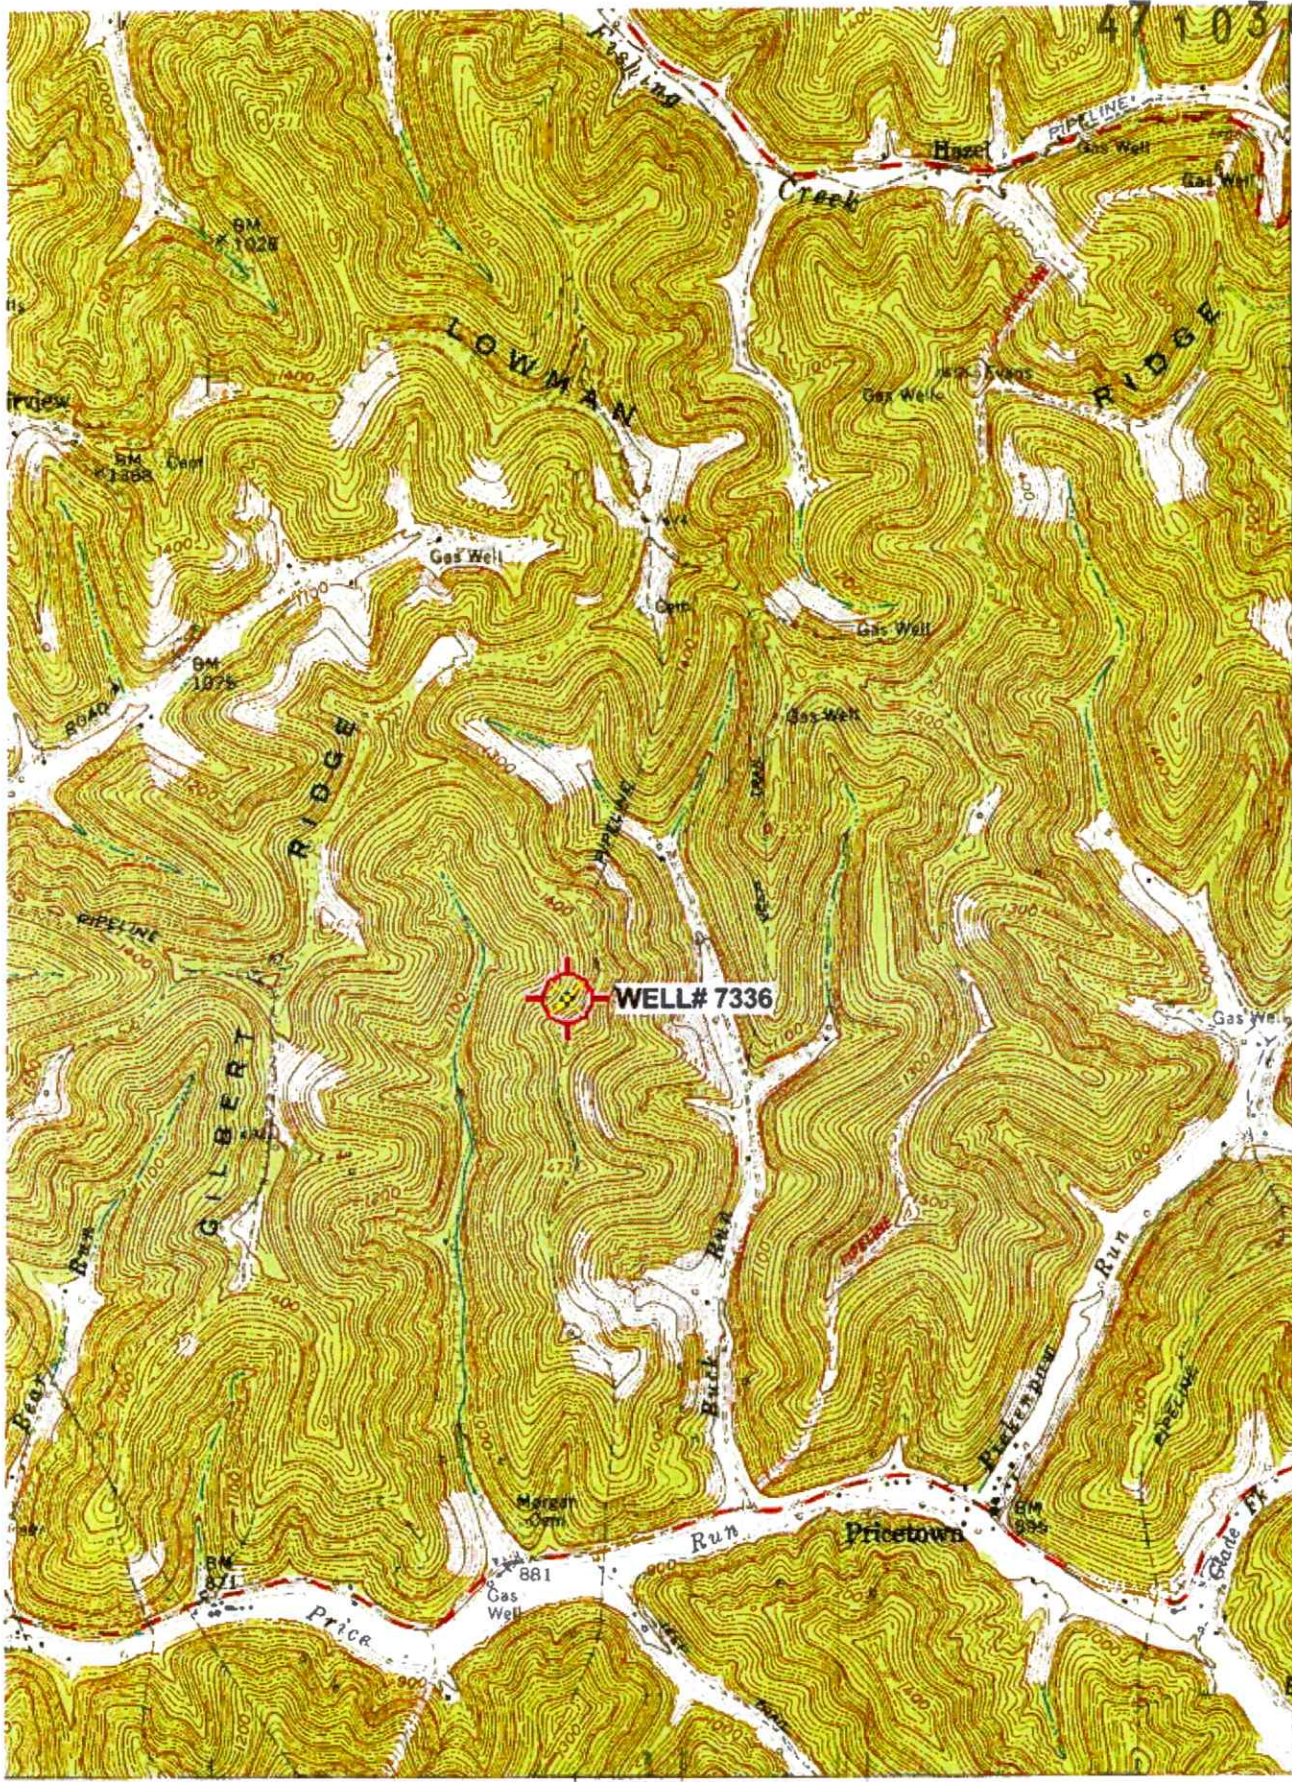

4377
32'30"

4376

4375

4374

RECEIVED
Office of Oil and Gas
AUG 12 2024
WV Department of
Environmental Protection

39° 30'
80° 30'

39 32'30" 40 41

INTERIOR GEOLOGICAL SURVEY, RESTON, VIRGINIA - 1977
642000E

1 MILE
7000 FEET
LOMETER


ROAD CLASSIFICATION

Heavy-duty ——— Light-duty ———
Medium-duty ——— Unimproved dirt ———

'Big Run; WV' Scale: 1" = 0.379Mi 610Mt 2,000Ft, 1 Mi = 2.640" , 1 cm = 240Mt

(WALLACE)
2023/11/14

08/23/2024

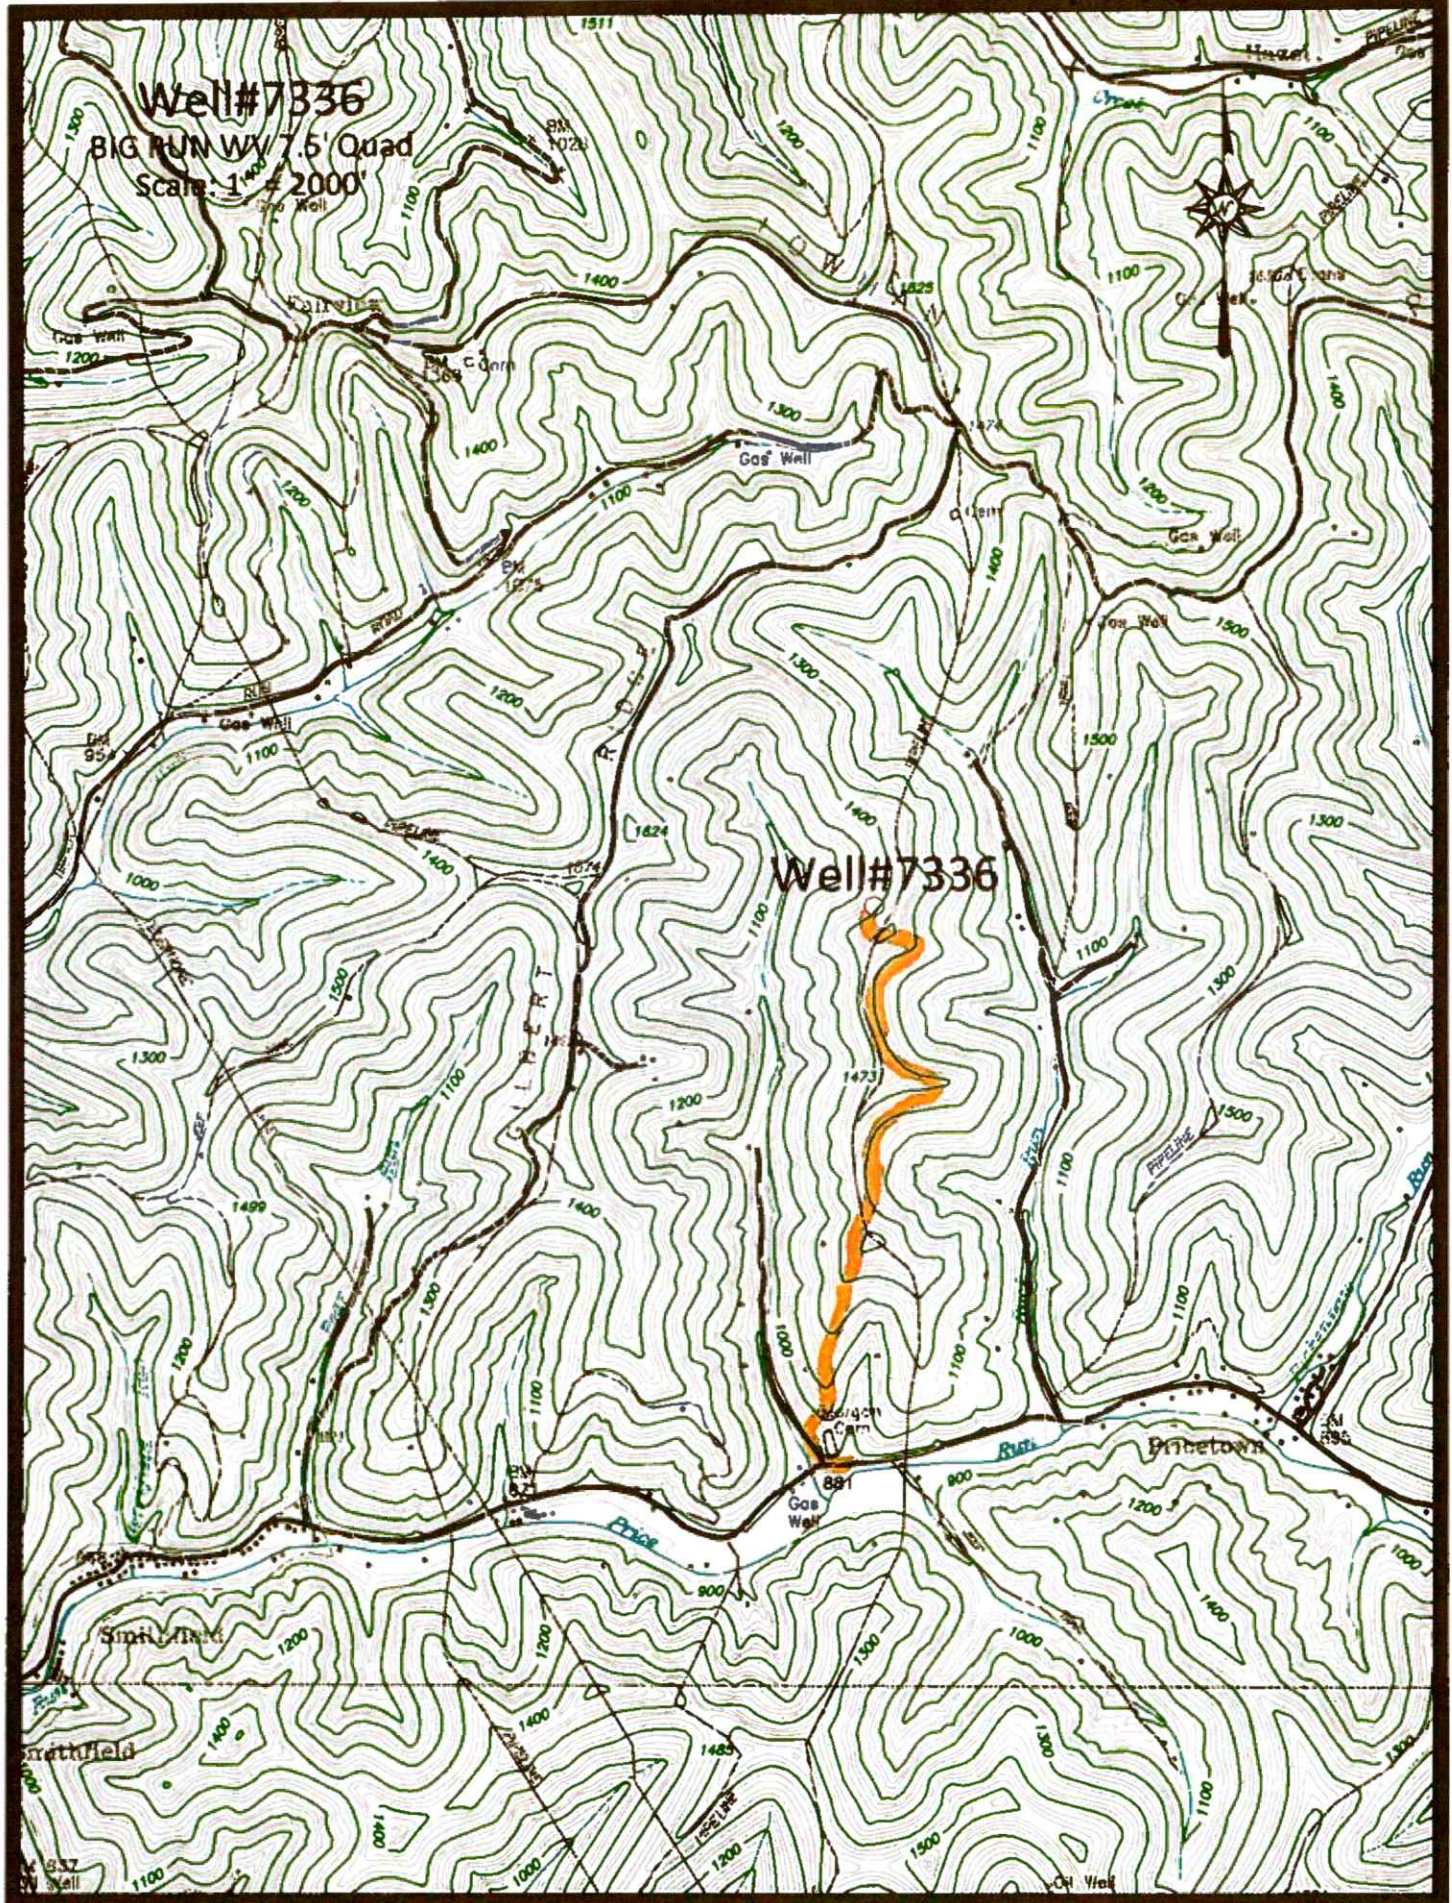

 Access Road

08/23/2024

Well#7336

BIG RUN WV 7.5' Quad

Scale: 1" = 500'

PIPELINE



1400

1100

Well#7336


1473

1200

RECEIVED
Office of Oil and Gas

AUG 12 2024

WV Department of
Environmental Protection

 Access Road

08/23/2024

47 103 03679

WW-7
8-30-06



West Virginia Department of Environmental Protection
Office of Oil and Gas

WELL LOCATION FORM: GPS

API: 47-103-72342 WELL NO.: 7336

FARM NAME: B W PETERSON 83

RESPONSIBLE PARTY NAME: WEST VIRGINIA LAND RESOURCES INC.

COUNTY: WETZEL DISTRICT: GRANT

QUADRANGLE: BIG RUN WV

SURFACE OWNER: DALLISON LUMBER INC.

ROYALTY OWNER: _____

UTM GPS NORTHING: 4,374,942 m

UTM GPS EASTING: 540,592 m GPS ELEVATION: 421 m

The Responsible Party named above has chosen to submit GPS coordinates in lieu of preparing a new well location plat for a plugging permit or assigned API number on the above well. The Office of Oil and Gas will not accept GPS coordinates that do not meet the following requirements:


- Datum: NAD 1983, Zone: 17 North, Coordinate Units: meters, Altitude: height above mean sea level (MSL) - meters.
- Accuracy to Datum - 3.05 meters
- Data Collection Method:
 - Survey grade GPS : Post Processed Differential
 - Real-Time Differential

Mapping Grade GPS : Post Processed Differential

Real-Time Differential

- Letter size copy of the topography map showing the well location.**

I the undersigned, hereby certify this data is correct to the best of my knowledge and belief and shows all the information required by law and the regulations issued and prescribed by the Office of Oil and Gas.

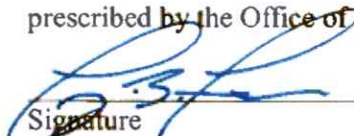
Signature

PS 2002
Title

AUGUST 5, 2024
Date

RECEIVED
Office of Oil and Gas
AUG 12 2024
WV Department of
Environmental Protection

08/23/2024