


47 1 0 3 0 3 6 8 7

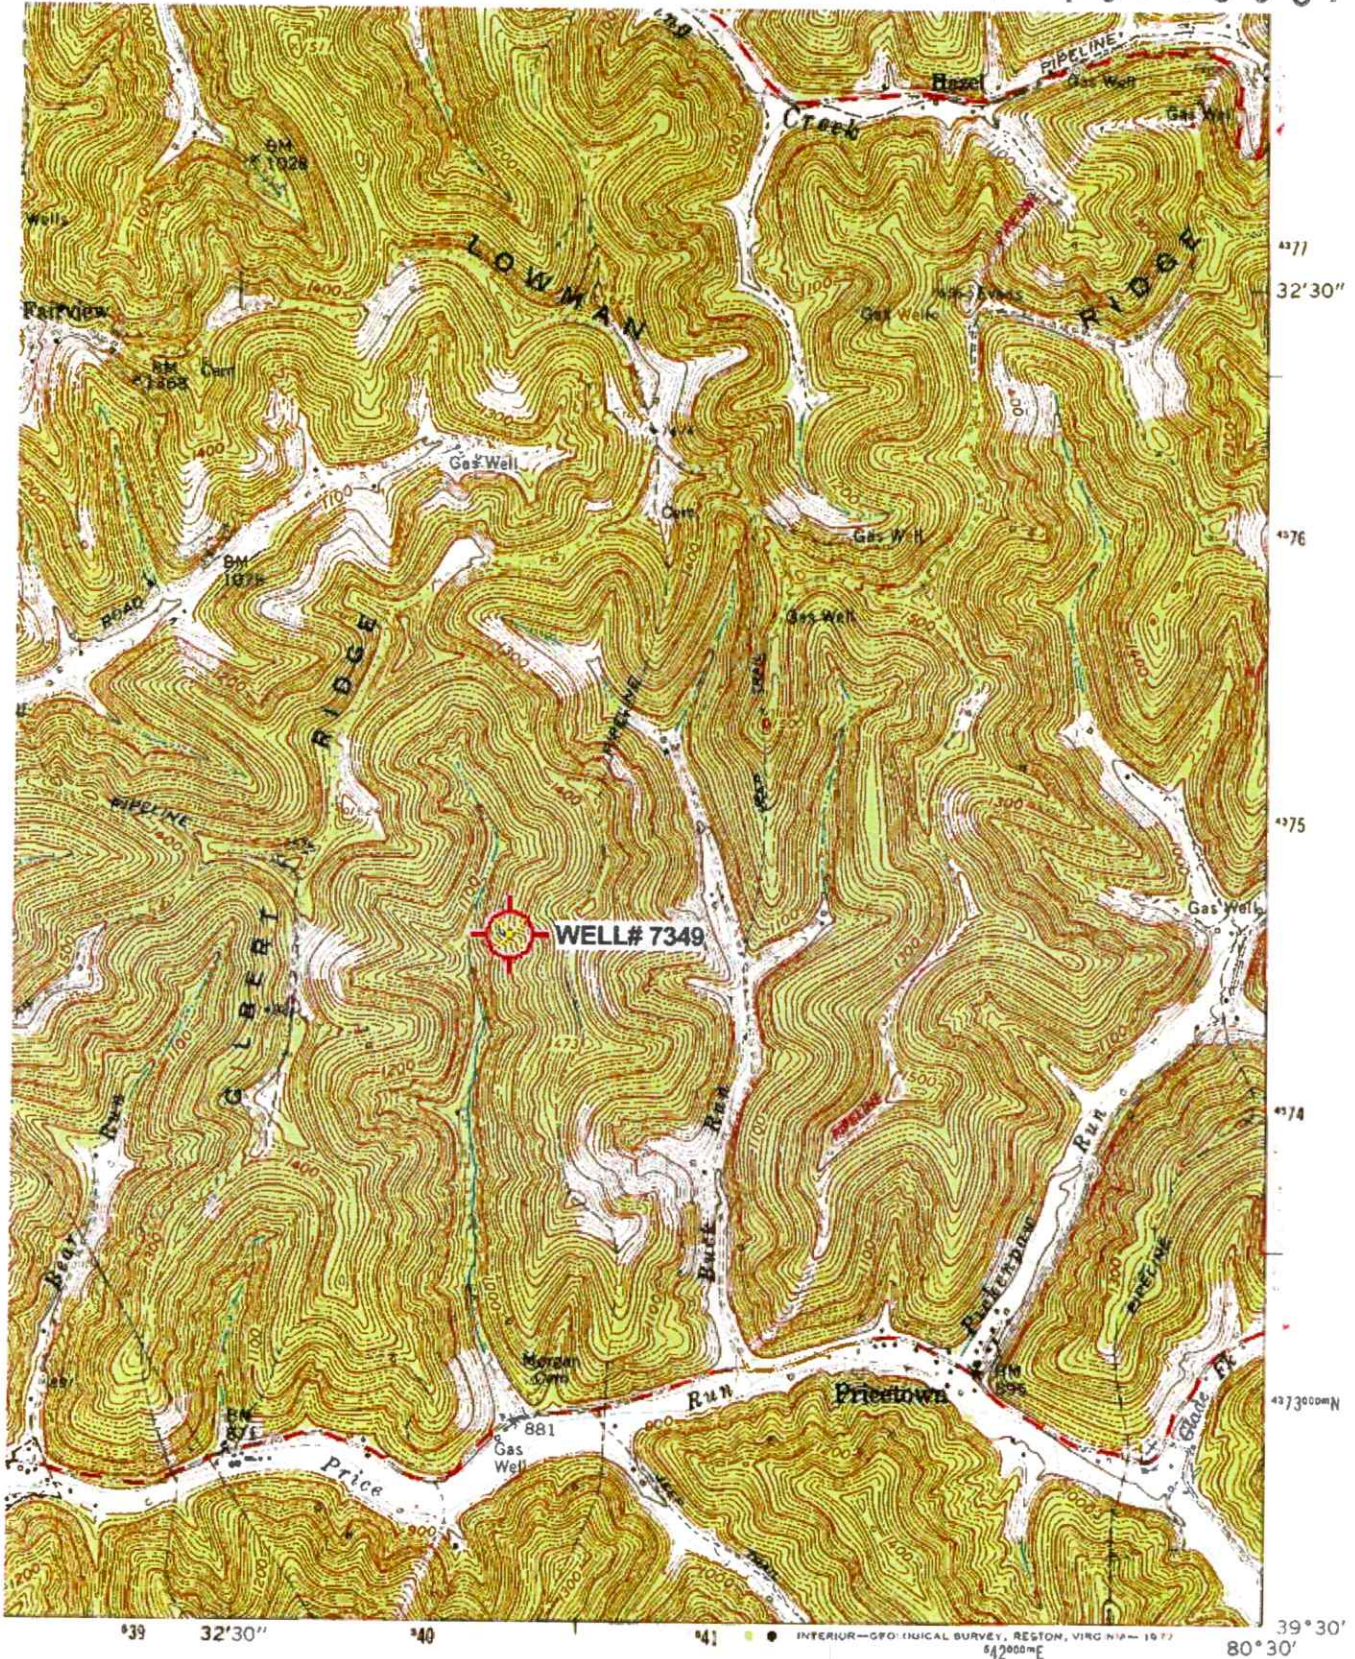

'Big Run; WV' Scale: 1" = 0.379Mi 610M 2,000Ft, 1 Mi = 2.640", 1 cm = 240M

ROAD CLASSIFICATION

- Heavy-duty Light-duty
- Medium-duty Unimproved dirt

Slate Run
SEP 20 2024

WV Department of Environmental Protection
09/27/2024

(WALLACE)
4882 N.W.

47 1 0 3 0 3 6 8 7

RECEIVED
Office of Oil and Gas

SEP 20 2024

Department of
Environmental Protection

08/19/2011 02:04

09/27/2024

4710303687

103-72392

37

103-03623

103-70090

103-31133

103-72340

103-72341

103-30600

103-03680

103-72339

103-03679

RECEIVED
Office of Oil and Gas

SEP 20 2024

WV Department of
Environmental Protection

103-30427

09/27/2024

47 1 03 03 6 8 7

WW-7
8-30-06



West Virginia Department of Environmental Protection
Office of Oil and Gas

WELL LOCATION FORM: GPS

API: 47-103-72341 WELL NO.: 7349

FARM NAME: B W PETERSON 3

RESPONSIBLE PARTY NAME: WEST VIRGINIA LAND RESOURCES INC.

COUNTY: WETZEL DISTRICT: GRANT

QUADRANGLE: BIG RUN WV

SURFACE OWNER: DALLISON LUMBER INC.

ROYALTY OWNER: _____

UTM GPS NORTHING: 4,374,761 m

UTM GPS EASTING: 540,371 m GPS ELEVATION: 379 m

The Responsible Party named above has chosen to submit GPS coordinates in lieu of preparing a new well location plat for a plugging permit or assigned API number on the above well. The Office of Oil and Gas will not accept GPS coordinates that do not meet the following requirements:

- Datum: NAD 1983, Zone: 17 North, Coordinate Units: meters, Altitude: height above mean sea level (MSL) – meters.
- Accuracy to Datum – 3.05 meters
- Data Collection Method:

Survey grade GPS x : Post Processed Differential X


Real-Time Differential _____

Mapping Grade GPS _____ : Post Processed Differential _____

Real-Time Differential _____

- Letter size copy of the topography map showing the well location.**

I the undersigned, hereby certify this data is correct to the best of my knowledge and belief and shows all the information required by law and the regulations issued and prescribed by the Office of Oil and Gas.


Signature

PS 2002
Title

SEPTEMBER 5, 2024
Date

RECEIVED
Office of Oil and Gas

SEP 20 2024

WV Department of
Environmental Protection

09/27/2024