


4710303690

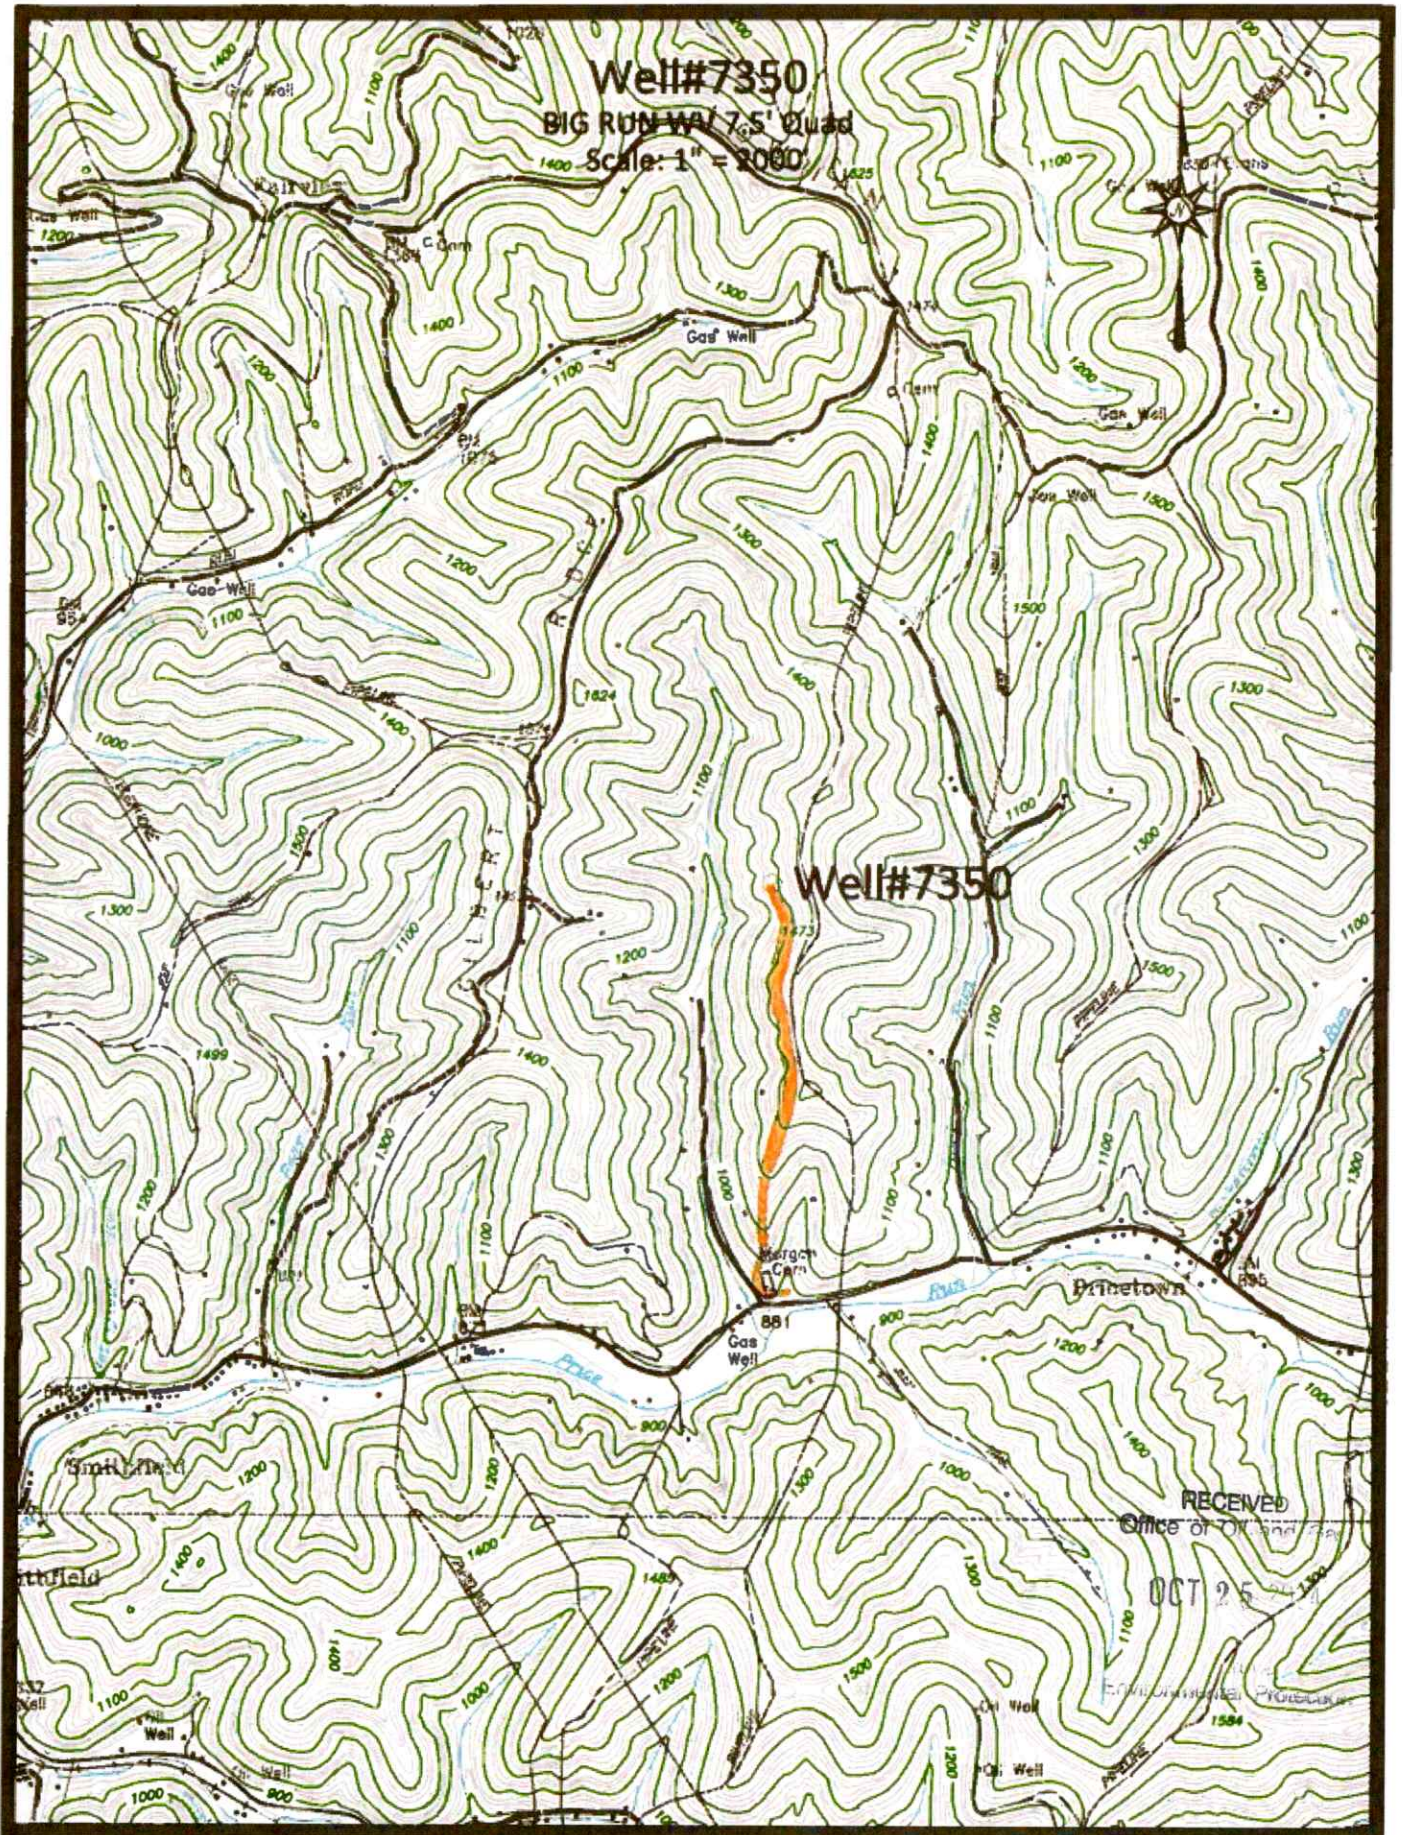

Access Road 

11/15/2024

47 10303690

Well#7350

BIG RUN WV 7.5' Quad


624



1100

1400

Well#7350

1473

1200

RECEIVED  
Office of Oil and Gas


OCT 25 2024

Environmental Protection

Access Road 

11/15/2024

47 10 30 30 0

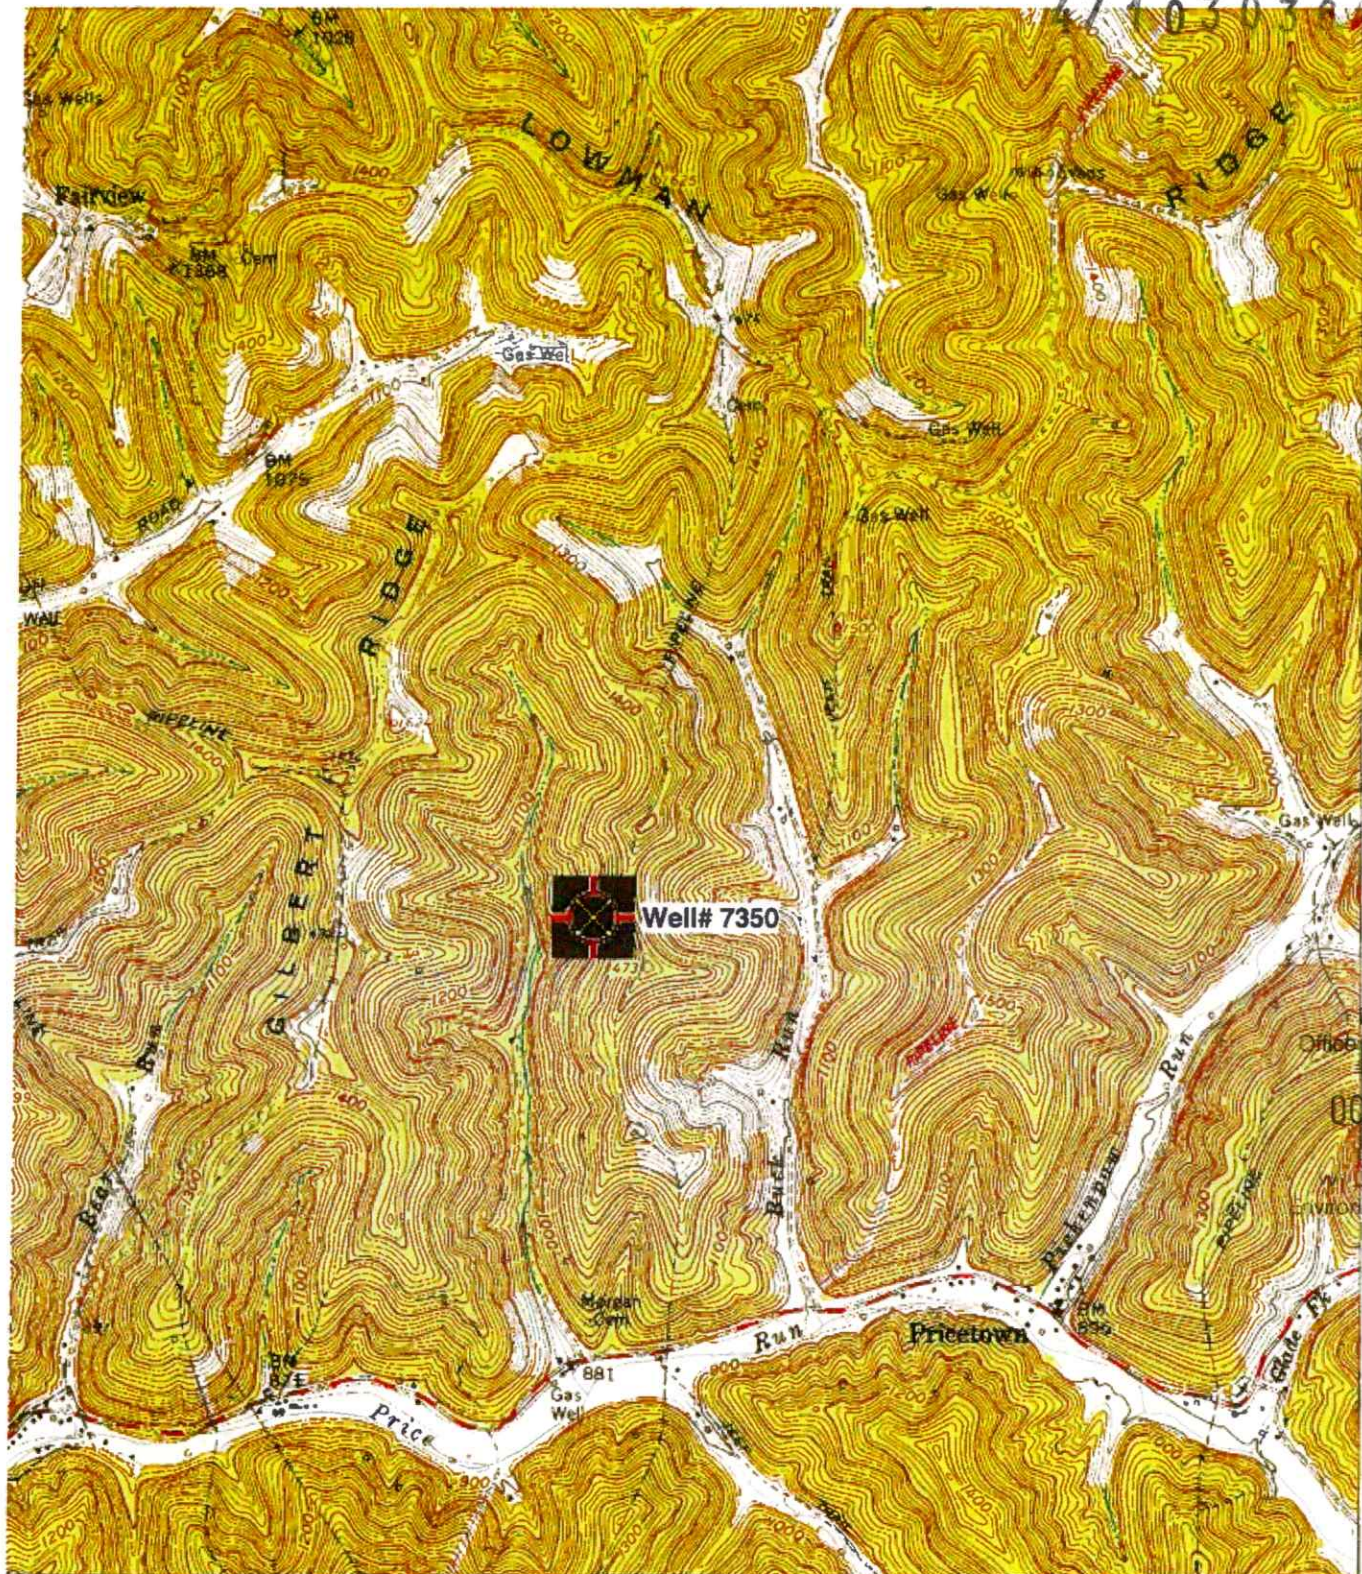

477  
32'30"

476

475


RECEIVED  
Office of Oil and Gas

OCT 25 2024

Department of  
Environmental Protection

473  
39° 30'

39 32'30" 40 41 80° 30'

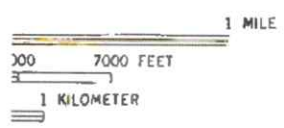

ROAD CLASSIFICATION

- Heavy duty ————
- Medium duty ————
- Light-duty ————
- Unimproved dirt - - - - -
- State Route ————



BIG RUN, W. VA.  
SE/4 LITTLETON 15 QUADRANGLE  
N3930—W8030/7.5

APDS  
'Big Run; WV' Scale: 1" = 0.379Mi 610Mt 2,000Ft, 1 Mi = 2.640", 1 cm = 240Mt

1060 11/15/2024

(WALLACE)  
4882 N NW



WW-7  
8-30-06



West Virginia Department of Environmental Protection  
Office of Oil and Gas  
**WELL LOCATION FORM: GPS**

API: 47-103-72339 WELL NO.: 7350

FARM NAME: GUMP 3

RESPONSIBLE PARTY NAME: WEST VIRGINIA LAND RESOURCES INC.

COUNTY: WETZEL DISTRICT: GRANT

QUADRANGLE: BIG RUN WV

SURFACE OWNER: DALLISON LUMBER INC.

ROYALTY OWNER: \_\_\_\_\_

UTM GPS NORTHING: 4,374,548. m

UTM GPS EASTING: 540,458 m GPS ELEVATION: 391 m

The Responsible Party named above has chosen to submit GPS coordinates in lieu of preparing a new well location plat for a plugging permit or assigned API number on the above well. The Office of Oil and Gas will not accept GPS coordinates that do not meet the following requirements:

1. Datum: NAD 1983, Zone: 17 North, Coordinate Units: meters, Altitude: height above mean sea level (MSL) – meters.

2. Accuracy to Datum – 3.05 meters

3. Data Collection Method:

Survey grade GPS X : Post Processed Differential X


Real-Time Differential \_\_\_\_\_

Mapping Grade GPS \_\_\_\_\_ : Post Processed Differential \_\_\_\_\_

Real-Time Differential \_\_\_\_\_

4. **Letter size copy of the topography map showing the well location.**

I the undersigned, hereby certify this data is correct to the best of my knowledge and belief and shows all the information required by law and the regulations issued and prescribed by the Office of Oil and Gas.

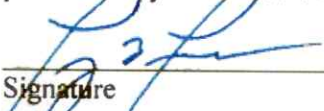  
\_\_\_\_\_  
Signature

PS 2002  
\_\_\_\_\_  
Title

OCTOBER 11, 2024  
\_\_\_\_\_  
Date

RECEIVED  
Office of Oil and Gas

OCT 25 2024

WV Department of  
Environmental Protection