

4710303812




09/21/2011 23:46

02/06/2026



WELL #7368  
BIG RUN WV 7.5' Quad  
Scale: 1" = 2000'

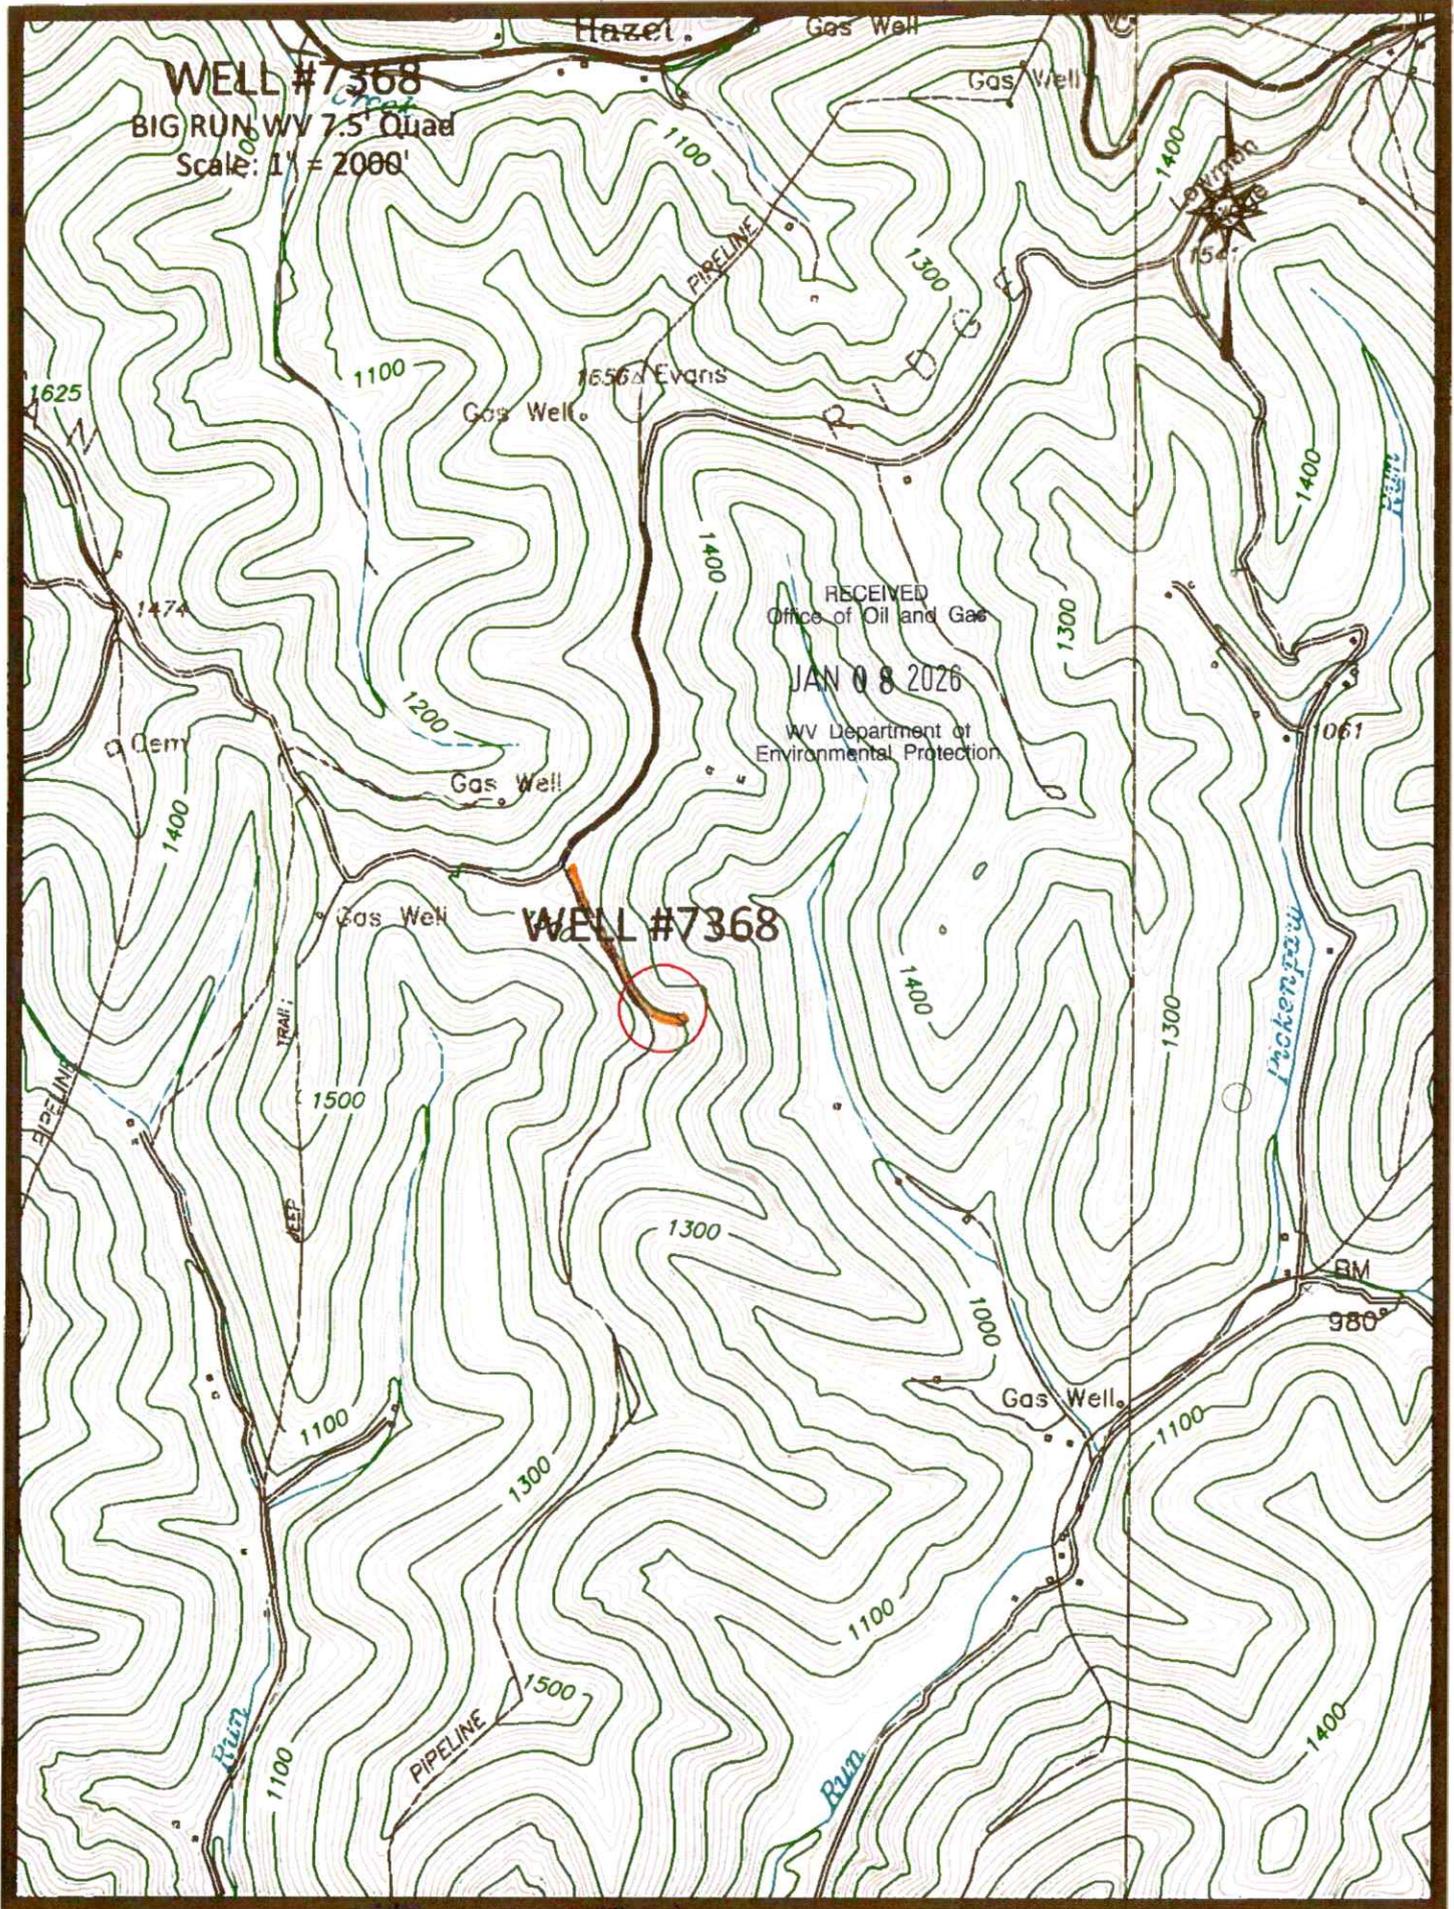

RECEIVED  
Office of Oil and Gas  
JAN 08 2026  
WV Department of  
Environmental Protection

WELL #7368

Access Road



02/06/2026

WELL# 7368

BIG RUN WV 7.5' Quad

Scale: 1" = 500'



Gas Well

RECEIVED  
Office of Oil and Gas

JAN 08 2026

WV Department of  
Environmental Protection

Well

1500

WELL #7368

1400

1300

 Access Road

02/06/2026

WW-7  
8-30-06

47 1 0 3 0 3 8 1 2

RECEIVED  
Office of Oil and Gas

JAN 08 2026

WV Department of  
Environmental Protection



West Virginia Department of Environmental Protection  
Office of Oil and Gas  
WELL LOCATION FORM: GPS

API: 47-103-72294 WELL NO.: ~~7368~~ 7368

FARM NAME: PRICE #4

RESPONSIBLE PARTY NAME: WEST VIRGINIA LAND RESOURCES INC.

COUNTY: WETZEL DISTRICT: GRANT

QUADRANGLE: BIG RUN WV

SURFACE OWNER: TALL TIMBER INC

ROYALTY OWNER: \_\_\_\_\_

UTM GPS NORTHING: 4,375,692 m

UTM GPS EASTING: 542,006 m GPS ELEVATION: 462 m

The Responsible Party named above has chosen to submit GPS coordinates in lieu of preparing a new well location plat for a plugging permit or assigned API number on the above well. The Office of Oil and Gas will not accept GPS coordinates that do not meet the following requirements:

- Datum: NAD 1983, Zone: 17 North, Coordinate Units: meters, Altitude: height above mean sea level (MSL) – meters.
- Accuracy to Datum – 3.05 meters
- Data Collection Method: Survey grade GPS X : Post Processed Differential

Real-Time Differential

Mapping Grade GPS : Post Processed Differential \_\_\_\_\_

Real-Time Differential \_\_\_\_\_

- Letter size copy of the topography map showing the well location.

I the undersigned, hereby certify this data is correct to the best of my knowledge and belief and shows all the information required by law and the regulations issued and prescribed by the Office of Oil and Gas.

Signature

PS 2002

Title

NOVEMBER 20, 2025

Date

02/06/2026