

0.25 W

463 4.68 2

Abd.

Company	Geo. F. Eagon
Address	New Martinsville, W. Va.
Farm	F.M. Huggans
Tract	Acres 7-1/8 Lease No.
Well (Farm) No.	1 Serial No.
Elevation (Spirit Level)	931'
Quadrangle	New Martinsville <b>NE</b>
County	Wetzel District Proctor
Engineer	F.W. Parsons
Engineer's Registration No.	203
File No.	Drawing No.
Date	Dec. 6, 1937 Scale 1"-200'

STATE OF WEST VIRGINIA  
 Department of Mines  
 OIL AND GAS DIVISION  
 CHARLESTON


WELL LOCATION MAP

File No. WET-249A

+ Denotes location of well on United States Topographic Maps, scale 1 to 62,500, latitude and longitude lines being represented by border lines as shown.

— Denotes one inch spaces on border line of original tracing.

Latitude

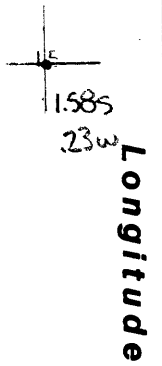

Topo Location

7.5' Loc. \_\_\_\_\_ 15' Loc. \_\_\_\_\_  
 \_\_\_\_\_ (calc.) \_\_\_\_\_

#287 MTW Co Rep't 1909

Company J Stamm & Co

Farm FM Huggins #1

15' Quad \_\_\_\_\_  
(sec.)

7.5' Quad New Martinsville

District Prector

WELL LOCATION PLAT

County 103 Permit 76529

RECEIVED  
DEC 21 1987  


200

34

Proctor District, Netzel County, W. Va.

By George E. Hagon, New Martinsville, W. Va.

Abandoned under permit 1581-249, issued 12-15-37 (Dec. report).

**SMITH PLAT.**

Location recalculated and spotted by AGF:

0.25 mi. N. of 80° 45' and 4.68 mi. S. of 39° 45' - NE -  
New Martinsville Quadrangle.

On east side of Garner Run.

On 7 1/8 acres.

Elevation, 931' ±.

Plat from Smith Dec. 21, 1937.

G. L. Hinchert leveled in from South Penn well on Mori Pough No. 1,  
65' lower; all the record I have or know of.  
Drilled in 1899 (Pough or Huggans well?)

	ZERI FAUGH NO. 1. (Owned by South Penn Oil Co.)	THIS WOULD BE MY RECORD. (Huggans).
Conductor	16	....
10" casing	1021	None
8 1/2" casing	1303	None
6" casing	1890	1825
Pittsburgh Coal	804	739
Top of Dankard <sup>?</sup> Sand	1951	1886
Bottom of Dankard <sup>?</sup> Sand	2300	2135
Top of Gordon Sand	2614	2749
Oil in Gordon Sand	2614	2749
Bottom of Gordon Sand	2824	2759
Total depth	2825	2760

*This record  
repeated  
O. F. No. 749*

Proctor District, Wetzel County, W. Va.

By J. Stamm & Co.

Completed, 1901.

Elevation, 995' B..

Gordon oil well.

Casing: 10", 205'; 8", 1170'; 6", 1853'; 5-5/8", 2060'.

Original production, 150 bbls. Present 2 to 3 bbls.

	Top.	Bottom.
Mapletown Coal	638	
Pittsburgh Coal	728	735
Water, 1490'.		
Water, 1510', in Lower Gas SS		
Pencil Cave	1800	1815
Big Line	1815	1865
Big Injun Sand	1865	
Berea Sand	2505	2515
Red rock	2580	2660
Sand, Gordon	2740	2745
Total depth (still in sand)		2745