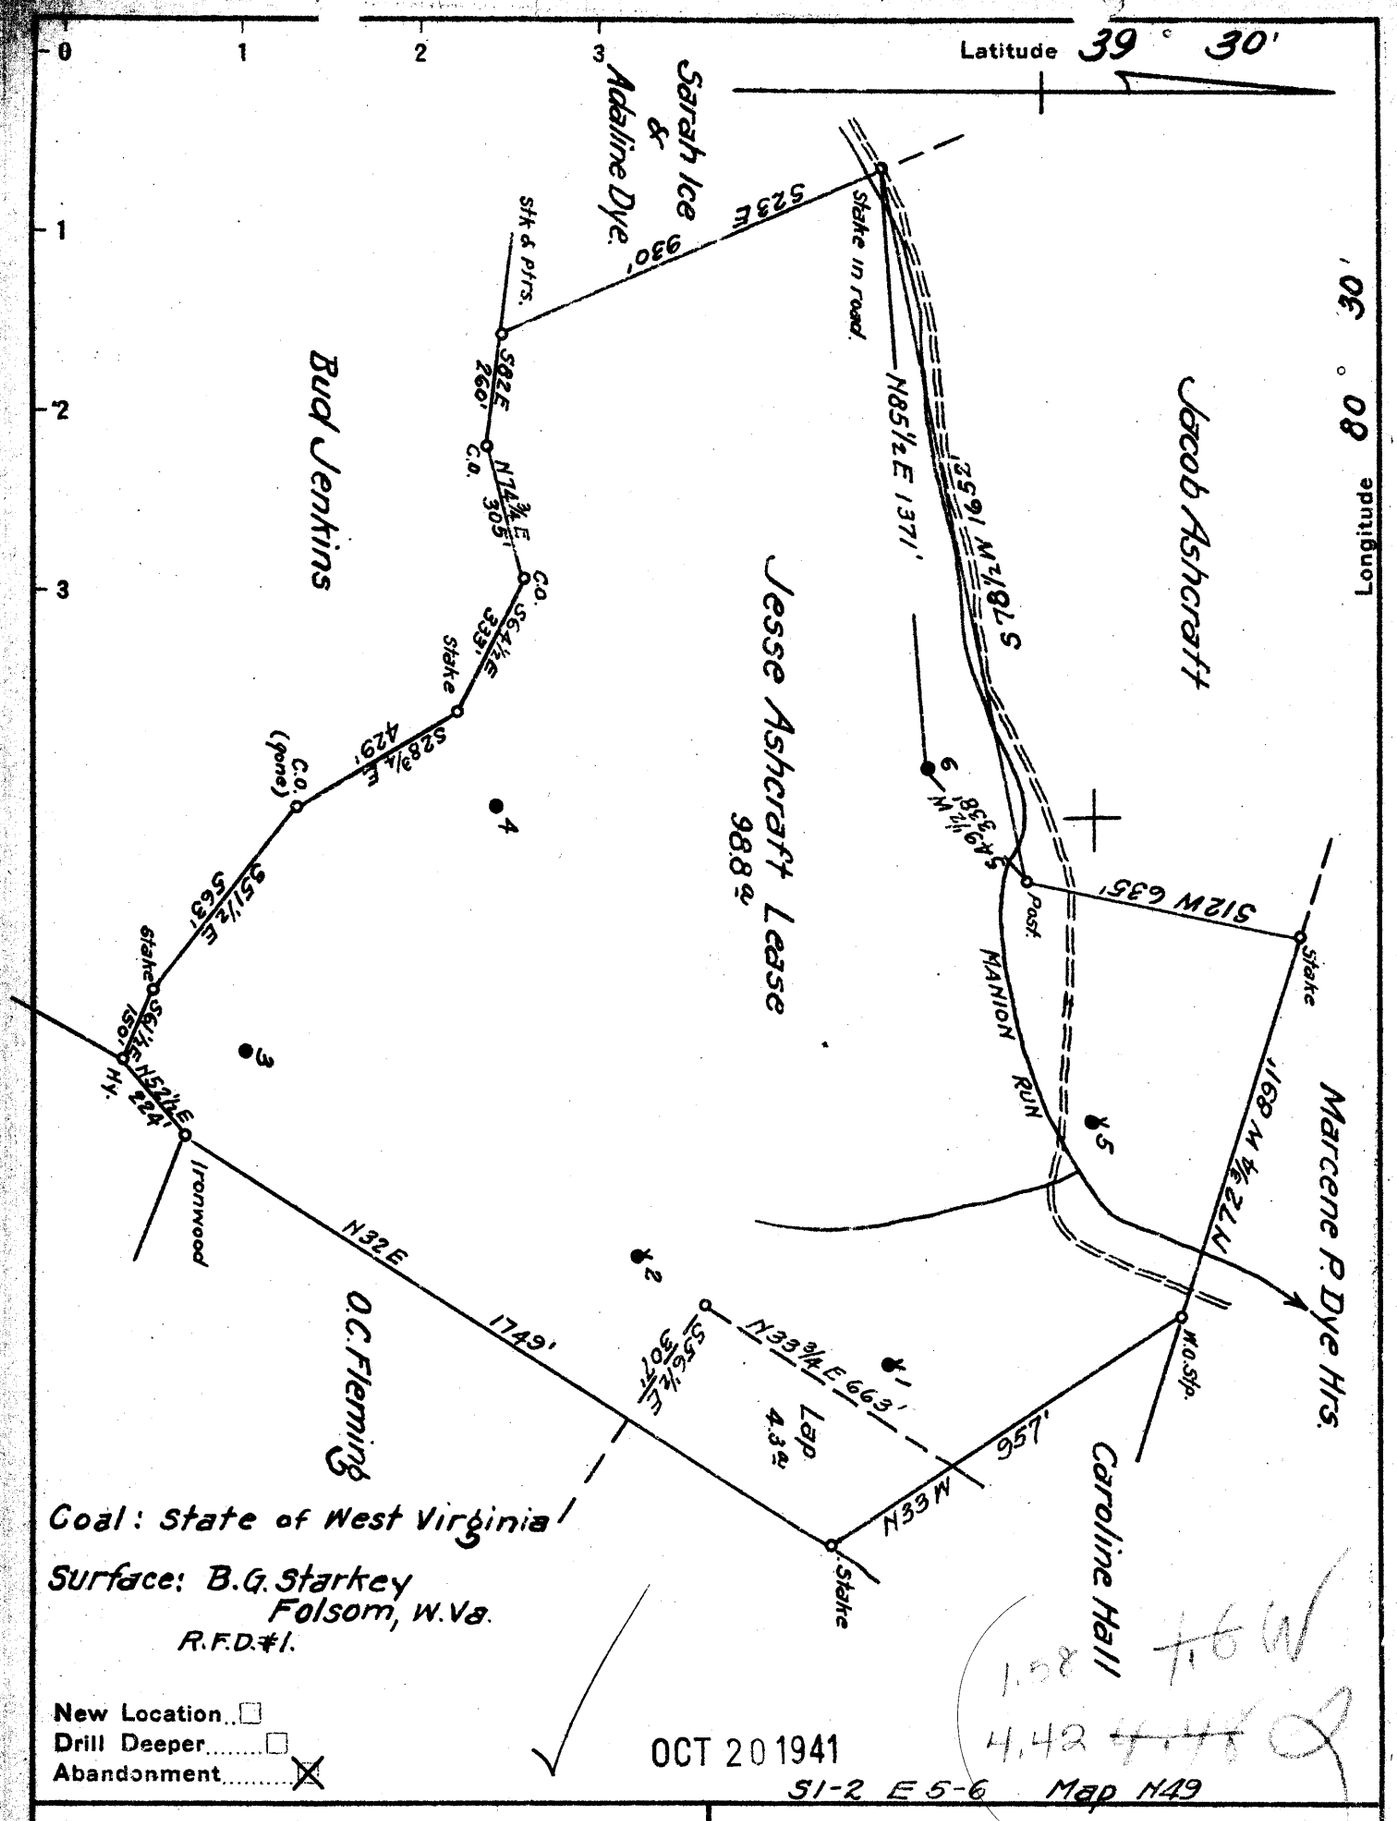

Company South Penn Natural Gas Co.
Address Parkersburg, W.Va.
Farm Jesse Ashcraft
Tract _____ Acres 75 Lease No. 46795
Well (Farm) No. 6 Serial No. _____
Elevation (Spirit Level) 1198.07
Quadrangle Centerpoint
County Wetzel District Grant
Engineer E.C. Tabler
Engineer's Registration No. _____
File No. _____ Drawing No. _____
Date July 2, 1941 Scale 1" = 400'

STATE OF WEST VIRGINIA
DEPARTMENT OF MINES
OIL AND GAS DIVISION
CHARLESTON

WELL LOCATION MAP

FILE NO. WET-384A

+ Denotes location of well on United States Topographic Maps, scale 1 to 62,500, latitude and longitude lines being represented by border lines as shown.

— Denotes one inch spaces on border line of original tracing.

JESSE ASHCRAFT No. 6 — SOUTH PENN NAT. GAS CO. — WET-384A