

Latitude

1025
.58w

Longitude

Topo Location

7.5' Loc. _____ 15' Loc. _____
_____ (calc.) _____

Company Hannco Gas + Oil Co

Farm DM Wade #2

15' Quad _____
(sec.)

7.5' Quad Posters Falls

District GREEN

WELL LOCATION PLAT

County 103 Permit 30644

30644

Green



Hamico Gas & Oil Co
DM Wade #2



1106

STATE OF WEST VIRGINIA
DEPARTMENT OF MINES
OIL AND GAS DIVISION

WELL RECORD


Permit No. 647-A Oil or Gas Well Oil (KIND)

Company Hawice Gas and Oil Co.
Address Uniontown, Pa.
Farm D. M. Wade Acres 67 1/2
Location (waters) _____
Well No. Two (2) Elev. 770'
District Green County Wetzel
The surface of tract is owned in fee by _____
Address _____
Mineral rights are owned by _____
Address _____
Drilling commenced Drilled in 1925
Drilling completed _____
Date Shot _____ From _____ To _____
With _____
Open Flow _____ /10ths Water in _____ Inch
_____ /10ths Merc. in _____ Inch
Volume _____ Cu. Ft.
Rock Pressure _____ lbs. _____ hrs.
Oil _____ bbls., 1st 24 hrs.
Fresh water _____ feet _____ feet
Salt water _____ feet _____ feet

Casing and Tubing	Used in Drilling	Left in Well	Packers
Size			
16			Kind of Packer
13			
10			Size of
8 1/2	1060'	Left	
6 3/4	1677'	"	Depth set
5 3/16			
3			Perf. top
2	2572'	"	Perf. bottom
Liners Used			Perf. top
			Perf. bottom

CASING CEMENTED _____ SIZE _____ No. Ft. _____ Date _____
COAL WAS ENCOUNTERED AT 533' FEET 24 INCHES
_____ FEET _____ INCHES FEET _____ INCHES
_____ FEET _____ INCHES FEET _____ INCHES

Formation	Color	Hard or Soft	Top	Bottom	Oil, Gas or Water	Depth Found	Remarks
Pittsburgh Coal			535'	535'			
Little Dunkard			882'	911'			
Big Dunkard			1060'	1090'			
Gas Sand			1145'	1170'			
1st Salt Sand			1350'	1415'			
2nd Salt Sand			1465'	1502'			
Maxon Sand			1545'	1563'			
Big Lime			1650'	1718'			
Big Injun			1718'	1950'			
Fifty Foot			2375'	2395'			
Thirty Foot			2498'	2514'			
Gordian Stray			2547'	2555'			
Gordian Sand			2557'	2561'			
Total Depth			2572'				

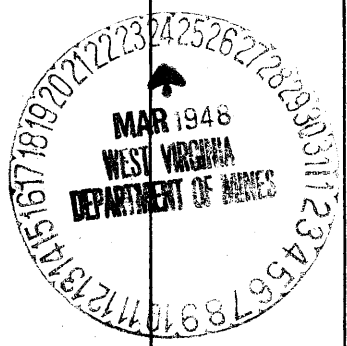

MAR 23 1948

30644

STATE INSPECTOR SUPERVISING PLUGGING

AFFIDAVIT

STATE OF WEST VIRGINIA

County of **Netzel**
Hiram Ulion

and **Eugene Tracy**
being first duly sworn according to law depose and say that they are experienced in the work of
plugging and filling oil and gas wells and were employed by **Hamico Gas and Oil Co.**
well operator, and participated in the work of plugging and filling the above well that said work
was commenced on the **28** day of **June** **1948**, and that the well was plugged
and filled in the following manner:

DEPTH IN FEET	MATERIAL	PLUGS USED		CASING	
		DOWN	UP	FEET	FEET
1700'	Clay	T. Depth	1700'		
1700'	Cement		1690'	1350'	327'
1525'	Bridge				
1525'	Clay		1310'		
1310'	Cement		1300'		
1110'	Bridge			800'	260'
1110'	Clay		1060'		
1060'	Clay		862'		
862'	Cement		852'		
565'	Bridge				
565'	Cement		513'		
513'	Clay		Surface		

GOAL BEAMS	DESCRIPTION OF MONUMENT
(NAME) Pgh. Cement 565' 513'	4" x 4" x 6" Cement base with 18" x 18" at base, tapering to at top. 30" High. Engraved with Hamico Gas and Oil Co. Well No. 1
(NAME)	
(NAME)	
(NAME)	

and that the work of plugging and filling said well was completed on the **10** day of **July** **1948**.

And further deponents saith not.

Sworn to and subscribed before me this **17** day of **July** **1948**.

Hiram Ulion
Eugene Tracy
Notary Public

My commission expires **July 2, 1953**

Permit No. **NET-60**