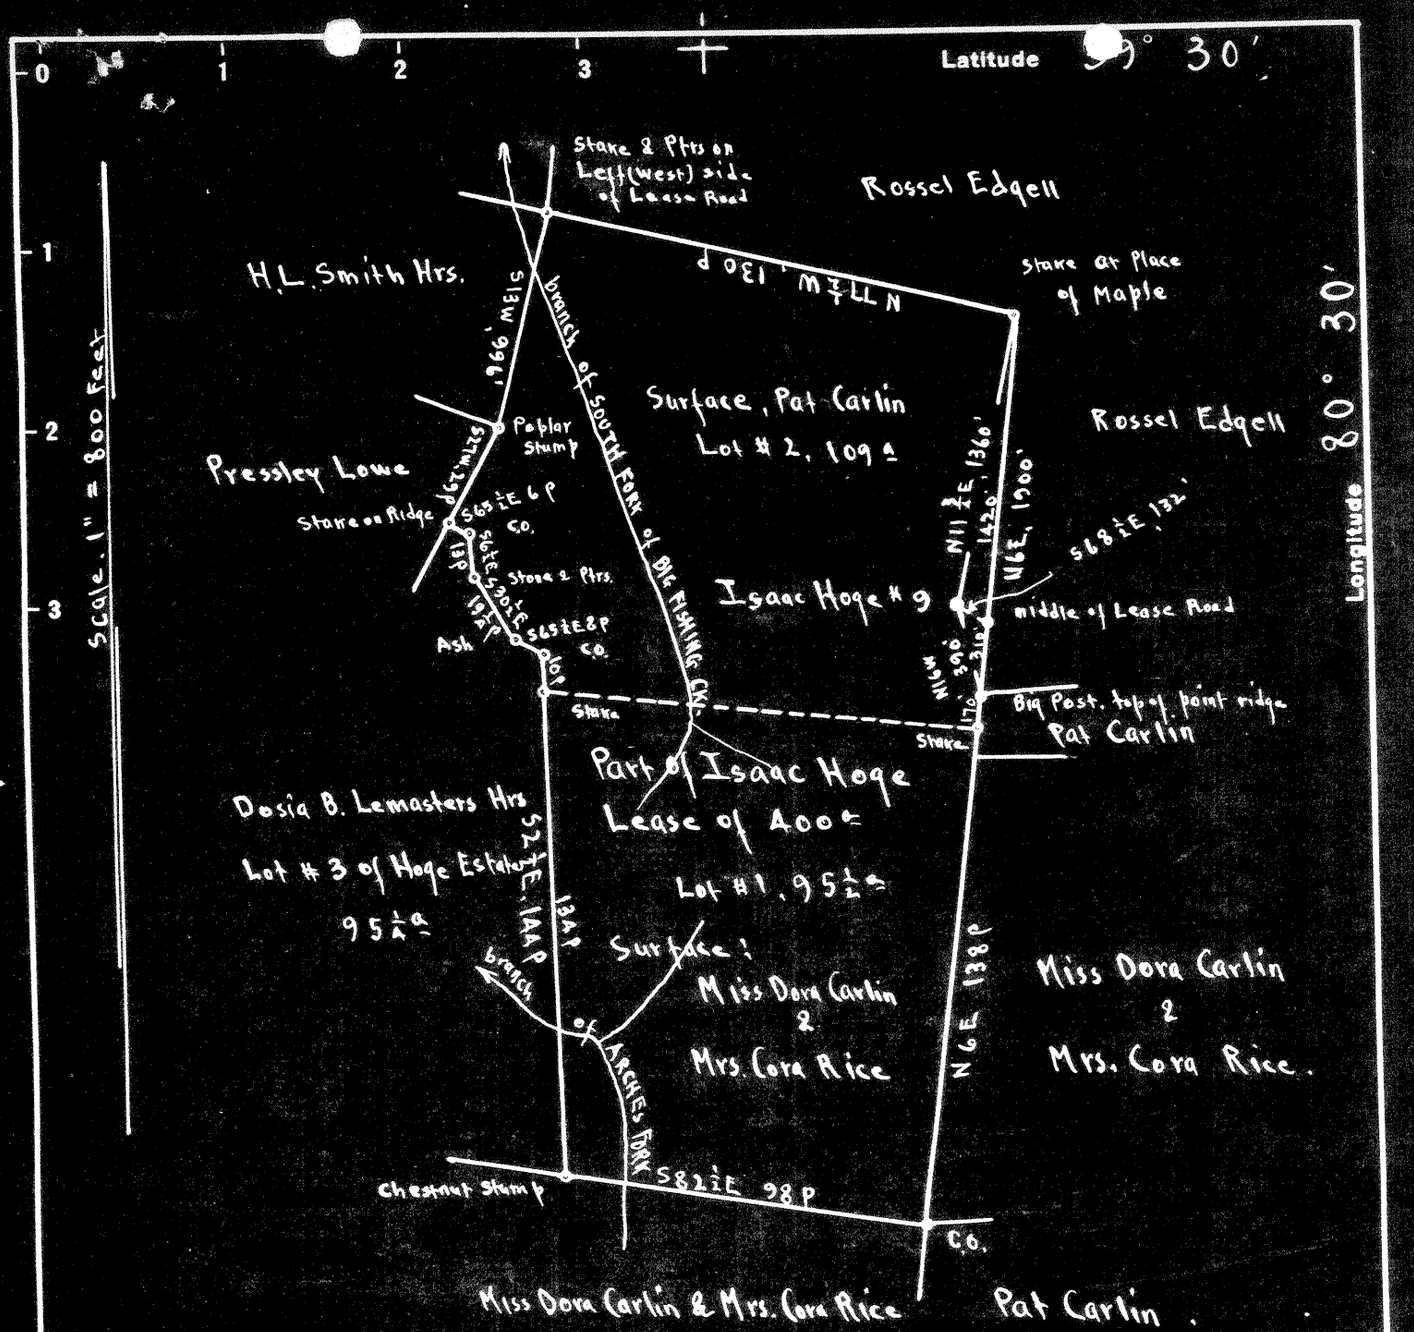

Surface: Pat Carlin, Smithfield, Wetzel Co., W.Va.

Coal: Lucius Hoge Jr., 334 Buckhannon Ave., Clarksburg, W.Va.

New Location ☐
Drill Deeper ☐
Abandonment ☒

On 400' maps 2851 & 2852. NA E3-A

Company The Interstate Pipe & Supply Co.
Address Marietta Ohio.
Farm Isaac Hoge
Tract _____ Acres 400 Lease No. _____
Well (Farm) No. 9 Serial No. _____
Elevation (Spirit Level) Floor – 1115.13 Ground – 1113.83
Quadrangle CENTERPOINT
County Wetzel District Grant
Engineer E.C. Tabler
Engineer's Registration No. _____
File No. _____ Drawing No. _____
Date July 27th 1948 Scale 1" = 800 Feet.

NE

STATE OF WEST VIRGINIA
DEPARTMENT OF MINES
OIL AND GAS DIVISION
CHARLESTON

WELL LOCATION MAP

FILE NO. Wet-828-A

+ Denotes location of well on United States Topographic Maps, scale 1 to 62,500, latitude and longitude lines being represented by border lines as shown.

— Denotes one inch spaces on border line of original tracing.

"IMPERIAL" TRACING CLOTH
K & E CO., N.Y.

OG-10

1256

STATE OF WEST VIRGINIA
DEPARTMENT OF MINES
OIL AND GAS DIVISION

WELL RECORD

Permit No. H-8284

Oil or Gas Well Oil (KIND)

Company The Interstate Pipe & Supply Company
Address P. O. Box 611, Marietta, Ohio
Farm Isaac Hoge Acres 400
Location (waters)
Well No. 9 Elev. 1113.83
District Grant County Wetzel
The surface of tract is owned in fee by Pat Carlin
Address Smithfield, W. Va.
Mineral rights are owned by Lucius Hoge, Jr.
334 Buckhannon Ave. Address Clarksburg, W. Va.
Drilling commenced November 26, 1896
Drilling completed January 6, 1897
Date Shot 10/21/08 From To 2256
With
Open Flow /10ths Water in Inch
/10ths Merc. in Inch
Volume Cu. Ft.
Rock Pressure lbs. hrs.
Oil bbls., 1st 24 hrs.
Fresh water feet feet
Salt water feet feet

Casing and Tubing	Used in Drilling	Left in Well	Packers
Size			
16			Kind of Packer
13			
10	633'10"	633'10"	Size of
8¼	1425'8"	1425'8"	
6⅝	2177	2177	Depth set
5 3/16			
3			Perf. top
2			Perf. bottom
Liners Used			Perf. top
			Perf. bottom

CASING CEMENTED SIZE No. Ft. Date

COAL WAS ENCOUNTERED AT 877 FEET 72" INCHES
FEET INCHES FEET INCHES
FEET INCHES FEET INCHES

Formation	Color	Hard or Soft	Top	Bottom	Oil, Gas or Water	Depth Found	Remarks
Conductor				16			
Pittsburgh Coal			877	883			
Dunkard Sand			1375	1405			
Salt Sand			1740	1920			
Big Lime			2110	2175			
Pencil Cave			2104	2110			
Big Injun			2175				
Gas			2260				
1st Pay Oil			2260				
Total				2276			

AUG 1949
WEST VIRGINIA
DEPARTMENT OF MINES

(Over) NOV - 4 1949

Formation	Color	Hard or Soft	Top	Bottom	Oil, Gas or Water	Depth Found	Remarks

Date August 23, 1949

APPROVED THE INTERSTATE PIPE & SUPPLY CO., Owner

By Adolph Berens
(Title)

MATHEWS PRINTING AND LITHOGRAPHING CO
CHARLESTON W VA