39°42'30"

Latitude

80°27'30"

1.18 S
2.17 W

Longitude

Topo Location

7.5' Loc. _____ 15' Loc. _____

_____ (calc.) _____

Company A M Snyder

Farm Jesse Orndorff Hrs

15' Quad _____
(sec.)

7.5' Quad Hundred

District Clay

WELL LOCATION PLAT

County 103 Permit 31113

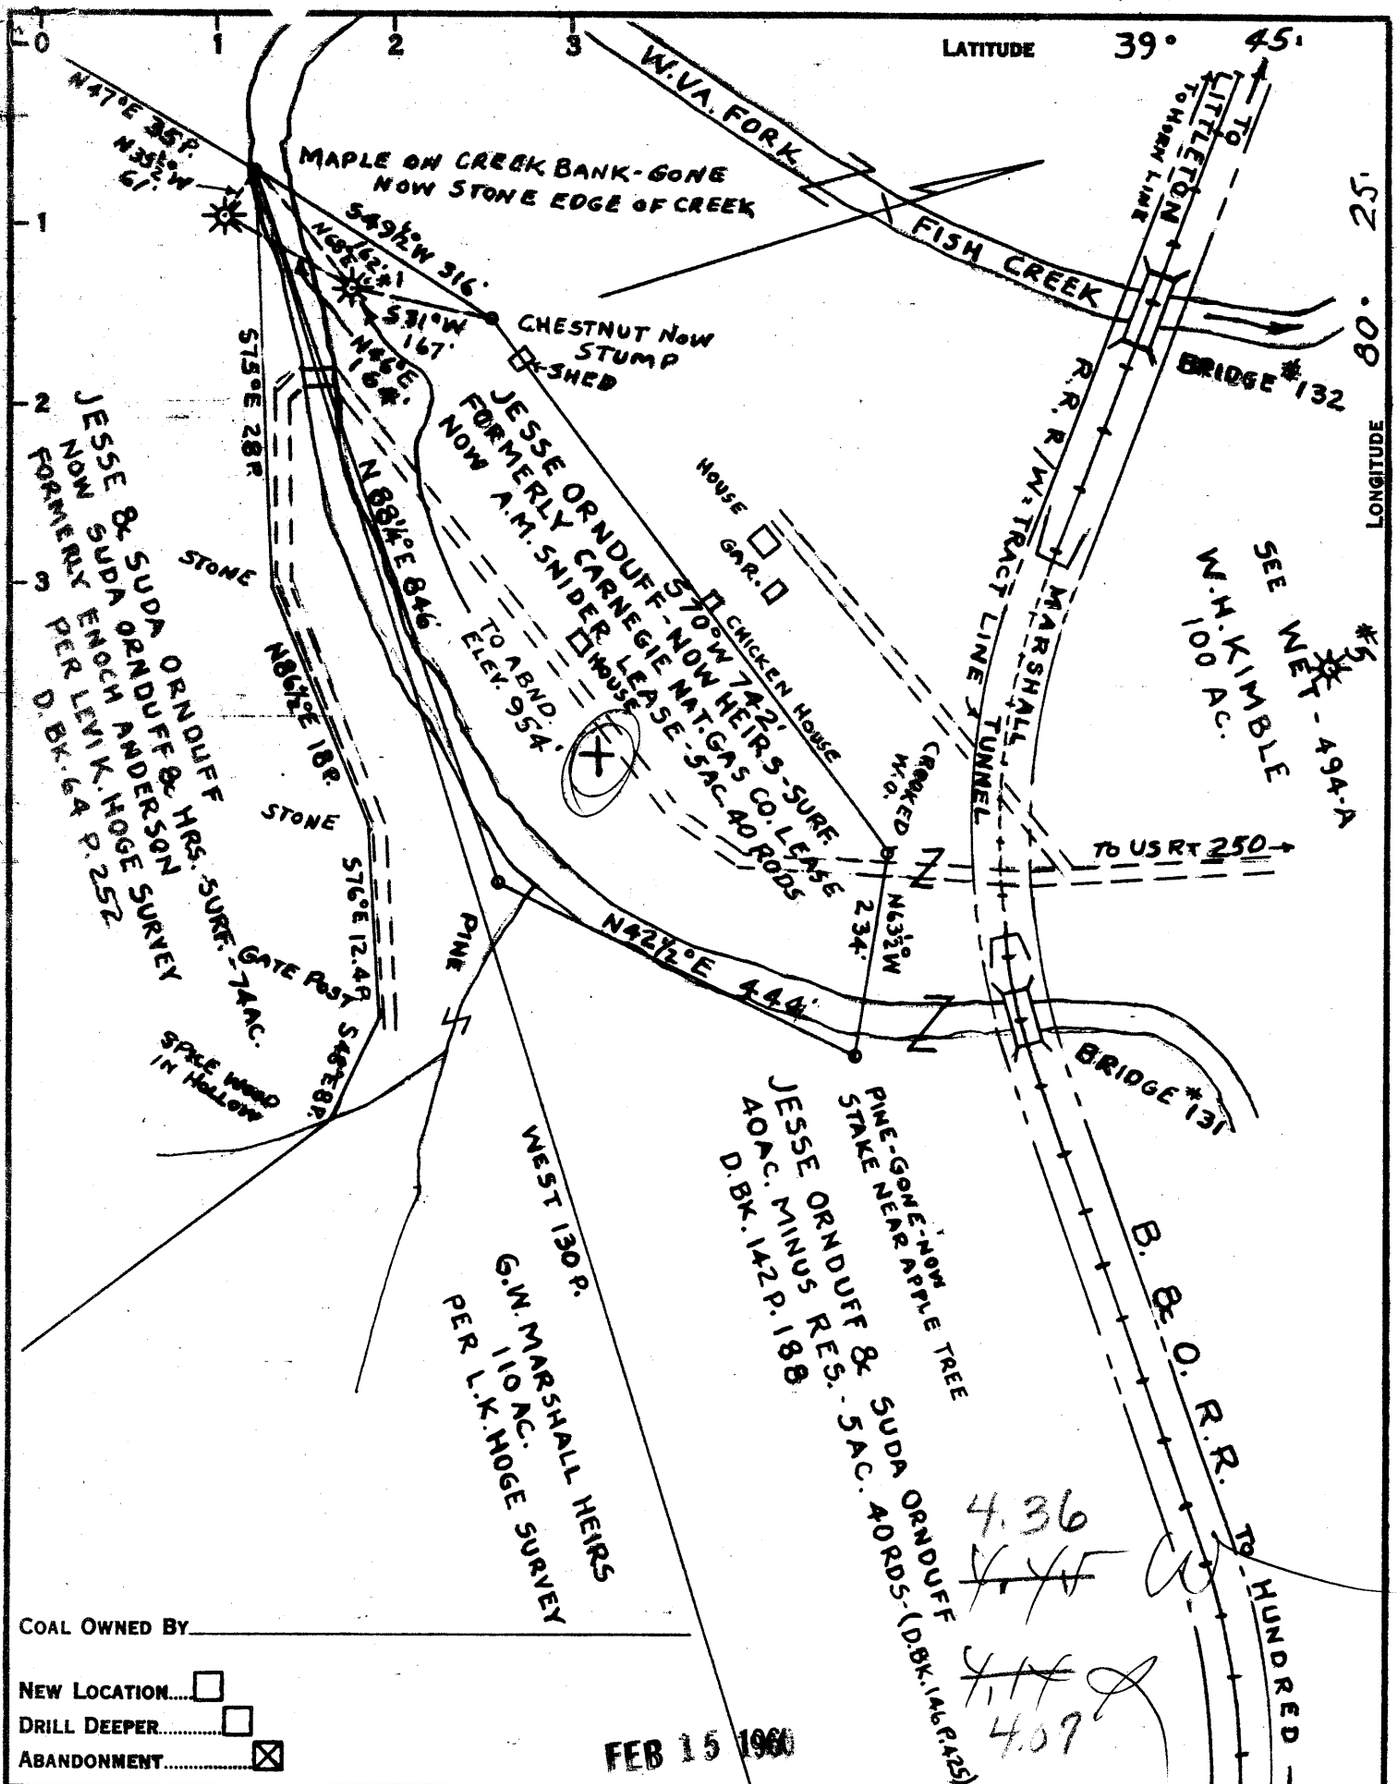

COAL OWNED BY _____

NEW LOCATION ☐

DRILL DEEPER ☐

ABANDONMENT ☒

FEB 15 1960

COMPANY A.M. SNIDER

ADDRESS HUNDRED, W. VA.

FARM JESSE ORNDUFF HEIRS

TRACT _____ ACRES 5+40P. LEASE NO. _____

WELL (FARM) NO. 1 SERIAL NO. _____

ELEVATION (SPIRIT LEVEL) 954'

QUADRANGLE MANNINGTON N.W.

COUNTY WETZEL DISTRICT CLAY

ENGINEER Thomas E. Virgin

ENGINEER'S REGISTRATION NO. 1503

FILE NO. B-2-3 DRAWING NO. _____

DATE 10 SEPT. 1959 SCALE 1" = 200'

STATE OF WEST VIRGINIA
DEPARTMENT OF MINES
OIL AND GAS DIVISION
CHARLESTON

WELL LOCATION MAP

FILE NO. WET-1113-A

+ DENOTES LOCATION OF WELL ON UNITED STATES TOPOGRAPHIC MAPS, SCALE 1 TO 62,500. LATITUDE AND LONGITUDE LINES BEING REPRESENTED BY BORDER LINES AS SHOWN.

— DENOTES ONE INCH SPACES ON BORDER LINE OF ORIGINAL TRACING.

JESSE ORNDUFF HEIRS NO. 1 — A.M. SNIDER — WET-1113-A