39°32'30"

Latitude

80°32'30"

Longitude

1.82s
1.40w

Topo Location

7.5' Loc. _____ 15' Loc. _____ (calc.)

_____ _____

Company Interstate Pipe & Supply Co

Farm Cosgray & Stewart #6

15' Quad _____ (sec.)

7.5' Quad Big Run

District Grant

WELL LOCATION PLAT

County 103 Permit 70312

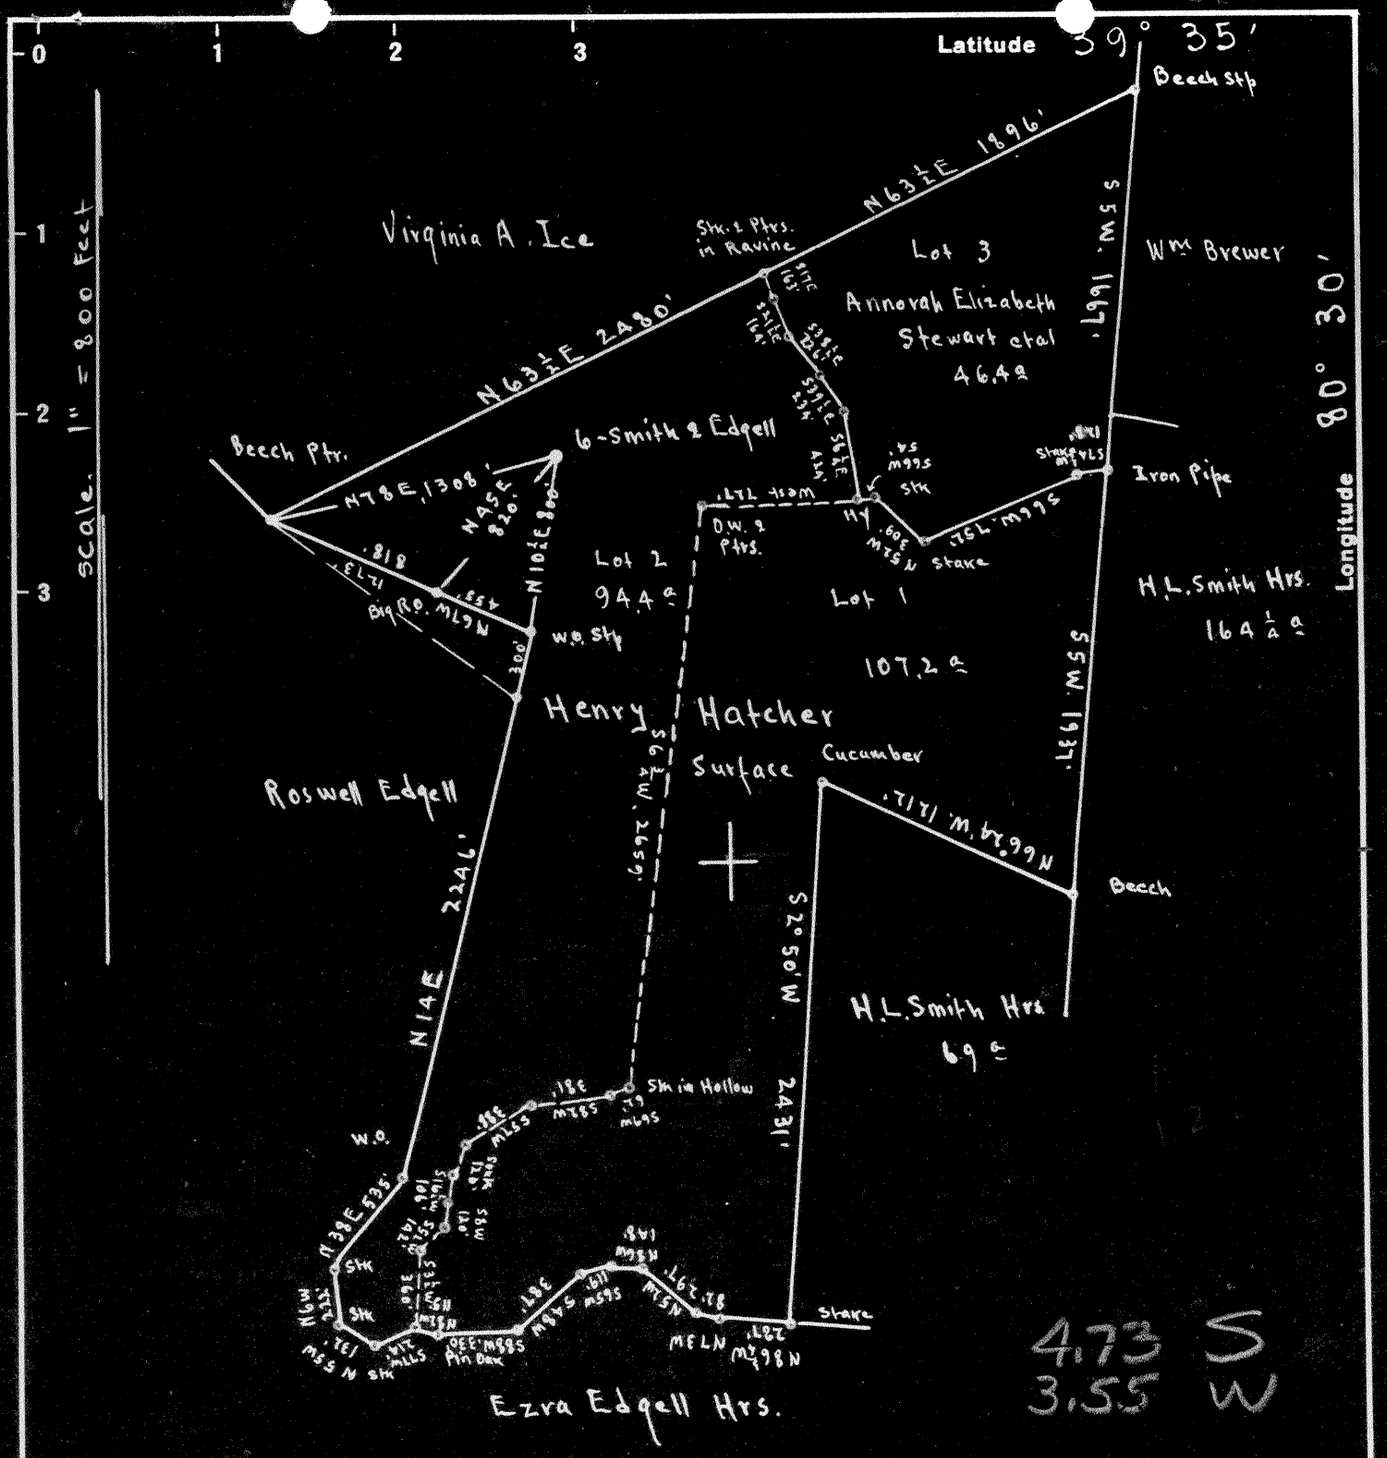

Surface: Henry Hatcher, Smithfield, Wetzel Co. W.Va.

Coal: Pittsburgh Consolidation Coal Co., Fairmont, W.Va.

New Location..☐
Drill Deeper.....☐
Abandonment.....☒ On 400' my # 2851 N5 E3-A

Company The Interstate Pipe & Supply Co.
Address Marietta Ohio
Farm Cosgray & Stewart
Tract ____ Acres 2.48 Lease No. ____ SE
Well (Farm) No. 6 Serial No. ____
Elevation (Spirit Level) Floor - 1140.13 Ground - 1135.13
Quadrangle LITTLETON
County Wetzel District Grant
Engineer E.C. Tabler
Engineer's Registration No. ____
File No. ____ Drawing No. ____
Date Sept. 13th 1949 Scale 1" = 800 Feet.

"IMPERIAL" TRACING CLOTH
K & E CO., N.Y.

STATE OF WEST VIRGINIA
DEPARTMENT OF MINES
OIL AND GAS DIVISION
CHARLESTON

WELL LOCATION MAP

FILE NO. W&T.

+ Denotes location of well on United States Topographic Maps, scale 1 to 62,500, latitude and longitude lines being represented by border lines as shown.

— Denotes one inch spaces on border line of original tracing.