
WAGNER B PAD
ANTERO RESOURCES CORPORATION

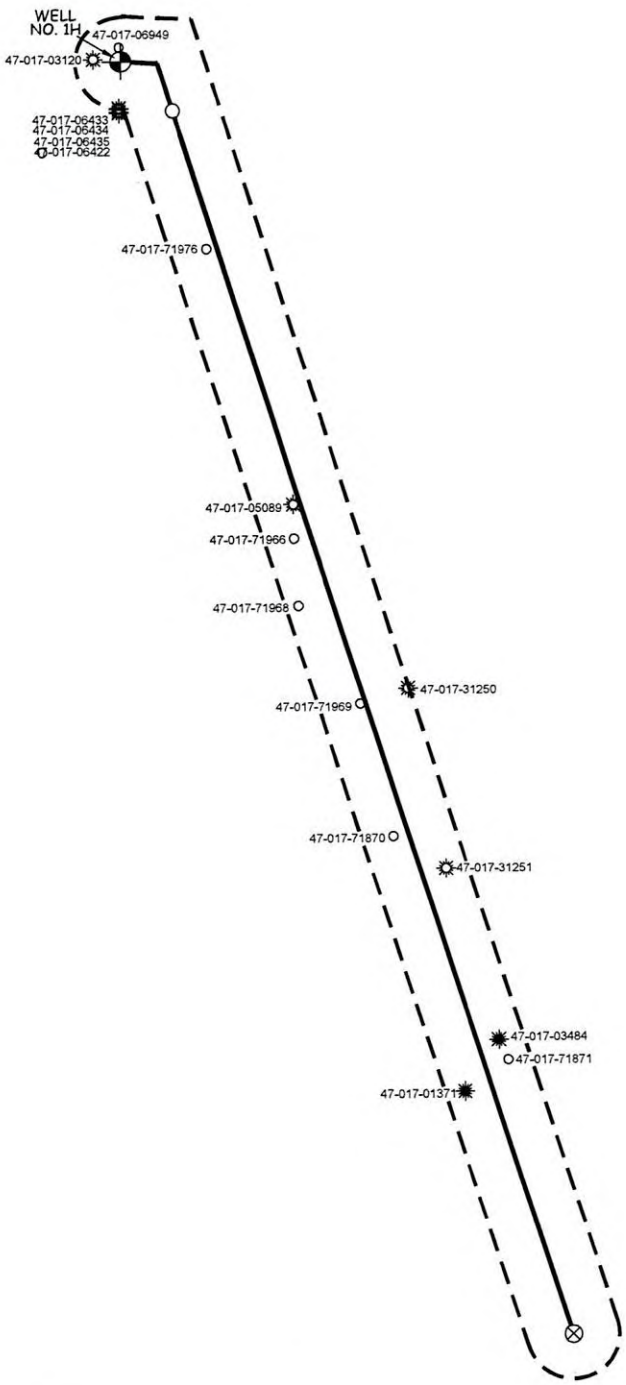

RECEIVED
Office of Oil and Gas
APR 0 3 2026
WV Department of
Environmental Protection

WILLOW LAND SURVEYING, PLLC
P.O. BOX 17, PENNSBORO, WV 26415
(304) 659-1717

JOB #: 25-021WA

DATE: 03/05/26 | DRAWN BY: T.B.S. | FILE: CREEL1HAOR.DWG


SCALE : 1-INCH = 2000-FEET

0' 2000' 4000' 6000'

04/24/2026

UWI (APINum)	Well Name	Well Number	Operator	Historical Operator	TD	Perforated Interval (shallowest, deepest)	Perforated Formation(s)	Producible Formation(s) not perf'd
4701706949	WAGNER B	5V	ANTERO RESOURCES CORP	ANTERO RESOURCES CORP				
4701706433	DOWNS UNIT	1H	ANTERO RESOURCES CORP	ANTERO RESOURCES CORP	16,983	7472 - 16893	Marcellus	
4701706434	DOWNS UNIT	2H	ANTERO RESOURCES CORP	ANTERO RESOURCES CORP	17,820	7692 - 17728	Marcellus	
4701706435	LETTIE UNIT	2H	ANTERO RESOURCES CORP	ANTERO RESOURCES CORP	17,792	7579 - 17668	Marcellus	
4701706422	LETTIE UNIT	1H	ANTERO RESOURCES CORP	ANTERO RESOURCES CORP	18,308	7750 - 18181	Marcellus	
4701703120	MCCLAIN FRANKIE R	1	DIVERSIFIED PRODUCTION LLC	STONEWALL GAS	5,740	5232 - 5579	Benson	Weir, Alexander
4701771976	MARGARET ADAMS	3705	HOPE NATURAL GAS	HOPE NATURAL GAS				
4701705089	BOLTE	2	JAY-BEE OIL & GAS INC	JAY-BEE OIL & GAS INC	5,152	2029 - 3327	Big Injun, Thirty-Foot, Base of Warren	
4701771966	G W SWISHER	3663	HOPE NATURAL GAS	HOPE NATURAL GAS				
4701771968	C L PEARCY	6820	HOPE NATURAL GAS	HOPE NATURAL GAS				
4701731250	E L SPERRY (ILLEGIB	1	WACO O & G CO INC	WACO O & G CO INC	2,753			
4701771969	A SPERRY	4376	UNKNOWN	UNKNOWN				
4701771870	MARY SPERRY	4418	UNKNOWN	UNKNOWN				
4701731251	MARY M SPERRY	1	WACO O & G CO INC	WACO O & G CO INC	2,284		Big Injun	
4701703484	BURNSIDE FRANK	3	HYDROCRBEX	HYDROCARBON EXPL INC	5,812	3539 - 5477	Fifth, Speechley, Balltown, Bradford, Elk	
4701771871	JONATHAN G BURNSIDE	2821	HOPE NATURAL GAS	HOPE NATURAL GAS				
4701701371	M T WILLIAMS	15	PNNZL COMP	PENNZOIL CO INC	2,480		Big Injun	

RECEIVED
Office of Oil and Gas
APR 03 2026
WV Department of
Environmental Protection

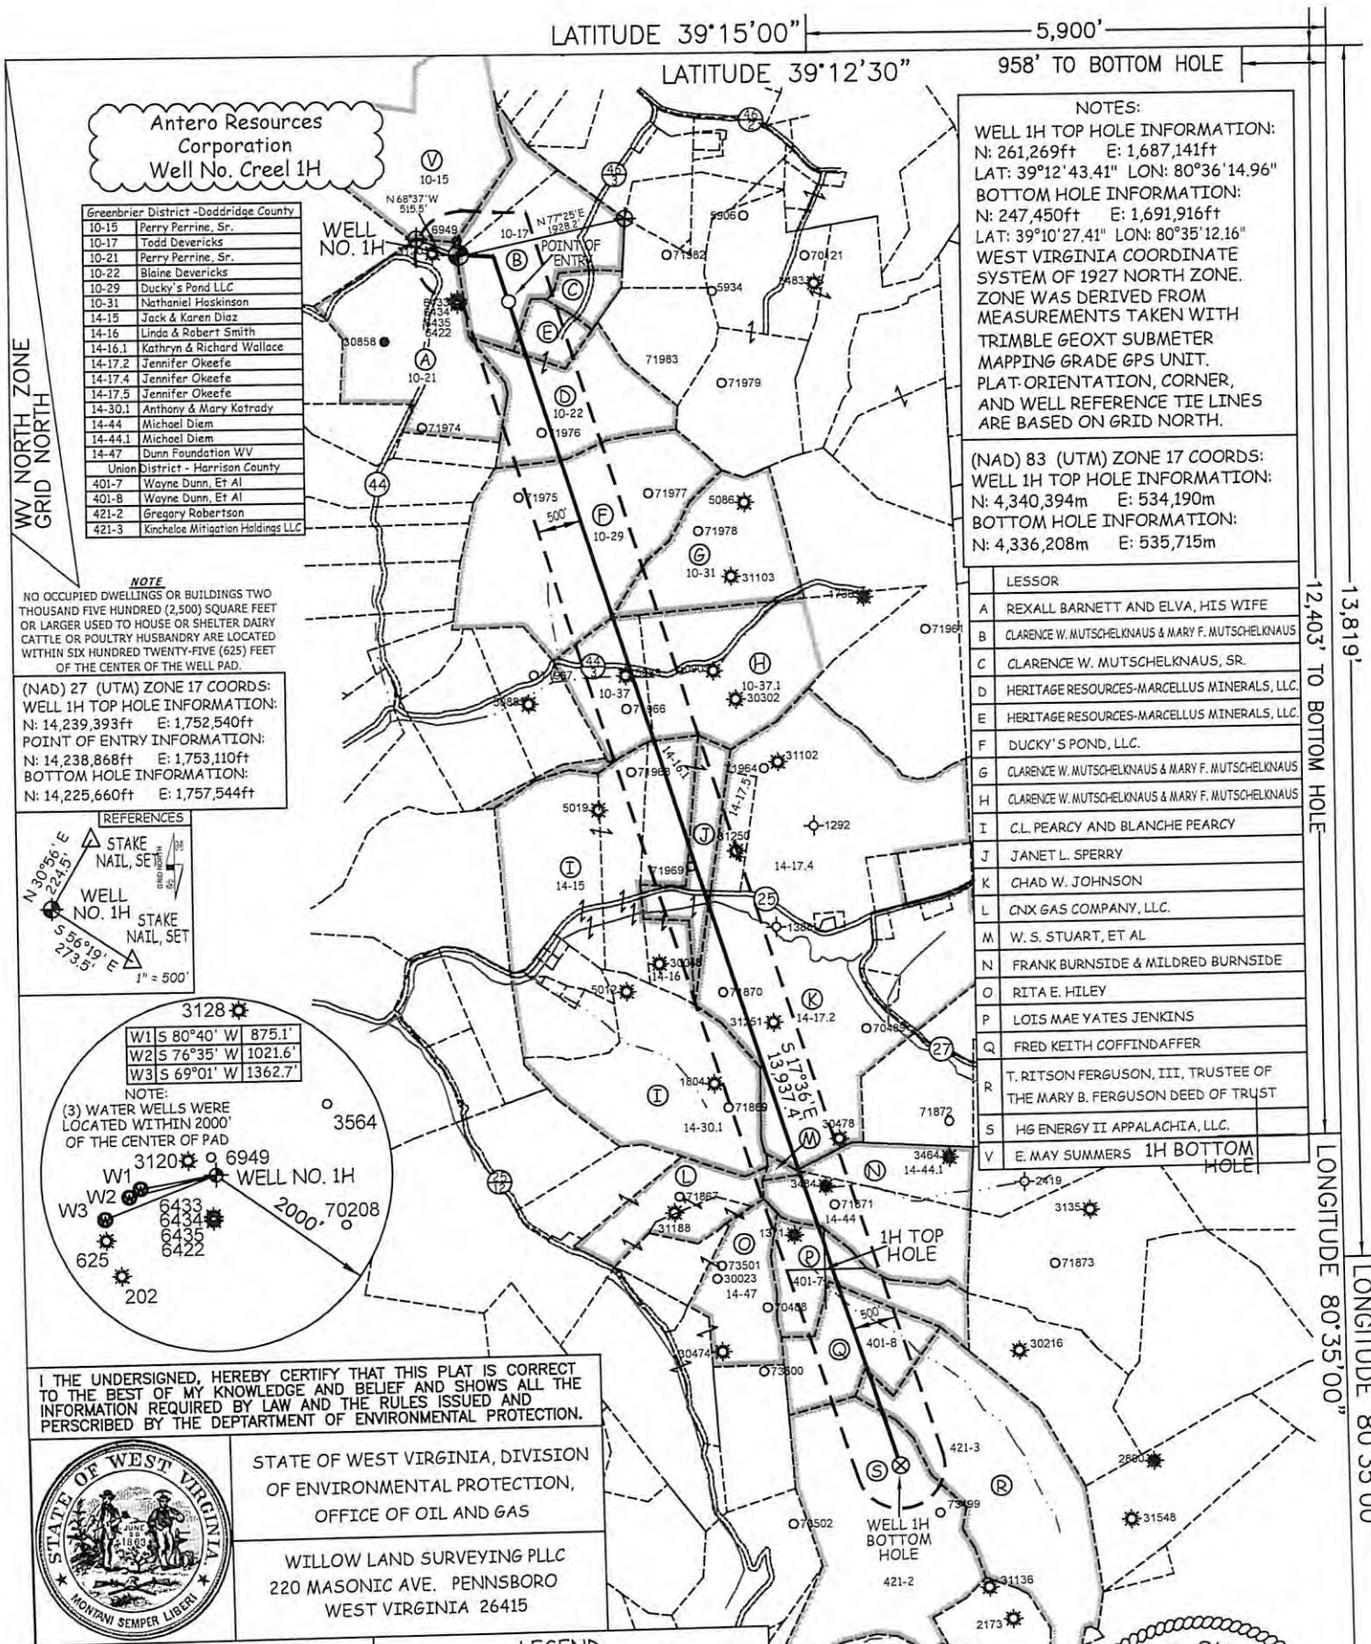
LATITUDE 39°15'00"
5,900'
LATITUDE 39°12'30"
958' TO BOTTOM HOLE
Antero Resources Corporation
Well No. Creel 1H
WV NORTH ZONE GRID NORTH
WELL NO. 1H
POINT OF ENTRY
1H TOP HOLE
1H BOTTOM HOLE
12,403' TO BOTTOM HOLE
13,819'
LONGITUDE 80°35'00"
LONGITUDE 80°35'00"
S 17°36' E 13,937.4'
500'
2000'
Greenbrier District -Doddridge County
10-15 Perry Perrine, Sr.
10-17 Todd Devericks
10-21 Perry Perrine, Sr.
10-22 Blaine Devericks
10-29 Ducky's Pond LLC
10-31 Nathaniel Haskinson
14-15 Jack & Karen Diaz
14-16 Linda & Robert Smith
14-16.1 Kathryn & Richard Wallace
14-17.2 Jennifer Okeefe
14-17.4 Jennifer Okeefe
14-17.5 Jennifer Okeefe
14-30.1 Anthony & Mary Kotrady
14-44 Michael Diem
14-44.1 Michael Diem
14-47 Dunn Foundation WV
Union District - Harrison County
401-7 Wayne Dunn, Et Al
401-8 Wayne Dunn, Et Al
421-2 Gregory Robertson
421-3 Kincheloe Mitigation Holdings LLC
NOTES:
WELL 1H TOP HOLE INFORMATION:
N: 261,269ft E: 1,687,141ft
LAT: 39°12'43.41" LON: 80°36'14.96"
BOTTOM HOLE INFORMATION:
N: 247,450ft E: 1,691,916ft
LAT: 39°10'27.41" LON: 80°35'12.16"
WEST VIRGINIA COORDINATE SYSTEM OF 1927 NORTH ZONE.
ZONE WAS DERIVED FROM MEASUREMENTS TAKEN WITH TRIMBLE GEOXT SUBMETER MAPPING GRADE GPS UNIT.
PLAT ORIENTATION, CORNER, AND WELL REFERENCE TIE LINES ARE BASED ON GRID NORTH.
(NAD) 83 (UTM) ZONE 17 COORDS:
WELL 1H TOP HOLE INFORMATION:
N: 4,340,394m E: 534,190m
BOTTOM HOLE INFORMATION:
N: 4,336,208m E: 535,715m
NOTE
NO OCCUPIED DWELLINGS OR BUILDINGS TWO THOUSAND FIVE HUNDRED (2,500) SQUARE FEET OR LARGER USED TO HOUSE OR SHELTER DAIRY CATTLE OR POULTRY HUSBANDRY ARE LOCATED WITHIN SIX HUNDRED TWENTY-FIVE (625) FEET OF THE CENTER OF THE WELL PAD.
(NAD) 27 (UTM) ZONE 17 COORDS:
WELL 1H TOP HOLE INFORMATION:
N: 14,239,393ft E: 1,752,540ft
POINT OF ENTRY INFORMATION:
N: 14,238,868ft E: 1,753,110ft
BOTTOM HOLE INFORMATION:
N: 14,225,660ft E: 1,757,544ft
A REXALL BARNETT AND ELVA, HIS WIFE
B CLARENCE W. MUTSCHELKNAUS & MARY F. MUTSCHELKNAUS
C CLARENCE W. MUTSCHELKNAUS, SR.
D HERITAGE RESOURCES-MARCELLUS MINERALS, LLC.
E HERITAGE RESOURCES-MARCELLUS MINERALS, LLC.
F DUCKY'S POND, LLC.
G CLARENCE W. MUTSCHELKNAUS & MARY F. MUTSCHELKNAUS
H CLARENCE W. MUTSCHELKNAUS & MARY F. MUTSCHELKNAUS
I C.L. PEARCY AND BLANCHE PEARCY
J JANET L. SPERRY
K CHAD W. JOHNSON
L CNX GAS COMPANY, LLC.
M W. S. STUART, ET AL
N FRANK BURNSIDE & MILDRED BURNSIDE
O RITA E. HILEY
P LOIS MAE YATES JENKINS
Q FRED KEITH COFFINDAFFER
R T. RITSON FERGUSON, III, TRUSTEE OF THE MARY B. FERGUSON DEED OF TRUST
S HG ENERGY II APPALACHIA, LLC.
V E. MAY SUMMERS
REFERENCES
N 30°56' E 224.5'
STAKE NAIL, SET
WELL NO. 1H
S 56°19' E 273.5'
1" = 500'
W1 S 80°40' W 875.1'
W2 S 76°35' W 1021.6'
W3 S 69°01' W 1362.7'
NOTE:
(3) WATER WELLS WERE LOCATED WITHIN 2000' OF THE CENTER OF PAD
I THE UNDERSIGNED, HEREBY CERTIFY THAT THIS PLAT IS CORRECT TO THE BEST OF MY KNOWLEDGE AND BELIEF AND SHOWS ALL THE INFORMATION REQUIRED BY LAW AND THE RULES ISSUED AND PERSCRIBED BY THE DEPTARTMENT OF ENVIRONMENTAL PROTECTION.
STATE OF WEST VIRGINIA, DIVISION OF ENVIRONMENTAL PROTECTION, OFFICE OF OIL AND GAS
WILLOW LAND SURVEYING PLLC
220 MASONIC AVE. PENNSBORO
WEST VIRGINIA 26415
LEGEND
Surface Owner Boundary Lines +/-
Adjoining Surface Tracts +/-
Found monument, as noted
THOMAS SUMMERS P.S. 2109
DATE 02/14/26
OPERATOR'S WELL# CREEL 1H
STATE OF WEST VIRGINIA DEPARTMENT OF ENERGY DIVISION OF OIL AND GAS
JOB # 25-021WA
DRAWING # CREEL1H
SCALE 1" = 2000'
MINIMUM DEGREE OF ACCURACY SUBMETER
PROVEN SOURCE OF ELEV. SUBMETER MAPPING GRADE GPS
BOLTE UNIT 1H
CREEL UNIT 1H
SEMBELLO UNIT 1H
JORAN UNIT 1H
HERRON UNIT 1H
MASON UNIT 1H
DUKATE UNIT 1H
N 33°43' W
GRID NORTH
NOT TO SCALE
THOMAS SUMMERS LICENSED No. 2109 STATE OF WEST VIRGINIA PROFESSIONAL SURVEYOR
WELL TYPE: OIL ___ GAS X LIQUID INJECTION ___ WASTE DISPOSAL ___
(IF "GAS") PRODUCTION X STORAGE ___ DEEP ___ SHALLOW X
LOCATION: ELEVATION 1,311' AS-BUILT WATERSHED HEADWATERS MIDDLE ISLAND CREEK
QUADRANGLE BIG ISAAC 7.5' DISTRICT GREENBRIER COUNTY DODDRIDGE
SURFACE OWNER TODD DEVERICKS ET AL ACREAGE 63.75 ACRES
OIL & GAS ROYALTY OWNER CLARENCE W. MUTSCHELKNAUS & MARY F. MUTSCHELKNAUS LEASE ACREAGE 59.84 AC.±
PROPOSED WORK: DRILL ___ CONVERT ___ DRILL DEEPER X REDRILL ___ FRACTURE OR STIMULATE X
PLUG OFF OLD FORMATION ___ PERFORATE NEW FORMATION X OTHER PHYSICAL CHANGE IN WELL
(SPECIFY) MOD-BHL PLUG & ABANDON CLEAN OUT & REPLUG
TARGET FORMATION MARCELLUS ESTIMATED DEPTH 7,800' TVD 23,300' MD
WELL OPERATOR ANTERO RESOURCES CORP. DESIGNATED AGENT CONRAD BASTON
ADDRESS 1615 WYNKOOP ST. DENVER, CO 80202 ADDRESS 535 WHITE OAK BLVD. BRIDGEPORT, WV 26330
FORM WW-6
47 – 017 – 07005
STATE COUNTY PERMIT
COUNTY NAME PERMIT
04/24/2026