
Antero Resources
Well No. Murray 1H
As-Drilled
Antero Resources Corporation

Page 1 of 1

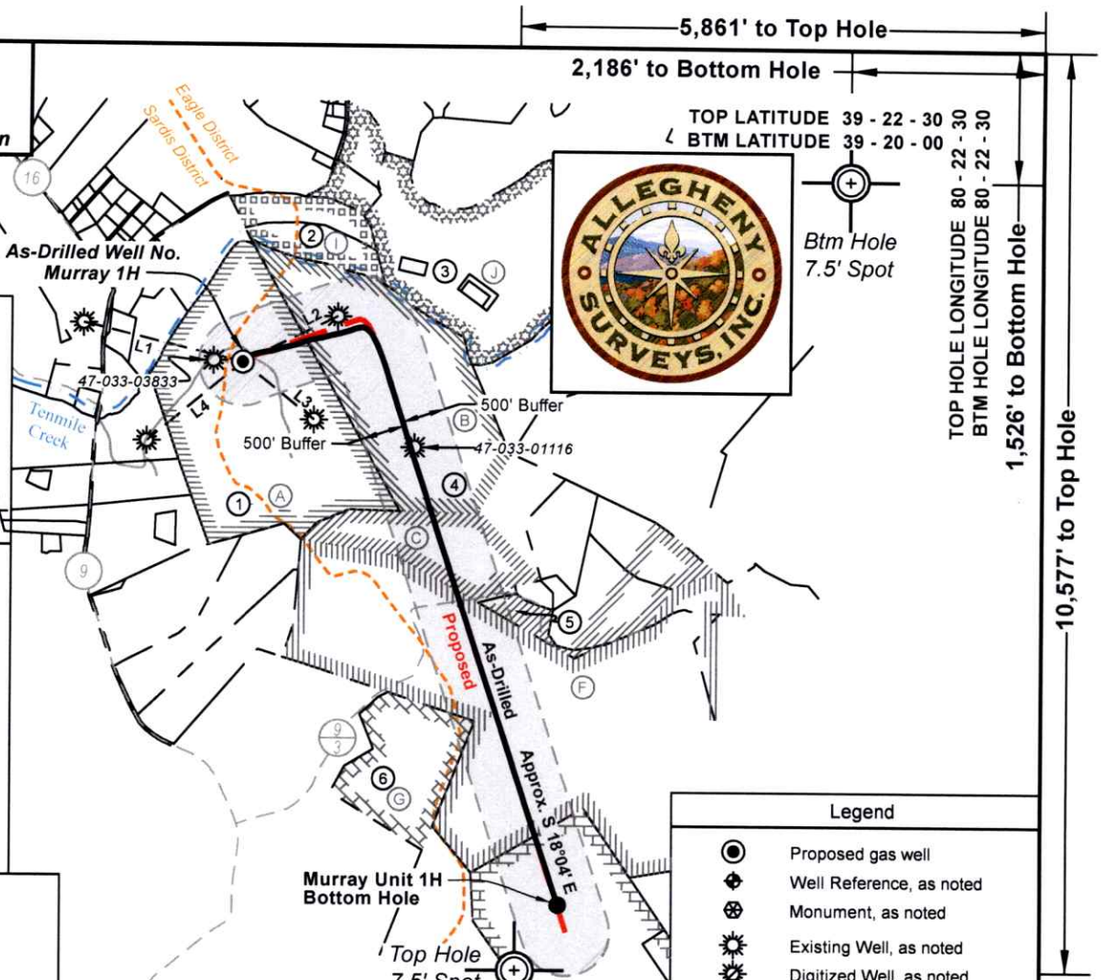


I, the undersigned, hereby certify that this plat is correct to the best of my knowledge and belief and shows all the information required by law and the rules issued and prescribed by the Department of Environmental Protection.


Bradley D. Miller, P.S. 2167

BRADLEY D. MILLER LICENSED No. 2167 STATE OF WEST VIRGINIA PROFESSIONAL SURVEYOR

SEAL

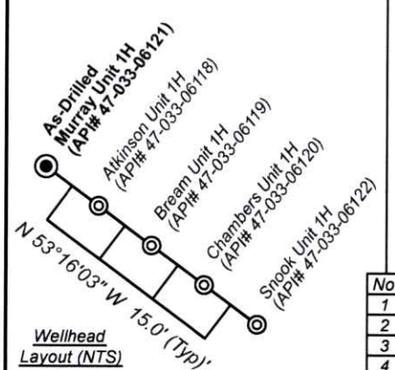

Wellhead Layout (NTS)

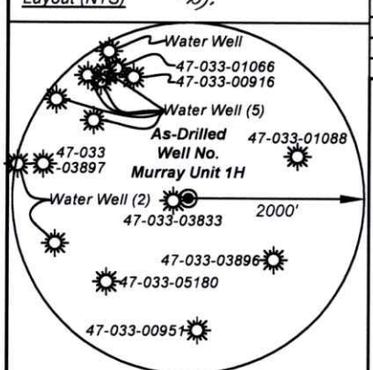

Note: Eight (8) water wells were found within 2000' of proposed well. No occupied dwellings or buildings 2,500 square feet or larger used to house or shelter dairy cattle or poultry husbandry are located within 625' of the center of the well pad.

Legend

- Proposed gas well
- Well Reference, as noted
- Monument, as noted
- Existing Well, as noted
- Digitized Well, as noted
- Creek or Drain
- Existing road
- Surface boundary (approx.)
- District line (approx.)

Tag	Bearing	Dist.	Description
L1	S 76°23' E	1,860.9'	47-033-03897
L2	S 63°53' W	1,200.7'	47-033-01088
L3	N 51°16' W	1,040.6'	47-033-03896
L4	N 50°20' E	1,411.4'	47-033-05180

Tag	Lease
A	A.W. Coffman, et ux
B	Dennis C. Bates, et al
C	Gore Corporation
F	Walter R. Lawman, et al
G	A.L. McQuaid & Harriet M. McQuaid, his wife
H	Sarah J. Morrison & Ashton H. Morrison, w/h
I	C. Garnett Ritter, et al
J	Marguerite Mason, et al

Harrison County

No.	TM / Par	Owner	Bk / Pg	Ac.
1	245 / 26	Robert G. & Christine E. Flanigan, et al	W216 / 842	129.00
2	226 / 89	David J. Robey	1444 / 1293	12.35
3	226 / 90.3	David J. Robey	1444 / 1293	83.98
4	246 / 30	James A. Varner	1261 / 957	397.42
5	246 / 17	Rory T. Williams	1735 / 1007	6.00
6	246 / 29	James W. & Shirley L. Loar	936 / 545	56.40
7	266A / 3	Paul E. McIE	1181 / 850	91.24

Notes
West Virginia Coordinate System of 1927, North Zone
based upon Differential GPS Measurements.
Well No. Murray Unit 1H Top Hole coordinates are
N: 309,379.16' Latitude: 39°20'45.46"
E: 1,746,683.17' Longitude: 80°23'44.61"
Bottom Hole coordinates are
N: 303,217.52' Latitude: 39°19'44.92"
E: 1,750,298.93' Longitude: 80°22'57.81"
UTM Zone 17, NAD 1983
Top Hole Coordinates Bottom Hole Coordinates
N: 4,355,353.402m N: 4,353,494.554m
E: 552,085.834m E: 553,218.671m
Plat orientation and corner and well references are based upon the grid north meridian.
Well location references are based upon the magnetic meridian.

Notes:
Well No. Murray Unit 1H
As-Drilled POE Coordinates
WV Coordinate System of 1927, North Zone
N: 309,434.17'
E: 1,748,271.76'
Lat: 39°20'46.16"
Lon: 80°23'24.40"
UTM Zone 17, NAD 1983
N: 4,355,378.226m
E: 552,569.540m

Top Hole Coordinates, As-drilled data, and information was provided by Antero Resources Corporation. Allegheny Surveys Inc. (ASI) is not certifying the data and information provided. ASI is not responsible for any errors or inaccuracies with the data and information that has been provided.

FILE NO: 212-36-EO-25
DRAWING NO: Murray Unit 1H As-Drilled
SCALE: 1" = 2000'
MINIMUM DEGREE OF ACCURACY: Submeter
PROVEN SOURCE OF ELEVATION: WVDOT, Harrisville, WV

STATE OF WEST VIRGINIA
DEPARTMENT OF ENVIRONMENTAL PROTECTION
OIL AND GAS DIVISION

DATE: May 28 20 26
OPERATOR'S WELL NO. Murray Unit 1H
API WELL NO
47 - 033 - 06121
STATE COUNTY PERMIT

WELL TYPE: ☐ OIL ☒ GAS ☐ LIQUID INJECTION ☐ WASTE DISPOSAL
(IF GAS) PRODUCTION : ☐ STORAGE ☐ DEEP ☒ SHALLOW

LOCATION: ELEVATION: As-Built1,154.4' WATERSHED: Tenmile Creek QUADRANGLE: Wolf Summit
DISTRICT: Eagle COUNTY: Harrison 08/28/2026
SURFACE OWNER: Robert G. & Christine E. Flanigan, et al ACREAGE: 129.00

ROYALTY OWNER: A.W. & Susan C. Coffman LEASE NO: _____ ACREAGE: 129.00
PROPOSED WORK: ☐ DRILL ☐ CONVERT ☐ DRILL DEEPER ☐ FRACTURE OR STIMULATE ☐ PLUG OFF OLD FORMATION
☐ PERFORATE NEW FORMATION ☒ OTHER PHYSICAL CHANGE IN WELL (SPECIFY) As-Drilled
☐ PLUG AND ABANDON ☐ CLEAN OUT AND REPLUG TARGET FORMATION: Marcellus Shale ESTIMATED DEPTH: 7,051' TVD 13,933' MD

WELL OPERATOR: Antero Resources Corporation DESIGNATED AGENT: Conrad Baston
ADDRESS: 1615 Wynkoop Street ADDRESS: 535 White Oaks Blvd.
Denver, CO 80202 Bridgeport, WV 26330