
Antero Resources
Well No. Snook 1H
As-Drilled
Antero Resources Corporation

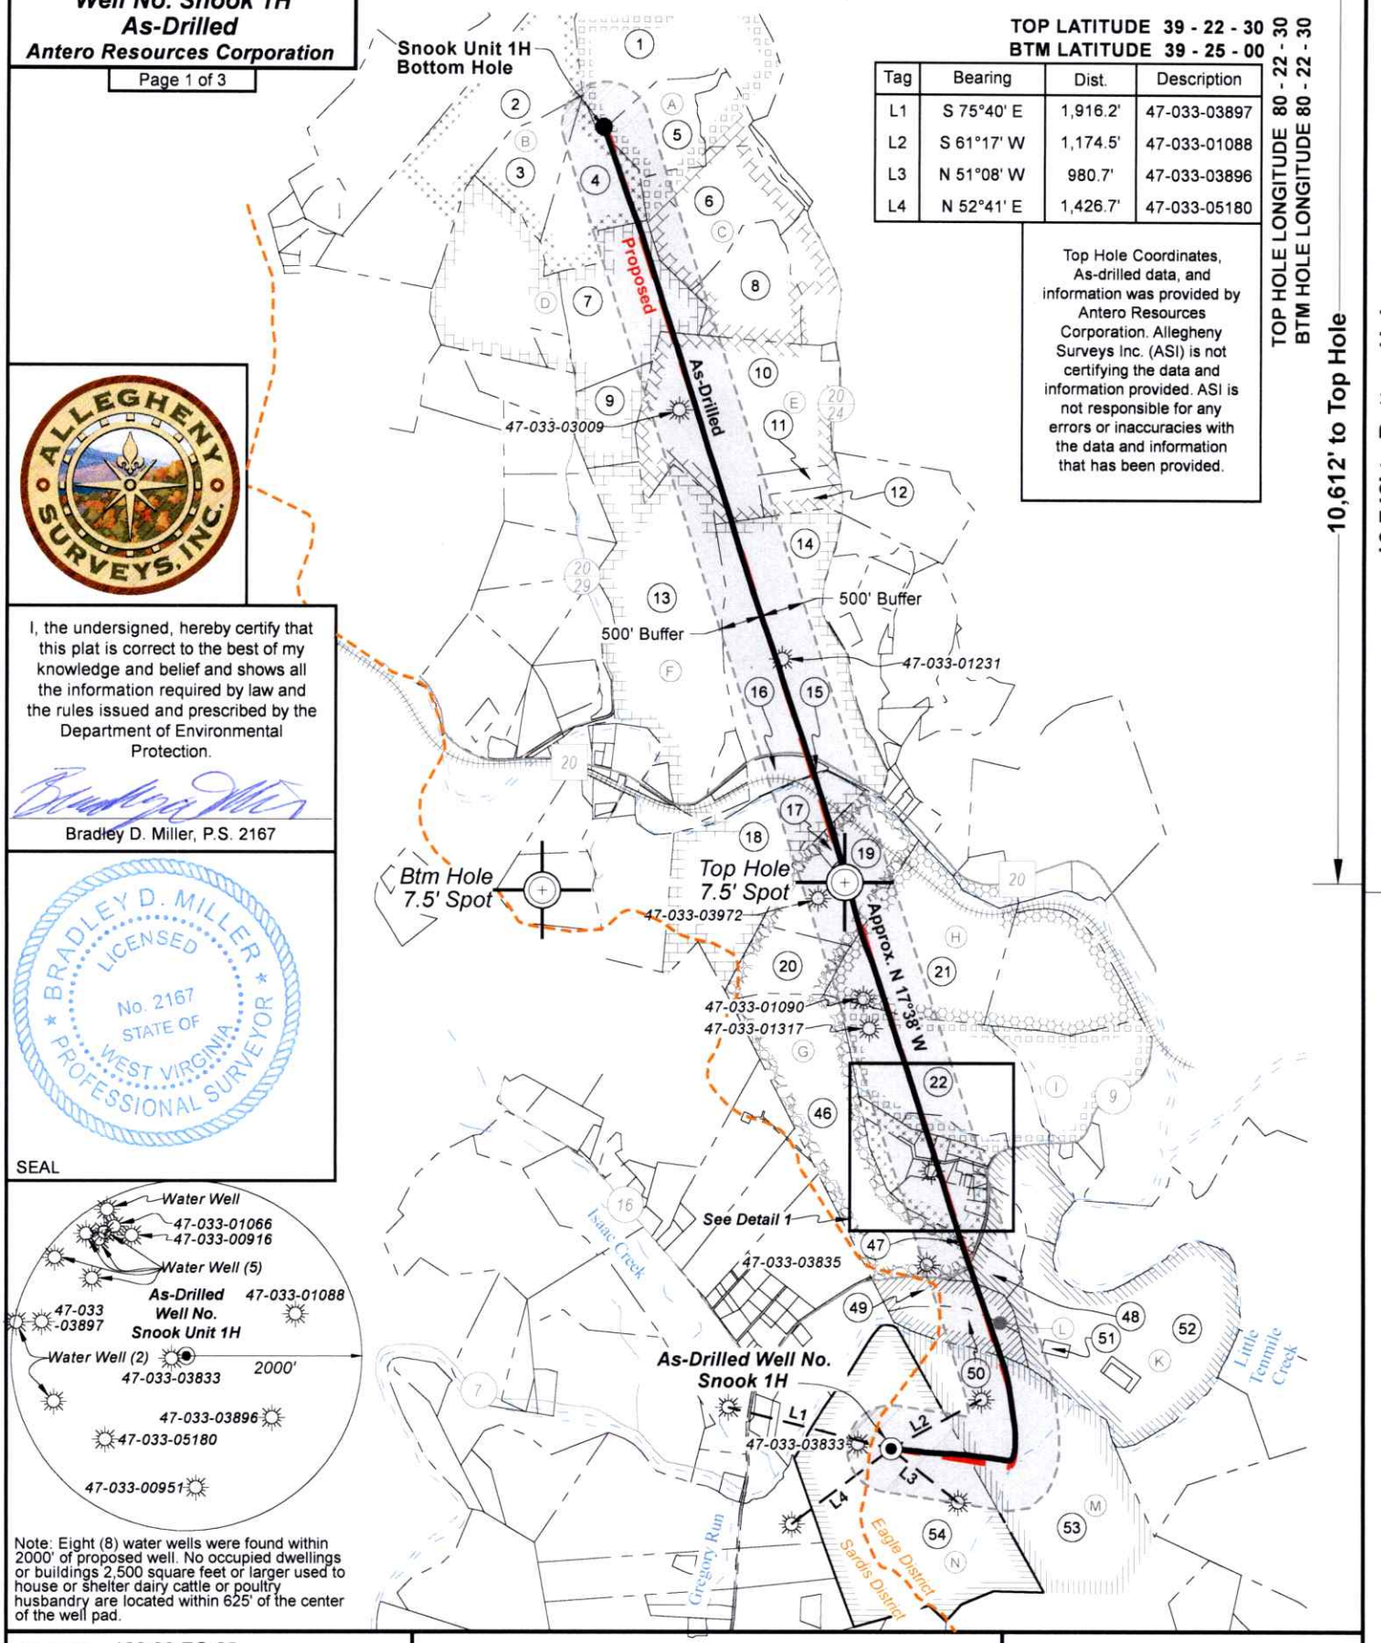

TOP LATITUDE 39 - 22 - 30
BTM LATITUDE 39 - 25 - 00
TOP HOLE LONGITUDE 80 - 22 - 30
BTM HOLE LONGITUDE 80 - 22 - 30

Tag	Bearing	Dist.	Description
L1	S 75°40' E	1,916.2'	47-033-03897
L2	S 61°17' W	1,174.5'	47-033-01088
L3	N 51°08' W	980.7'	47-033-03896
L4	N 52°41' E	1,426.7'	47-033-05180

Top Hole Coordinates, As-drilled data, and information was provided by Antero Resources Corporation. Allegheny Surveys Inc. (ASI) is not certifying the data and information provided. ASI is not responsible for any errors or inaccuracies with the data and information that has been provided.

ALLEGHENY SURVEYS, INC.

I, the undersigned, hereby certify that this plat is correct to the best of my knowledge and belief and shows all the information required by law and the rules issued and prescribed by the Department of Environmental Protection.

Bradley D. Miller, P.S. 2167

BRADLEY D. MILLER LICENSED No. 2167 STATE OF WEST VIRGINIA PROFESSIONAL SURVEYOR

SEAL

Note: Eight (8) water wells were found within 2000' of proposed well. No occupied dwellings or buildings 2,500 square feet or larger used to house or shelter dairy cattle or poultry husbandry are located within 625' of the center of the well pad.

FILE NO: 126-36-EO-25
DRAWING NO: Snook Unit 1H As-Drilled
SCALE: 1" = 2000'
MINIMUM DEGREE OF ACCURACY: Submeter
PROVEN SOURCE OF ELEVATION: WVDOT, Harrisville, WV

STATE OF WEST VIRGINIA
DEPARTMENT OF ENVIRONMENTAL PROTECTION
OIL AND GAS DIVISION

DATE: May 28 20 26
OPERATOR'S WELL NO. Snook Unit 1H

API WELL NO
47 - 033 - 06122
STATE COUNTY PERMIT

WELL TYPE: ☐ OIL ☒ GAS ☐ LIQUID INJECTION ☐ WASTE DISPOSAL
(IF GAS) PRODUCTION : ☐ STORAGE ☐ DEEP ☒ SHALLOW

LOCATION: ELEVATION: As-Built 1,154.4' WATERSHED: Tenmile Creek QUADRANGLE: Wolf Summit
DISTRICT: Eagle COUNTY: Harrison
SURFACE OWNER: Robert G. & Christine E. Flanigan, et al ACREAGE: 129.00

08/28/2026

ROYALTY OWNER: A.W. & Susan C. Coffman LEASE NO: _____ ACREAGE: 129.00
PROPOSED WORK: ☐ DRILL ☐ CONVERT ☐ DRILL DEEPER ☐ FRACTURE OR STIMULATE ☐ PLUG OFF OLD FORMATION
☐ PERFORATE NEW FORMATION ☒ OTHER PHYSICAL CHANGE IN WELL (SPECIFY) As-Drilled
☐ PLUG AND ABANDON ☐ CLEAN OUT AND REPLUG TARGET FORMATION: Marcellus Shale ESTIMATED DEPTH: 6,962' TVD / 22,918' MD

WELL OPERATOR: Antero Resources Corporation DESIGNATED AGENT: Conrad Baston
ADDRESS: 1615 Wynkoop Street ADDRESS: 535 White Oaks Blvd.
Denver, CO 80202 Bridgeport, WV 26330

Antero Resources
Well No. Snook 1H
As-Drilled
Antero Resources Corporation

ALLEGHENY SURVEYS, INC.


Notes:
Well No. Snook Unit 1H
As-Drilled POE Coordinates
WV Coordinate System
of 1927, North Zone
N: 309,616.98'
E: 1,748,137.83'
Lat: 39°20'47.96"
Lon: 80°23'26.12"
UTM Zone 17, NAD 1983
N: 4,355,433.242m
E: 552,527.809m


Notes
West Virginia Coordinate System
of 1927, North Zone
based upon Differential GPS Measurements.
Well No. Snook Unit 1H Top Hole coordinates are
N: 309,343.32' Latitude: 39°20'45.11"
E: 1,746,731.43' Longitude: 80°23'43.99"
Bottom Hole coordinates are
N: 324,423.60' Latitude: 39°23'13.83"
E: 1,743,429.69' Longitude: 80°24'27.96"
UTM Zone 17, NAD 1983
Top Hole Coordinates Bottom Hole Coordinates
N: 4,355,342.728m N: 4,359,920.329m
E: 552,100.718m E: 551,018.294m
Plat orientation and corner and well references are based upon the grid north meridian.
Well location references are based upon the magnetic meridian.

Legend

- Proposed gas well
- Well Reference, as noted
- Monument, as noted
- Existing Well, as noted
- Digitized Well, as noted
- Creek or Drain
- Existing road
- Surface boundary (approx.)
- District line (approx.)

Detail 1 (1"=500')

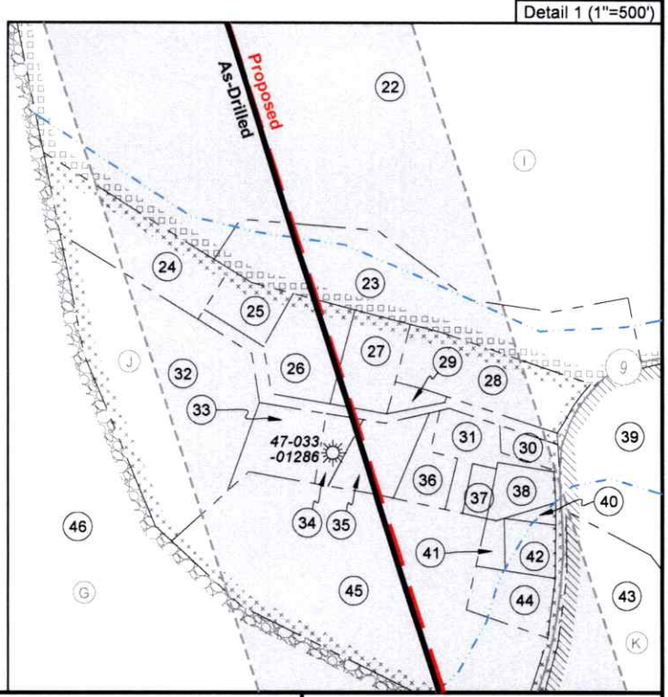

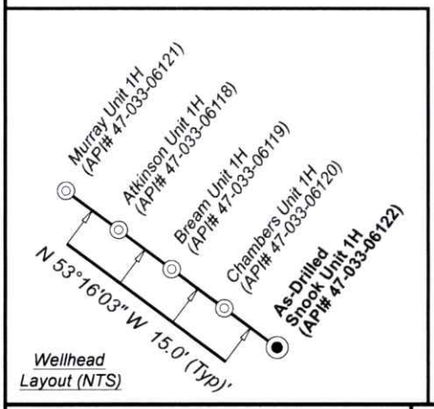

FILE NO: 126-36-EO-25
DRAWING NO: Snook Unit 1H As-Drilled
SCALE: 1" = 2000'
MINIMUM DEGREE OF ACCURACY: Submeter
PROVEN SOURCE OF ELEVATION: WVDOT, Harrisville, WV

STATE OF WEST VIRGINIA
DEPARTMENT OF ENVIRONMENTAL PROTECTION
OIL AND GAS DIVISION

DATE: May 28 20 26
OPERATOR'S WELL NO. Snook Unit 1H

API WELL NO
47 - 033 - 06122
STATE COUNTY PERMIT

WELL TYPE: ☐ OIL ☒ GAS ☐ LIQUID INJECTION ☐ WASTE DISPOSAL
(IF GAS) PRODUCTION : ☐ STORAGE ☐ DEEP ☒ SHALLOW

LOCATION: ELEVATION: As-Built 1,154.4' WATERSHED: Tenmile Creek QUADRANGLE: Wolf Summit
DISTRICT: Eagle COUNTY: Harrison
SURFACE OWNER: Robert G. & Christine E. Flanigan, et al ACREAGE: 129.00

08/28/2026

ROYALTY OWNER: A.W. & Susan C. Coffman LEASE NO: _____ ACREAGE: 129.00
PROPOSED WORK: ☐ DRILL ☐ CONVERT ☐ DRILL DEEPER ☐ FRACTURE OR STIMULATE ☐ PLUG OFF OLD FORMATION
☐ PERFORATE NEW FORMATION ☒ OTHER PHYSICAL CHANGE IN WELL (SPECIFY) As-Drilled
☐ PLUG AND ABANDON ☐ CLEAN OUT AND REPLUG TARGET FORMATION: Marcellus Shale ESTIMATED DEPTH: 6,962' TVD / 22,918' MD

WELL OPERATOR: Antero Resources Corporation DESIGNATED AGENT: Conrad Baston
ADDRESS: 1615 Wynkoop Street ADDRESS: 535 White Oaks Blvd.
Denver, CO 80202 Bridgeport, WV 26330

Antero Resources
Well No. Snook 1H
As-Drilled
Antero Resources Corporation

		Harrison County		
No.	TM / Par	Owner	Bk / Pg	Ac.
1	185 / 56	James M. & Barbara A. Plybon	1685 / 534	69.75
2	205 / 11	Tenmile Ranch, LLC	1754 / 249	81.35
3	205 / 12	Romona A. & Richard P. Swiger, Jr.	1184 / 420	21.80
4	205 / 13	Maxine K. & James G. Ice, II	1234 / 770	29.98
5	185 / 62	Gregory S. Plybon	1411 / 293	21.79
6	205 / 14	James M. Plybon	1411 / 289	39.28
7	205 / 38	Maxine K. & James G. Ice, II	1234 / 770	40.42
8	205 / 14.1	James M. Plybon	1398 / 1023	27.58
9	205 / 38.1	David E. & Rebecca L. Nay	1741 / 767	17.58
10	205 / 39	Michael S. & Vickie L. Holt	1663 / 1159	87.07
11	205 / 39.3	Dennis D. & Joyce E. Southern	1318 / 195	5.00
12	205 / 39.2	Keith R. & Brenda K. Fortney	1070 / 499	5.00
13	205 / 61	David E. & Rebecca L. Nay	1208 / 843	89.26
14	205 / 79.1	David E. & Rebecca L. Nay	1741 / 762	88.00
15	205 / 79.2	Larry Hood	1789 / 1268	0.57
16	205 / 79	Larry Hood	1784 / 1193	4.82
17	225 / 22	Christopher J. Deem	1782 / 126	2.12
18	225 / 21	Patrick H. & Frank O. Cunningham	W203 / 413	64.00
19	225 / 23	Lyndon Holdings, LLC, et al	1613 / 135,152	35.82
20	225 / 36	Jason C. & Kristin A. Cunningham	1610 / 1185	18.47
21	226 / 14	Charles J. Nay	W184 / 59	61.70
22	226 / 36	Julia F. Zirkle	W167 / 267	53.50
23	226 / 54	Marie Z. & John Q. Clemens	1287 / 659	5.50
24	226 / 56.9	Drayke A. Martin & Jacye D. Laxton	1776 / 1001	2.07
25	226 / 56.15	R. Michelle & Harold Q. Frye, II	1244 / 585	2.00
26	226 / 56.6	R. Michelle & Harold Q. Frye, II	1244 / 585	1.33
27	226 / 56.10	Danny J. & Tammie J. Heflin	1151 / 571	1.02
28	226 / 55	Bobby L. Ash, II	1372 / 1032	2.00
29	226 / 56.17	James E. Darway	1260 / 835	0.20
30	226 / 56.4	Clifford A. & James H. Powers	999 / 195	0.44
31	226 / 56	Michael A. Tharp	1734 / 1338	0.76
32	226 / 56.13	Corey J. & Tara A. Wright	1625 / 1225	5.80
33	226 / 56.12	Harold Q. & Ronda M. Frye	1582 / 246	1.00
34	226 / 56.19	Michael A. Tharp	1734 / 1338	0.34
35	226 / 56.7	Jason W. Melinda J. Hurst	1390 / 265	1.00
36	226 / 56.11	Michael A. Tharp	1623 / 156	0.55
37	226 / 56.18	Janet Sayers	1485 / 533	0.23
38	226 / 56.14	Janet S. Sayers	1128 / 247	0.49
39	226 / 90	Gary & Susan Ross	1432 / 964	14.06
40	226 / 56.8	Travis Baney	1555 / 1132	0.11
41	226 / 56.2	Travis Baney	1555 / 1132	0.22
42	226 / 56.3	Travis Baney	1555 / 1132	0.50
43	226 / 90.1	Branch Banking & Trust Co.	1665 / 1203	7.19
44	226 / 56.1	Judy S. & John D. Maxwell, Jr.	1465 / 836	0.80
45	226 / 56.5	Gary & Susan Ross	1234 / 645	9.59
46	226 / 57	Jason C. & Kristin A. Cunningham	1610 / 1185	67.52
47	226 / 57.1	Andria L. Williams	1628 / 98	0.60
48	226 / 90.2	David E. Robey	1555 / 1136	5.35
49	226 / 88	Jason C. & Kristin A. Cunningham	1610 / 1185	9.98
50	226 / 89	David J. Robey	1444 / 1293	12.35
51	226 / 90.4	Logan D. Robey	1780 / 917	1.00
52	226 / 90.3	David J. Robey	1444 / 1293	83.98
53	246 / 30	James A. Varner	1261 /957	397.42
54	245 / 26	Robert G. & Christine E. Flanigan, et al	W216 / 842	129.00

Tag	Lease
A	James A. & Alice Griffin
B	Louisa C. Robinson & D.D. Robinson, her husband
C	J. Ashvill & Matilda J. Swiger
D	J.N. Swiger & H.J. Swiger
E	J.C. & Mandora V. Bartlett
F	A.G. Swiger
G	Blanche R. Atkinson
H	E.L. Coffman & F.O. Coffman, his wife
I	Samuel A. Elliott & Bashie A. Elliott
J	Anson Cain & Ida S. Cain, his wife
K	Marguerite Mason, et al
L	C. Garnett Ritter, et al
M	Dennis C. Bates, et al
N	A.W. & Susan C. Coffman

FILE NO: 126-36-EO-25
DRAWING NO: Snook Unit 1H As-Drilled
SCALE: 1" = 2000'
MINIMUM DEGREE OF ACCURACY: Submeter
PROVEN SOURCE OF ELEVATION: WVDOT, Harrisville, WV

STATE OF WEST VIRGINIA
DEPARTMENT OF ENVIRONMENTAL PROTECTION
OIL AND GAS DIVISION

DATE: May 28 20 26
OPERATOR'S WELL NO. Snook Unit 1H
API WELL NO
47 - 033 - 06122
STATE COUNTY PERMIT

WELL TYPE: ☐ OIL ☒ GAS ☐ LIQUID INJECTION ☐ WASTE DISPOSAL
(IF GAS) PRODUCTION : ☐ STORAGE ☐ DEEP ☒ SHALLOW

LOCATION: ELEVATION: As-Built 1,154.4' WATERSHED: Tenmile Creek QUADRANGLE: Wolf Summit
DISTRICT: Eagle COUNTY: Harrison 08/28/2026
SURFACE OWNER: Robert G. & Christine E. Flanigan, et al ACREAGE: 129.00

ROYALTY OWNER: A.W. & Susan C. Coffman LEASE NO: _____ ACREAGE: 129.00
PROPOSED WORK: ☐ DRILL ☐ CONVERT ☐ DRILL DEEPER ☐ FRACTURE OR STIMULATE ☐ PLUG OFF OLD FORMATION
☐ PERFORATE NEW FORMATION ☒ OTHER PHYSICAL CHANGE IN WELL (SPECIFY) As-Drilled
☐ PLUG AND ABANDON ☐ CLEAN OUT AND REPLUG TARGET FORMATION: Marcellus Shale ESTIMATED DEPTH: 6,962' TVD / 22,918' MD

WELL OPERATOR: Antero Resources Corporation DESIGNATED AGENT: Conrad Baston
ADDRESS: 1615 Wynkoop Street ADDRESS: 535 White Oaks Blvd.
Denver, CO 80202 Bridgeport, WV 26330